November 8, 2023

Addendum CC-2

Irving Middle School 2745 S 22nd Street Lincoln, NE 68502

Pound Middle School 4740 S 45th Street Lincoln, NE 68516

CWP 23120



5060 Dodge Street Omaha, Nebraska 68132 402.551.1500

cwparchitects.com

NOTICE TO BIDDERS:

- A. This Addendum is issued to all registered plan holders pursuant to the Instructions to Bidders and serves to clarify, revise, and supersede information in the Project Manual, Drawings, and previously issued Addenda. Once issued, portions of this Addendum affecting the Contract Documents shall be considered as fully incorporated into the Contract Documents unless further modified by subsequent Addenda.
- B. Previously issued Addenda include Addendum CC-1 dated October 26, 2023.
- C. The Bidder shall acknowledge receipt of Addenda in the appropriate space on the Bid Form.
- D. The date for receipt of bids is unchanged by this Addendum, at same time and location.
- E. The Contract Documents for the above referenced project are hereby amended as follows:

ASSOCIATED CONSULTANT ADDENDA:

Item No. A1 Mechanical, Electrical, Plumbing Work

A. See Alvine Engineering Addendum 2 page 1 and attachments attached hereto and dated 11/7/23 for additional addendum items.

PROJECT MANUAL:

Item No. M1 Section 096517 RESILIENT SHEET FLOORING

- A. Eliminate all references to manufacturer RCA Rubber; Subsection 2.2 RUBBER SHEET FLOORING (RSF-#) shall read as follows:
- A. Product: Subject to compliance with requirements, provide products by Flexco Flooring.
 - 1. Flexco
- 1) Custom colorway(s) by Flexco may be required to match existing resilient sheet flooring. Ensure final product matches existing resilient flooring colors and patterns and Bid quantity meets manufacturers minimum production quantities for custom colorways.
 - a) All overage resulting from meeting minimum custom requirements shall be supplied to Owner as attic stock.
- 2. *RSF*:
 - a. Manufacturer: Flexco
 - b. Style/Pattern: Custom rubber sheet flooring

Addendum CC-2 Page 1 of 4

October 31, 2023, 2:00 pm

PRE-BID MEETING Sign-in – LPS Bid #10888

Meeting Location:

Irving Middle School 2745 S 22nd Street Lincoln, NE 68502 Pound Middle School 4740 S 45th Street Lincoln, NE 68516

CWP 23120

Please register your attendance:



5060 Dodge Street Omaha, Nebraska 68132 402.551.1500

cwparchitects.com

Name	Organization	Interest	Phone	E-Mail
1. Justin Mammens	MMC		402.432.7405	
2. Tracy Stake	D.H.M.		402.610.7459	
3. Bryce McGill	Genesis Contracting		402.791.0151	
4. Brian Wehrs	Kingery		402.840.2508	
5. Brian Grimes	Sampson		402.434.5419	
6. Marcus Rand	Peitzmeier Demo		402.949.0123	
7. Mark Wall	Cheever Const.		402.477.6745	
8. Nick Collen	IES Electric		402.890.7874	
9. John	Nifco		402.499.5190	
10. Brandon Engler	BLU Cor		402.677.4944	
11. Justin Schulz	BIC Construction		402.875.3522	
12. John Morehouse	CTM Construction		402.476.2105	
13. Dan Throener	ECC		402.570.1123	
14. Christian Martin	Rogge General Contractors		402.441.3100	

- c. Colors: As indicated in Materials Schedule on Drawings to match colors of existing installed rubber's manufacturer, RCA Rubber Flexi-Floor.
- d. Roll Width: 36"
- e. Roll Length: 16-30 yards
- f. Overall Thickness: 1/8"
- g. Fire Performance: ASTM E 648, Standard Test method for Critical Radiant Flux of 0.45 watts/cm2 or greater, Class I, ASTM E662 Smoke Development.
- h. Coefficient of Friction (ASTM D2047): 0.6 0.7 dry. ADA Compliant.
- i. Warranty: manufacturer's standard 12 year limited non-prorated warranty

IRVING MIDDLE SCHOOL DRAWINGS:

Item No. IRVING-D1 Sheet A1.6 FINISHES, EQUPMENT & DOOR AND FRAMES SCHEDULE

- A. Revise MATERIALS SCHEDULE designation RS-1 as follows:
 - 1. Manufacturer: FLEXCO
 - 2. Style/Collection: CUSTOM SHEET RUBBER FLOORING
 - 3. Color: CUSTOM MATCH EXISTING RCA RUBBER 758: FRESH CREAM
 - 4. Size:1/8" THICK x 36" WIDE ROLL
 - 5. Notes: VERIFY MATCH TO EXISTING
- B. Revise MATERIALS SCHEDULE designation RSF-2 as follows:
 - 1. Manufacturer: FLEXCO
 - 2. Style/Collection: CUSTOM SHEET RUBBER FLOORING
 - 3. Color: CUSTOM MATCH EXISTING RCA RUBBER 711: DOVE GREY
 - 4. Size:1/8" THICK x 36" WIDE ROLL
 - 5. Notes: VERIFY MATCH TO EXISTING
- C. Revise MATERIALS SCHEDULE designation RSF-3 as follows:
 - 1. Manufacturer: FLEXCO
 - 2. Style/Collection: CUSTOM SHEET RUBBER FLOORING
 - 3. Color: CUSTOM MATCH EXISTING RCA RUBBER 604 : BLACK MARBLE
 - 4. Size:1/8" THICK x 36" WIDE ROLL
 - 5. Notes: VERIFY MATCH TO EXISTING

Item No. IRVING-D2 Sheet A2.2 REFLECTED CEILING PLANS - FCS & CTE

D. Modify detail 3/A2.2 to show soffit's GB face 1" proud of millwork hardwood facing below.

Item No. IRVING-D3 Sheet A6.1 MILLWORK

- E. Modify dimensions of tall storage cabinets and indicated upper and base cabinets in elevation 11/A6.1.
- F. Modify elevation 24/A6.1 to include further details of teaching station, modify millwork dimensions, indicate butch block countertop, and to add end panels as indicated.
- G. Add elevation 24b/A6.1 in its entirety.
- H. Add millwork sections 25, 26, and 27/A6.1 to illustrate construction of CTE teaching station.

I.

Addendum CC-2 Page 2 of 4

Item No. IRVING-D4 Sheet A6.2 MILLWORK

A. Add millwork section 3B/A6.2 in its entirety.

Item No. IRVING-D5 Sheet A1.2 FCS DEMOLITION & FLOOR PLAN

A. Adjust notes to clarify contractor/owner scope regarding owner provided casework.

Item No. IRVING-D6 Sheet A1.4 ART DEMOLITION & FLOOR PLANS

A. Add note to include new blinds in art room where wall disrupts existing window treatment

POUND MIDDLE SCHOOL DRAWINGS:

Item No. POUND-D1 Sheet A1.4 ART ROOM DEMOLITION & FLOOR PLANS

- A. Revise millwork section 4/A1.4 to:
 - 1. indicate 5.5" depth at new ADA sink and reduce removable panel size to accommodate sink.
 - 2. Countertop finish to be PL-2. Reference revised MATERIALS SCHEDULE.
 - 3. Indicate RAKKS EVH vanity bracket to be custom to accommodate ADA sink and panel as shown.

Item No. POUND-D2 Sheet A1.5 FINISHES & DOOR AND FRAME SCHEDULE

- B. Revise MATERIALS SCHEDULE designation RS-1 as follows:
 - 1. Manufacturer: FLEXCO
 - 2. Style/Collection: CUSTOM SHEET RUBBER FLOORING
 - 3. Color: CUSTOM MATCH EXISTING RCA RUBBER 758: FRESH CREAM
 - 4. Size:1/8" THICK x 36" WIDE ROLL
 - 5. Notes: VERIFY MATCH TO EXISTING
- C. Revise MATERIALS SCHEDULE designation RSF-4 as follows:
 - 1. Manufacturer: FLEXCO
 - 2. Style/Collection: CUSTOM SHEET RUBBER FLOORING
 - 3. Color: CUSTOM MATCH EXISTING RCA RUBBER 747 : BUTTERSCOTCH SWIRL
 - 4. Size:1/8" THICK x 36" WIDE ROLL
 - 5. Notes: VERIFY MATCH TO EXISTING
- D. Add MATERIALS SCHEDULE designation PL-2 as follows:
 - 1. Manufacturer: WILSONART
 - 2. Style/Collection: HPL. HORIZONTAL GRADE GP-50
 - 3. Color: 4170-60: BEIGE PAMPAS (MATTE)
 - 4. Notes: COUNTERTOPS; VERIFY MATCH TO EXISTING

Item No. **POUND-**D3 Sheet A6.1 MILLWORK


- A. Revise millwork elevations 16 and 17/A6.1 to indicate PL-2 countertop finish; reference millwork sections 28 and 29/A6.1
- B. Revise millwork section 28/A6.1 to:

Addendum CC-2 Page 3 of 4

- 5. Indicate 5.5" depth at new ADA sink and reduce removable panel size to accommodate sink.
- 1. Indicate PL-2 finish at countertops, associated splashes, and cladding. Reference revised MATERIALS SCHEDULE.
- C. Modify millwork enlarged plan 18/A6.1 FCS- DEMO STATION to illustrate millwork chase built into base cabinets; reference associated millwork sections.
- D. Modify section 22/A6.1 to indicate HDMI and outlet location within millwork cabinet chase.
- E. Add millwork section 22B in its entirety.

END OF ADDENDUM

Addendum CC-2 Page 4 of 4

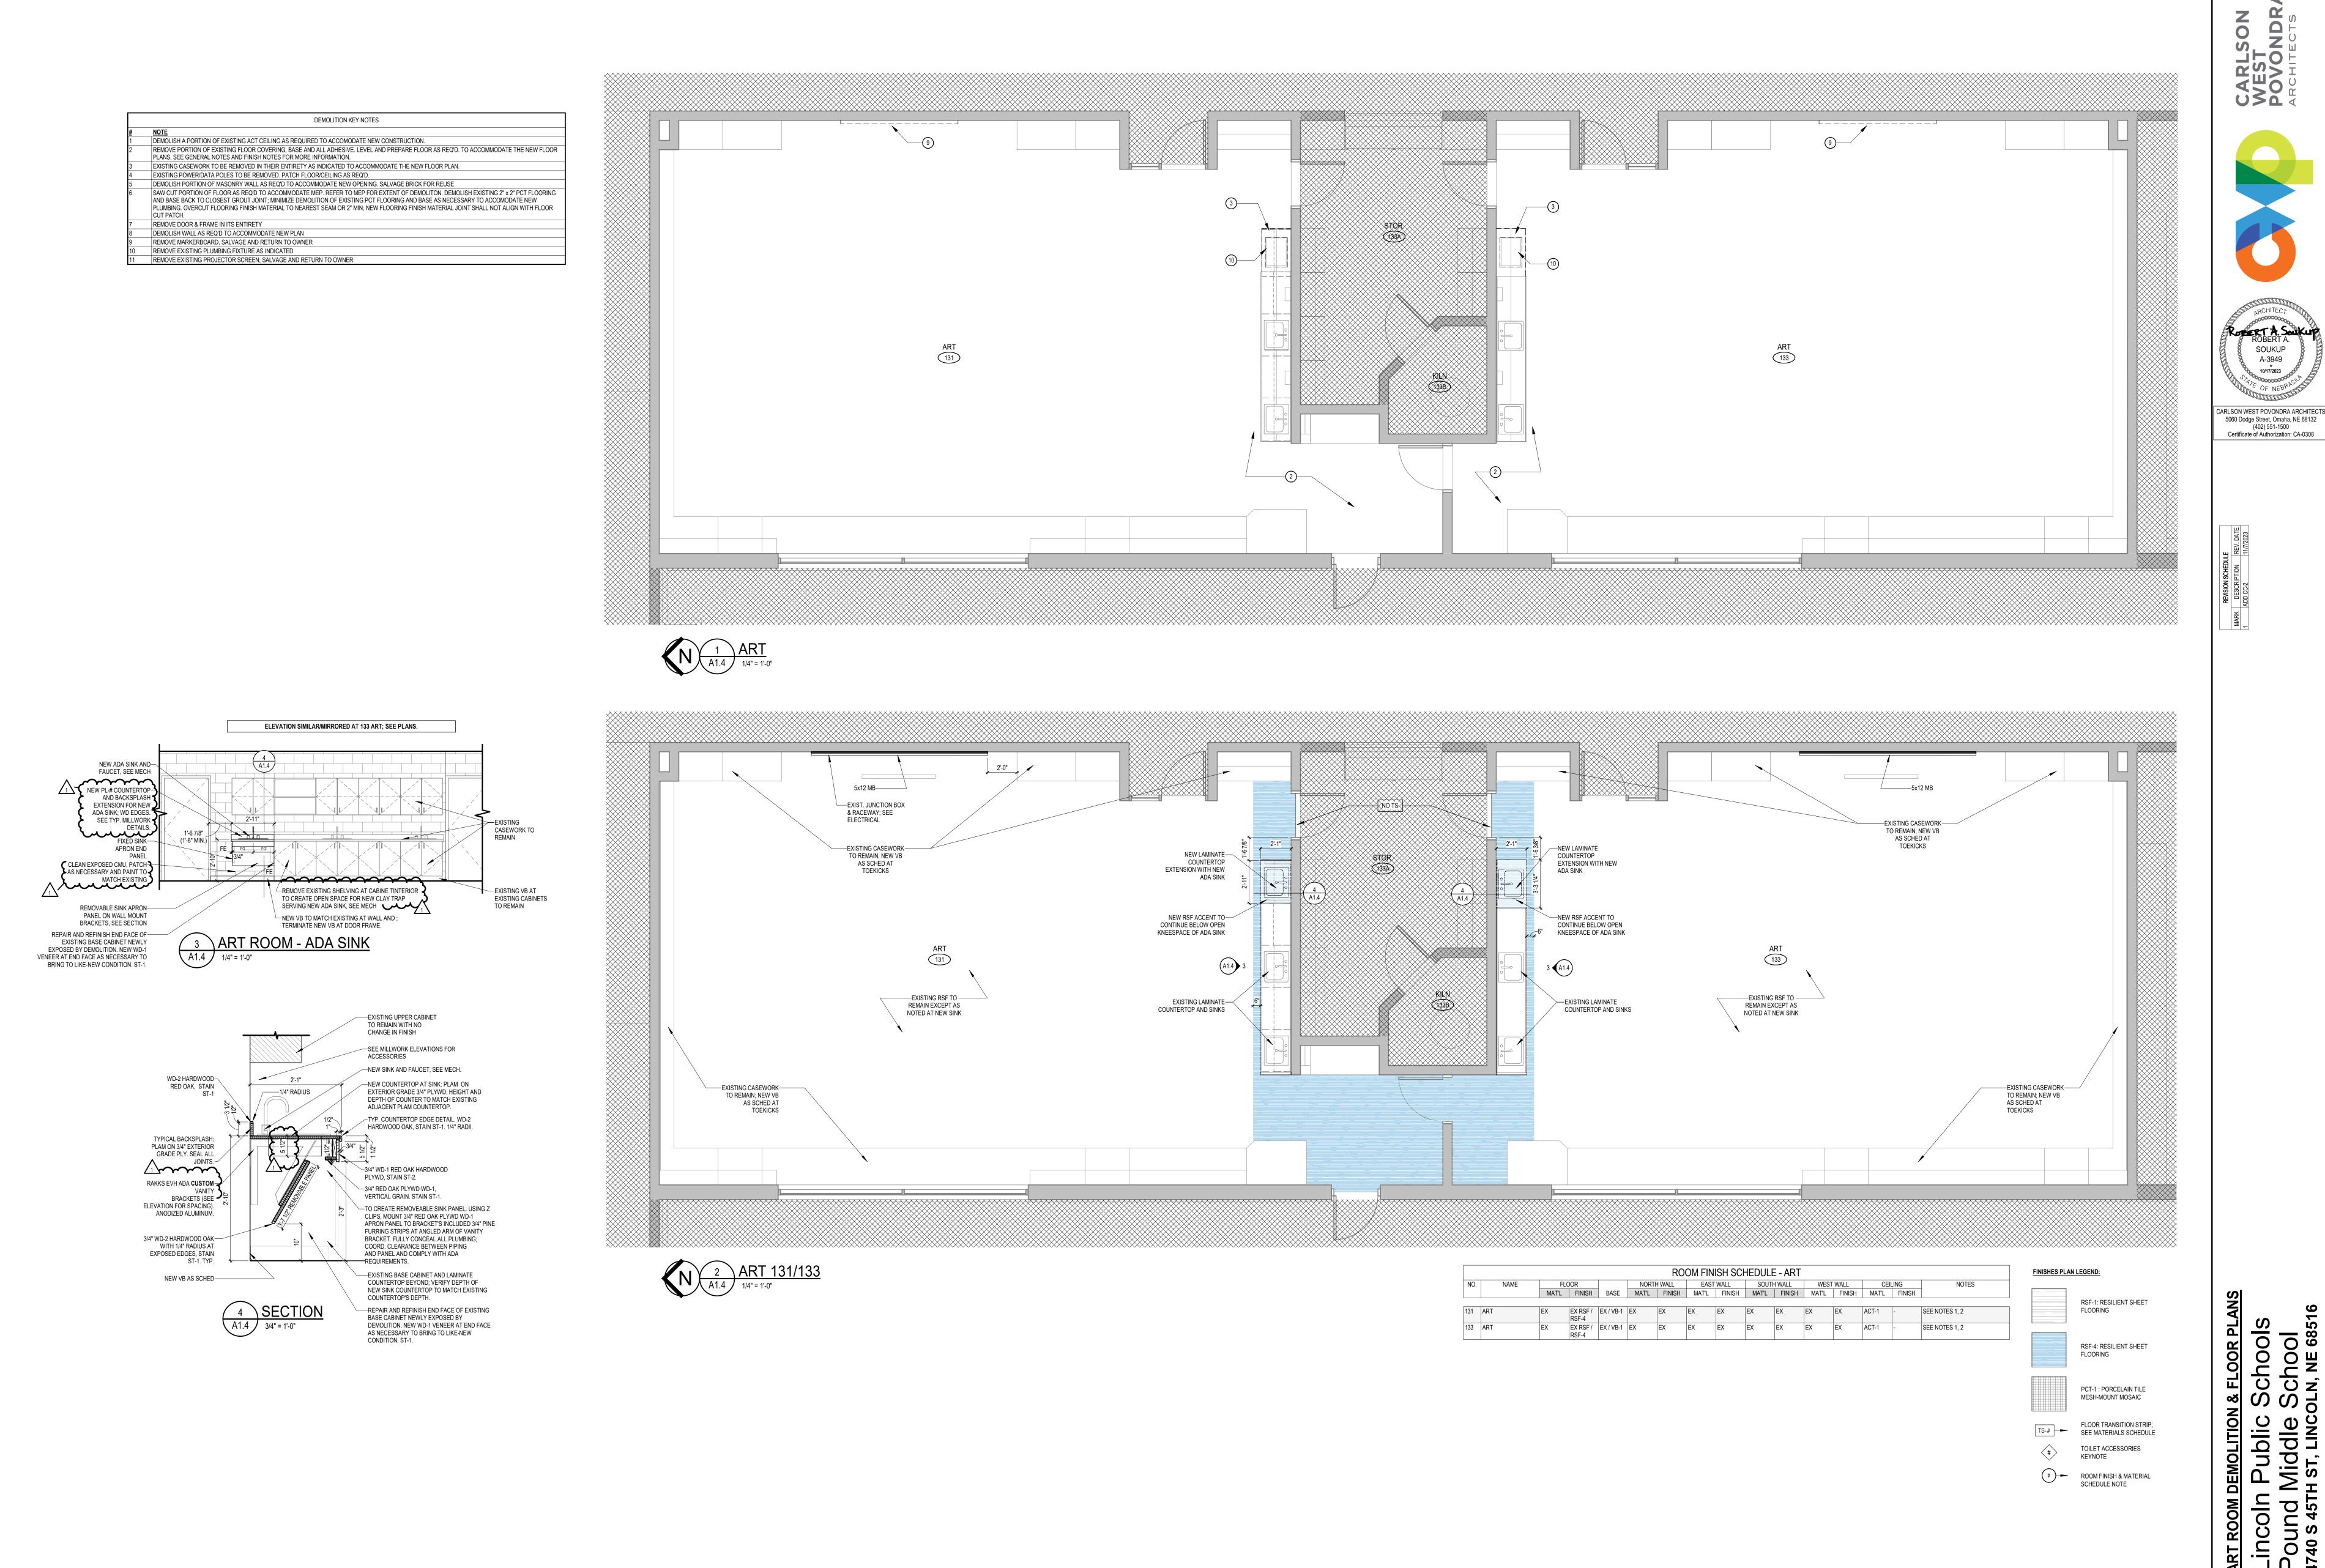

ART ROOM DEMOLITION & FLOOR PLAN Lincoln Public Schools Pound Middle School 4740 S 45TH ST, LINCOLN, NE 68516

FINISH & MATERIAL GENERAL NOTES:

- 1. SEE INTERIOR ELEVATIONS, REFLECTED CEILING PLAN & FINISH PLAN FOR ALL LOCATIONS OF MULTIPLE FINISHES. 2. VERIFY CONDITIONS OF FLOORS & WALLS SCHEDULE TO RECEIVE NEW FINISHES WITH THE INSTALLER OR PRODUCT MANUFACTURERS' REPRESENTATIVE, PRIOR TO FINISH INSTALLATION. PATCH AND/OR REPAIR HOLES & DEPRESSIONS TO PROVIDE A SMOOTH FINISHED SURFACE.
- 3. INSTALL ALL FINISHES PER MANUFACTURER'S RECOMMENDATIONS: IMMEDIATELY NOTIFY ARCHITECT IN WRITING OF CONDITIONS OF CONSTRUCTION DETRIMENTAL OR PROHIBITIVE TO MANUFACTURER-RECOMMENDED INSTALLATION 4. FOR ALL 'MATCH EXISTING' FINISHES, MULTIPLE SAMPLES OF DIFFERENT STYLES AND/OR COLORS MAY BE REQUIRED. VERIFY EXACT STYLES & COLORS ON SITE AND SUBMIT SAMPLES FOR ARCHITECT'S APPROVAL PRIOR TO
- INSTALLATION. FLOORS:

 1. FLOOR SURFACES SHOULD HAVE NO MORE THAN 1/2" VARIANCE PER 10 LINEAR FEET WHEN READY TO RECEIVE FINISH MATERIALS. REPAIR EXISTING FLOORS TO MEET REQUIREMENTS IF NECESSARY. 2. CONTRACTOR TO VERIFY SCHEDULED FLOOR TRANSITION STRIP PROFILES & SIZE AGAINST FLOORING MATERIALS
- (BOTH NEW & EXISTING) FOR ADA COMPLIANCE PRIOR TO INSTALLATION, INCLUDING ANY NEEDED FOR RAMPED A. PROVIDE FLOOR PLAN NOTING EACH TRANSITION STRIP AS INDICATED IN THE MATERIALS SCHEDULE & LOCATION OF FLOOR TRANSITION STRIPS FOR ARCHITECT'S REVIEW. B. WHERE FLOOR MATERIAL TRANSITIONS HAVE SAME MATERIAL THICKNESS, DO NOT INSTALL TRANSITION STRIP
- BETWEEN MATERIALS UNLESS OTHERWISE NOTED. INSTALL FLOORING WITH TIGHT JOINTS AND NO VISIBLE C. FOR ALL TRANSITION STRIPS (TS-#), TRANSITIONS OF FLOORING MATERIALS TO OCCUR UNDER DOOR IN THE CLOSED POSITION UNLESS OTHERWISE INDICATED IN THE DRAWINGS.
- D. CONSULT ARCHITECT WITH QUESTIONS ON FLOOR TRANSITIONS & TRANSITION STRIPS PRIOR TO ORDERING 3. SEE DOOR & FRAME SCHEDULE FOR PAINT FINISHES ON HM DOORS & DOOR FRAMES. COORDINATE WITH MATERIALS
- SCHEDULE & SPECIFICATIONS. 4. CONTINUE FLOOR FINISHES & PATTERNS BENEATH EQUIPMENT, MOVEABLE ITEMS & OPEN (KNEE SPACE) MILLWORK. 5. FLOOR DRAIN GRATES TO BE SET AT 90° TO FLOORING PATTERN. IF FLOORING DOES NOT HAVE A PATTERN TO ALIGN TO, GRATE TO BE SET AT 90° TO ADJACENT WALL(S). ALL WALL FINISHES SHOWN ON FINISH PLAN ARE FOR CLARIFICATION ONLY: COORDINATE FINISHES WITH THE ROOM
- ELEVATIONS OCCUR, CONTACT ARCHITECT'S OFFICE IMMEDIATELY FOR CLARIFICATION PRIOR TO PROCEEDING. CONTRACTOR SHALL PROVIDE ALL BLOCKING AS REQUIRED FOR WALL MOUNTED ACCESSORIES & SPECIALTY EQUIPMENT, INCLUDING BUT NOT LIMITED TO ALL TOILET & BATH ACCESSORIES, MARKER BOARDS, TACK BOARDS, AUDIO VISUAL & MEP INDICATED EQUIPMENT. CONTRACTOR TO PROVIDE BLOCKING FOR WALL MOUNTED ITEMS INDICATED BY OTHERS. 3. WHERE PRODUCTS OR EQUIPMENT PLACEMENT SPANS FROM TILE TO DRYWALL OR OTHER MATERIAL, PROVIDE

FINISH SCHEDULE. WHERE DISCREPANCIES BETWEEN THE ROOM FINISH SCHEDULE, FINISH PLAN, DETAILS OR

- WHITE UHMW PLASTIC FILLER OF THE SAME THICKNESS AS TILE BEHIND PRODUCT. AT DRYWALL OR OTHER MATERIAL. THIS MAY OCCUR AT (BUT IS NOT LIMITED TO) TOILET PARTITIONS, MIRRORS OR OTHER TOILET & BATH ACCESSORIES.
- 1. SEE REFLECTED CEILING PLAN(S) FOR ALL ROLLER SHADE (RS-#) LOCATIONS AND DETAILS. MECHANICAL & ELECTRICAL & OWNER PROVIDED COORDINATION:
- SEE ELECTRICAL DRAWINGS FOR ALL FLOOR RECEPTACLE LOCATIONS. COORDINATE MILLWORK OPENINGS WITH ELECTRICAL LOCATIONS WHERE OCCURRING. 2. ALL LOUVRES, VENTS, GRILLES, DUCTWORK & OTHER MISCELLANEOUS MECHANICAL & ELECTRICAL DEVICES IN EXPOSED LOCATIONS SHALL BE PAINTED TO MATCH THE SURFACE IN WHICH THEY APPEAR, UNLESS OTHERWISE
- 3. PAINT ALL EXPOSED FIRE SUPPRESSION (BOTH NEW AND EXISTING) SPRINKLER PIPING; PAINT TO MATCH ADJACENT
- 4. ALL FURNITURE SHOWN ON PLANS TO BE PROVIDED BY OWNER AND SHOWN FOR REFERENCE ONLY. CONTRACTOR TO VERIFY FURNITURE LAYOUT WITH OWNER AND OWNER'S FURNITURE VENDOR. CONTRACTOR TO COORDINATE POWER & DATA CONNECTIONS AT FURNITURE WITH VENDOR & IN ACCORDANCE WITH CONSTRUCTION DOCUMENTS [SEE ELECTRICAL].

FINISH ABBREVIATIONS

- ACT ACOUSTIC CEILING TILE AFF ABOVE FINISHED FLOOR ALUM ALUMINUM AWP ACOUSTIC WALL PANEL
- BRICK CEMENTITIOUS BOARD CORNER GUARD CERAMIC MOSAIC TILE CMU CONCRETE MASONRY UNIT
- CERAMIC TILE EPOXY RESINOUS FLOORING EXPOSED STRUCTURE
- FIBERGLASS REINFORCED PANELING GYPSUM BOARD
- GLASS TILE HIGH-IMPACT / ABUSE RESISTANT GYPSUM BOARD LOCKERS
- RSF RUBBER SHEET FLOORING SOLID SURFACE MATERIAL SCONC SEALED CONCRETE FINISH
- SEALED STAIN TRANSITION STRIP VINYL BASE
- WD WOOD WPM WATERPROOF MEMBRANE

DOOR & FRAME GENERAL NOTES: HOLLOW METAL DOORS AND FRAMES ARE INDICATED ON THE FLOOR PLANS WITH A "SINGLE CIRCLE" REFERENCE AND ARE SHOWN ON THE DOOR AND FRAME SCHEDULE WITH THE MATERIAL REFERENCE "HM". 2. ALUMINUM DOORS AND FRAMES ARE INDICATED ON THE FLOOR PLANS WITH A

- "SINGLE HEXAGON" REFERENCE AND ARE SHOWN ON THE DOOR AND FRAME SCHEDULE WITH THE MATERIAL REFERENCE "AL" 3. DOOR GLASS TYPES ARE INDICATED IN THE "GLASS" COLUMN ON THE DOOR AND FRAME SCHEDULES. FRAME GLASS TYPES ARE INDICATED ON THE "FRAME TYPE"
- ELEVATIONS. SEE DIVISION 08 SECTION "GLAZING" FOR GLASS IN HOLLOW METAL DOORS AND FRAMES, WOOD DOORS AND ALUMINUM DOORS AND FRAMES. 4. COORDINATE DOOR UNDERCUTS WITH THRESHOLDS.
- 5. SET GLAZING TAPES/COMPOUNDS A MINIMUM 1/4" BELOW EXPOSED FACE OF GLASS STOP AT ALL DOORS AND FRAMES. 6. INSTALL EXTERIOR FRAMES WITH 1/4" SHIM AND SEALANT AROUND PERIMETER OF 7. SPLIT DOOR & FRAME COLOR: P-6 AT LOBBY SIDE; P-3 AT OFFICE SIDE.
- 8. SPLIT DOOR & FRAME COLOR: P-3 AT INTERIOR SIDE; P-2 AT EXTERIOR SIDE. 9. REFER TO MATERIALS SCHEDULE ON A1.# FOR FINISH COLOR SELECTIONS; CONTACT ARCH. OFFICE WITH ANY QUESTIONS. 10. SEE SPECIFICATION 087100, PARAGRAPH 2.8.B FOR SPECIFIC REQUIREMENTS


REGARDING PROCUREMENT AND INSTALLATION OF KEY CYLINDERS.


GLAZING TYPES


SEE PROJECT SPECIFICATIONS FOR ADDITIONAL INFORMATION.

A1.5 / 1/4" = 1'-0"

CTG CLEAR TEMPERED GLASS

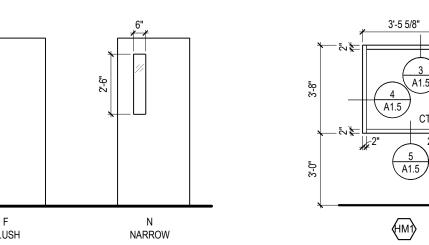

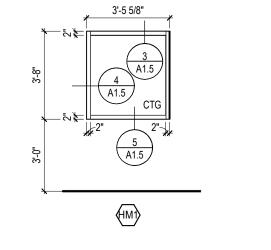

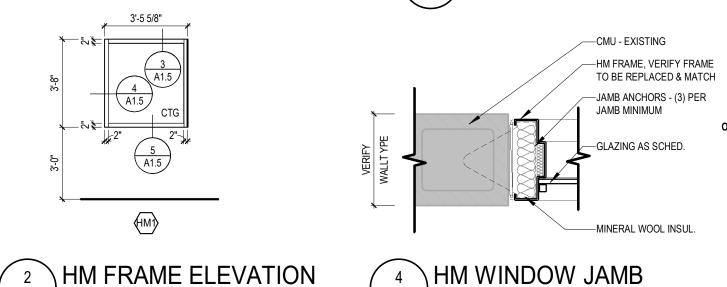

CMU INFILL, BULLNOSE-

BLOCK @ JAMB TO MATCH

EXISTING OPPOSITE JAMB

HM FRAME, VERIFY FRAME—

TO BE REPLACED & MATCH


JAMB ANCHORS - (3) PER-

GLAZING AS SCHED.-

MINERAL WOOL INSUL.—

13 HM WINDOW JAMB


JAMB MINIMUM

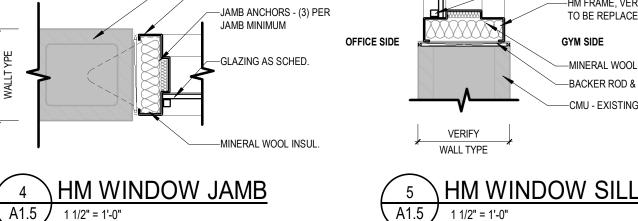


OFFICE SIDE

DOOR & FRAME SCHEDULE NOTES:

1. REFER TO SPECIFICATIONS FOR ACCESS PANEL DETAILED INFORMATION

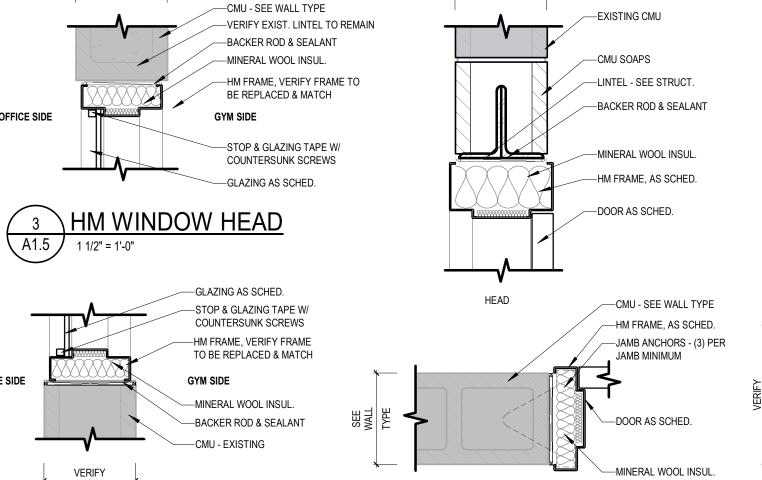

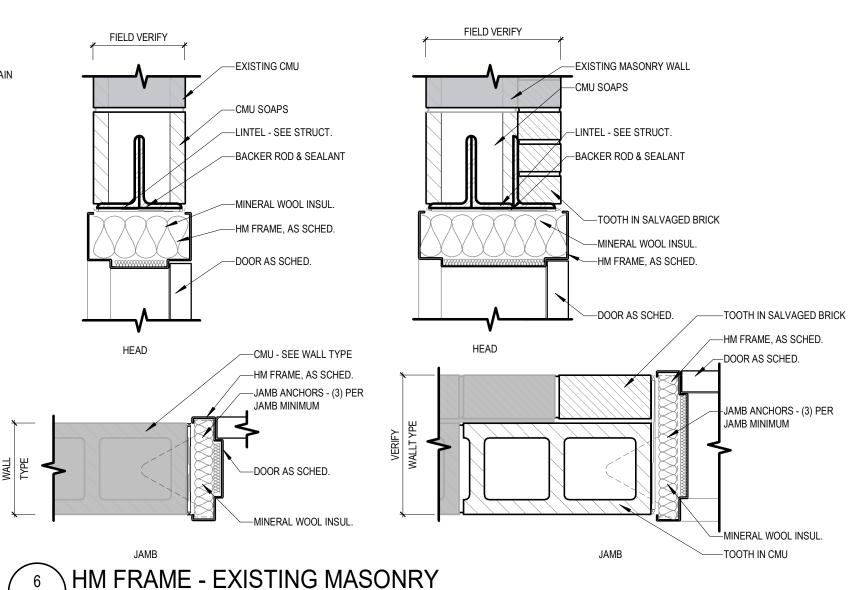

HM SC-5 1'-0 1/4" CTG

SEE NOTE 1

DOOR AND FRAME SCHEDULE

						RO	OOM F	INISH	SCHE	DULE					
NO. NAME		FLOOR			NORTH WALL		EAST WALL		SOUTH WALL		WEST WALL		CEILING		NOTES
		MAT'L		BASE	MAT'L	FINISH	MAT'L	FINISH	MAT'L	FINISH	MAT'L	FINISH	MAT'L	FINISH	
108	FCS	EX	RSF-1	VB-1	EX	P-11	EX	P-11	EX	P-11	EX	P-11	ACT-1		CEE NOTEC 1 2
110	FCS	EX	RSF-1	VB-1	EX	P-11	EX	P-11	EX	P-11	EX	P-11	ACT-1	-	SEE NOTES 1, 2 SEE NOTES 1, 2
131	ART	EX	EX RSF / RSF-4	EX / VB-1	EX	EX	EX	EX	EX	EX	EX	EX	ACT-1	-	SEE NOTES 1, 2
133	ART	EX	EX RSF / RSF-4	EX / VB-1	EX	EX	EX	EX	EX	EX	EX	EX	ACT-1	-	SEE NOTES 1, 2
142	CTE	EX	EX	EX	EX	EX	EX	EX	EX	EX	EX	EX	ACT-1	-	SEE NOTE 1
144B	OFFICE	EX	EX RSF-4	EX VB / VB-1	EX	P-11	EX	P-11	EX	P-11	CMU	P-11	EX ACT / ACT-1	-	
144C	FAMILY RR	EX CONC	PCT-1	PCT-1B	EX CMU	SC-11	CMU	SC-11 / SC-13 / SC-14	EX CMU	SC-11	EX CMU	SC-11	MRGB	P-12	
190	CORR.	EX	EX RSF / RSF-4	EX / VB-1	EX	EX	EX CMU	P-11 / P-13 / P-14	EX	EX	EX	EX	EX	EX	SEE NOTE 2
190A	FAMILY RR	EX	PCT-1	PCT-1B	EX BRICK	SC-11	CMU	SC-11 / SC-13 / SC-14	CMU	SC-11	EX BRICK	SC-11	MRGB	P-12	
190B	SRO	EX	RSF-1	VB-1	CMU/GB	P-11	CMU	P-11	EX	P-11	EX BRICK	P-11	ACT-1	-	


ROOM FINISH SCHEDULE NOTES: EXISTING ACT-1 GRID TO REMAIN, REPLACE PADS ONLY AS NECESSARY TO ACCOMMODATE NEW PENETRATIONS 2. EXISTING RSF-1 TO REMAIN, PATCH AS NECESSARY; COLOR TO MATCH EXISTING CONDITIONS


3. CPT-1 SELECTION TO MATCH EXISTING CONDITIONS

			MATERIALS SO	HEDULE		
SECTION	TAG	MANUFACTURER	COLLECTION/STYLE	COLOR	SIZE	NOTES
3 40 23 - INTERIOR ARCHITECTURAL CASEWORK						
6 40 23 - INTERIOR ARCHITECTURAL CASEWORK	PL-1	WILSONART	HPL, HORIZONTAL GRADE GP-50	4166-60 : PAMPAS (MATTE FINISH)		COUNTERTOPS
6 40 23 - INTERIOR ARCHITECTURAL CASEWORK	PL-2	WILSONART	HPL, HORIZONTAL GRADE GP-50	4170-60 : BEIGE PAMPAS (MATTE FINISH)		COUNTERTOPS; VERIFY MATCH TO EXISITING
6 40 23 - INTERIOR ARCHITECTURAL CASEWORK	WD-1		RED OAK 7-PLY PLYWD (A-2 PREMIUM, ROTARY CUT)	STAIN ST-1		
3 40 23 - INTERIOR ARCHITECTURAL CASEWORK	WD-2		SOLID RED OAK HARDWOOD	STAIN ST-1		
9 30 00 - TILING						
9 30 00 - TILING	G-1	TEC	ACCUCOLOR		DETERMINED BY MESH MOUNT PCT-1 JOINT WIDTH	FOR USE WITH PCT-1/1B
9 30 00 - TILING	G-2	TEC	ACCUCOLOR	MATCH EXISTING	MATCH EXISTING JOINTS	FOR USE WITH PCT-2
30 00 - TILING	PCT-1	AMERICAN OLEAN	UNGLAZED MOSAICS	0A94 : WILLOW SPECKLE	2" x 2" MESH MOUNT MOSAIC	
30 00 - TILING	PCT-1B	AMERICAN OLEAN	UNGLAZED MOSAICS	0A94 : WILLOW SPECKLE	MB5B (5"H) BUILT UP BASE	
3 30 00 - TILING	PCT-2	AMERICAN OLEAN	UNGLAZED MOSAICS	0A91 : WILLOW	2" x 2" MESH MOUNT MOSAIC	
9 30 00 - TILING	PCT-2B	AMERICAN OLEAN	UNGLAZED MOSAICS	0A91 : WILLOW	STIMOSITI WOOMO	VERIFY MATCH TO EXISTING BASE PROFILE / HEIGHT
9 30 00 - TILING	TS-1	SCHLUTER	RENO-V	SATIN ANODIZED ALUMINUM	COORDINATE WITH PCT	PCT to RSF
V. 5.4. 4.0. A.O.O.U.O.T.I.O.U. O.T.II. T.II. T.						
9 51 13 - ACOUSTICAL CEILING TILE 9 51 13 - ACOUSTICAL CEILING TILE	ACT-1	CERTAINTEED	HHF-457 HNRC: FINE FISSURED	WHITE (SQUARE LAY-IN)	24" x 24" (3/4" THICK)	VERIFY MATCH TO EXISTING
131 13 - ACOUSTICAL CEILING TILE	ACT-1	CERTAINTEED	HIGH NRC	WHITE (SQUARE LAT-IN)	24 X 24 (3/4 TRICK)	VERIFT WATCH TO EXISTING
9 65 13 - RESILIENT BASE & ACCESSORIES						
9 65 13 - RESILIENT BASE & ACCESSORIES	VB-1	JOHNSONITE (TARKETT)	TRADITIONAL VINYL BASE (COVE TOE)	MATCH EXISTING	4"H (1/8" THICK)	VERIFY MATCH TO EXISTING BASE PROFILE / HEIGH
	~~~	~~~~		~~~~~	~~~~	······
9 65 19 - RESILIENT SHEET FLOORING						
65 19 - RESILIENT SHEET FLOORING	RS-2 THRU 3	NOT USED				
65 19 - RESILIENT SHEET FLOORING	RSF-1	FLEXCO	CUSTOM SHEET RUBBER FLOORING	CUSTOM MATCH EXISTING RCA RUBBER 758 : FRESH CREAM	1/8" THICK x 36" WIDE ROLL	VERIFY MATCH TO EXISTING
9 65 19 - RESILIENT SHEET FLOORING	RSF-4	FLEXCO	CUSTOM SHEET RUBBER FLOORING	CUSTOM MATCH EXISTING RCA RUBBER 747 : BUTTERSCOTCH SWIRL	1/8" THICK x 36" WIDE ROLL	VERIFY MATCH TO EXISTING
9 91 20 - PAINT	سس	سسس	mmm	munum	www	mmmm
9 91 20 - PAINT 9 91 20 - PAINT	P-11		VARIES BY SUBSTRATE; SEE	MATCH EXISTING		VERIFY MATCH TO EXISTING
			SPECIFICATIONS			
9 91 20 - PAINT	P-12		VARIES BY SUBSTRATE; SEE SPECIFICATIONS	MATCH EXISTING		VERIFY MATCH TO EXISTING
9 91 20 - PAINT	P-13		VARIES BY SUBSTRATE; SEE SPECIFICATIONS	MATCH EXISTING COORIDOR GREEN ACCENT		VERIFY MATCH TO EXISTING
9 91 20 - PAINT	P-14		VARIES BY SUBSTRATE; SEE SPECIFICATIONS	MATCH EXISTING CORRIDOR YELLOW ACCENT		VERIFY MATCH TO EXISTING
9 9 1 20 - PAINT	P-15		VARIES BY SUBSTRATE; SEE SPECIFICATIONS	MATCH EX H.M. FRAMES		VERIFY MATCH TO EXISTING H.M. FRAMES
9 93 00 - STAINING AND TRANSPARENT FINISHING						
9 93 00 - STAINING AND TRANSPARENT FINISHING	ST-1	OLD MASTERS	PENETRATING STAIN	MATCHING EXISTING AND ARCH SAMPLE		
9 96 00 - HIGH PERFORMANCE COATINGS			1=.=		I	1
96 00 - HIGH PERFORMANCE COATINGS	SC-11		VARIES BY SUBSTRATE; SEE SPECIFICATIONS	MATCH P-1		
9 96 00 - HIGH PERFORMANCE COATINGS	SC-12		VARIES BY SUBSTRATE; SEE SPECIFICATIONS	MATCH P-2		
9 96 00 - HIGH PERFORMANCE COATINGS	SC-13		VARIES BY SUBSTRATE; SEE SPECIFICATIONS	MATCH P-3		
96 00 - HIGH PERFORMANCE COATINGS	SC-14		VARIES BY SUBSTRATE; SEE SPECIFICATIONS	MATCH P-4		
9 96 00 - HIGH PERFORMANCE COATINGS	SC-15		VARIES BY SUBSTRATE; SEE SPECIFICATIONS	MATCH EXISTING HOLLOW METAL FRAMES		H.M. DOOR FRAMES

SPECIFICATIONS

			EQUIPMENT & FURNI	30111G3 3	CHEDULE			
		ROOM	1	CONTR	RACTOR	EXIS		
TAG NO	TYPE	NO.	ROOM NAME	FURNISHED	INSTALLED	RELOCATED	TO REMAIN	Count
		,						,
E-110A	ELECTRIC COOKTOP	110	FCS	No	Yes	No	No	1
E-110B	ADJUSTABLE COUNTER LIFT	110	FCS	Yes	Yes	No	No	2
E-110C	ELECTRIC COOKTOP	110	FCS	No	No	Yes	Yes	1
E-142A	SHOP SINK	142	CTE	Yes	Yes	No	No	1
E-142B	EYE WASH STATION	142	CTE	Yes	Yes	No	No	1
E-142C	TABLE SAW	142	CTE	No	Yes	Yes	No	1
E-C126C	MARKER BOARD - 12'x5'	131	ART	Yes	Yes	No	No	1
E-C126C	MARKER BOARD - 12'x5'	133	ART	Yes	Yes	No	No	1

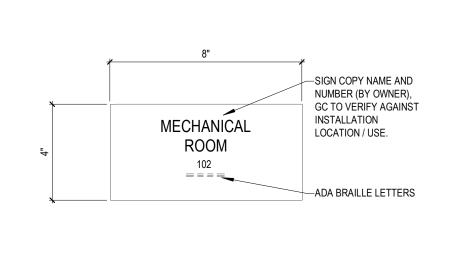

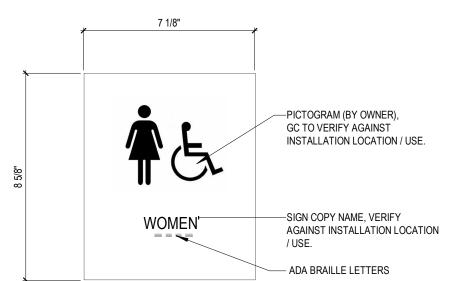

**RESTROOM** 

# **INTERIOR SIGNAGE NOTES:**

- . SIGNAGE SHALL BE PROVIDED BY OWNER'S OPERATIONS DEPARTMENT, INSTALLED BY CONTRACTOR TO MEET OWNER STANDARDS. OVERALL DIMENSIONS SHOWN REFLECT OWNER STANDARD; COPY/PICTOGRAM APPEARANCE / SIZE / LOCATION MAY VARY FROM SHOWN. ALL RESTROOMS WHERE WORK OCCURS TO HAVE ADA-COMPLIANT SIGNAGE INSTALLED BY CONTRACTOR, PROVIDED BY OWNER. 3. FOR BIDDING PURPOSES, CONTRACTOR TO ASSUME ALL ROOMS WHERE WORK IS SCHEDULED TO OCCUR SHALL RECEIVE NEW OWNER-PROVIDED ROOM NAME SIGNAGE (RESTROOM-SPECIFIC SIGNS AT RESTROOMS) TO BE INSTALLED BY CONTRACTOR. 4. VERIFY SIGNAGE TEXT AND NUMBERING AGAINST INSTALLATION LOCATION
- WITH OWNER PRIOR TO INSTALLATION. 5. SIGNAGE TO BE MOUNTED PER OWNER STANDARDS (VERIFY WITH OWNER AND AGAINST ANY ADJACENT EXISTING PRIOR TO INSTALLATION): A. SMALLER SIGNS TO BE 46" A.F.F. TO BOTTOM OF SIGN.
- B. LARGER SIGNS TO BE 56" A.F.F. TO BOTTOM OF SIGN. 6. SIGNAGE TO BE MOUNTED WITH DOUBLE STICK TAPE.

10/17/2023

EINISHES & DOOR AND I Lincoln Public Pound Middle 4740 S 45TH ST, LINCO

NOS

N

SOUKUP

A-3949


CARLSON WEST POVONDRA ARCHITECTS

5060 Dodge Street, Omaha, NE 68132

(402) 551-1500 Certificate of Authorization: CA-0308

- CONC CONCRETE
- FIBER-REINFORCED ABRASION RESISTANT EPOXY COATING
- GLASS / GLAZING GMGB GLASS MAT GYPSUM BOARD
- METAL PANEL MRGB MOISTURE-RESISTANT GYPSUM BOARD
- PORCELAIN TILE PLASTIC LAMINATE RCP REFLECTED CEILING PLAN
- RS/WS ROLLER SHADE/WINDOW SHADE SPECIALTY COATINGS (DIV.9 HIGH PERFORMANCE WALL PAINT)

- VINYL COMPOSITION TILE VINYL WALL COVERING WOOD BASE

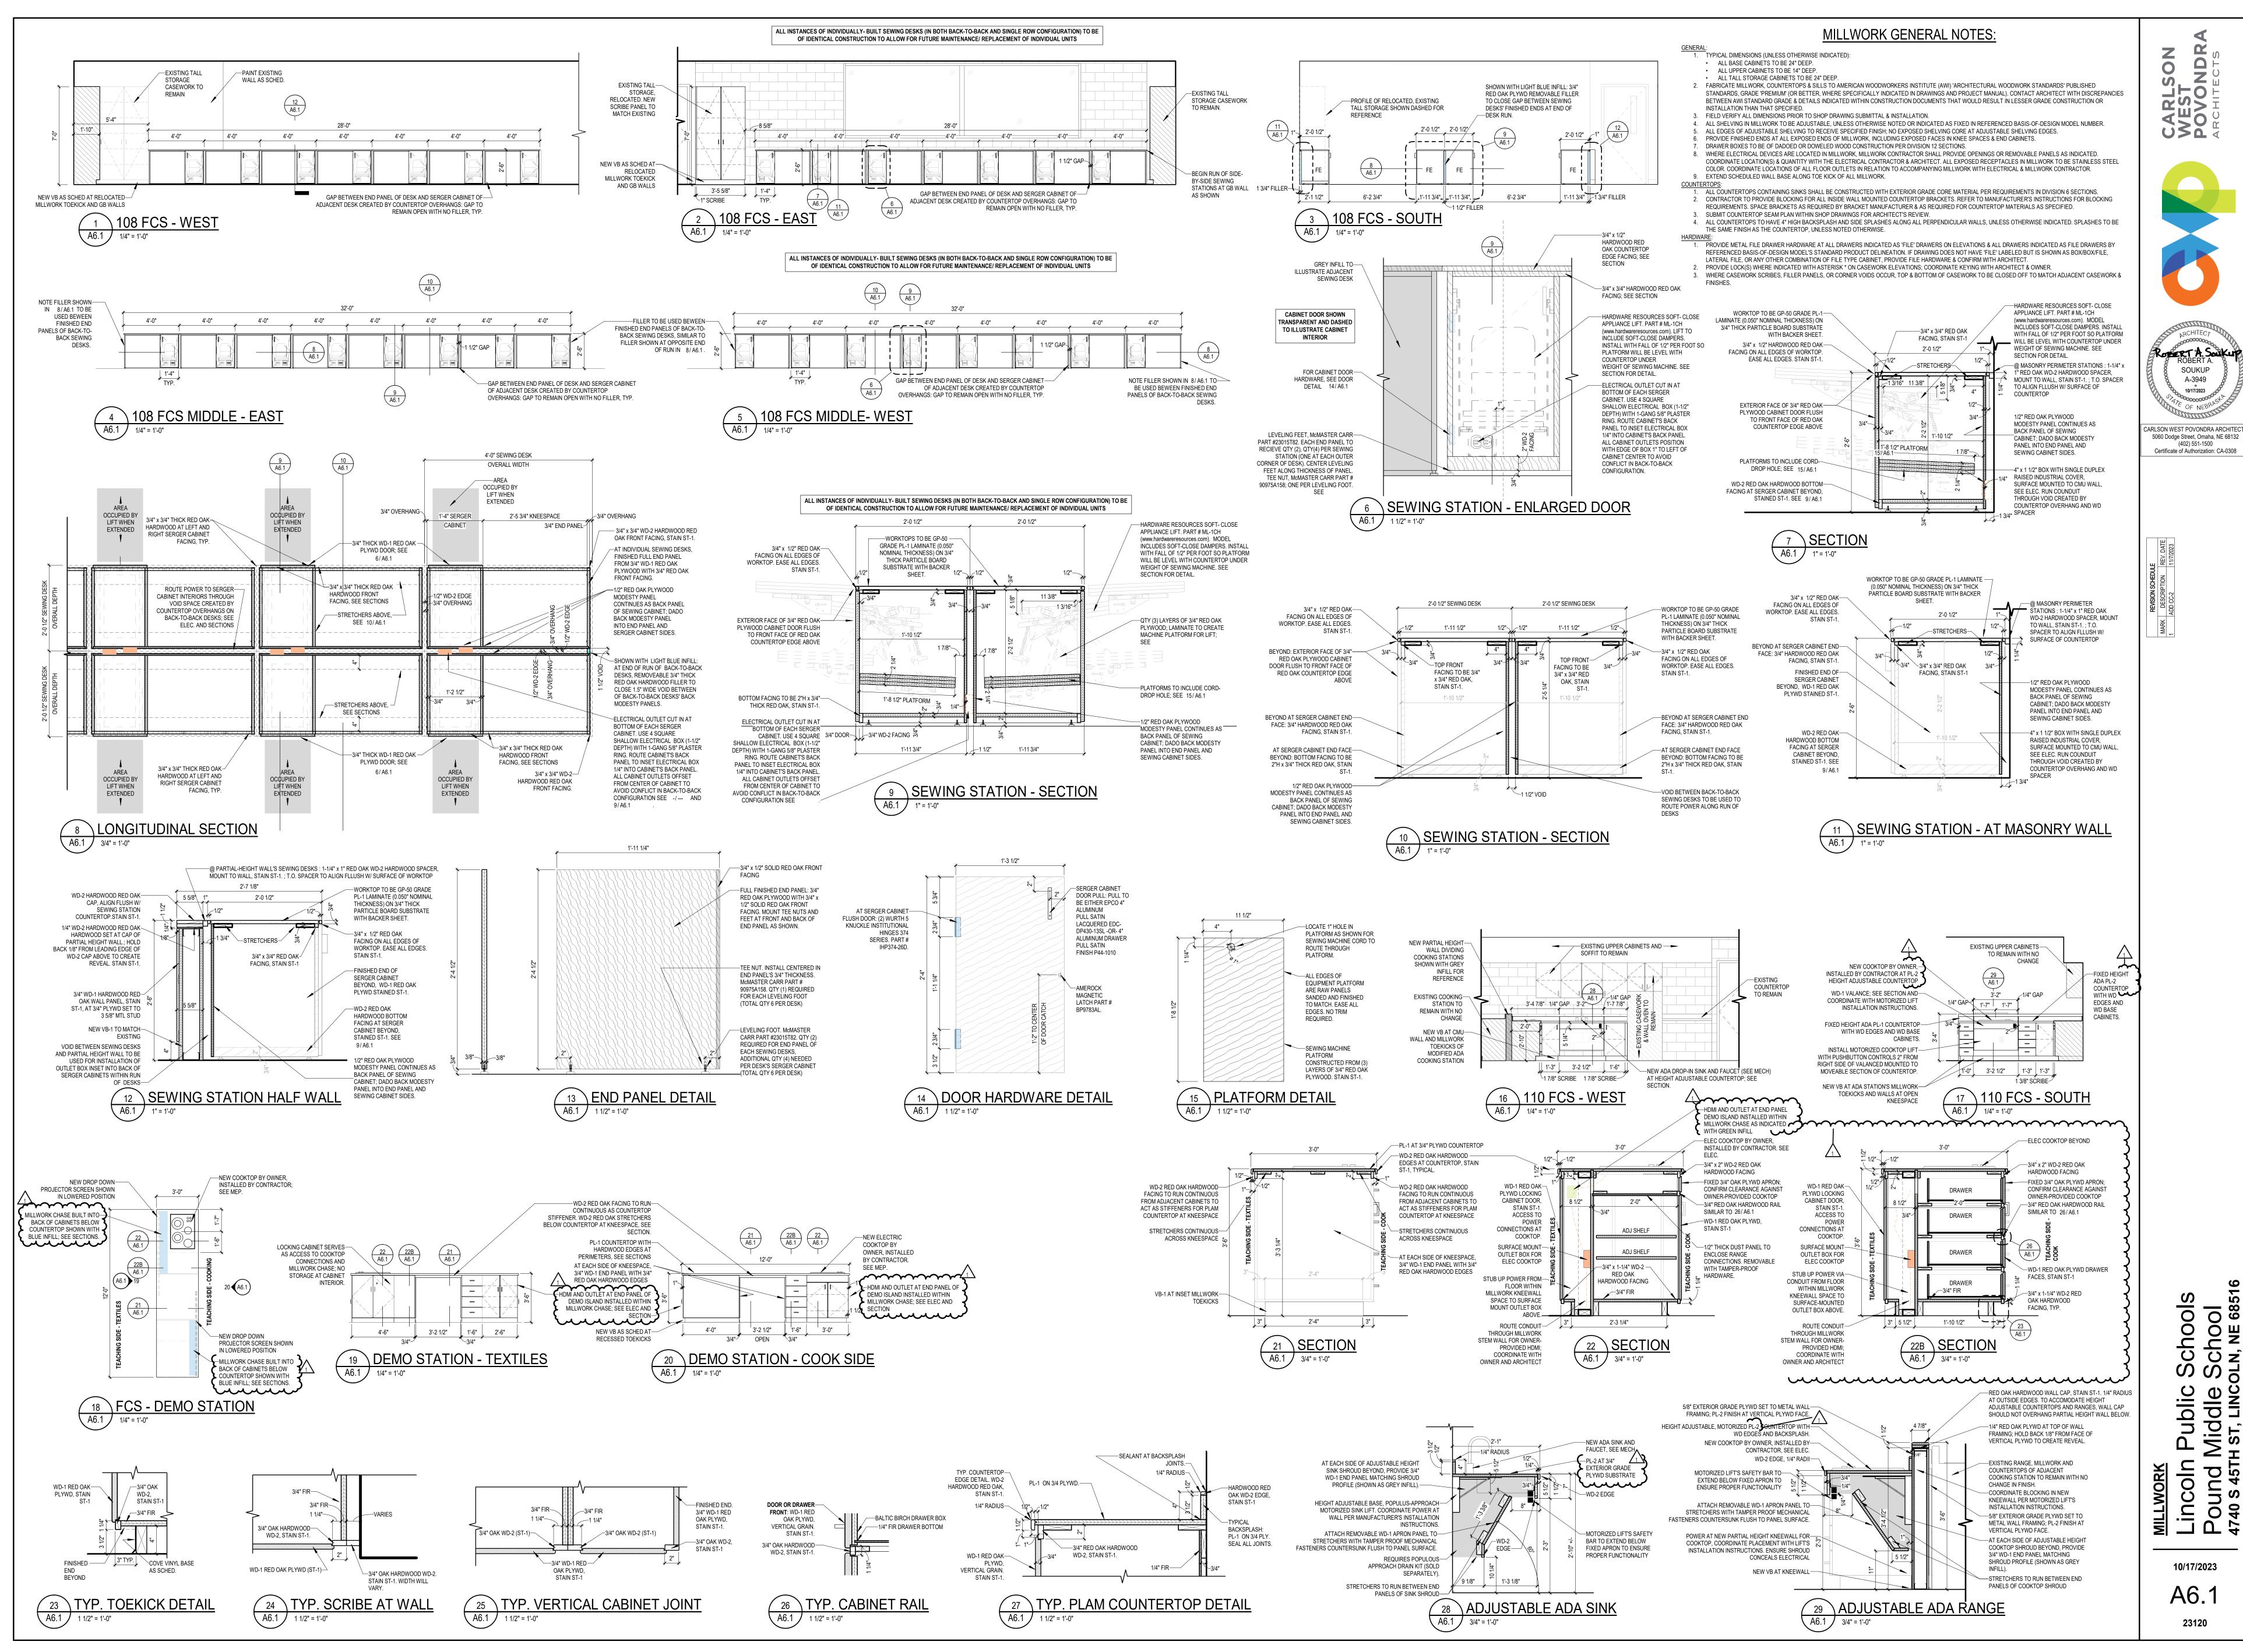


Z









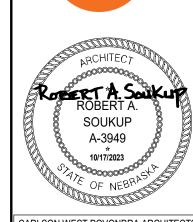


ARLSON WEST POVONDRA ARCHITECTS 5060 Dodge Street, Omaha, NE 68132 (402) 551-1500 Certificate of Authorization: CA-0308

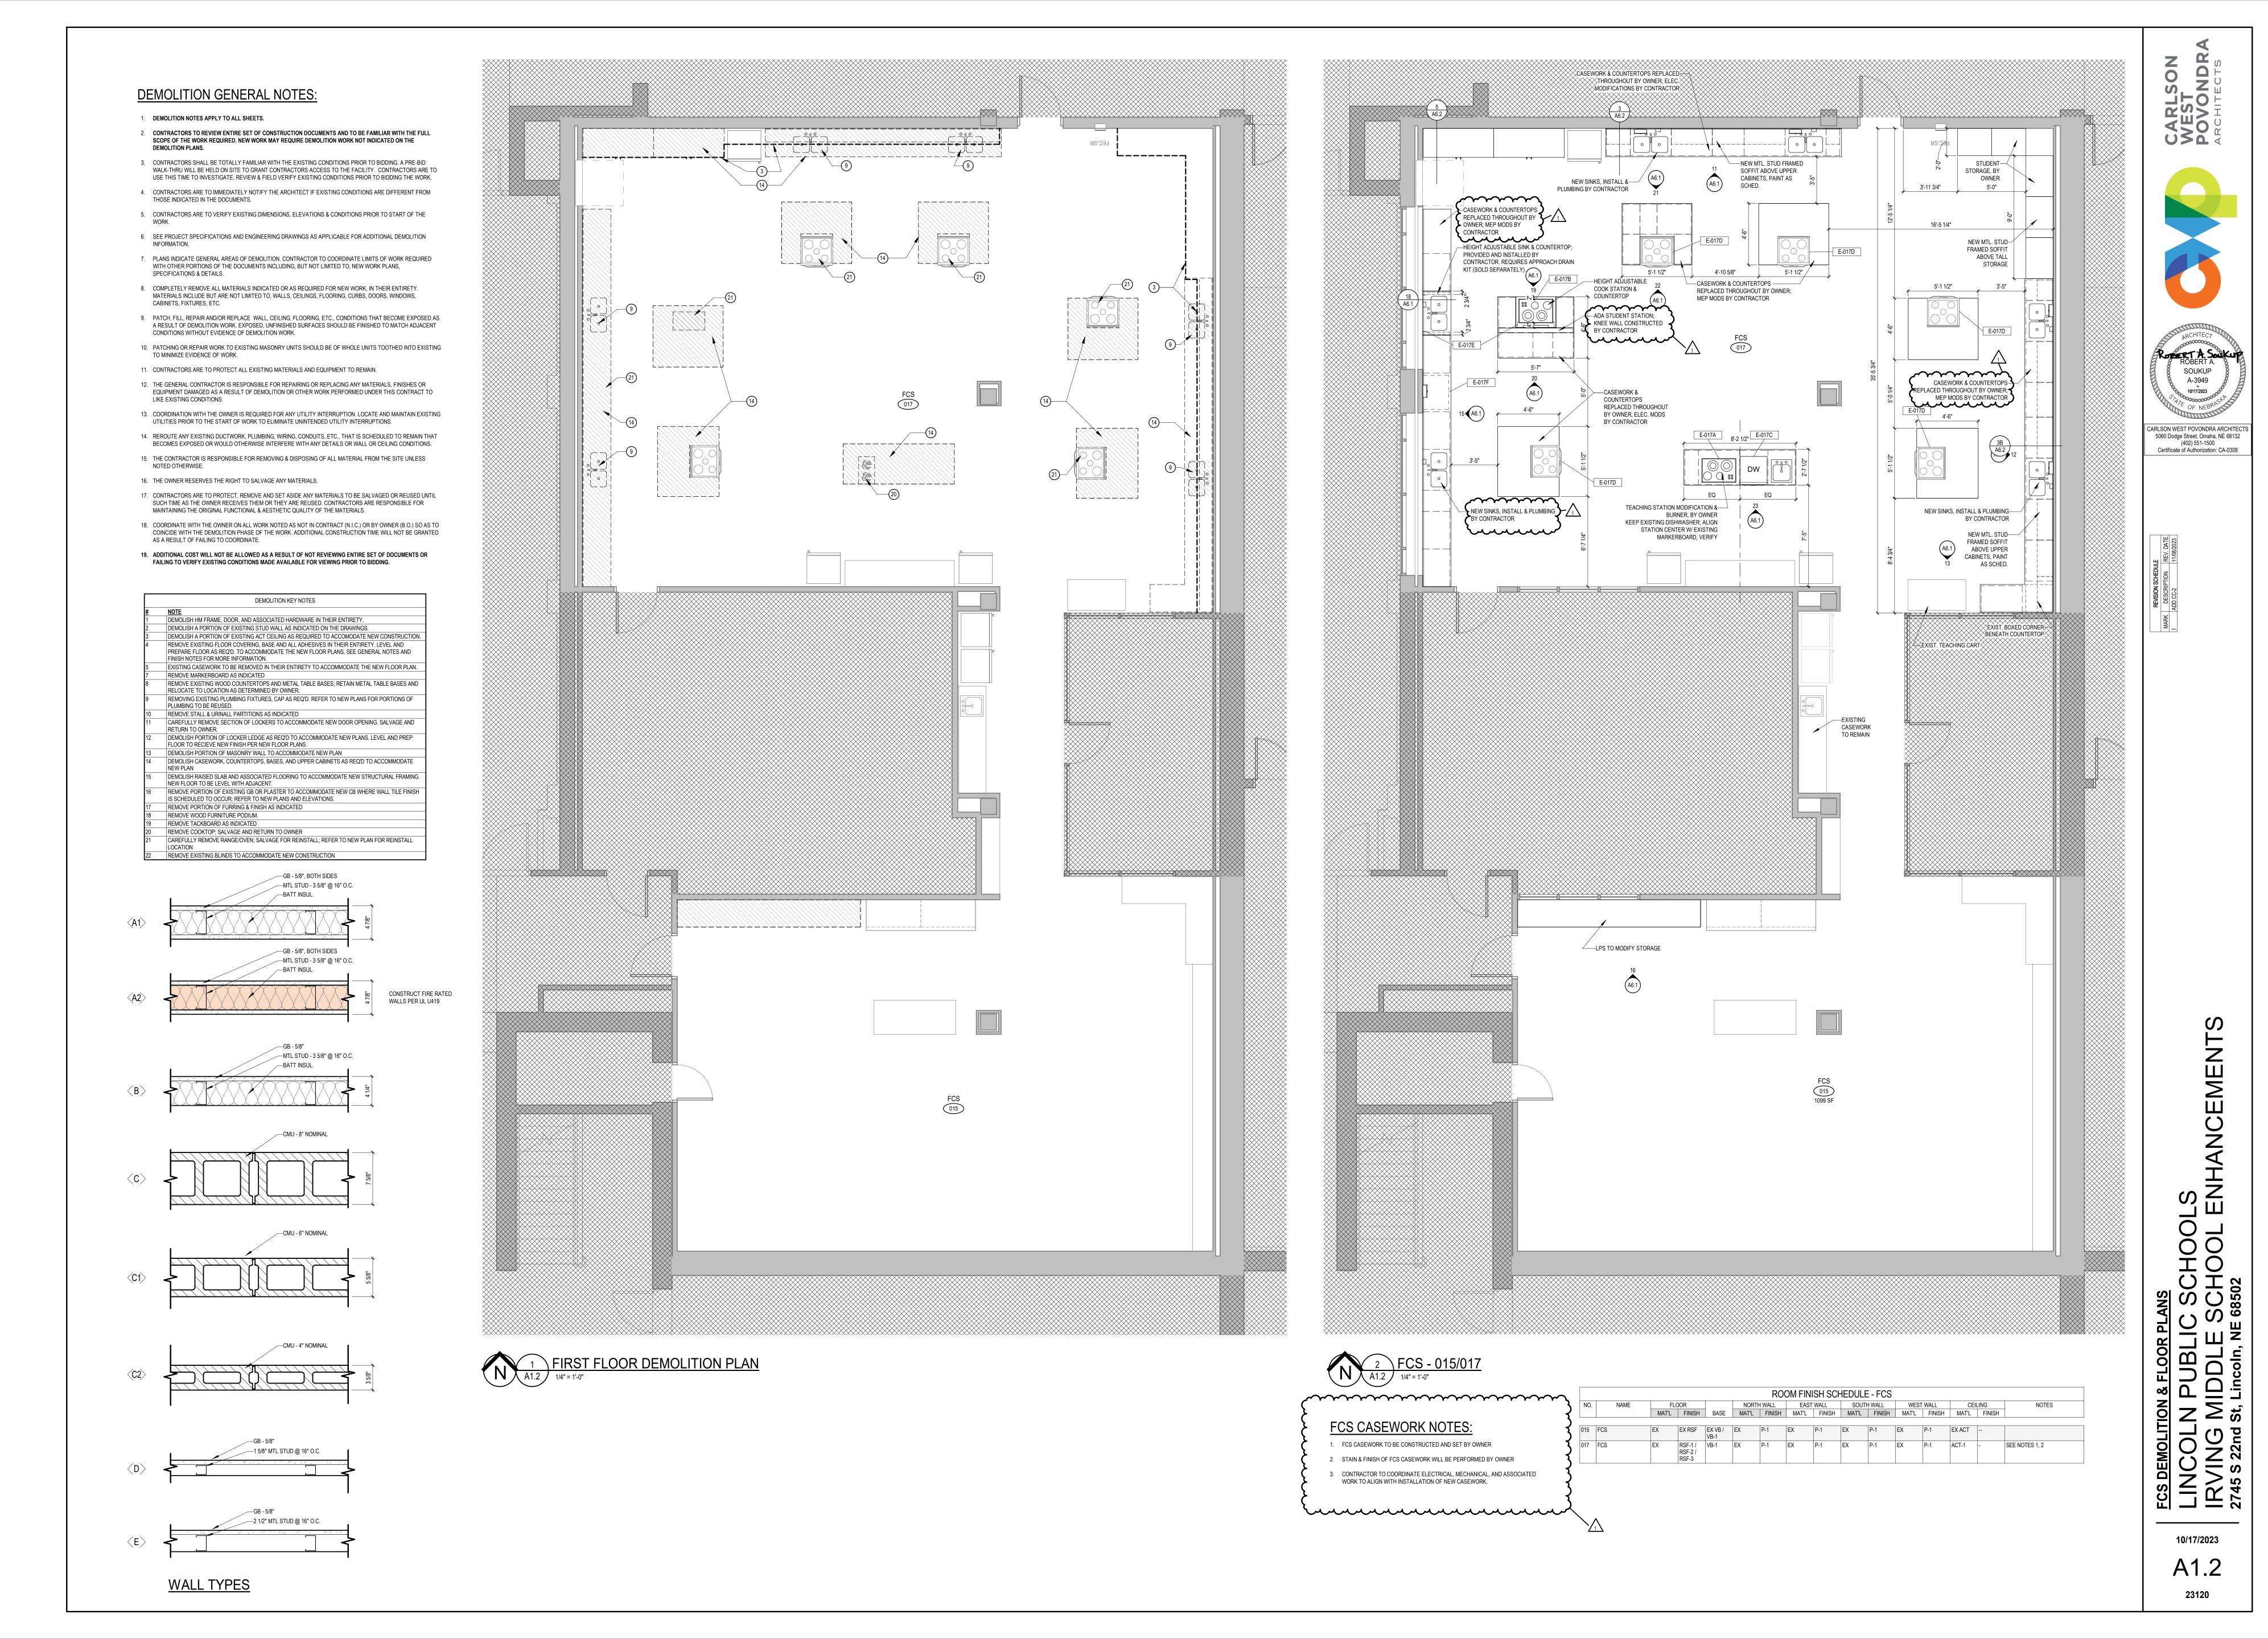

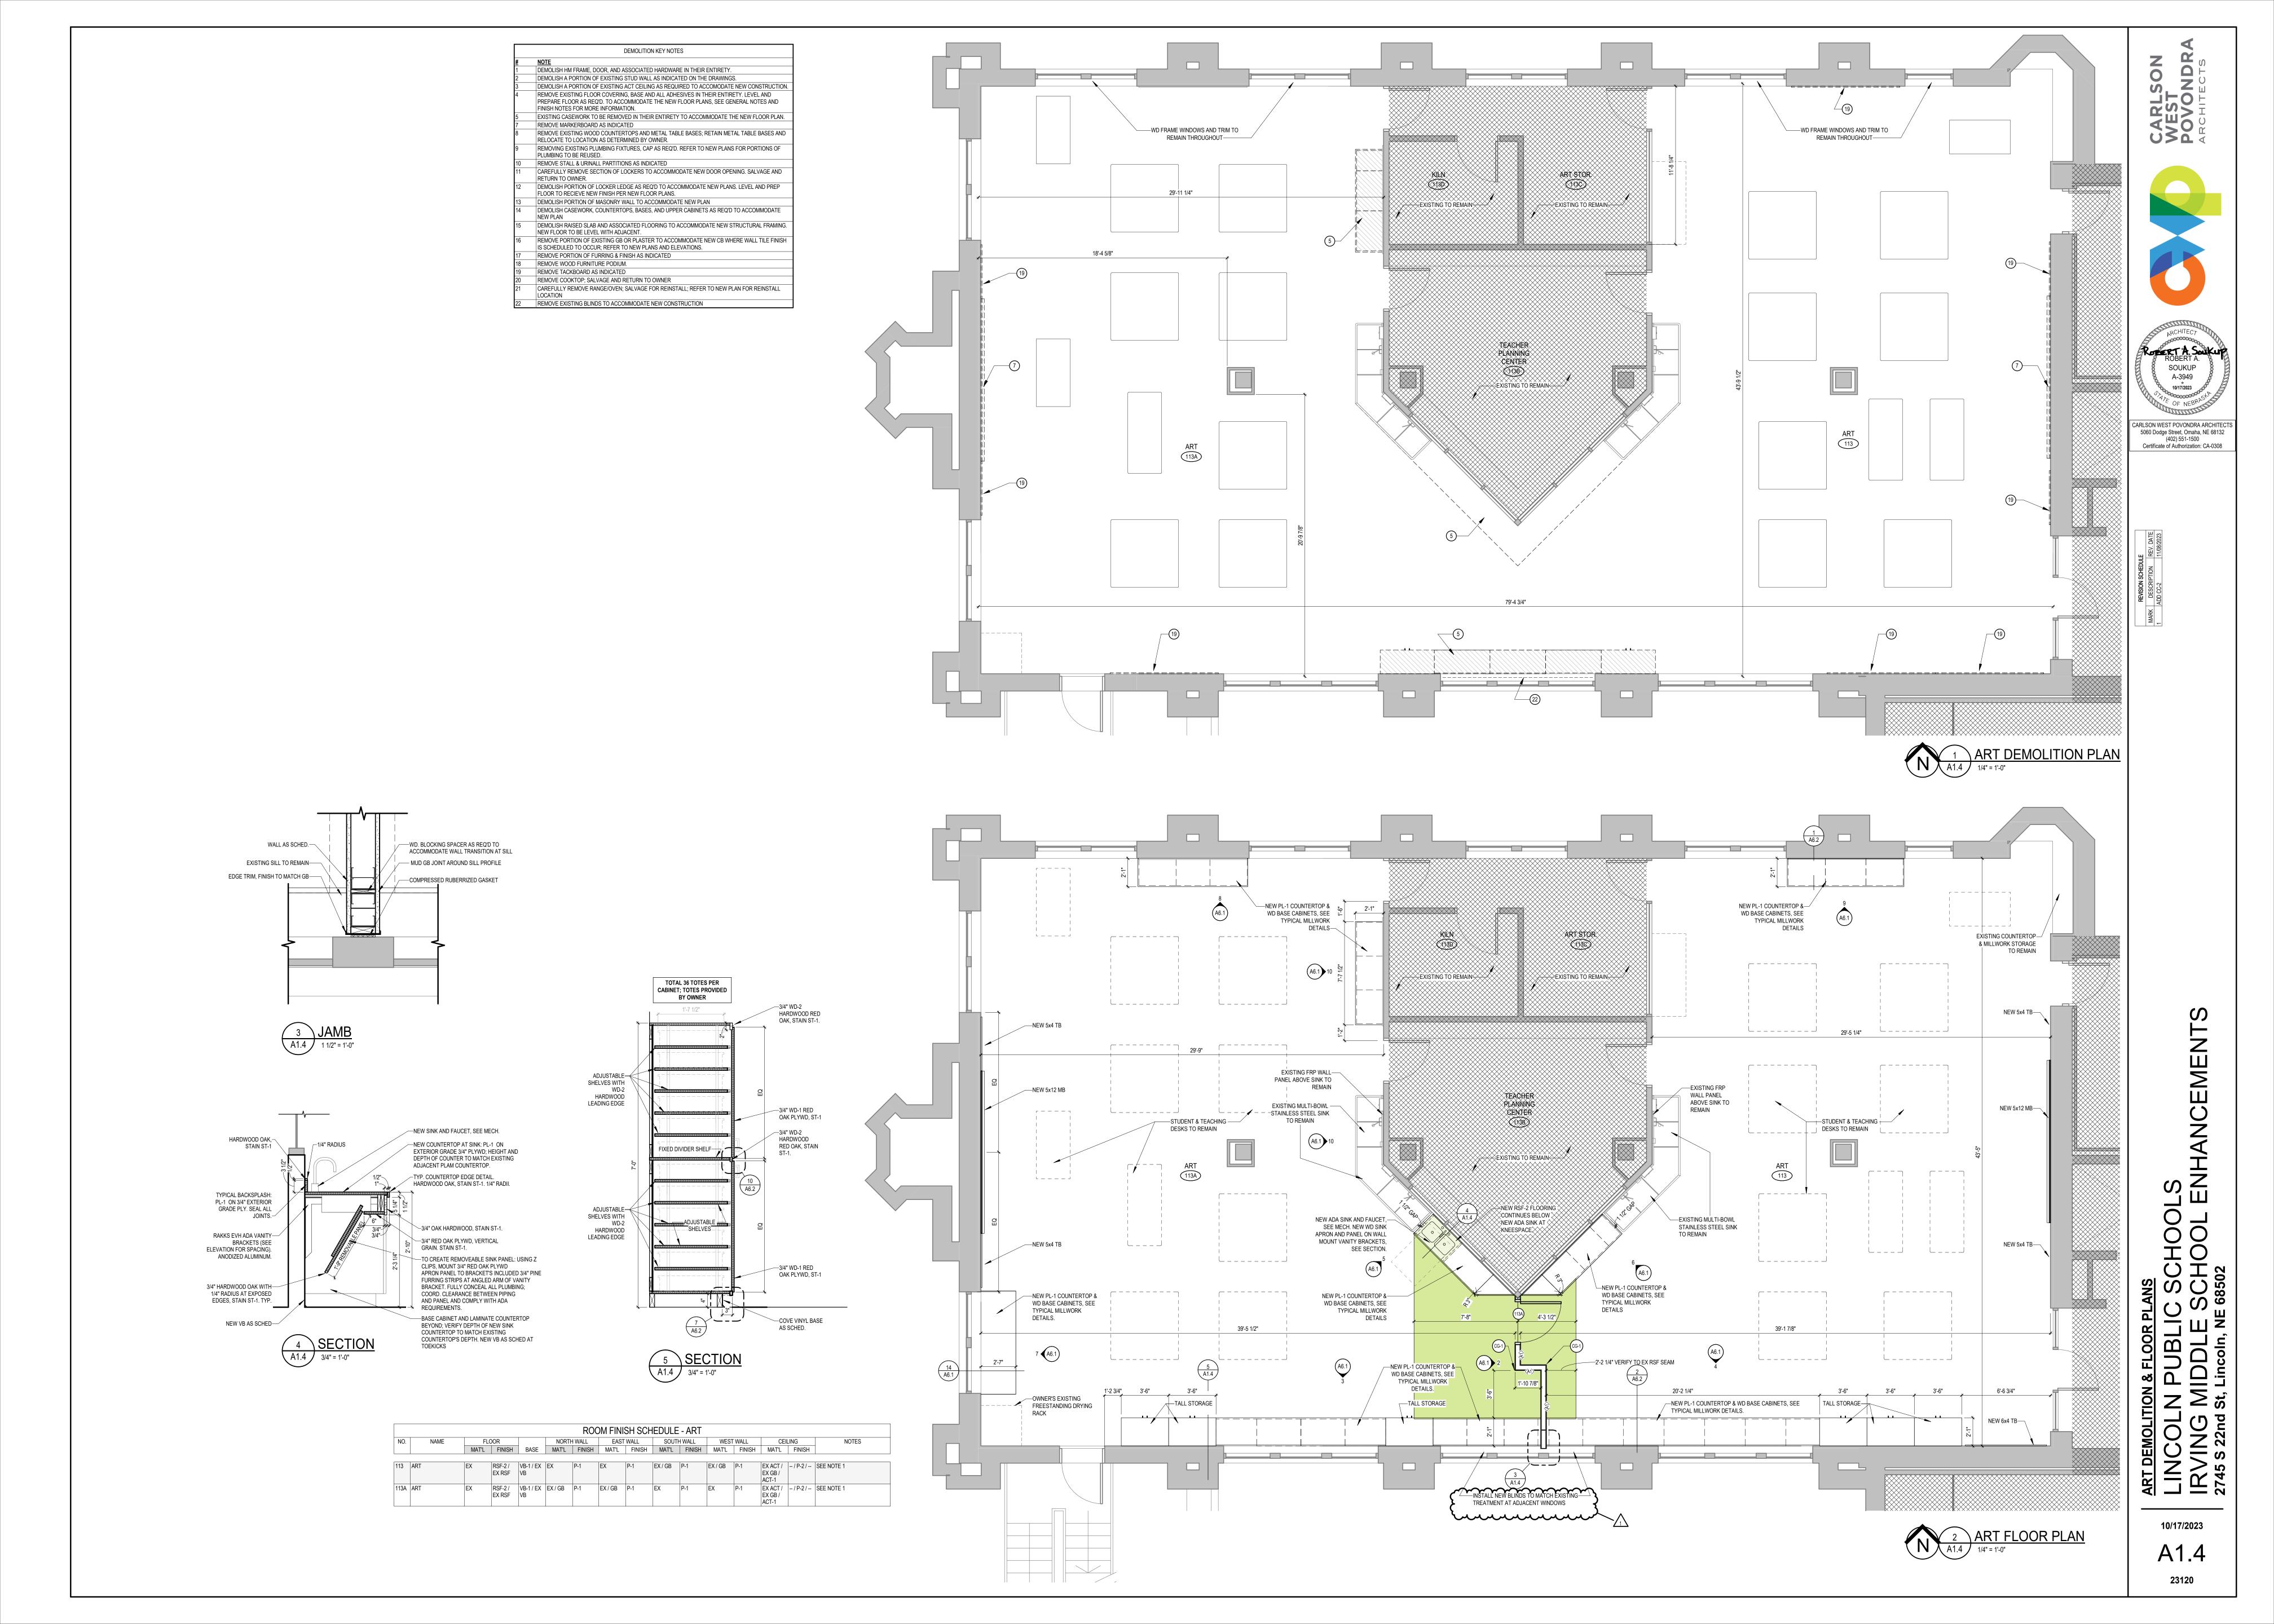

#### . HOLLOW METAL DOORS AND FRAMES ARE INDICATED ON THE FLOOR PLANS WITH A "SINGLE CIRCLE" REFERENCE AND ARE SHOWN ON THE DOOR AND FRAME SCHEDULE WITH THE MATERIAL REFERENCE "HM". 2. ALUMINUM DOORS AND FRAMES ARE INDICATED ON THE FLOOR PLANS WITH A "SINGLE HEXAGON" REFERENCE AND ARE SHOWN ON THE DOOR AND FRAME DOOR AND FRAME SCHEDULE SCHEDULE WITH THE MATERIAL REFERENCE "AL" FINISH ABBREVIATIONS 3. DOOR GLASS TYPES ARE INDICATED IN THE "GLASS" COLUMN ON THE DOOR AND **FINISH & MATERIAL GENERAL NOTES:** FRAME SCHEDULES. FRAME GLASS TYPES ARE INDICATED ON THE "FRAME TYPE" ELEVATIONS. SEE DIVISION 08 SECTION "GLAZING" FOR GLASS IN HOLLOW METAL DOORS AND FRAMES, WOOD DOORS AND ALUMINUM DOORS AND FRAMES. 4. COORDINATE DOOR UNDERCUTS WITH THRESHOLDS. 1. SEE INTERIOR ELEVATIONS, REFLECTED CEILING PLAN & FINISH PLAN FOR ALL LOCATIONS OF MULTIPLE FINISHES. ACT ACOUSTIC CEILING TILE 5. SET GLAZING TAPES/COMPOUNDS A MINIMUM 1/4" BELOW EXPOSED FACE OF 2. VERIFY CONDITIONS OF FLOORS & WALLS SCHEDULE TO RECEIVE NEW FINISHES WITH THE INSTALLER OR PRODUCT AFF ABOVE FINISHED FLOOR GLASS STOP AT ALL DOORS AND FRAMES MANUFACTURERS' REPRESENTATIVE, PRIOR TO FINISH INSTALLATION. PATCH AND/OR REPAIR HOLES & ALUM ALUMINUM 6. INSTALL EXTERIOR FRAMES WITH 1/4" SHIM AND SEALANT AROUND PERIMETER OF DEPRESSIONS TO PROVIDE A SMOOTH FINISHED SURFACE. AWP ACOUSTIC WALL PANEL 3. INSTALL ALL FINISHES PER MANUFACTURER'S RECOMMENDATIONS; IMMEDIATELY NOTIFY ARCHITECT IN WRITING OF BRICK 7. SPLIT DOOR & FRAME COLOR: P-6 AT LOBBY SIDE; P-3 AT OFFICE SIDE. DOOR AND FRAME SCHEDULE EXISTING CONDITIONS OF CONSTRUCTION DETRIMENTAL OR PROHIBITIVE TO MANUFACTURER-RECOMMENDED INSTALLATION CEMENTITIOUS BOARD 8. SPLIT DOOR & FRAME COLOR: P-3 AT INTERIOR SIDE; P-2 AT EXTERIOR SIDE. CORNER GUARD 9. REFER TO MATERIALS SCHEDULE ON A1.# FOR FINISH COLOR SELECTIONS; 4. FOR ALL 'MATCH EXISTING' FINISHES, MULTIPLE SAMPLES OF DIFFERENT STYLES AND/OR COLORS MAY BE REQUIRED. CERAMIC MOSAIC TILE CONTACT ARCH. OFFICE WITH ANY QUESTIONS. VERIFY EXACT STYLES & COLORS ON SITE AND SUBMIT SAMPLES FOR ARCHITECT'S APPROVAL PRIOR TO CONCRETE MASONRY UNIT 10. SEE SPECIFICATION 087100, PARAGRAPH 2.8.B FOR SPECIFIC REQUIREMENTS INSTALLATION. CONC CONCRETE REGARDING PROCUREMENT AND INSTALLATION OF KEY CYLINDERS. FLOOR SURFACES SHOULD HAVE NO MORE THAN 1/4" VARIANCE PER 10 LINEAR FEET WHEN READY TO RECEIVE FINISH CERAMIC TILE MATERIALS, REPAIR EXISTING FLOORS TO MEET REQUIREMENTS IF NECESSARY EPOXY RESINOUS FLOORING **GLAZING TYPES** 2. CONTRACTOR TO VERIFY SCHEDULED FLOOR TRANSITION STRIP PROFILES & SIZE AGAINST FLOORING MATERIALS EXPOSED STRUCTURE (BOTH NEW & EXISTING) FOR ADA COMPLIANCE PRIOR TO INSTALLATION, INCLUDING ANY NEEDED FOR RAMPED FIBER-REINFORCED ABRASION RESISTANT EPOXY COATING SEE PROJECT SPECIFICATIONS FOR ADDITIONAL A. PROVIDE FLOOR PLAN NOTING EACH TRANSITION STRIP AS INDICATED IN THE MATERIALS SCHEDULE & LOCATION FIBERGLASS REINFORCED PANELING INFORMATION. OF FLOOR TRANSITION STRIPS FOR ARCHITECT'S REVIEW. B. WHERE FLOOR MATERIAL TRANSITIONS HAVE SAME MATERIAL THICKNESS, DO NOT INSTALL TRANSITION STRIP GYPSUM BOARD CTG CLEAR TEMPERED GLASS BETWEEN MATERIALS UNLESS OTHERWISE NOTED. INSTALL FLOORING WITH TIGHT JOINTS AND NO VISIBLE GLASS / GLAZING GMGB GLASS MAT GYPSUM BOARD C. FOR ALL TRANSITION STRIPS (TS.#), TRANSITIONS OF FLOORING MATERIALS TO OCCUR UNDER DOOR IN THE GLASS TILE DOOR & FRAME SCHEDULE NOTES: CLOSED POSITION UNLESS OTHERWISE INDICATED IN THE DRAWINGS. HGB HIGH-IMPACT / ABUSE RESISTANT GYPSUM BOARD EXISTING DOOR & FRAME GLAZING TO RECEIVE OPAQUE VINYL FILM D. CONSULT ARCHITECT WITH QUESTIONS ON FLOOR TRANSITIONS & TRANSITION STRIPS PRIOR TO ORDERING LOCKERS 2. REFER TO SPECIFCATIONS FOR ACCESS PANEL DETAILED INFORMATION METAL PANEL 3. SEE DOOR & FRAME SCHEDULE FOR PAINT FINISHES ON HM DOORS & DOOR FRAMES. COORDINATE WITH MATERIALS MRGB MOISTURE-RESISTANT GYPSUM BOARD SCHEDULE & SPECIFICATIONS. NO FINISH 4. CONTINUE FLOOR FINISHES & PATTERNS BENEATH EQUIPMENT, MOVEABLE ITEMS & OPEN (KNEE SPACE) MILLWORK. OPERABLE WALL PARTITION 5. FLOOR DRAIN GRATES TO BE SET AT 90° TO FLOORING PATTERN. IF FLOORING DOES NOT HAVE A PATTERN TO ALIGN PAINT PORCELAIN FLOOR TILE TO, GRATE TO BE SET AT 90° TO ADJACENT WALL(S). PORCELAIN WALL TILE 1. ALL WALL FINISHES SHOWN ON FINISH PLAN ARE FOR CLARIFICATION ONLY; COORDINATE FINISHES WITH THE ROOM PLASTIC LAMINATE FINISH SCHEDULE. WHERE DISCREPANCIES BETWEEN THE ROOM FINISH SCHEDULE, FINISH PLAN, DETAILS OR RS/WS ROLLER SHADE/WINDOW SHADE ELEVATIONS OCCUR, CONTACT ARCHITECT'S OFFICE IMMEDIATELY FOR CLARIFICATION PRIOR TO PROCEEDING. RSF RUBBER SHEET FLOORING 2. CONTRACTOR SHALL PROVIDE ALL BLOCKING AS REQUIRED FOR WALL MOUNTED ACCESSORIES & SPECIALTY RUBBER STAIR TREAD EQUIPMENT, INCLUDING BUT NOT LIMITED TO ALL TOILET & BATH ACCESSORIES, MARKER BOARDS, TACK BOARDS, SPECIAL COATINGS AUDIO VISUAL & MEP INDICATED EQUIPMENT. CONTRACTOR TO PROVIDE BLOCKING FOR WALL MOUNTED ITEMS (DIV.9 SECTION HIGH PERFORMANCE SPECIAL WALL COATINGS) INDICATED BY OTHERS. SCONC SEALED CONCRETE SSM SOLID SURFACE MATERIAL 3. WHERE PRODUCTS OR EQUIPMENT PLACEMENT SPANS FROM TILE TO DRYWALL OR OTHER MATERIAL, PROVIDE WHITE UHMW PLASTIC FILLER OF THE SAME THICKNESS AS TILE BEHIND PRODUCT, AT DRYWALL OR OTHER RCP REFLECTED CEILING PLAN MATERIAL. THIS MAY OCCUR AT (BUT IS NOT LIMITED TO) TOILET PARTITIONS, MIRRORS OR OTHER TOILET & BATH SEALED ACCESSORIES. STAIN TRANSITION STRIP CEILINGS: 1. SEE REFLECTED CEILING PLAN(S) FOR ALL ROLLER SHADE (RS-#) LOCATIONS AND DETAILS. FG - EX. HM1 VINYL BASE NARROW LITE HALF LITE FULL GLASS MECHANICAL & ELECTRICAL & OWNER PROVIDED COORDINATION: VINYL COMPOSITION TILE EXISTING 1. SEE ELECTRICAL DRAWINGS FOR ALL FLOOR RECEPTACLE LOCATIONS. COORDINATE MILLWORK OPENINGS WITH VINYL WALL COVERING ELECTRICAL LOCATIONS WHERE OCCURRING. WOOD BASE 2. ALL LOUVRES, VENTS, GRILLES, DUCTWORK & OTHER MISCELLANEOUS MECHANICAL & ELECTRICAL DEVICES IN WD WOOD FRAME TYPES **DOOR TYPES** EXPOSED LOCATIONS SHALL BE PAINTED TO MATCH THE SURFACE IN WHICH THEY APPEAR, UNLESS OTHERWISE WPM WATERPROOF MEMBRANE 3. PAINT ALL EXPOSED FIRE SUPPRESSION (BOTH NEW AND EXISTING) SPRINKLER PIPING; PAINT TO MATCH ADJACENT SURFACE. 4. ALL FURNITURE SHOWN ON PLANS TO BE PROVIDED BY OWNER AND SHOWN FOR REFERENCE ONLY. CONTRACTOR SEE FLOOR PLAN FOR-TO VERIFY FURNITURE LAYOUT WITH OWNER AND OWNER'S FURNITURE VENDOR. CONTRACTOR TO COORDINATE POWER & DATA CONNECTIONS AT FURNITURE WITH VENDOR & IN ACCORDANCE WITH CONSTRUCTION DOCUMENTS WALL TYPE [SEE ELECTRICAL]. FINISHES AS SCHED.-—CG AS SCHED. MATERIALS SCHEDULE —5/8" GB ON 2 1/2" MTL. STUD MANUFACTURER FINISHES KEYNOTES: —DOOR & FRAME AS SCHED. # FINISHES TAG; SEE FASARA GLASS FINISHES SH2MAOW: OPAQUE WHITE 1270 mm x 30 m ROLLS MATERIALS SCHEDULE 06 40 23 - INTERIOR ARCHITECTURAL CASEWORK # LEVEL 5 GB WALL FINISH; HPL, HORIZONTAL GRADE GP-50 4166-60 : PAMPAS (MATTE FINISH) SEE MATERIALS SCHEDULE RED OAK 7-PLY PLYWD (A-2 STAINED ST-1 (10) ROOM FINISH & MATERIAL PREMIUM, ROTARY CUT) SCHEDULE NOTE SEE DETAILS SOLID RED OAK HARDWOOD **TOILET ACCESSORIES** COLOR WHEEL CLASSIC 4.25" x 4.25" TREATED WD FRAMING, SHIM AS REQ'D DALTILE COLOR WHEEL CLASSIC ALMOND (GLOSS) 4.25" x 4.25" COLOR WHEEL CLASSIC BLACK (GLOSS) 4.25" x 4.25" `-5/8" GB ON 3 5/8" MTL. STUD EXISTING MASONRY, VERIFY— ACCUCOLOR TO BE SELECTED FROM FULL RANGE MATCH PCT-1 MOSAIC FOR USE WITH PCT-1 and PCT-1B CONSTRUCTION IN FIELD BLOCKING AS REQ'D-MATCH EXISTING AT 4.25" SQUARE CT MATCH EXISTING GROUT FOR USE WITH CT-1 and CT-2 ACCUCOLOR -----5/8" GB ON 1 5/8" MTL. STUD JOINT SIZE 5/8" GB ON 3 5/8" MTL. STUD-AMERICAN OLEAN UNGLAZED MOSAICS 0A94: WILLOW SPECKLE x 2" MESH MOUNT MOSAIC MINERAL WOOL INSUL.-PCT-1B AMERICAN OLEAN UNGLAZED MOSAICS 0A94: WILLOW SPECKLE 09 51 13 - ACOUSTICAL CEILING TILE -THIN BRICK AS SPECIFIED, 24" x 24" (3/4" THICK) VERIFY MATCH TO EXISTING ALIGN TOP W/ ADJACENT ACT-1 CERTAINTEED HHF-457 HNRC: FINE FISSURED WHITE (SQUARE LAY-IN) A1.6 1 1/2" = 1'-0 A1.6 / 1 1/2" = 1'-0" 09 65 13 - RESILIENT BASE & ACCESSORIES TRADITIONAL VINYL BASE TO MATCH EXISTING VERIFY MATCH TO EXISTING JOHNSONITE (TARKETT) <del>ᢇᠬ</del>ᢇᠬ᠇ᢇᡤᢇᠬᢇᡤ᠇ᠬ᠇ᡤ᠇ᠬ᠇ᠬᡤ᠇ᠬ᠇ᡤ᠇ᠬᡤ᠇ᠬᡤ᠇ᠬ᠇ᢇᢇᡤ CUSTOM SHEET RUBBER CUSTOM MATCH EXISTING RCA RUBBER 1/8" THICK x 36" WIDE ROLL RSF-1 FLEXCO SEE FLOOR PLAN FOR-758: FRESH CREAM WALL TYPE RSF-2 FLEXI-FLOOR: SHEET RUBBER | CUSTOM MATCH EXISTING RCA RUBBER | 1/8" THICK x 36" WIDE ROLL FLOORING 711 · DOVF GREY FINISHES AS SCHED. ----CG AS SCHED. RSF-3 FLEXI-FLOOR: SHEET RUBBER | CUSTOM MATCH EXISTING RCA RUBBER | 1/8" THICK x 36" WIDE ROLL FLOORING 604 : BLACK MARBLE UN PAINTING AND COATING —GYP. BD - 5/8" ----5/8" GB ON 2 1/2" MTL. STUD —SEALANT - BOTH SIDES VARIES BY SUBSTRATE; SEE MATCH EXISTING MAIN PAINT; VERIFY MATCH TO EXISTING **SPECIFICATIONS** SHERWIN WILLIAMS MATCH EXISTING CEILING WHITE GB CEILINGS VARIES BY SUBSTRATE; SEE —DOOR & FRAME AS SCHED. ----HM FRAME VARIES BY SUBSTRATE: SEE MATCH EXISTING H.M. FRAMES H.M. FRAMES AND DOORS ---DOOR AS SCHED. SPECIFICATIONS VARIES BY SUBSTRATE; SEE SPECIFICATIONS PENETRATING STAIN MATCHING EXISTING AND ARCH SAMPLE SUBMIT SAMPLE TO ARCHITECT FOR APPROVAL NEW PCT-1 to ex RSF TREATED WD FRAMING, SHIM AS REQ'D NEW RSF to EX STORAGE flooring ----5/8" GB ON 3 5/8" MTL STUD COORDINATE WITH CT / PCT PCT-1/1B to CT-1 SCHIENE EXISTING MASONRY, VERIFY-CONSTRUCTION IN FIELD -----5/8" GB ON 1 5/8" MTL. STUD 5/8" GB ON 3 5/8" MTL. STUD-ROOM FINISH SCHEDULE NOTES: EXISTING ACT-1 GRID TO REMAIN, REPLACE PADS ONLY AS NECESSARY TO 4 HM FRAME - MTL. STUD FINISHES TO MATCH ADJACENT EXISTING CONDITIONS. 4. CPT-1 SELECTION TO MATCH EXISTING CONDITIONS A1.6 / 1 1/2" = 1'-0"

DOOR & FRAME GENERAL NOTES:

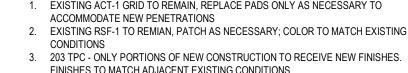

ROOM FINISH SCHEDULE

TB-1 / EX EX

CT-2 / MRGB CT-2 / SC-1

P-1 / TB-1 EX

MRGB

113A ART

180 CORRIDOR

EX RSF-1

NORTH WALL EAST WALL SOUTH WALL WEST WALL

NOTES

SC-1

SEE NOTES 1, 2


SEE NOTE 1

SEE NOTES 1, 3, 4

EX ACT / -- / P-2 / -- SEE NOTE 1

EX ACT / -- / P-2 / -- SEE NOTE 1

EX/CMU P-2 EX ACT-1 -

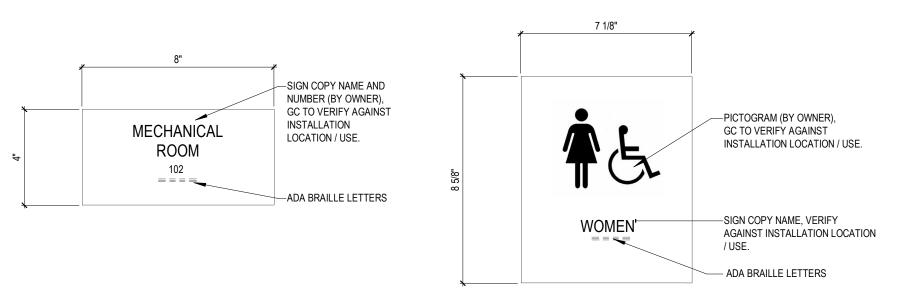

**EQUIPMENT & FURNISHINGS SCHEDULE** 

ROOM NAME

E-017A COOKTOP E-017B COOKTOP E-017C DISHWASHER E-017D RANGE

E-021A-A BAND SAW E-021A-B TABLE SAW

E-017E ADJUSTABLE COUNTER LIFT E-017F OVEN - BELOW COUNTER

CONTRACTOR

FURNISHED INSTALLED RELOCATED TO REMAIN

Yes Yes

**ROOM NUMBER** 

- SIGNAGE SHALL BE PROVIDED BY OWNER'S OPERATIONS DEPARTMENT, INSTALLED BY CONTRACTOR TO MEET OWNER STANDARDS. OVERALL DIMENSIONS SHOWN REFLECT OWNER STANDARD; COPY/PICTOGRAM APPEARANCE / SIZE / LOCATION MAY VARY FROM SHOWN. ALL RESTROOMS WHERE WORK OCCURS TO HAVE ADA-COMPLIANT SIGNAGE INSTALLED BY CONTRACTOR, PROVIDED BY OWNER. FOR BIDDING PURPOSES, CONTRACTOR TO ASSUME ALL ROOMS WHERE WORK IS SCHEDULED TO OCCUR SHALL RECEIVE NEW OWNER-PROVIDED ROOM NAME SIGNAGE (RESTROOM-SPECIFIC SIGNS AT RESTROOMS) TO BE INSTALLED BY CONTRACTOR. 4. VERIFY SIGNAGE TEXT AND NUMBERING AGAINST INSTALLATION LOCATION WITH OWNER PRIOR TO INSTALLATION.
- 5. SIGNAGE TO BE MOUNTED PER OWNER STANDARDS (VERIFY WITH OWNER AND AGAINST ANY ADJACENT EXISTING PRIOR TO INSTALLATION): A. SMALLER SIGNS TO BE 46" A.F.F. TO BOTTOM OF SIGN.
- B. LARGER SIGNS TO BE 56" A.F.F. TO BOTTOM OF SIGN. 6. SIGNAGE TO BE MOUNTED WITH DOUBLE STICK TAPE.


10/17/2023



Z O

ND



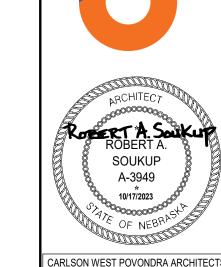

5060 Dodge Street, Omaha, NE 68132

(402) 551-1500

Certificate of Authorization: CA-0308

NOTE: CONTRACTOR TO VERIFY

WD1 - EX.

EXISTING FRAME

QUANTITY OF FRAME TYPES W/ FLOOR

OCCUR IN MORE THAN ONE LOCATION.

-EXISTING MASONRY, VERIFY

-CMU SOAP INFILL

-SHIM, BACKER ROD &

SEALANT BOTH SIDES

—HM FRAME, AS SCHED.

—DOOR AS SCHED.

—DOOR AS SCHED.

—FLOOR ANCHORS

—HM FRAME, AS SCHED.

JAMB MINIMUM

-DOOR AS SCHED.

SEALANT BOTH SIDES

-HM FRAME, AS SCHED.

EACH SIDE - TYPICAL

—FINISH FLOOR AS SCHED.


-JAMB ANCHORS - (3) PER

LINTEL - SEE STRUCT.


WALL CONSTRUCTION IN FIELD


PLANS. SOME FRAME ELEVATIONS

EME FRAME SCHEDULE LS ENH, FINISHES, EQUIPMENT & LINCOLN PUBLIRVING MIDDL 2745 S 22nd St, Lincoln,

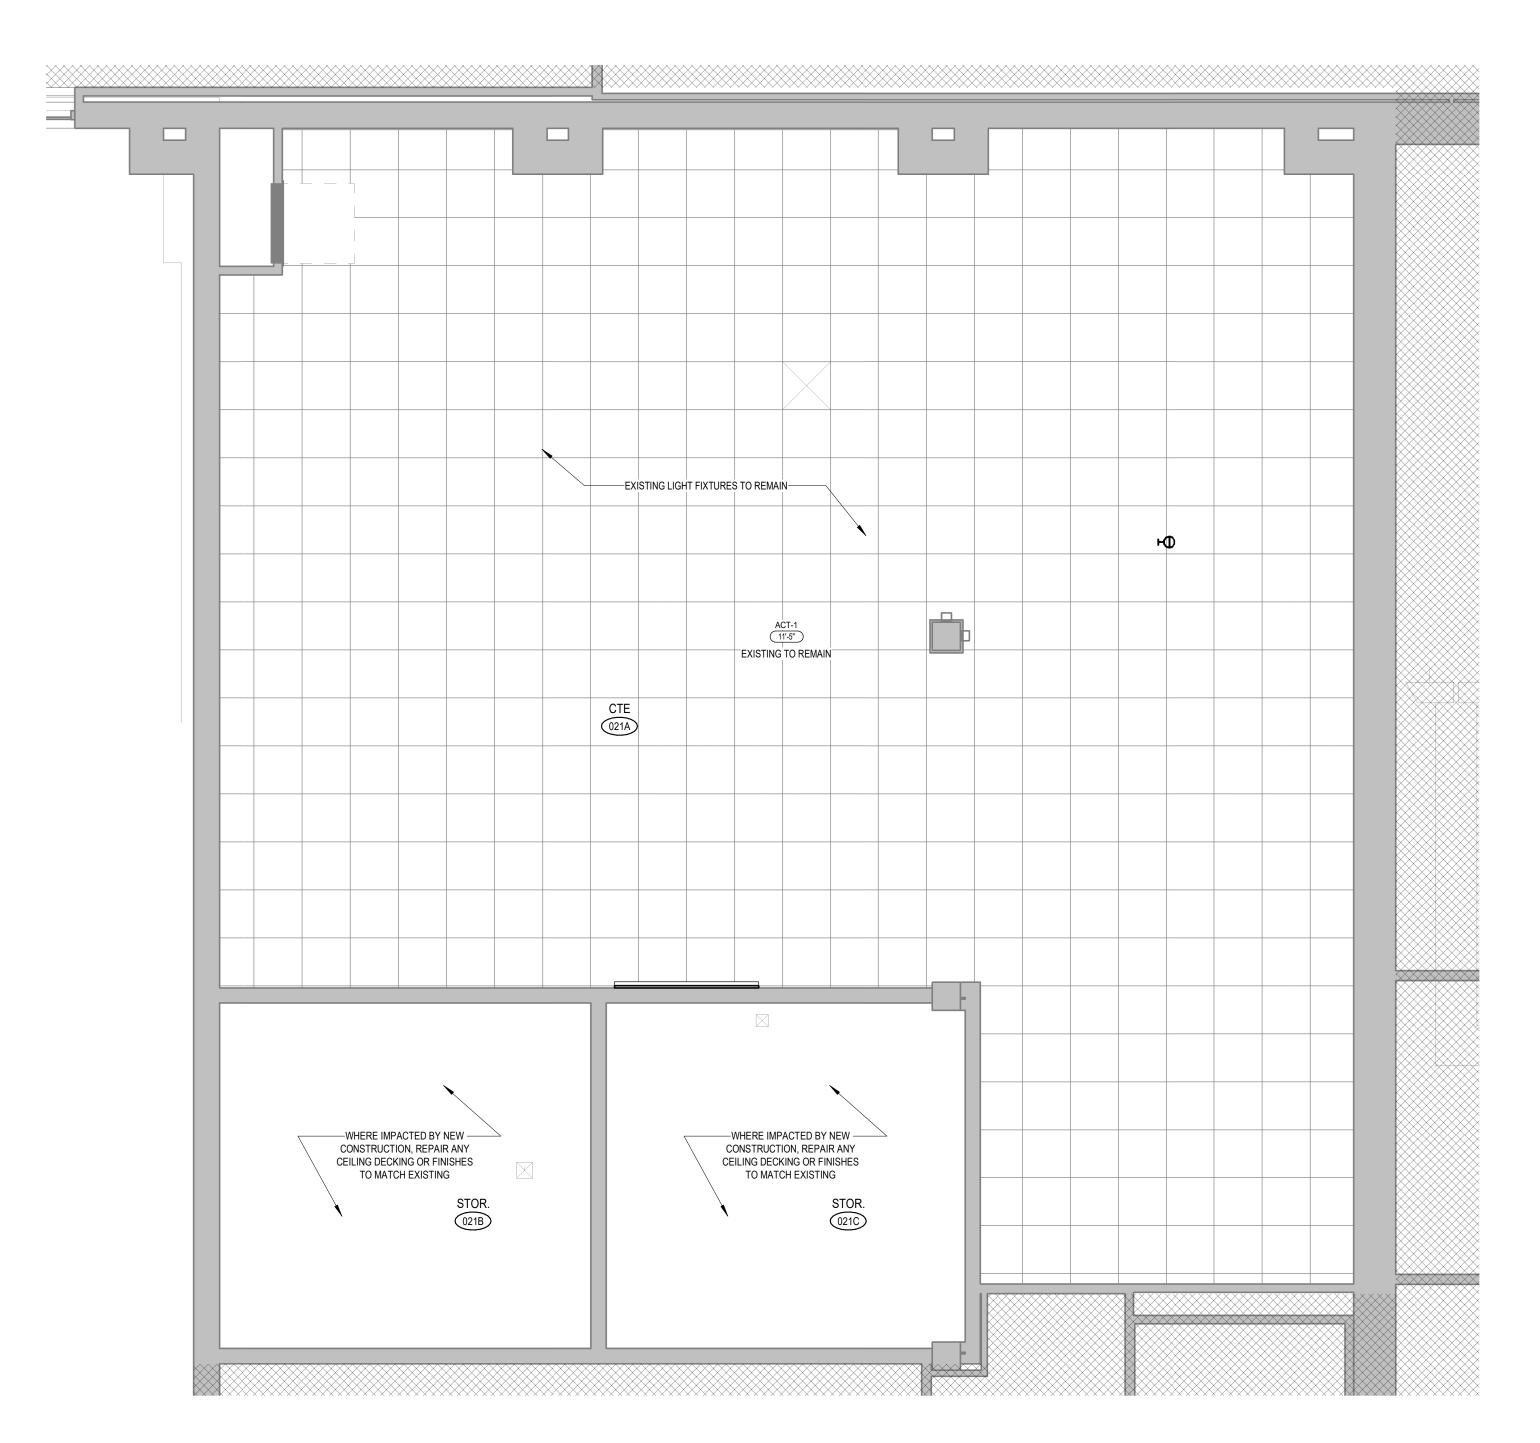



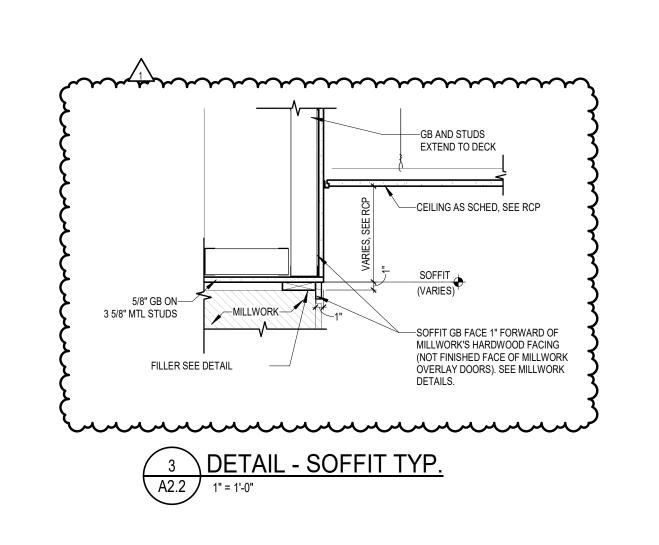

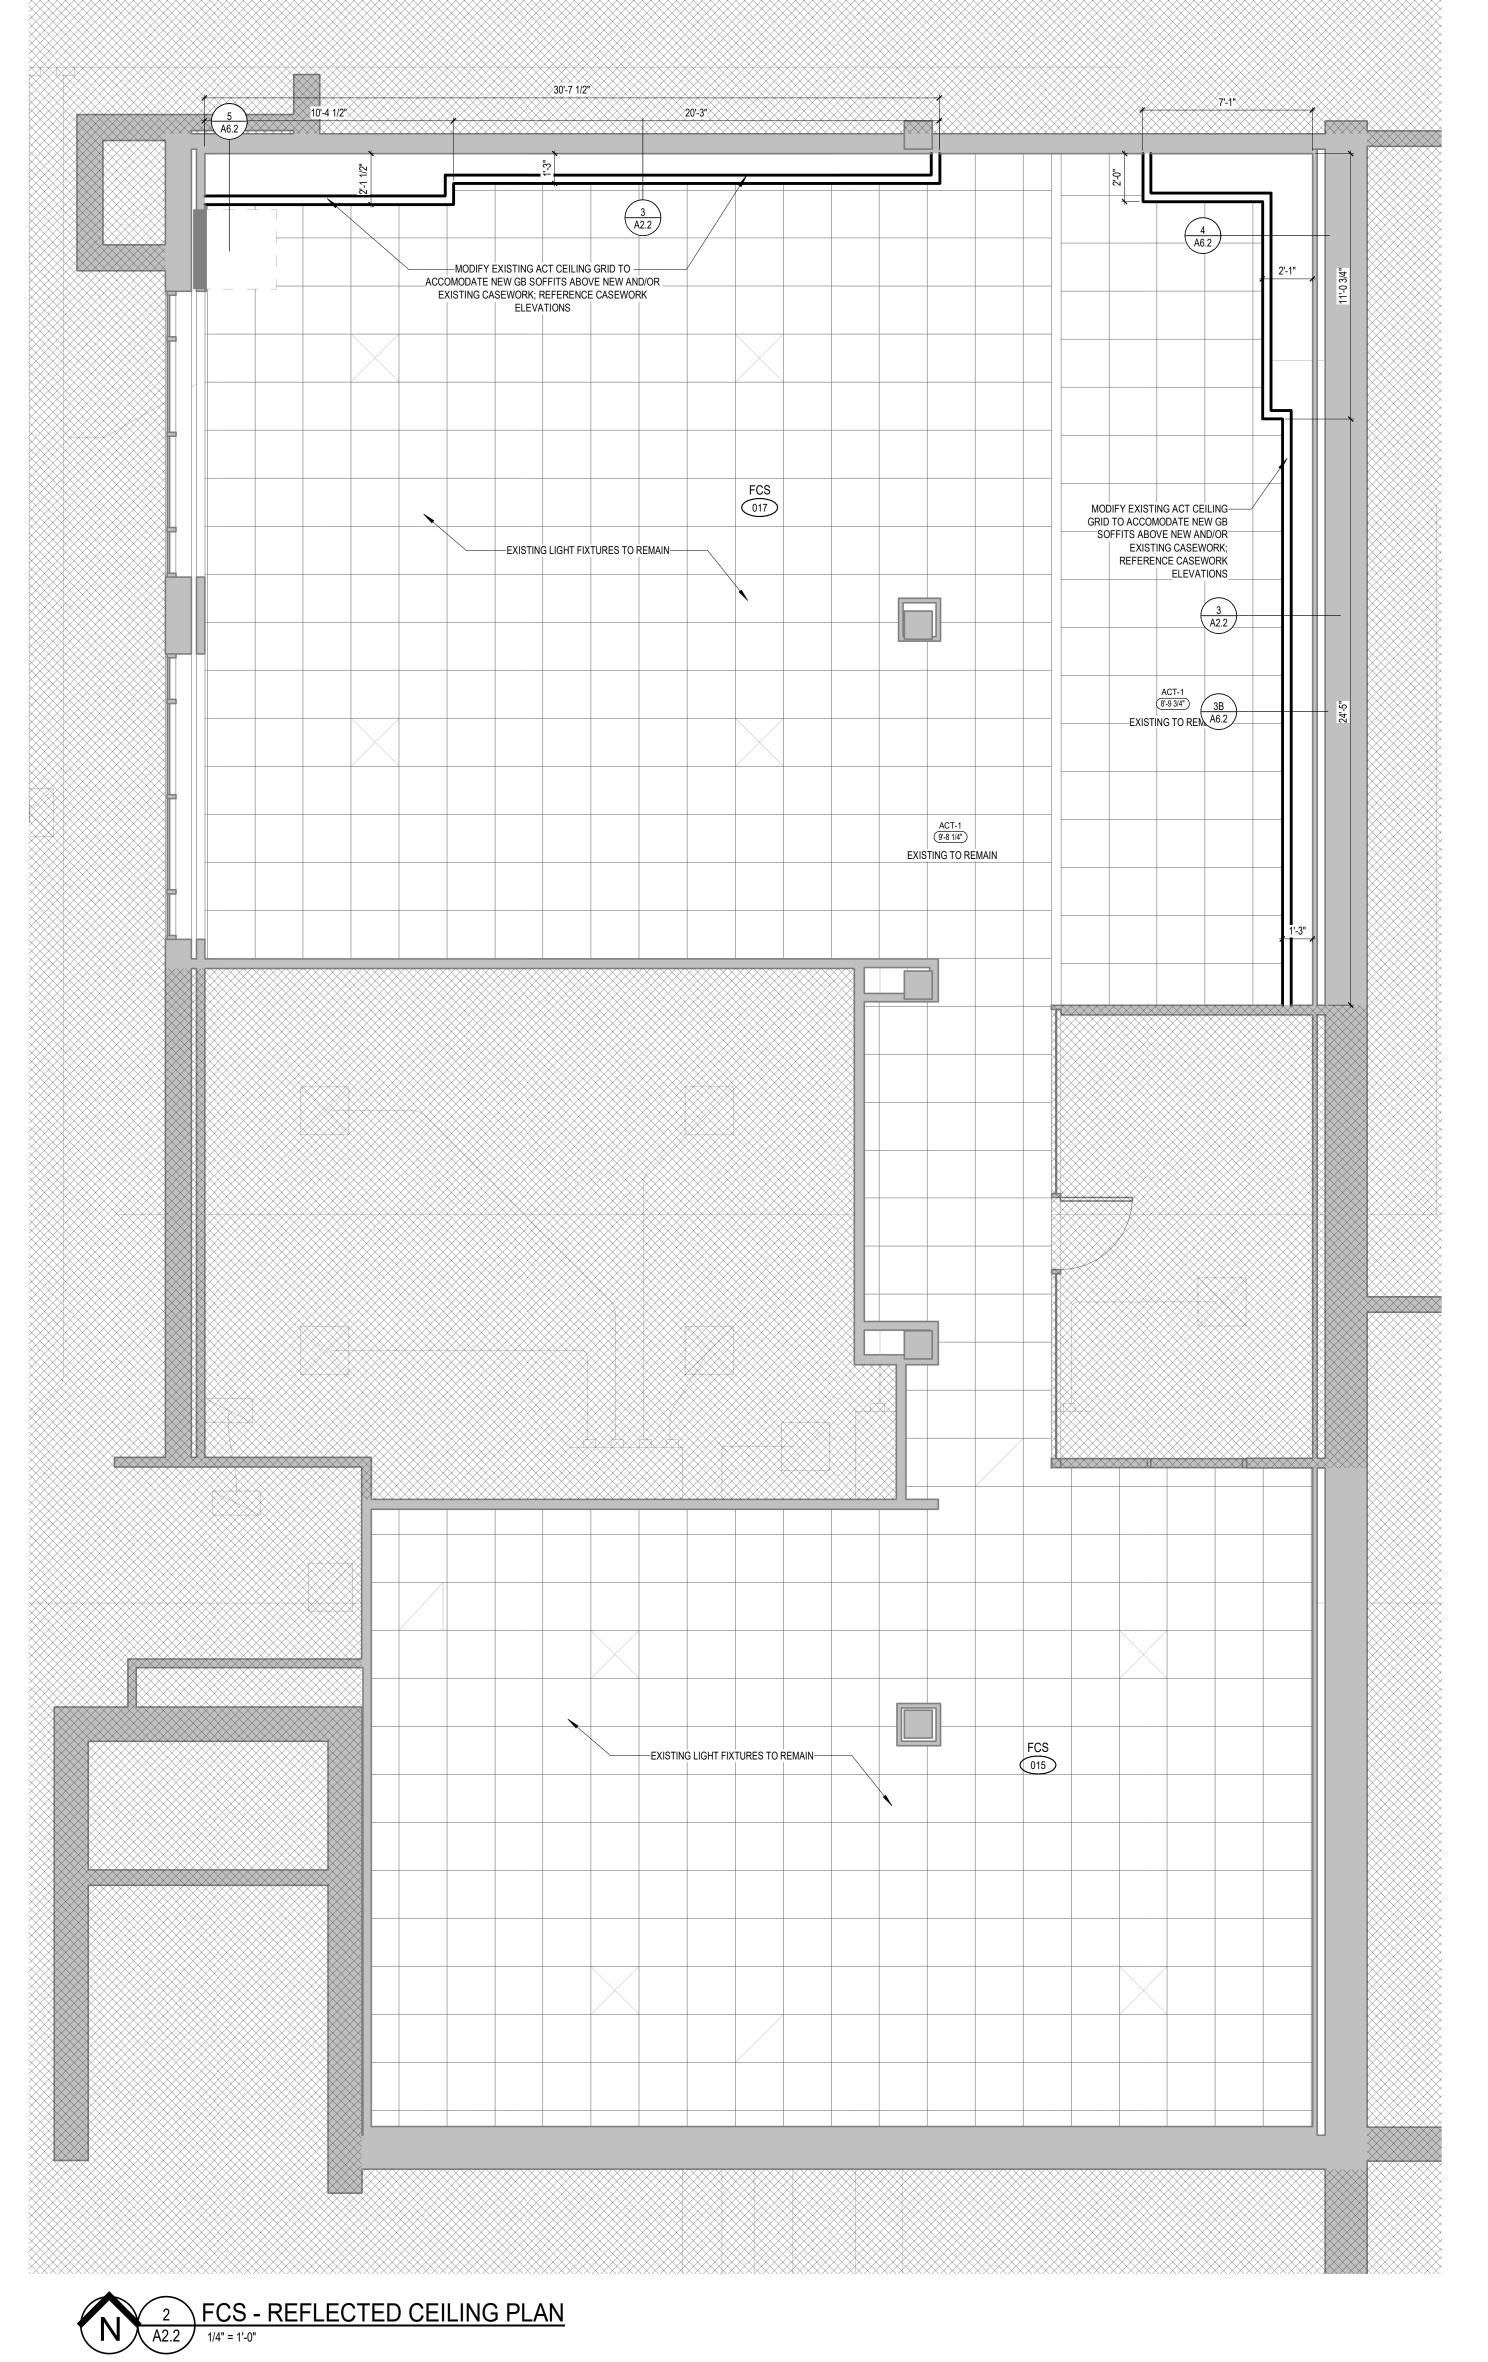



REFLECTED CEILING PLANS - FCS & CTE
LINCOLN PUBLIC SCHOOLS
IRVING MIDDLE SCHOOL ENHANCEMENTS
2745 S 22nd St, Lincoln, NE 68502


CARLSON WEST POVONDRA

CARLSON WEST POVONDRA ARCHITECTS 5060 Dodge Street, Omaha, NE 68132 (402) 551-1500 Certificate of Authorization: CA-0308

A2.2

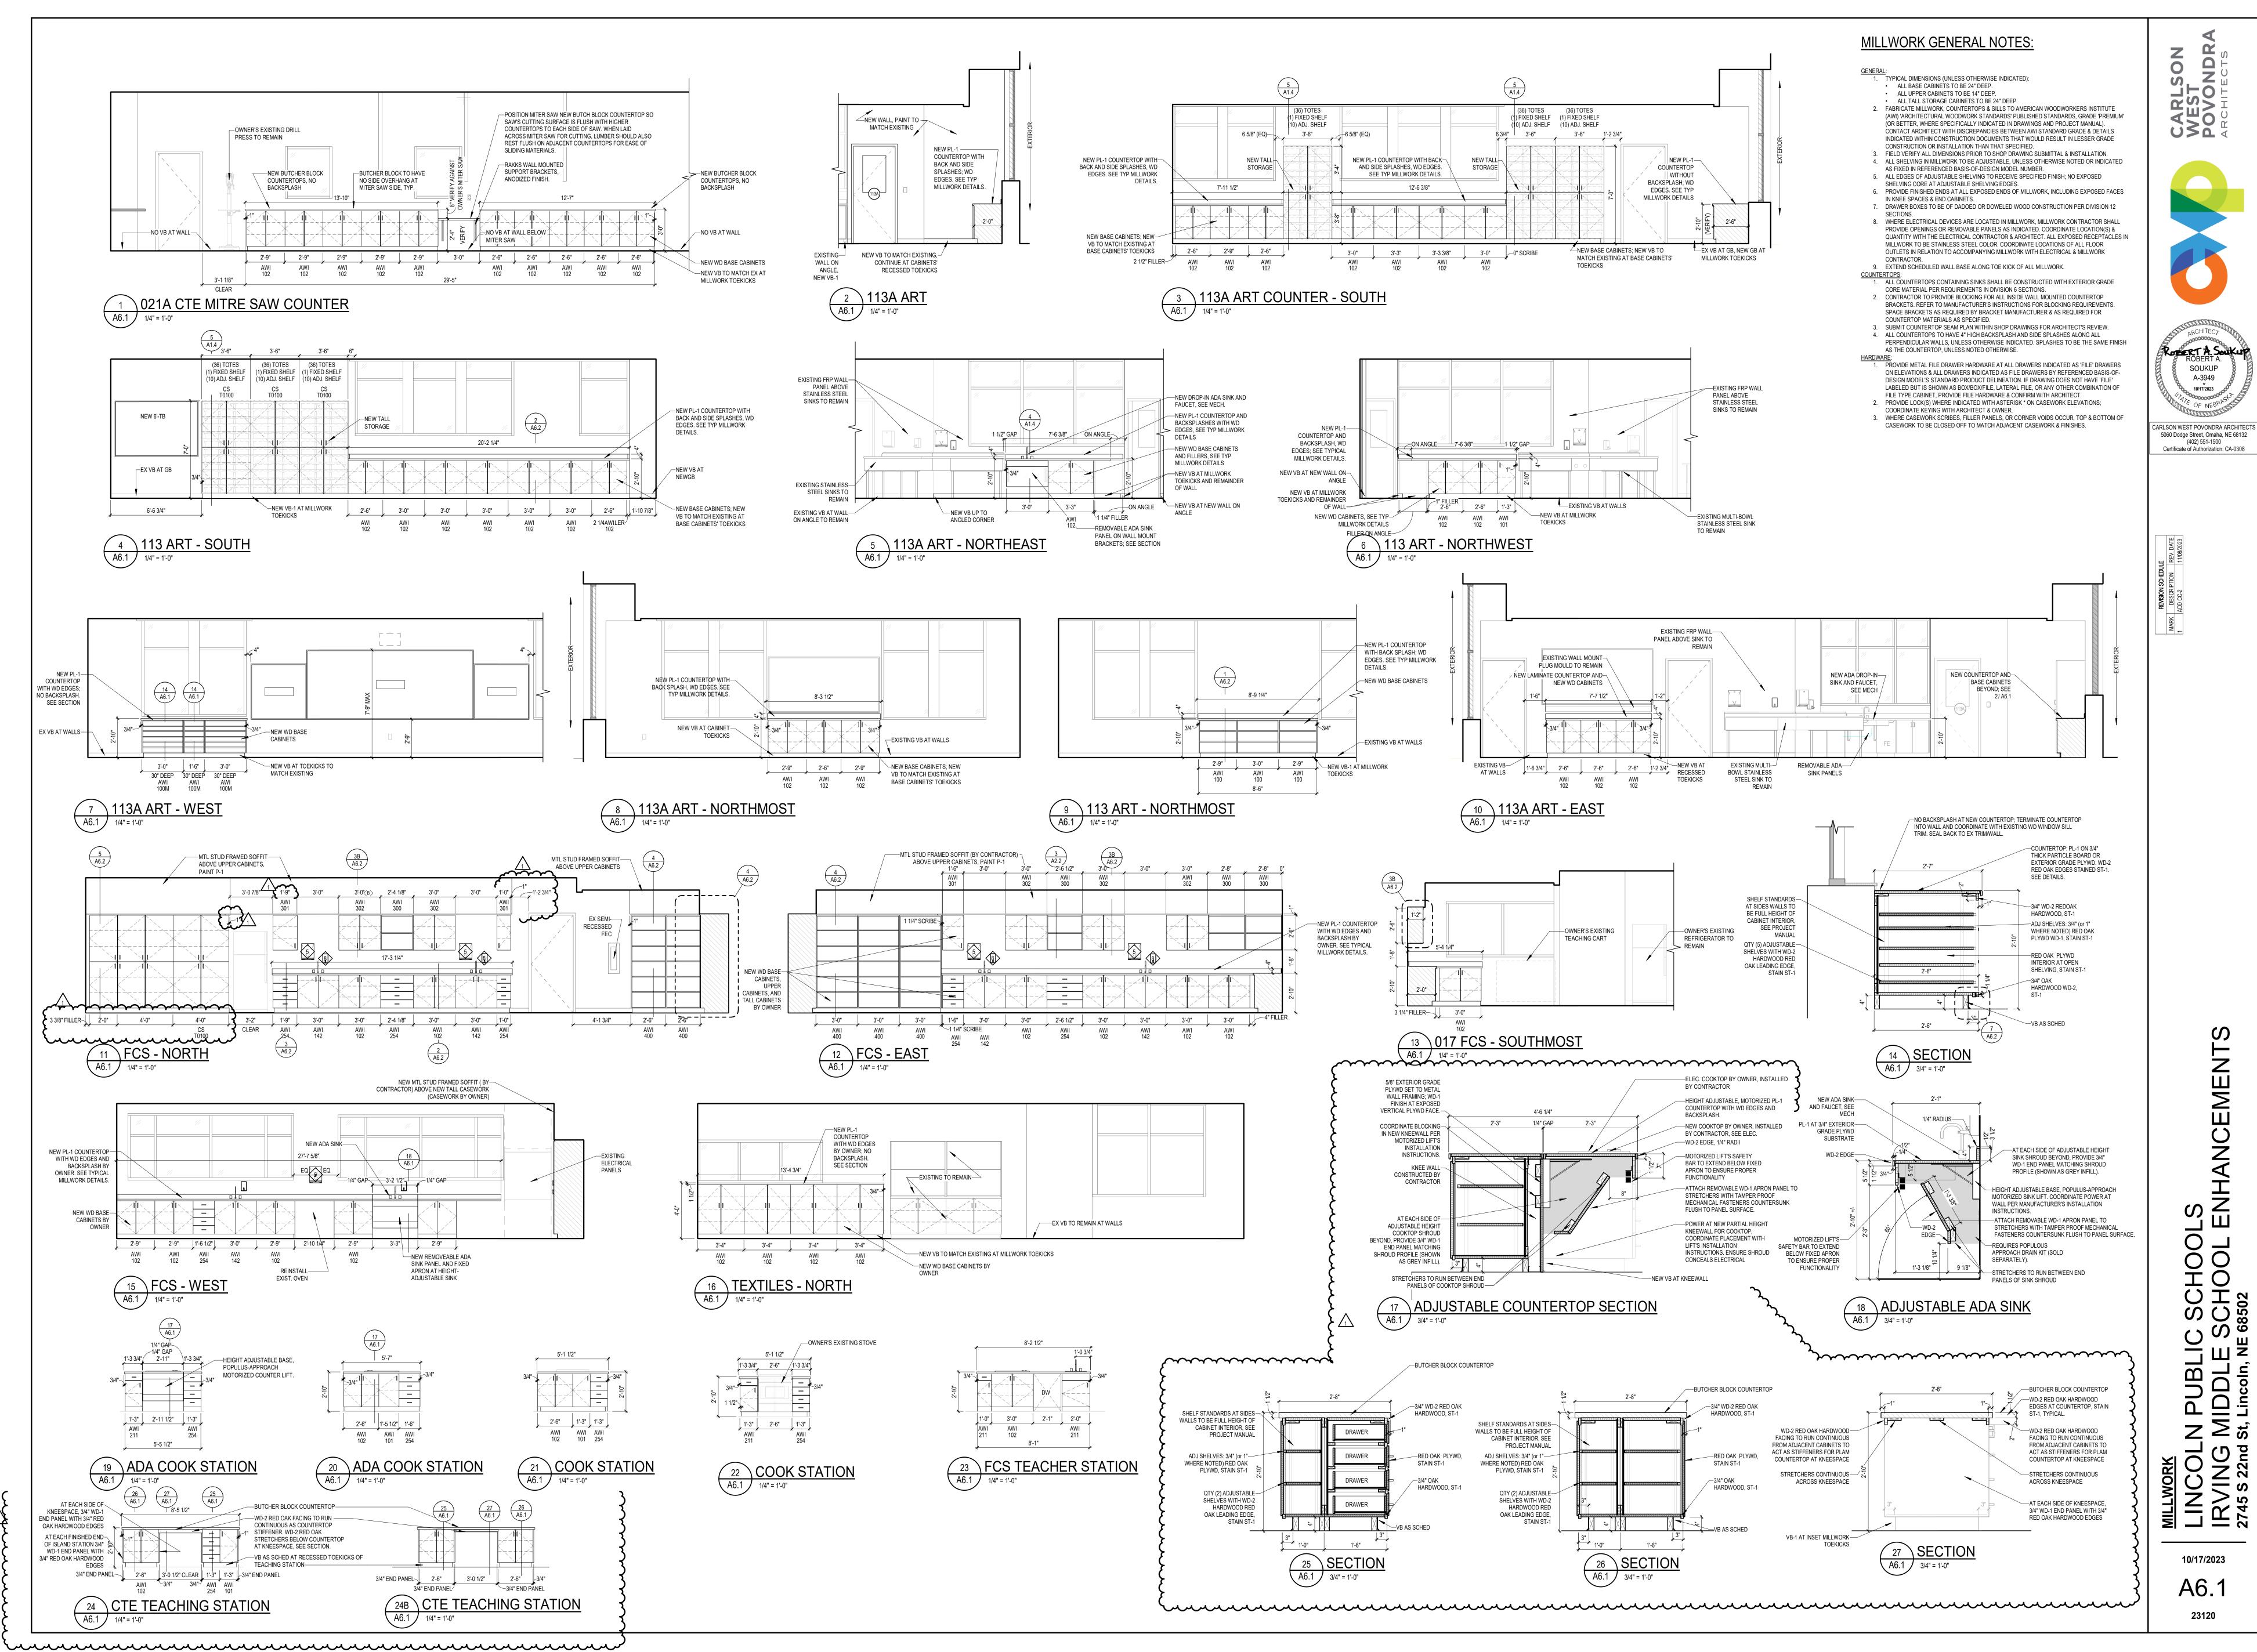


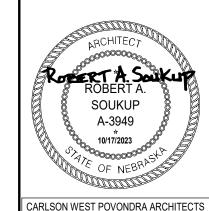

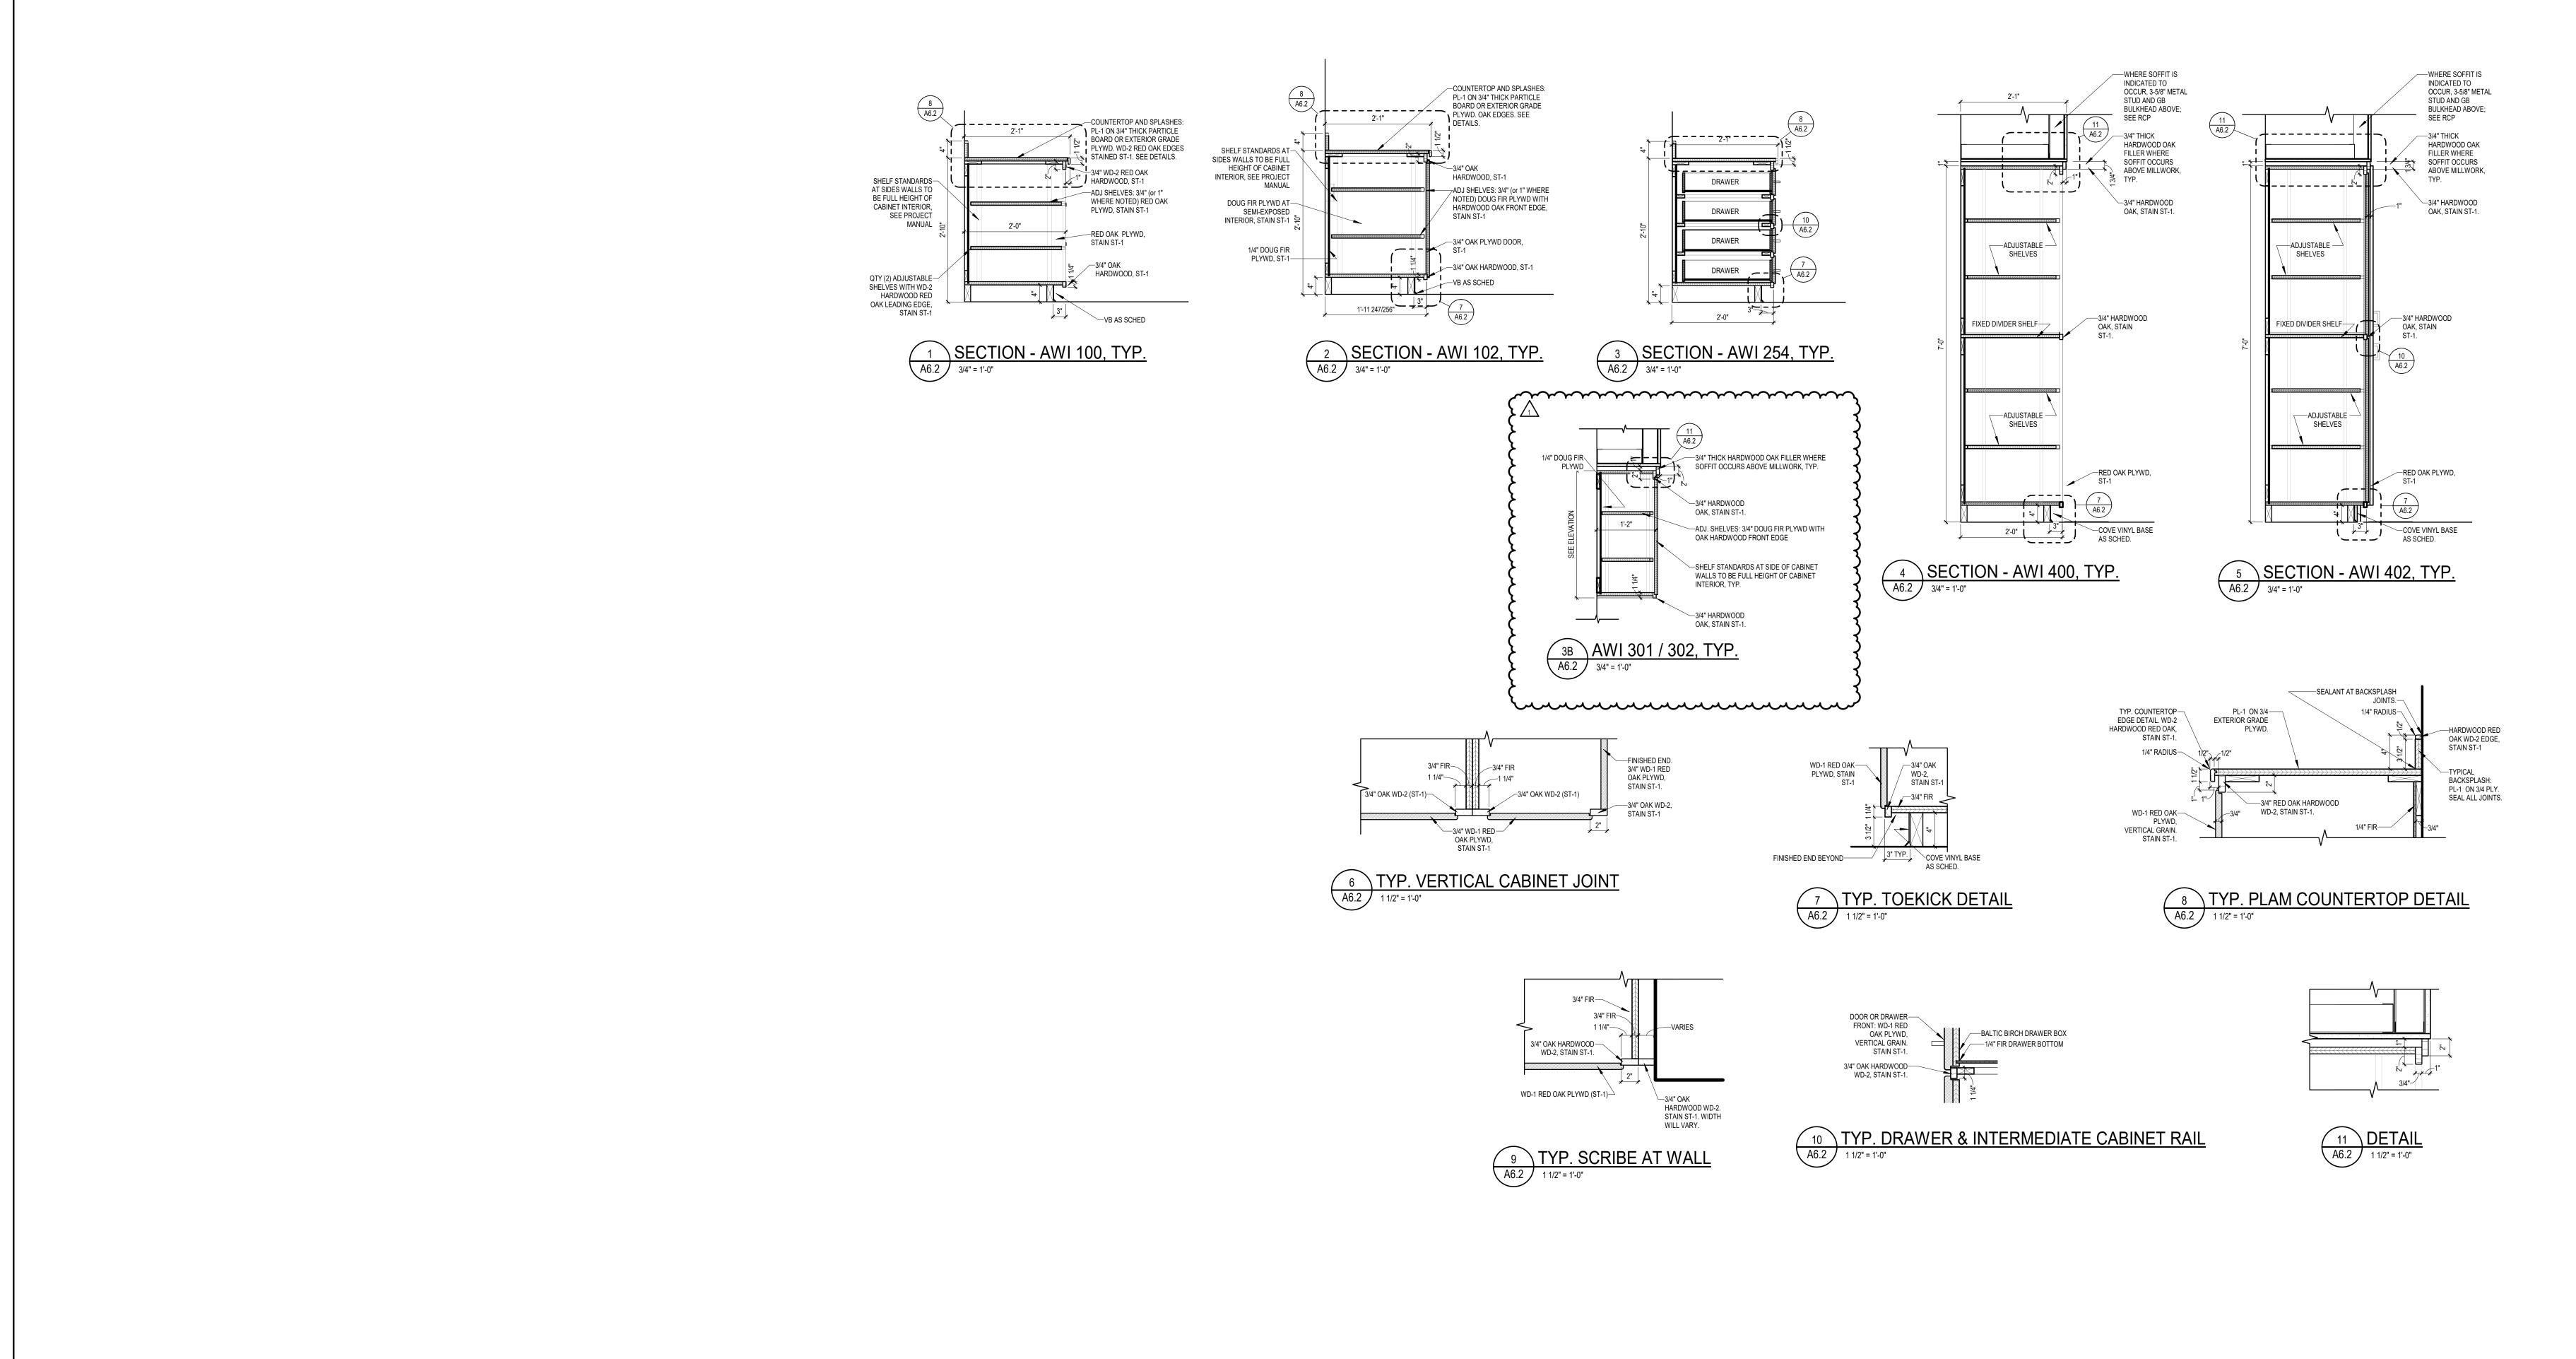


CARLSON WEST POVONDRA ARCHITECTS



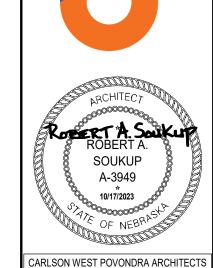

5060 Dodge Street, Omaha, NE 68132 (402) 551-1500 Certificate of Authorization: CA-0308

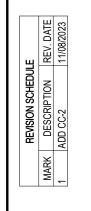

MILLWORK
LINCOLN PUBLIC SCHOOLS
IRVING MIDDLE SCHOOL ENHANCEMENTS
2745 S 22nd St, Lincoln, NE 68502

10/17/2023 A6.2



LPS Irving Middle School and Pound Middle School Enhancements

November 7, 2023

This addendum is hereby made a part of the contract documents to the same extent as though it were originally included therein.

Specifications and drawings shall be considered modified or revised as hereinafter described. Revisions to the drawings are referenced by the drawing number.

#### **Changes to the Mechanical Drawings**

### **Pound Middle School:**

2MD1. Sheet M1.1 - First Floor Plan - Plumbing

- 1. Flag Notes: Add Flag Note 7.
- 2. Floor Plan 1: Add Flag Note 7 in two locations.
- 3. See attached modified sheet.

#### Irving Middle School:

2MD2. Sheet M3.2 – Enlarged HVAC Plans

- 1. Enlarged Plan 2: Demolish ductwork.
- 2. Enlarged Plan 5: Add new ductwork.
- 3. See attached modified sheet.

#### **Changes to the Electrical Drawings**

#### **Pound Middle School:**

2ED1. Sheet E2.1 – First Floor Enlarged Plans – Power, Lighting, and Fire Alarm

- 1. Detail 1 RR-Gym Admin 144B Power:
  - A. Connect EF-1 to same existing power circuit noted in Flag Note 3.
  - B. See attached modified sheet.


**END** 


GAN-BLL/mdg


Alvine No. 2023 9838 Page 1 of 1


FIRST FLOOR ENLARGE
Lincoln Public
Pound Middle
Lincoln, Nebraska


10/17/2023

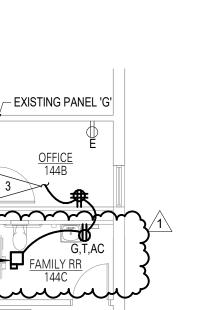

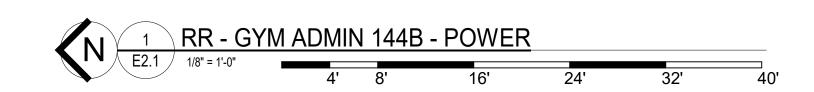

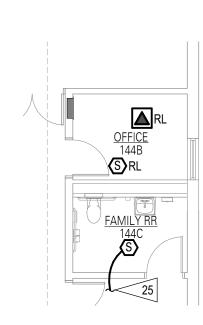


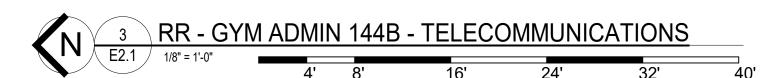

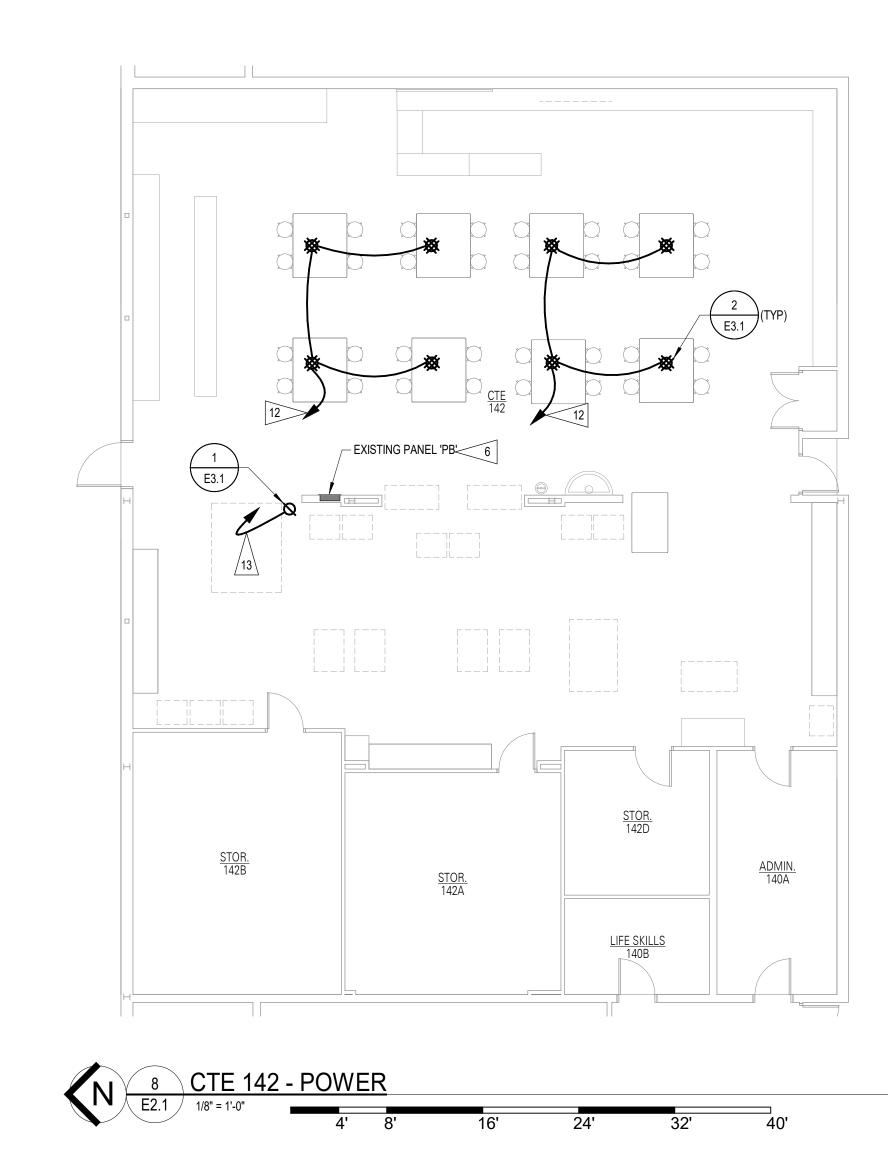

# **GENERAL NOTES:**

- 1. 'E' INDICATES EXISTING DEVICE TO REMAIN IN PLACE. SHOWN FOR REFERENCE
- 2. 'RL' INDICATES RELOCATED DEVICE. RECONNECT TO EXISTING CIRCUIT OR CABLING. EXTEND CONDUCTORS / CONDUIT AS REQUIRED.

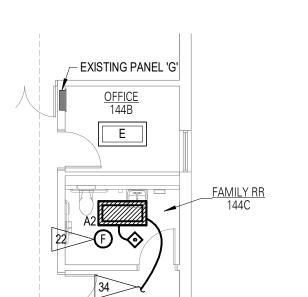

- 1 ELECTRICAL RECEPTACLE TO BE CUT IN AT BOTTOM OF EACH SEWING CABINET. PROVIDE 4" SQUARE, 1-1/2" DEEP BOX WITH SINGLE GANG, 5/8" PLASTER RING. SEE ARCHITECTURAL DETAILS AND ELEVATIONS ON SHEET A6.1
- 2 CONNECT TO NEW 20A1P AND 30A2P BRANCH CIRCUIT BREAKERS IN PANEL 'C'.
- 3 CONNECT TO EXISTING CIRCUIT SERVING THIS OFFICE.
- 4 SURFACE MOUNT RECEPTACLE ON BRICK WALL. PROVIDE WIREMOLD BOX AND V700 SURFACE METAL RACEWAY FROM DEVICE BOX VERTICAL UP TO CEILING SPACE.
- 5 COORDINATE MOUNTING LOCATION FLUSH IN CEILING TO SERVE NEW PROJECTOR. 6 PROVIDE (1) NEW 20A2P AND (2) NEW 20A1P BRANCH BREAKERS. UPDATE
- CIRCUIT DIRECTORY.

FLAG NOTES

- 7 CONNECT NEW COOKTOP WITH 3 #10, #10 GND 3/4" C.
- 8 CONNECT TO NEW 20A1P BRANCH CIRCUIT BREAKERS IN PANEL 'C'.
- 9 PROVIDE (1) NEW 30A2P, (6) NEW 20A1P AND (2) 20A1P AFCI BRANCH CIRCUIT BREAKERS. REVISE PANEL CIRCUIT DIRECTORY TO REFLECT NEW LOADS.
- 10 CONNECT TO EXISTING 20A1P SPARE CIRCUIT BREAKER (POLE #34) IN PANEL 'PPS1'.
- PROVIDE NEW FLUSH MOUNTED RECEPTACLE IN EXISTING WALL. CONNECT TO EXISTING RECEPTACLE IN WASHING 111
- 12 CONNECT TO NEW 20A1P BRANCH CIRCUIT BREAKER IN PANEL 'PB'.

13 CONNECT TO NEW 20A2P BRANCH CIRCUIT BREAKER IN PANEL 'PB'.


- ROUTE NEW 1" CONDUITS TO TEACHING AND SEWING CABINET ISLANDS IN FLOOR TRENCH. REPLACE CONCRETE FLOOR WHERE IT WAS REMOVED.
- TRANSITION FROM PVC BELOW FLOOR TO EMT <u>BEFORE</u> CONDUITS EXIT FLOOR SLAB. NO PVC CONDUIT SHALL BE EXPOSED TO VIEW OR BE SUBJECT TO DAMAGE. WITH INSULATING BUSHINGS.
- 17 CONNECT TO EXISTING EMERGENCY LIGHTING CIRCUIT SERVING FIXTURES IN ADJACENT TOILET ROOMS.
- 18 CONNECT TO EXISTING NORMAL LIGHTING CIRCUIT SERVING FIXTURES IN ADJACENT TOILET ROOMS.
- 19 SURFACE MOUNT SWITCH ON BRICK WALL. PROVIDE WIREMOLD V700 SURFACE METAL RACEWAY FROM DEVICE BOX VERTICAL UP TO CEILING SPACE.
- 20 COORDINATE MOUNTING LOCATION BELOW COUNTER TO SERVE MOTORIZED COUNTER LIFT. SEE MANUFACTURERS INSTALLATION INSTRUCTIONS.
- 21 CONNECT TO NEW 20A1P AFCI BRANCH BREAKER IN PANEL 'C'.
- 22 CONNECT TO EXISTING FIRE ALARM SYSTEM.
- 23 2-GANG DEEP FLUSH BOX AT BOTH ENDS OF ISLAND FOR HDMI CABLE. CABLE INSTALLED BY LPS. AT WEST END OF ISLAND, PROVIDE SINGLE GANG DEEP FLUSH BOX FOR CAT 6 CABLE. PROVIDE 3/4" C. BETWEEN BOXES.
- ROUTE NEW EMT CONDUITS TIGHT TO WALL UP INTO CEILING SPACE. TERMINATE
- PROVIDE FLUSH BOX IN CEILING AT NEW PROJECTOR LOCATION FOR CAT. 6. PATCH CORDS FROM THE EXISTING CEILING GEAR BOX. 27 LPS WILL PROVIDE NEW CEILING MOUNT FOR NEW PROJECTOR LOCATION. 16 1/4" C. ROUTED BELOW FLOOR. 28 REVISE POWER CONNECTION TO EXISTING COOKTOP AS REQUIRED TO ACCOMODATE NEW MOTORIZED COUNTER LIFT TO ALLOW COOKTOP TO RAISE
  - AND LOWER. 29 RELOCATE LIGHTING FIXTURE TO CLEAR NEW PROJECTION SCREEN.


24 CONNECT NEW CLOCK TO EXISTING CLOCK SYSTEM WITH (4) CONDUCTORS:


25 CONNECT NEW SPEAKER TO EXISTING CORRIDOR ZONE. WORK SHALL BE PERFORMED BY AUDIO ENHANCEMENT.


(1) HOT, (1) NEUTRAL, (1) GROUND, (1) RESET.


- 30 CONNECT NEW SWITCHING / CIRCUITING TO EXISTING LIGHTING CIRCUITS. 'E' INDICATES EXISTING FIXTURE TO REMAIN AND BE RE-SWITCHED AND RE-
- EXISTING SWITCH BANK WITH (1) 3-WAY AND (2) SINGLE POLE SWITCHES.
  REMOVE BLANK TOGGLE FILLER AND PROVIDE (1) NEW SINGLE POLE TOGGLE
- PROVIDE AUDIO ENHANCEMENT CS-12 CEILING SPEAKER, VOLUME CONTROL KNOB AND ANALOG SPEAKER CABLING AND TIE INTO THE EXISTING SCHOOL INTERCOM SYSTEM. WORK SHALL BE PERFORMED BY AUDIO ENHANCEMENT.
- 34 CONNECT TO CLOSEST EMERGENCY LIGHTING CIRCUIT.

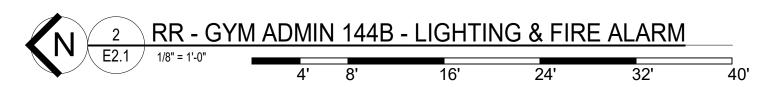


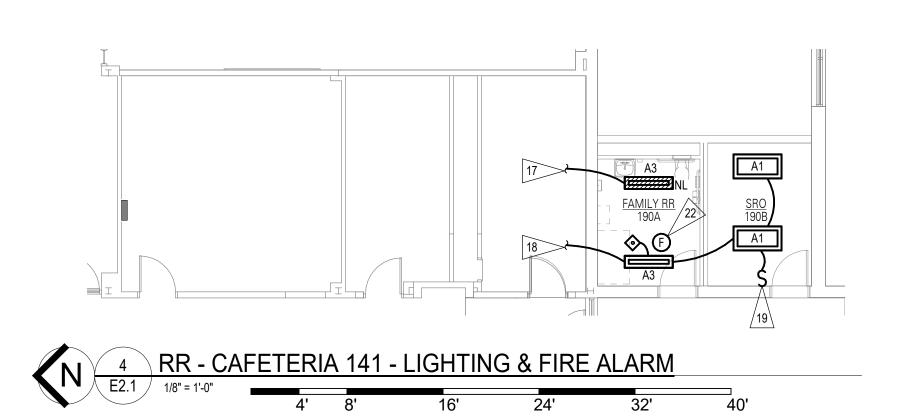


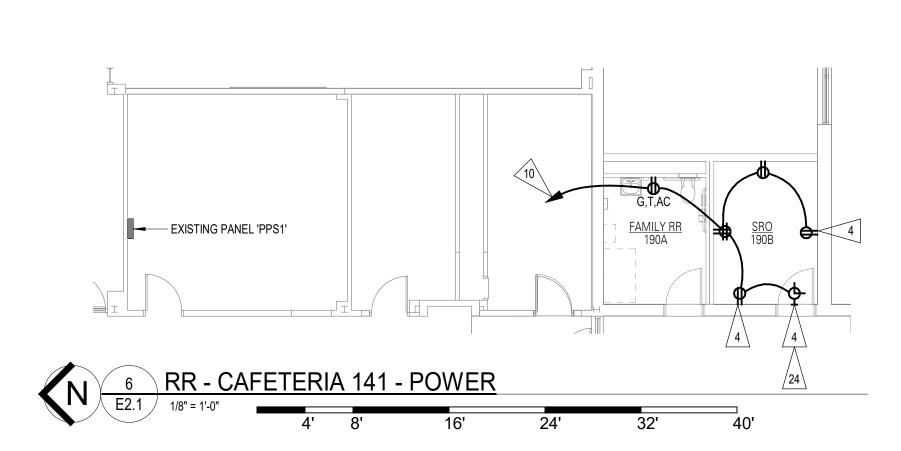


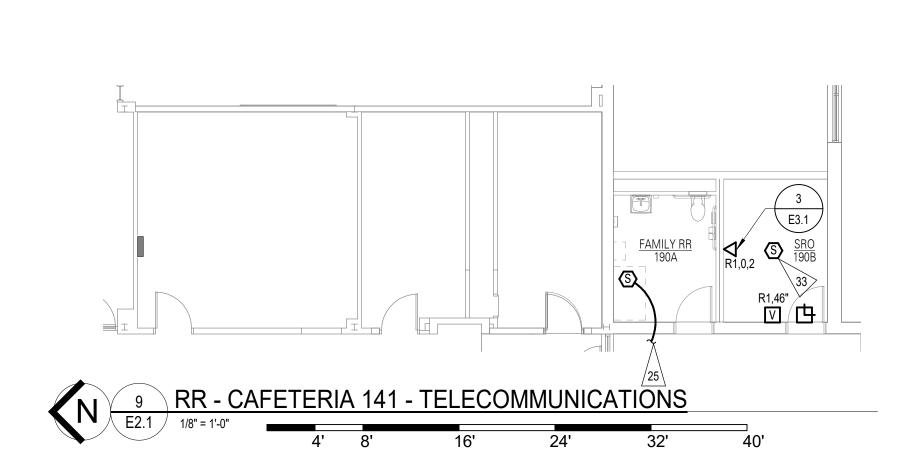


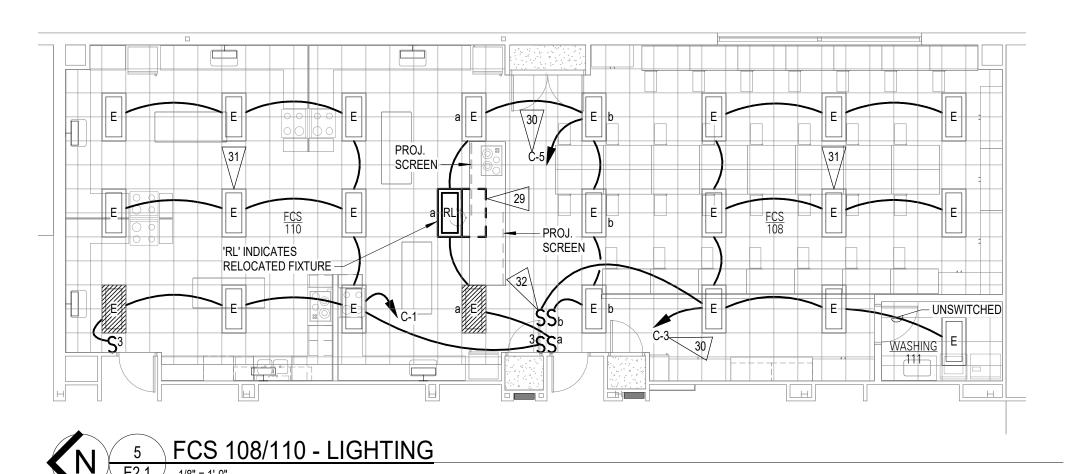

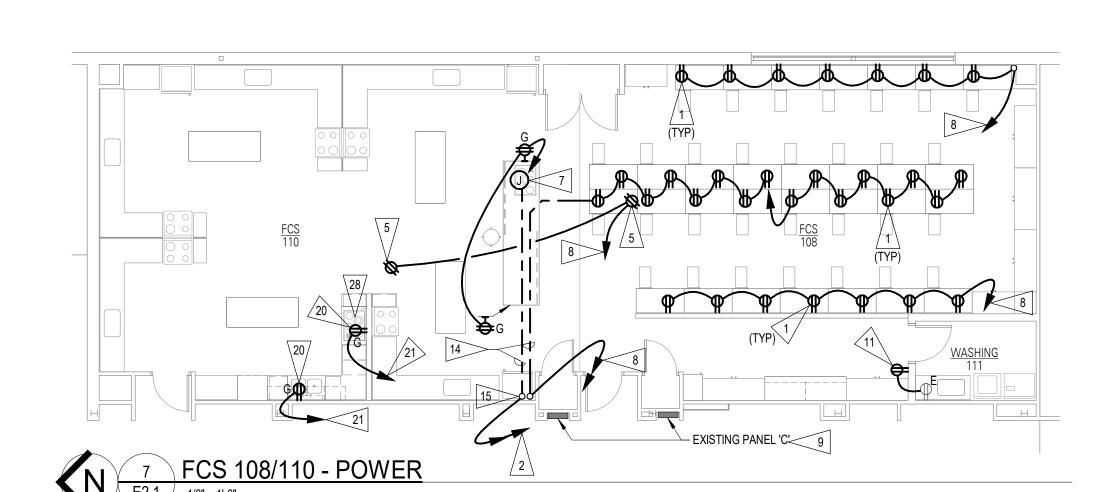


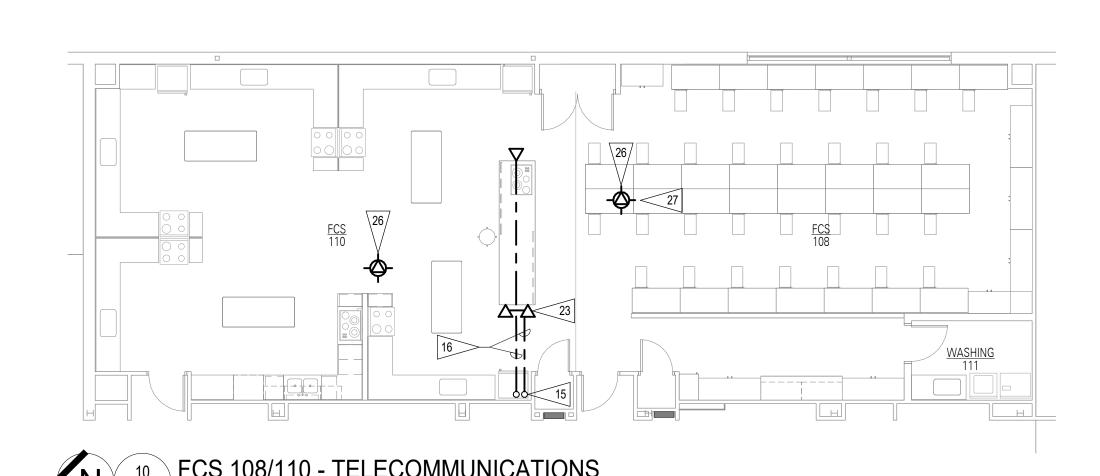

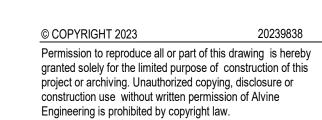

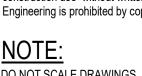

DO NOT SCALE DRAWINGS. VERIFY ALL DIMENSIONS and clearances from ARCHITECTURAL, STRUCTURAL, shop and other appropriate drawing or at site. Lay out and coordinate all work prior to installation to provide clearances required for operation, maintenance, and codes and verify non-interference with other work. DO NOT FABRICATE PRIOR TO VERIFICATION OF CLEARANCE FOR ALL TRADES. READ SPECIFICATIONS.

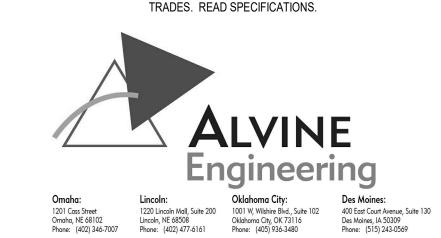



10/17/2023 M3.2


23120






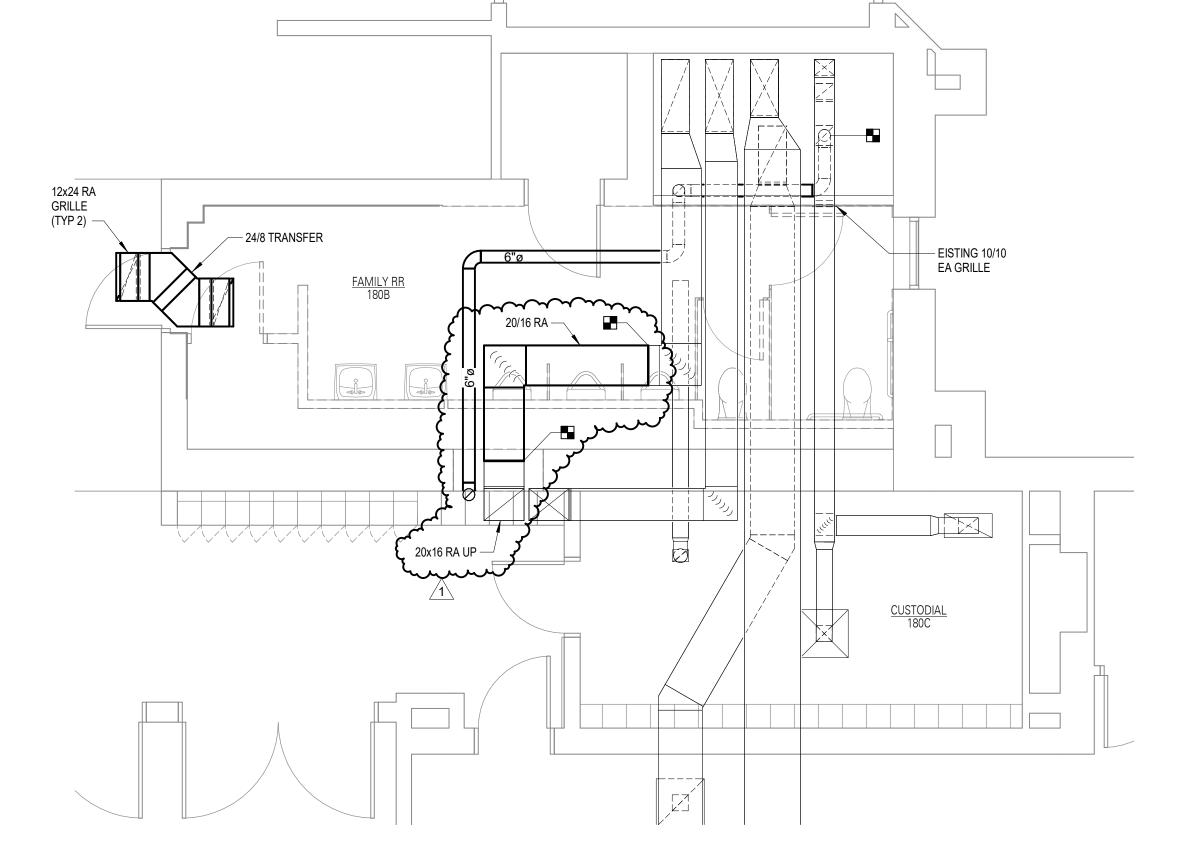


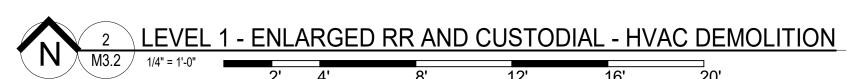


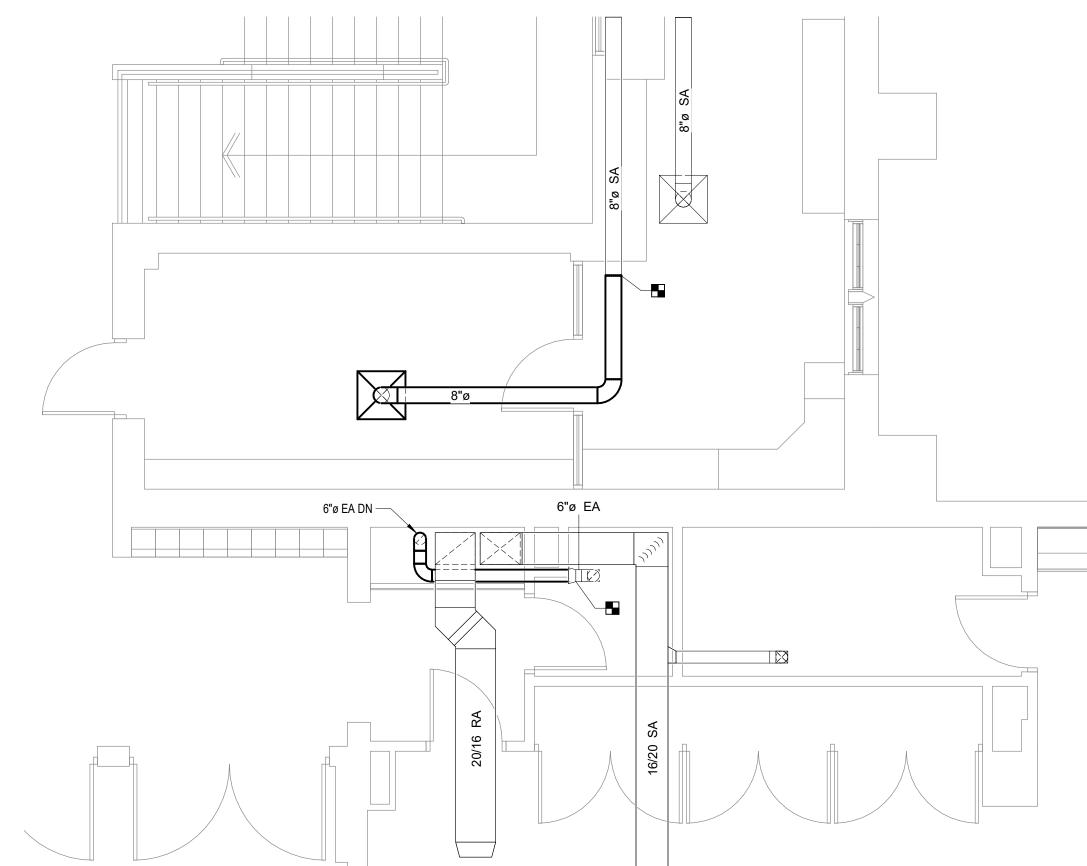



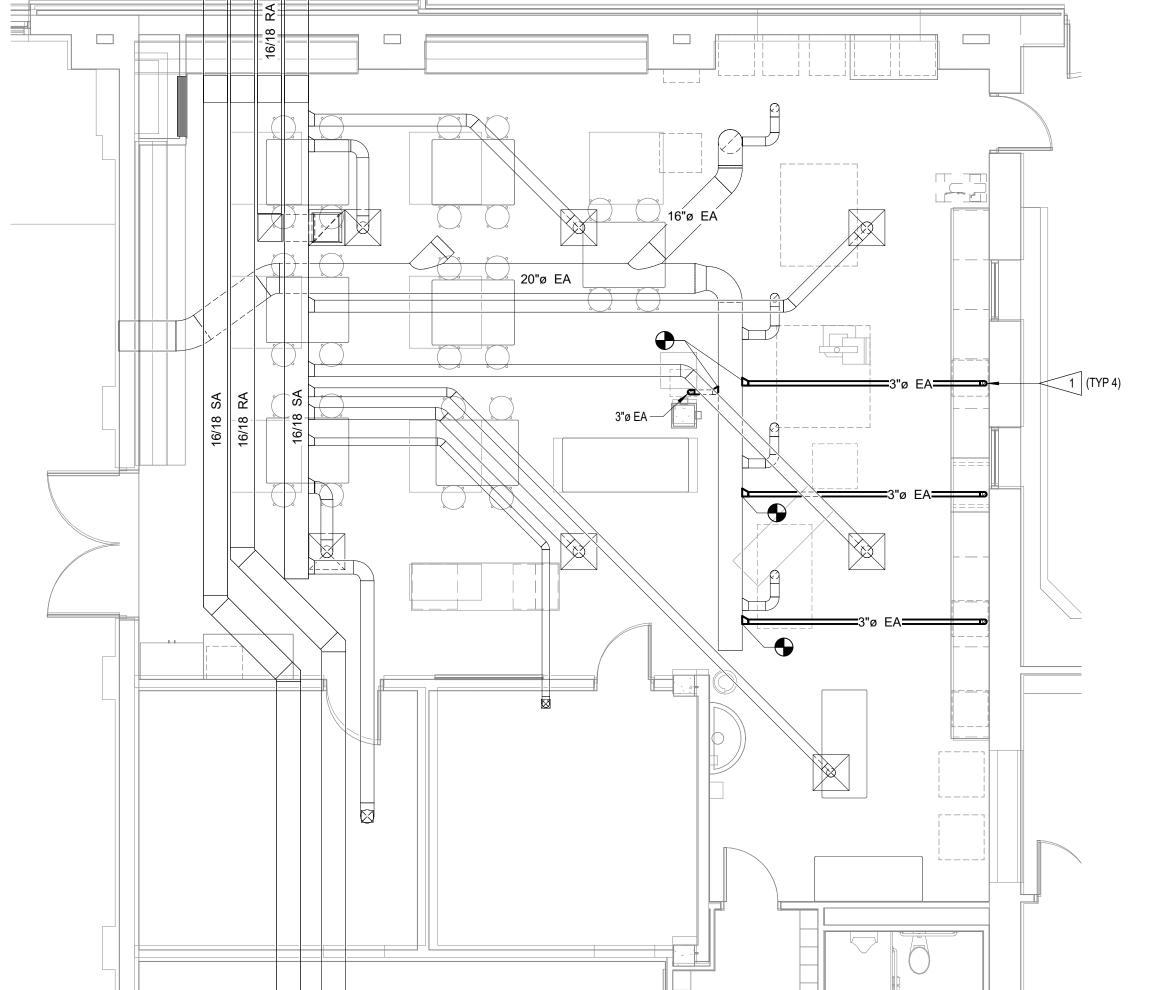

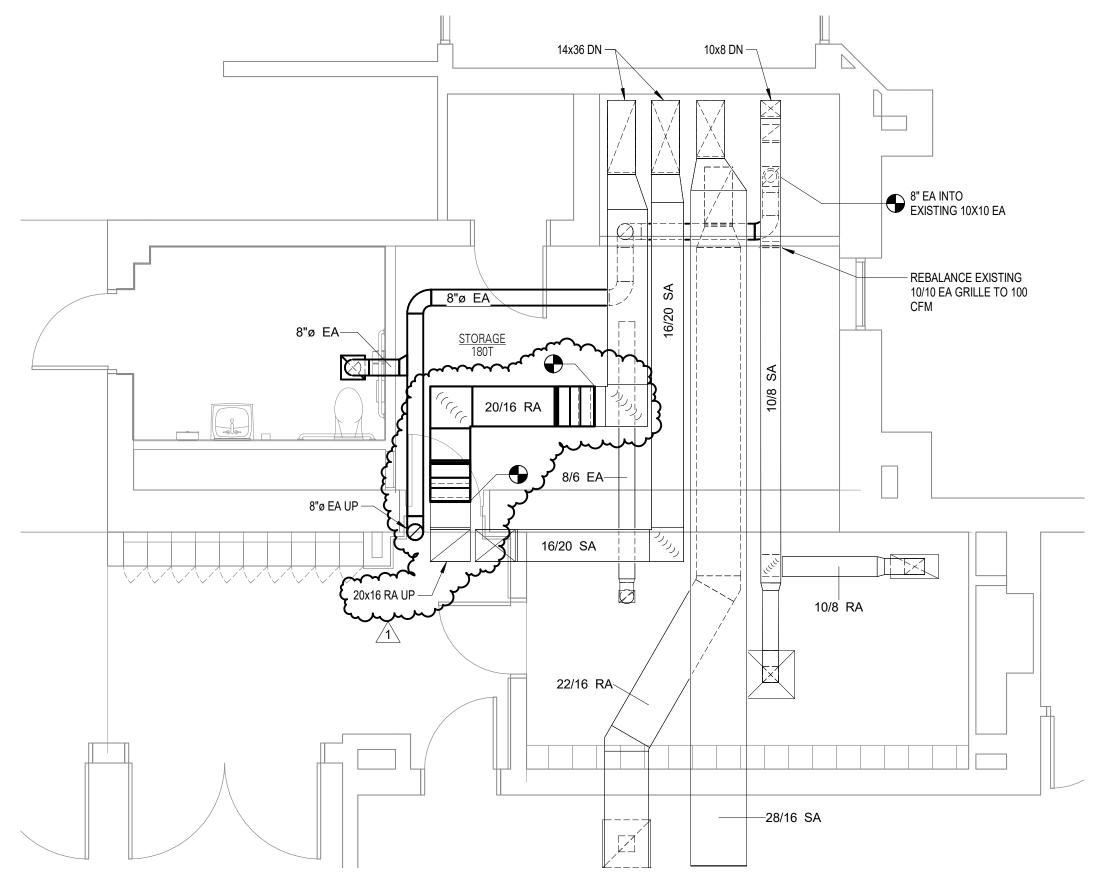

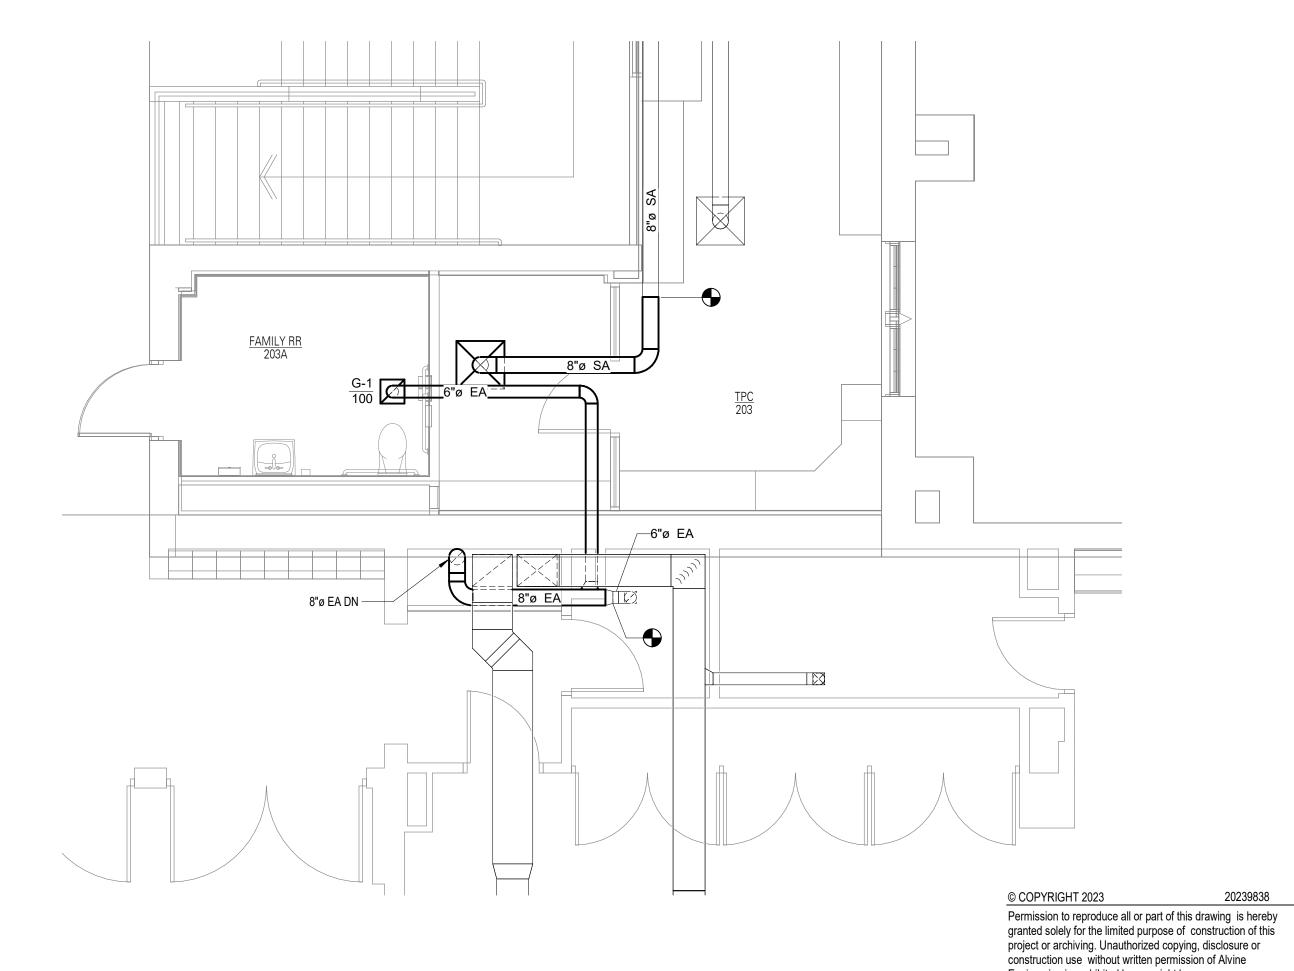

6 LEVEL 2 - ENLARGED RR - HVAC

M3.2 1/4" = 1'-0"

2' 4' 8' 12'

NOTE:

DO NOT SCALE DRAWINGS. VERIFY ALL DIMENSIONS and clearances from ARCHITECTURAL, STRUCTURAL, shop and clearances from ARCHITECTURAL, STRUCTURAL, Shop and other appropriate drawing or at site. Lay out and coordinate all work prior to installation to provide clearances required for operation, maintenance, and codes and verify non-interference with other work. DO NOT FABRICATE PRIOR TO VERIFICATION OF CLEARANCE FOR ALL TRADES. READ SPECIFICATIONS.

Omaha:
1201 Cass Street
Omotho, NE 68102
Phone: (402) 346-7007


Lincoln, NE 68508
Phone: (402) 477-6161

ALVINE
Engineering
Oklahoma City:
1001 W, Wilshire Blvd., Suite 102
Oklahoma City, OK 73116
Phone: (405) 936-3480

Des Moines:
400 East Court Avenue, Suite 130
Des Moines, IA 50309
Phone: (405) 936-3480

Phone: (515) 243-0569

Engineering is prohibited by copyright law.

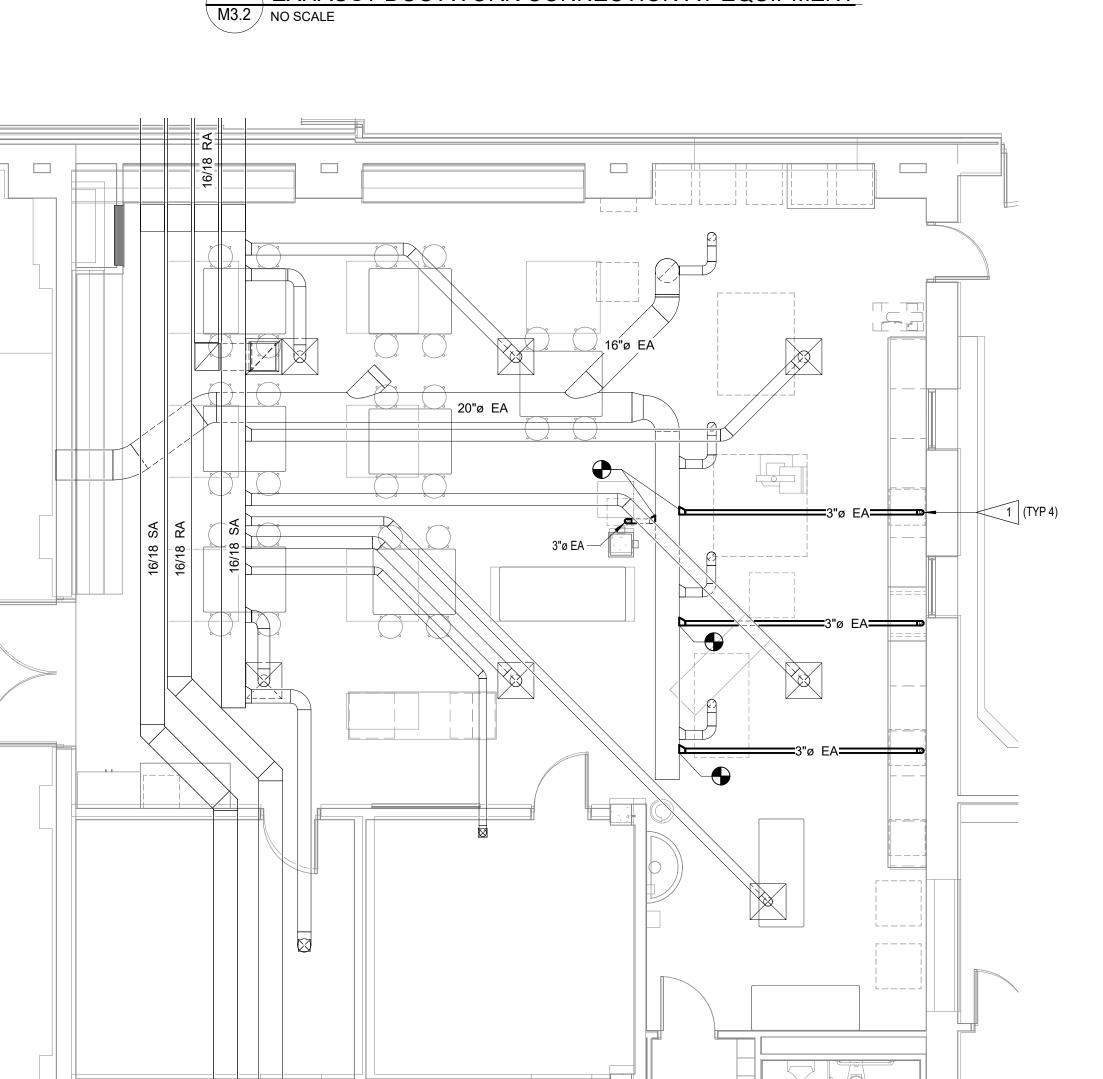

4 LOWER LEVEL - ENLARGED CTE ROOM - HVAC

M3.2 3/16" = 1'-0"

3' 6' 12' 18' 24'