

This addendum is issued by the Owner to all known bidders prior to receipt of Proposal. Bidders shall acknowledge receipt of this Addendum by so indicating on the Proposal Form. All information and instruction given herein shall become a part of the Contract Documents.

THIS ADDENDUM WILL REPLACE THE PREVIOUSLY FAXED ADDENDUM NUMBERED AS #1. PREVIOUSLY SENT FAX SHOULD BE ELIMINATED FROM THE DOCUMENTS.

This addendum contains the following information:

Addendum #1	(8 ½ x 11)	05 Sheets
Supplemental Drawing AD01 (A1-A4)	(8 ½ x 11)	04 Sheets
Supplemental Drawing AD02 (A1)	(8 ½ x 11)	01 Sheet
Supplemental Drawing SDS (001-003)	(8 ½ x 11)	03 Sheets
Supplemental Drawing M1.00a-M1.00b	(8 ½ x 11)	02 Sheets
Supplemental Drawing M1.04a	(8 ½ x 11)	01 Sheet
Supplemental Drawing M2.00a	(8 ½ x 11)	01 Sheet
Supplemental Drawing M2.01b	(8 ½ x 11)	01 Sheet
Supplemental Drawing M4.09a	(8 ½ x 11)	01 Sheet
Supplemental Drawing M7.03a-M7.03b	(8 ½ x 11)	02 Sheets
Supplemental Drawing E1.05a	(8 ½ x 11)	01 Sheet
Supplemental Drawing E5.05a	(8 ½ x 11)	01 Sheet
Telecommunications Drawings	(22 x 34)	08 Sheets
	Total	31 Sheets

If this addendum appears incomplete, notify the architect immediately.

GENERAL ITEMS

1. Add L-V drawings per attached full sized Sheets.
2. Add Allowance of \$20,000 for exterior landscaping and soil preparation.

PROJECT MANUAL

MECHANICAL SPECIFICATIONS

1. Section 23 0993 SEQUENCE OF OPERATIN FOR HVAC CONTROLS
 - a. Page 23 0993-6, Paragraph 1.6, Change title to read
 - i. " **DOAU-2A and DOAU-2B ROOFTOP HEAT PUMPS WITH ENERGY RECOVERY UNITS**"
 - b. Page 23 0773-7, Paragraph 1.7, Change title to read
 - i. " **DOAU-1A AND DOAU-1B HEAT PUMPS WITH MODULAR HOT GAS REHEAT**"
 - c. Page 23 0993-10, ADD
 - i. " 1.11 CORRIDOR REHEAT COIL WITH SCR CONTROL
 1. Corridor wall mounted sensor (location to be determined in field) shall control corridor electric duct heating coil (EDH-1) using SCR

- control provide by temperature control contractor. (typical floors 2-10)
2. Discharge air temperature shall be monitored through the DDC system
 3. Zone temperature shall be monitored and adjusted through the DDC system
 4. Show on graphics on DDC system

DRAWINGS

ARCHITECTURAL DRAWINGS

1. COVER SHEET
 - a. Add Sheets D-V 6.0, D-V 7.0 and D-V 8.0 per attached L-V sheets.
2. SHEET L1.1
 - b. V1/L1.0 – Add keyed note L60 per attached Supplemental Drawing. Keyed note #L60 to read "IN PLAZA AREA, REMOVE EXISTING DOCKS AND WEARING SLABS TO STRUCTURAL DECK. WATERPROOF ALL HORIZONTAL SURFACES AND VERTICAL SURFACES FROM NEW PLAZA DOWN TO BASEMENT LEVEL AT PERIMETER OF PLAZA. ALL NEW STOOPS TO BE SIZED TO MATCH PAVING PATTERN. SEE NOTES ON BASEMENT PLANS FOR ADDITIONAL INFORMATION."
3. SHEET D1.01
 - a. V1/D1.01 – Revise keyed note #d26 to read "REMOVE EXISTING WOOD AND CONCRETE DOCKS, SLABS, DRAINS, AREAWAYS, ETC. IN THEIR ENTIRETY DOWN TO GRADE OR STRUCTURAL SLABS BELOW. REMOVE WEARING SLABS WHERE APPLICABLE TO ALLOW WATERPROOFING. SEE L1.1 AND BASEMENT PLANS FOR ADDITIONAL REQUIREMENTS."
4. SHEET G0.0.
 - a. Add general note "9. EXTERIOR STONE, GRANITE AND BRICK TO BE TUCK POINTED / RE-GROUTED WHERE REQUIRED."
5. SHEET A1.1108
 - a. G15/A1.1108 – Add keyed note #a23 to stair inside of unit. Keyed note #a23 to read "NEW STAIR WITH HANDRAIL / GUARDRAIL AT OPEN SIDES AND WOOD HANDRAIL AT WALL SIDES; SEE DETAILS ON A4.1"
6. SHEET A1.1200.1
 - a. V1/A1.1200.1 – Revise existing plaster height to be 9'-7".
 - b. V9/A1.1200.1 – Revise flooring and add flooring tags per attached Supplemental Drawing.
 - c. V17/A1.1200.1 – Add keyed notes #a22 and a23 to stairs inside of suites per attached Supplemental Drawings.
 - d. V17/A1.1200.1 – Add dimension (6'-9" min) at desk location per attached Supplemental Drawings.
 - e. V17/A1.1200.1 – Remove dimension ("6'-6") at restroom exterior wall per attached Supplemental Drawings.

7. SHEET A1.1200.2
 - a. M17/A1.1200.2 – add robe hook #270 per attached Supplemental Drawings.
 - b. M20/A1.1200.2 – add towel bar #227 per attached Supplemental Drawings.
8. SHEET A2.1
 - a. Revise Keyed Note #L21 to Read “NEW ALUMINUM DOORS AND CURTAIN WALL TO MATCH EXISTING. FOR TRANSOM ABOVE STONE DETAILING, CLEAN EXISTING CURTAIN WALL, REPLACE SEALANT AND PROVIDE NEW GLAZING TO MATCH NEW GLAZING BELOW.”
9. SHEET A2.1 thru A2.4
 - b. Add general note “9. EXTERIOR STONE, GRANITE AND BRICK TO BE TUCK POINTED / RE-GROUTED WHERE REQUIRED.”

STRUCTURAL DRAWINGS

1. SHEET S0.00
 - a. Detail 3/S0.00: Revise the detail as shown clouded in *Supplemental Drawing SDS-001*.
2. SHEET S1.00
 - a. Basement Plan: Revise the note “Existing Concrete Curbs” to read “*Existing Concrete Curbs; ADD STEPS, SEE ARCH.*”
3. SHEET S1.11
 - a. Eleventh Floor Plan: Add the RTU framing as shown in *Supplemental Drawing SDS-002*.
 - b. Detail 3/S1.11: Added Detail as shown in *Supplemental Drawing SDS-003*.

MECHANICAL DRAWINGS

1. SHEET M1.00 BASEMENT FLOOR PLAN - HVAC AND MISCELLANEOUS PIPING
 - a. Mechanical RM 026
 - i. HHP-1.5, Route ¾” condensate piping from heat pump down wall and spill into drain TD-1.
 - b. Storage and Mechanical RM 042
 - i. DOAU-1A and DOAU-1B, spill 1-1/4” condensate drain into floor drain between units.
 - c. See Sketches M1.00a and M1.00b
2. SHEET M1.03 THIRD THROUGH TENTH FLOOR PLAN – HVAC AND MISCELLANEOUS PIPING
 - a. Corridor Rm X50, Locate sensor for EDH-1 on west wall of corridor near elevator.
3. SHEET M1.04 TENTH FLOOR MEZZANINE AND ELEVENTH FLOOR PLAN – HVAC AND MISCELLANEOUS PIPING
 - a. DOAU-2A and DOAU-2B
 - i. Route HPLS/HPLR piping up inside DOAU-2A and DOAU-2B roof curb. Provide 2-1/2” hose kit, automatic flow control valve and strainer

identical to Water Source Heat Pumps. Reference section 23 8146
Water Source Heat Pumps subparagraph 2.4 Hose Kits for
requirements.

- b. See Sketch M1.04a
- 4. SHEET M2.00 BASEMENT FLOOR PLAN – PLUMBING
 - a. Guest Fitness 044,
 - i. Provide pounds to ounces natural gas regulator on ½" gas pipe serving fire place on first floor. Vent regulator to outside.
 - b. See Sketch M2.00a
- 5. SHEET M2.01 FIRST FLOOR PLAN - PLUMBING
 - a. See Sketch M2.01a
- 6. SHEET M4.09 WASTE AND VENT RISER DIAGRAM
 - a. See Sketch M4.09a
- 7. SHEET M7.03 MECHANICAL SCHEDULES
 - a. See Sketch M7.03a and M7.03b


ELECTRICAL DRAWINGS

- 2. SHEET E0.01 SITE UTILITY PLAN – ELECTRICAL
 - a. Contact Burt Adams at 402-636-3333 with OPPD for Fixture "G" pricing and coordination.
- 3. SHEET E1.02 SECOND FLOOR PLAN - ELECTRICAL
 - a. Add rough-in for wall mounted telephone on west side of guest corridor 24" north of column line 5. Install at 54" a.f.f.
- 4. SHEET E1.03 THIRD THRU NINTH TYPICAL FLOOR PLANS - ELECTRICAL
 - a. Add rough-in for wall mounted telephone on west side of guest corridor 24" north of column line 5. Install at 54" a.f.f.
- 5. SHEET E1.04 TENTH FLOOR PLAN - ELECTRICAL
 - a. Add rough-in for wall mounted telephone on west side of guest corridor 24" north of column line 5.
- 6. SHEET E1.05 ELEVENTH FLOOR PLAN - ELECTRICAL
 - a. Add rough-in for wall mounted telephone on west side of guest corridor 24" north of column line 5. Install at 54" a.f.f.
- 7. SHEET E1.05 ELEVENTH FLOOR PLAN – ELECTRICAL
 - a. Delete telecommunication conduits labeled with flag note 1 between gridlines 3-4. See attached sketch E1.05a.
 - b. Relocate panel "E11", telecommunication boards and associated power per attached sketch sheet E1.05a.
- 8. SHEET E1.06 TWELFTH FLOOR PLAN - ELECTRICAL

Downtown Omaha Residence Inn
APMA Project #09001
27 June 2012


- a. Add rough-in for wall mounted telephone on north side of guest corridor directly above receptacle. Install at 54" a.f.f.
9. SHEET E4.04 TELECOMMUNICATIONS PATHWAY RISE DIAGRAM – BASEMENT THRU FOURTH FLOORS
 - a. Delete 1-4" conduit sleeve crossing section of gyp. board ceiling in front of main elevators on floors 2-4.
 10. SHEET E4.05 TELECOMMUNICATIONS PATHWAY RISE DIAGRAM – FIFTH THRU NINTH FLOORS
 - a. Delete 1-4" conduit sleeve crossing section of gyp. board ceiling in front of main elevators on floors 5-9.
 11. SHEET E4.05 TELECOMMUNICATIONS PATHWAY RISE DIAGRAM – TENTH THRU MECH. LEVEL
 - a. Delete 1-4" conduit sleeve crossing section of gyp. board ceiling in front of main elevators on floor 10.

END OF ADDENDUM #1

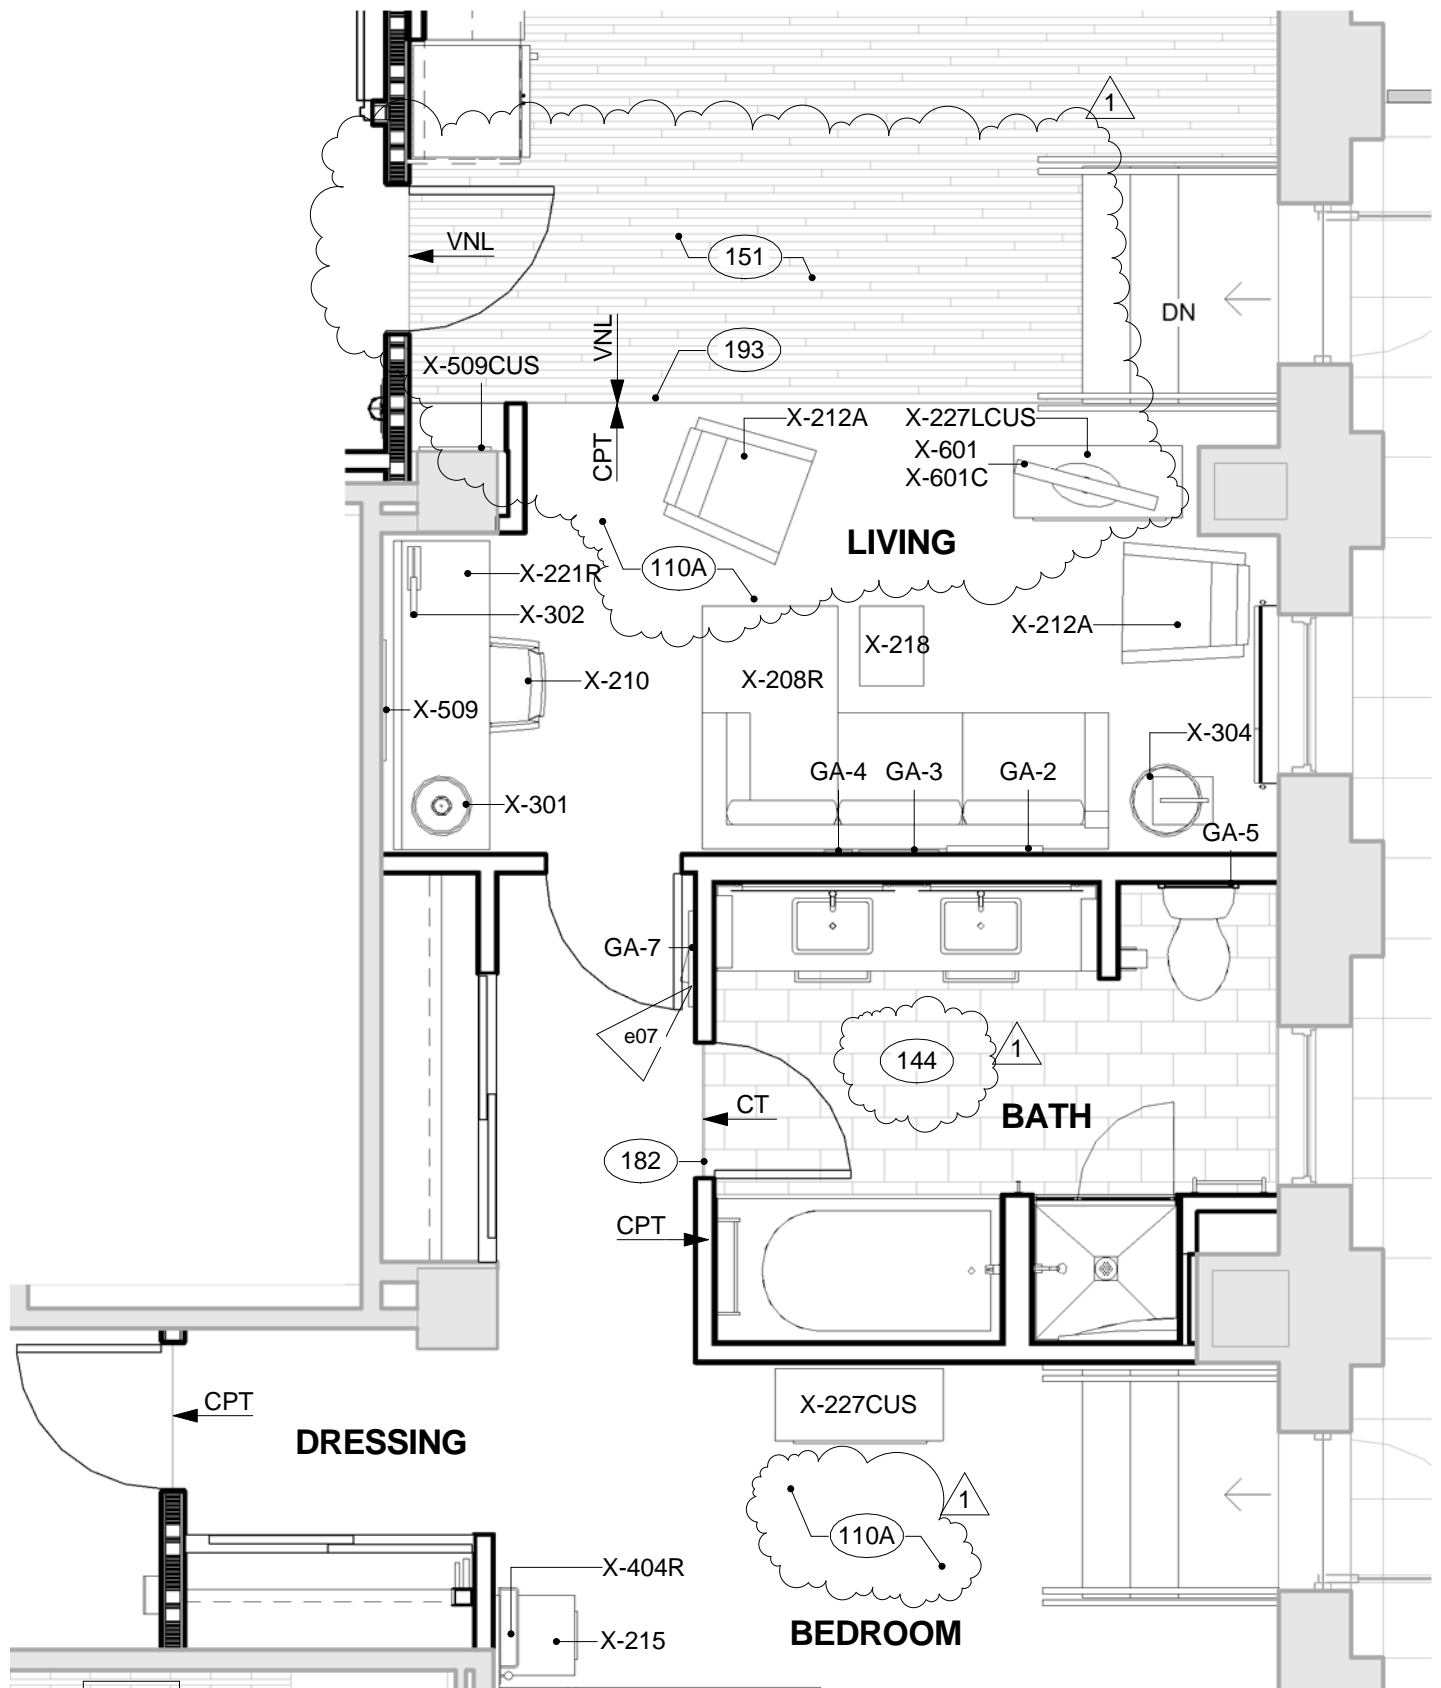

V9 SUITE 1200 - PENTHOUSE - FURNITURE
A1.1200.1 1/4" = 1'-0"


SHEET REFERENCE: V9 / A1.1200.1		DWG NO. AD01 A1	ALLEY·POYNER MACCHIETTO ARCHITECTURE	
PROJECT NAME: Downtown Omaha Residence Inn				1516 Cuming Street Omaha, NE 68102 Ph: 402.341.1544 Fx: 402.341.4735 alleypoyner.com
PROJECT NUMBER: 09001				
DATE: 2012-06-22		ADDENDUM #1		
<small>COPYRIGHT 2011 ALL RIGHTS RESERVED PRINTED OR ELECTRONIC DRAWINGS AND DOCUMENTATION MAY NOT BE REPRODUCED IN ANY FORM WITHOUT WRITTEN PERMISSION FROM ALLEY POYNER MACCHIETTO ARCHITECTURE</small>				

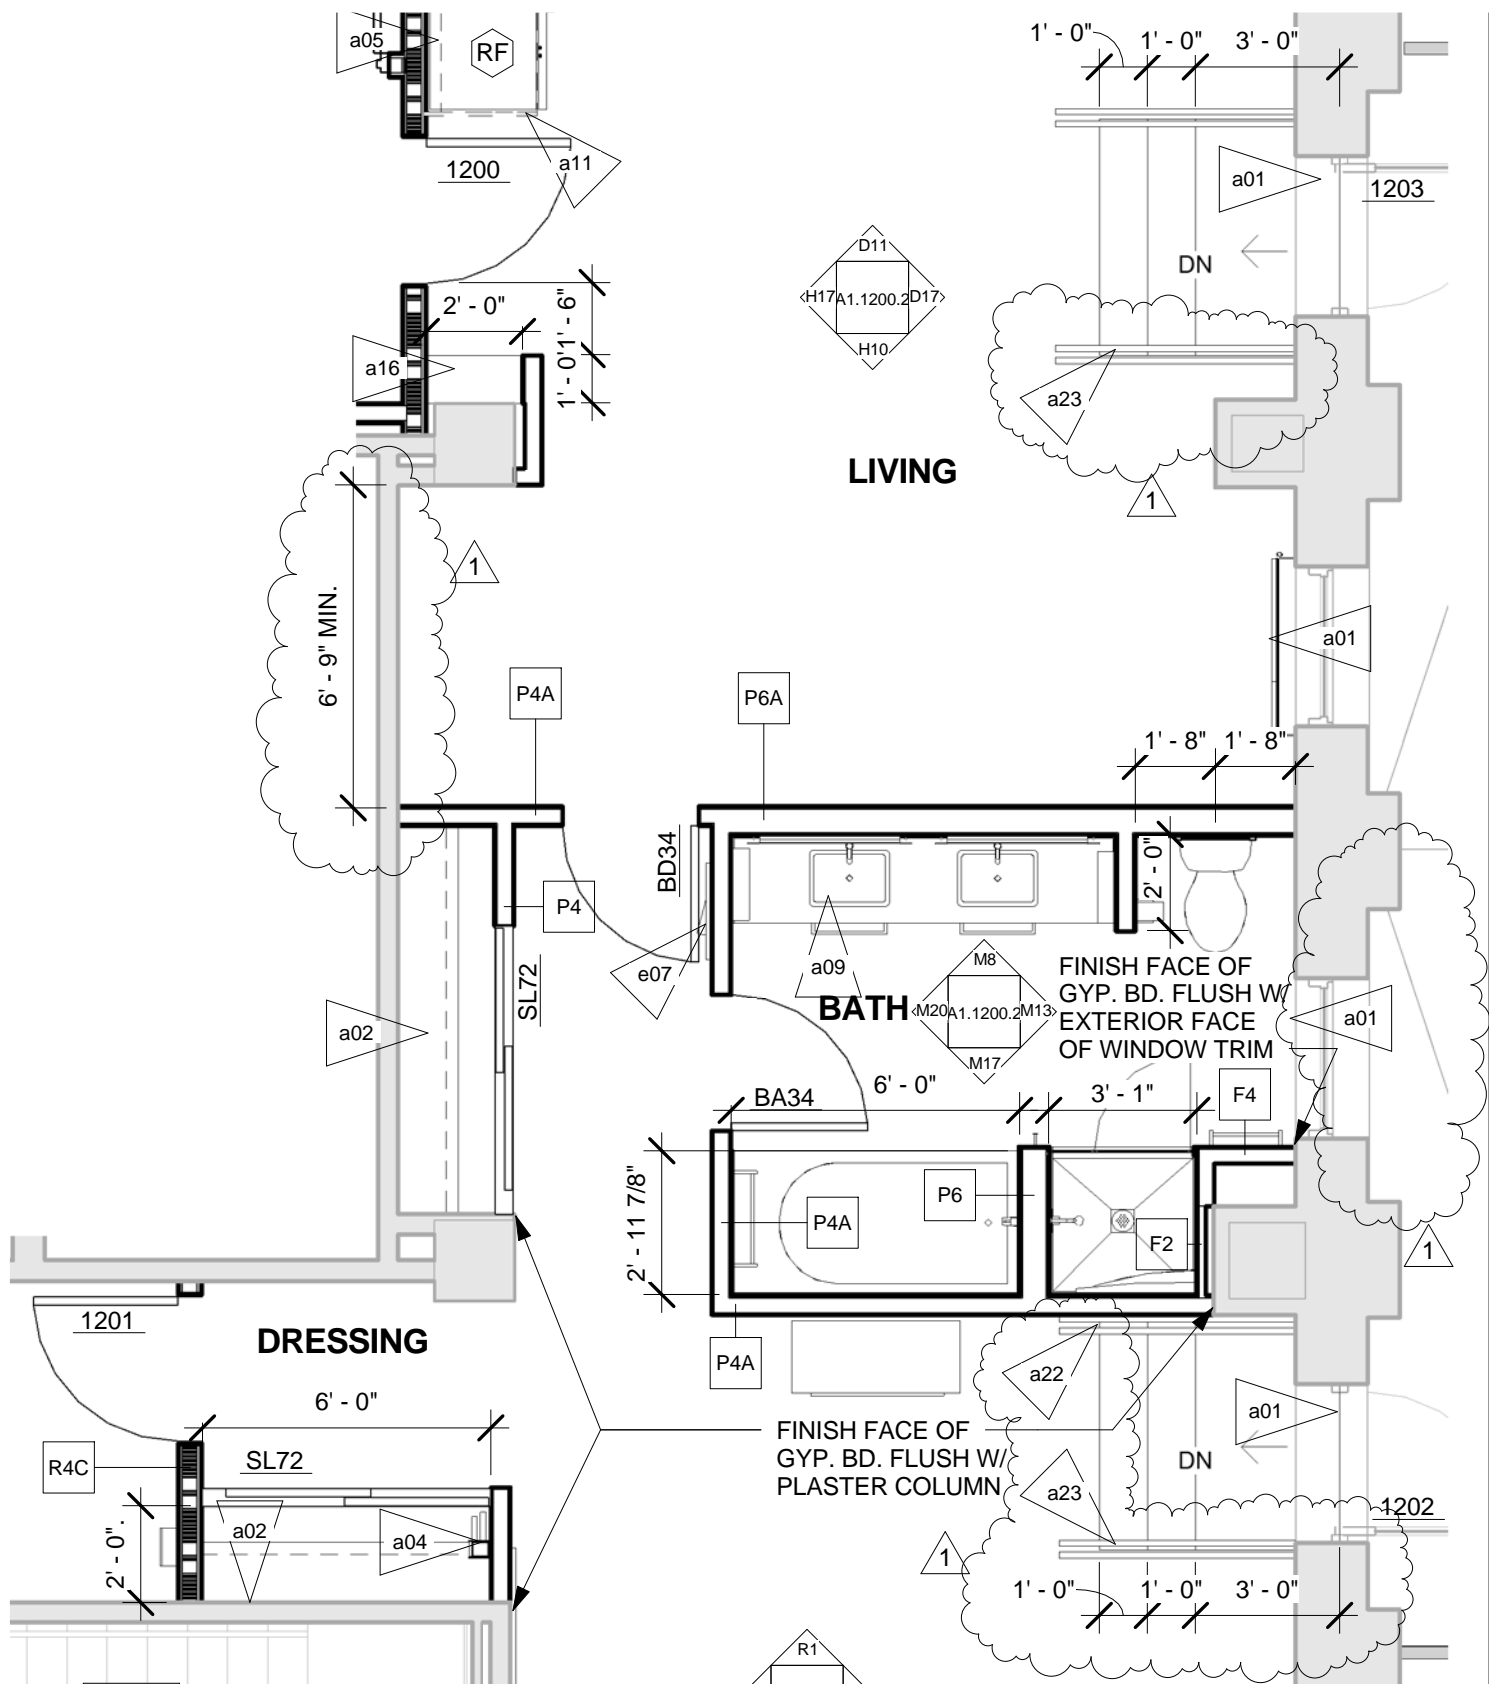

V17 SUITE 1200 - PENTHOUSE - ARCHITECTURAL
A1.1200.1 1/4" = 1'-0"

SHEET REFERENCE: V9 / A1.1200.1	DWG NO.	ALLEY·POYNER MACCHIETTO ARCHITECTURE
PROJECT NAME: Downtown Omaha Residence Inn	AD01	
PROJECT NUMBER: 09001	A2	1516 Cuming Street Omaha, NE 68102 Ph: 402.341.1544 Fx: 402.341.4735 alleypoyner.com
DATE: 2012-06-22	ADDENDUM #1	
<small>COPYRIGHT 2011 ALL RIGHTS RESERVED PRINTED OR ELECTRONIC DRAWINGS AND DOCUMENTATION MAY NOT BE REPRODUCED IN ANY FORM WITHOUT WRITTEN PERMISSION FROM ALLEY POYNER MACCHIETTO ARCHITECTURE</small>		

9 | 10 | 11 | 12 | 13 | 14 | 15 | 16

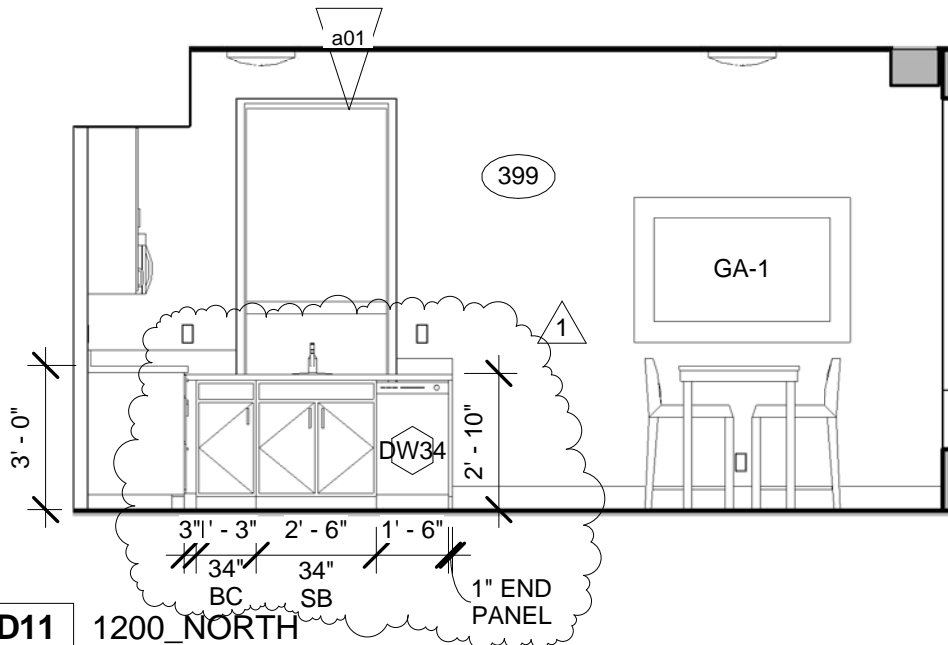

D11 1200_NORTH
 A1.1200.21/4" = 1'-0"

SHEET REFERENCE: A1.1200.2

PROJECT NAME: Downtown Omaha Residence Inn

PROJECT NUMBER: 09001

DATE: 2012-06-22

COPYRIGHT 2011 ALL RIGHTS RESERVED PRINTED OR ELECTRONIC DRAWINGS AND DOCUMENTATION MAY NOT BE REPRODUCED IN ANY FORM WITHOUT WRITTEN PERMISSION FROM ALLEY POYNER MACCHIETTO ARCHITECTURE

DWG NO.

AD01


A3

ADDENDUM #1


**ALLEY·POYNER
 MACCHIETTO
 ARCHITECTURE**

1516 Cuming Street
 Omaha, NE 68102
 Ph: 402.341.1544
 Fx: 402.341.4735
 alleypoyner.com


D17 1200_EAST
 A1.1200.21/4" = 1'-0"

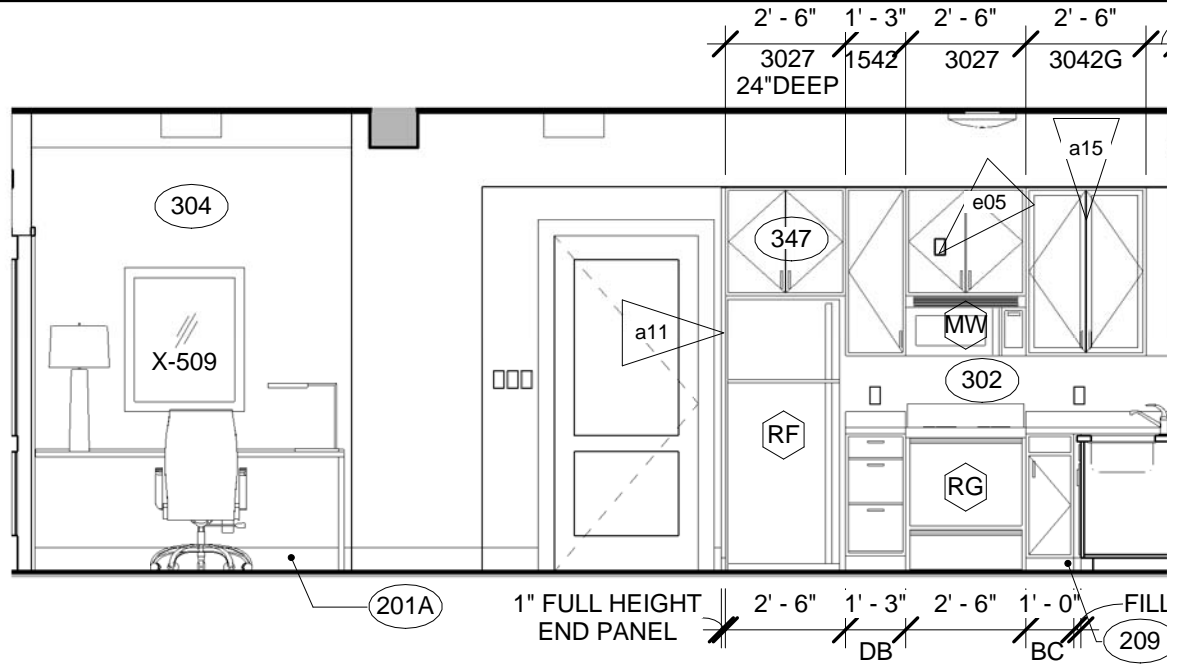

H17 1200_WEST
 A1.1200.21/4" = 1'-0"

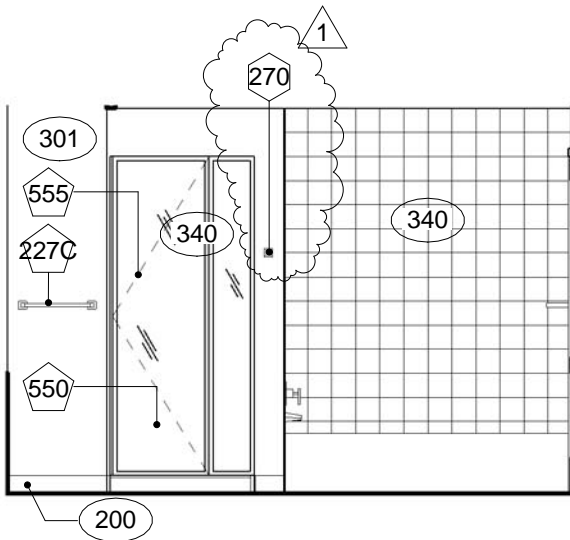

M17 1200 BATH SOUTH
 A1.1200.21/4" = 1'-0"

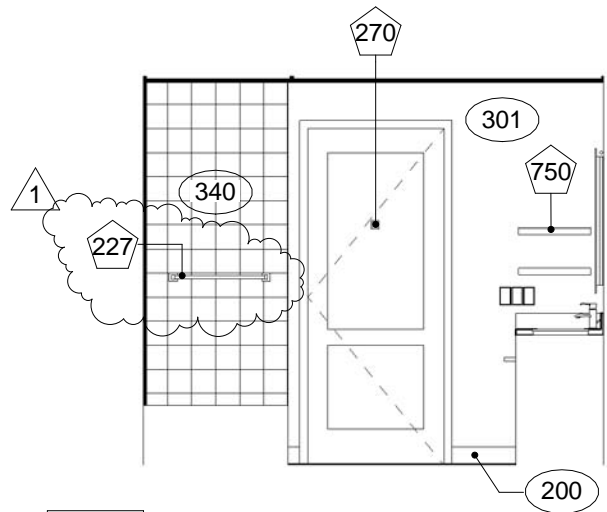

M20 1200 BATH WEST
 A1.1200.21/4" = 1'-0"

SHEET REFERENCE: A1.1200.2

PROJECT NAME: Downtown Omaha Residence Inn

PROJECT NUMBER: 09001

DATE: 2012-06-22

COPYRIGHT 2011 ALL RIGHTS RESERVED PRINTED OR ELECTRONIC DRAWINGS AND DOCUMENTATION MAY NOT BE REPRODUCED IN ANY FORM WITHOUT WRITTEN PERMISSION FROM ALLEY POYNER MACCHIETTO ARCHITECTURE

DWG NO.


AD01

A4

ADDENDUM #1

**ALLEY·POYNER
 MACCHIETTO
 ARCHITECTURE**


1516 Cuming Street
 Omaha, NE 68102
 Ph: 402.341.1544
 Fx: 402.341.4735
 alleypoyner.com

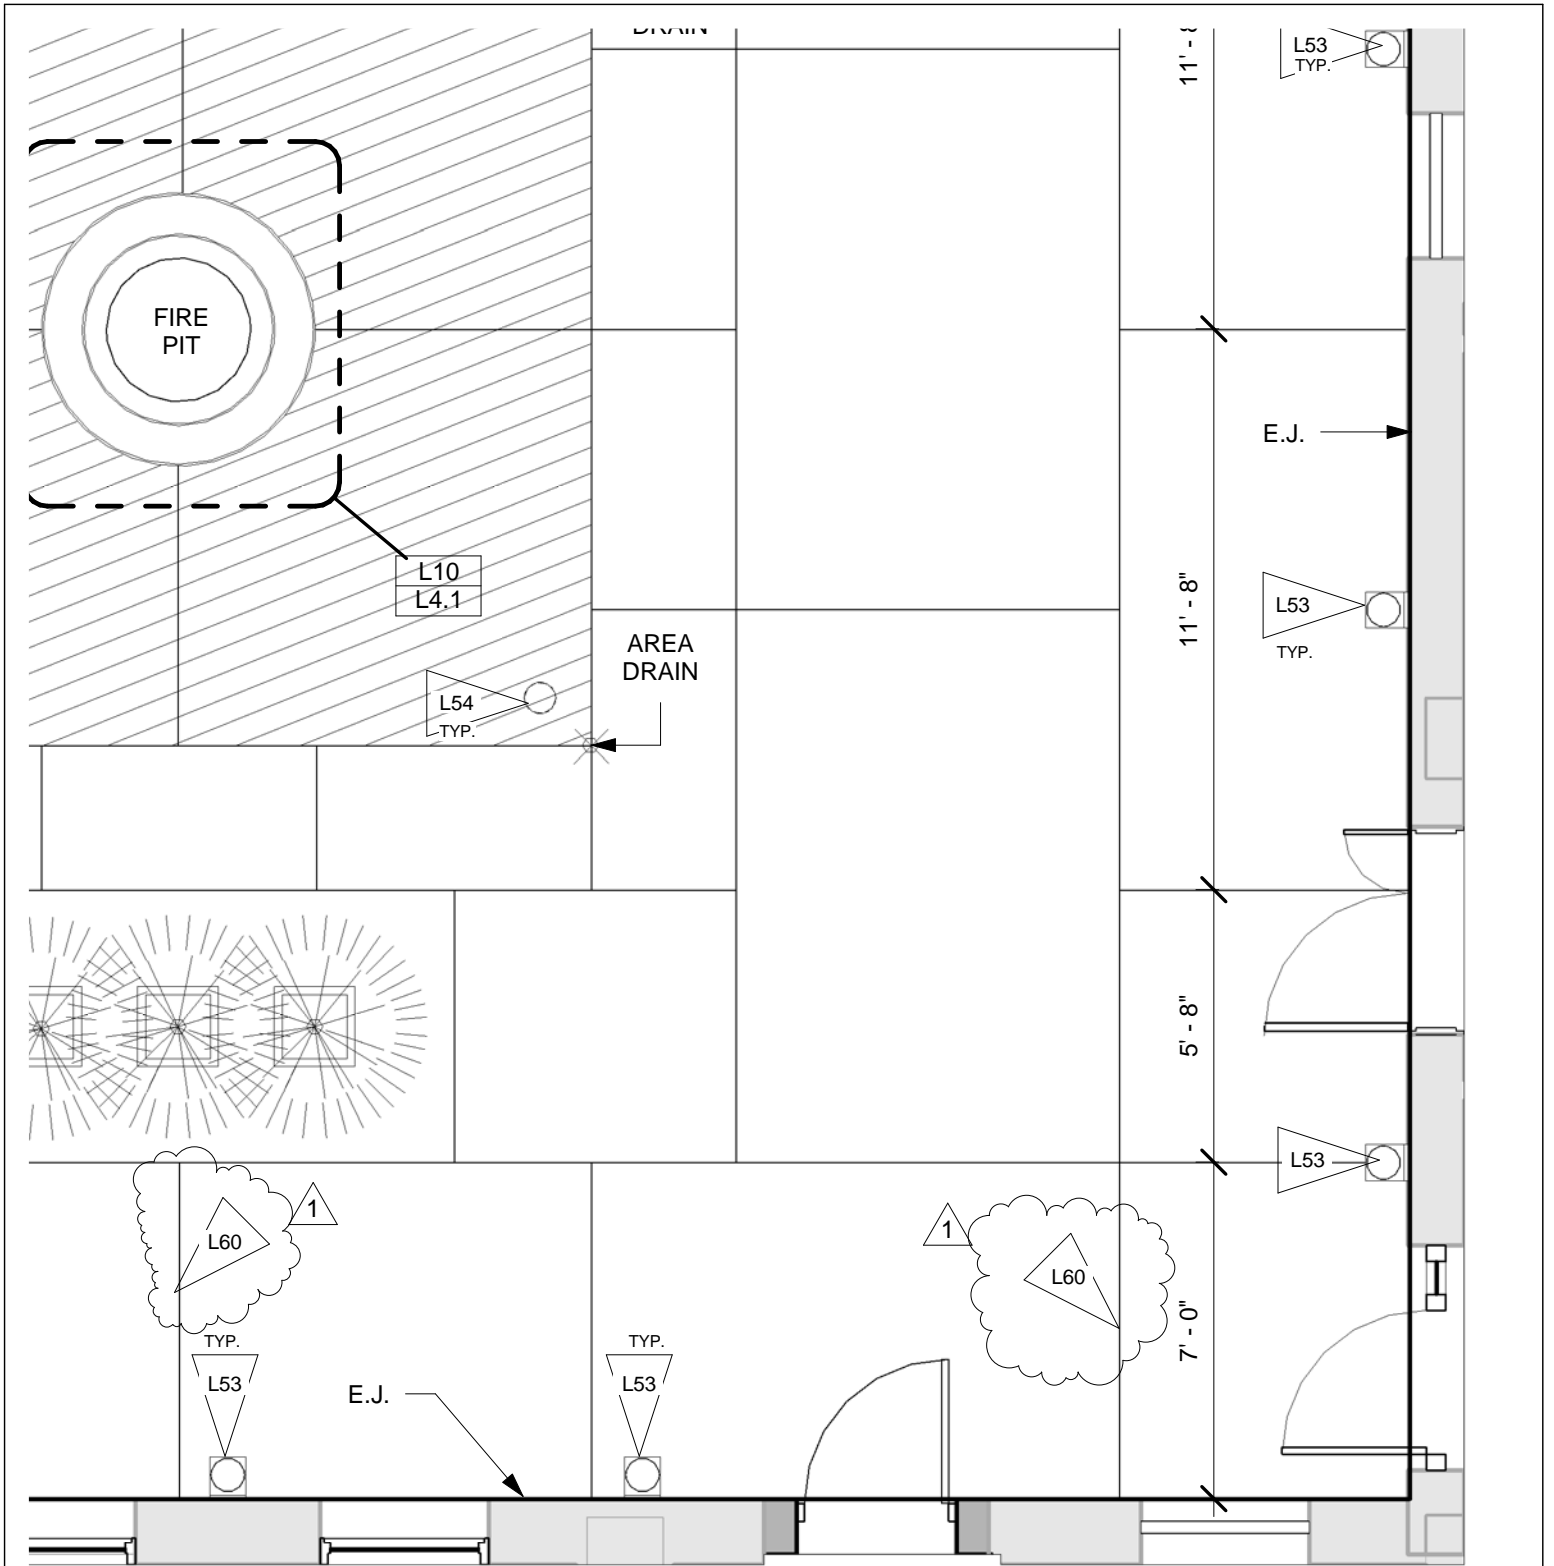

V1 ENLARGED COURTYARD
 L1.1 1/4" = 1'-0"

SHEET REFERENCE: L1.1		DWG NO. AD02 A1	ALLEY•POYNER MACCHIETTO ARCHITECTURE 1516 Cuming Street Omaha, NE 68102 Ph: 402.341.1544 Fx: 402.341.4735 alleypoyner.com
PROJECT NAME: Downtown Omaha Residence Inn			
PROJECT NUMBER: 09001			
DATE: 2012-06-22			
<small>COPYRIGHT 2011 ALL RIGHTS RESERVED PRINTED OR ELECTRONIC DRAWINGS AND DOCUMENTATION MAY NOT BE REPRODUCED IN ANY FORM WITHOUT WRITTEN PERMISSION FROM ALLEY POYNER MACCHIETTO ARCHITECTURE</small>		ADDENDUM #1	

3/4" DIA HILTI KWIK BOLT TZ- SS 304
w/ 4 3/4" EMBEDMENT INTO CONC.
STRUCTURE BEHIND BRICK
VENEER. BRICK VENEER
ESTIMATED TO BE 4" THICK. BOLTS
2" FROM EDGE OF PL. 1 BOLT PER
FLOOR TO BE TESTED IN PLACE.

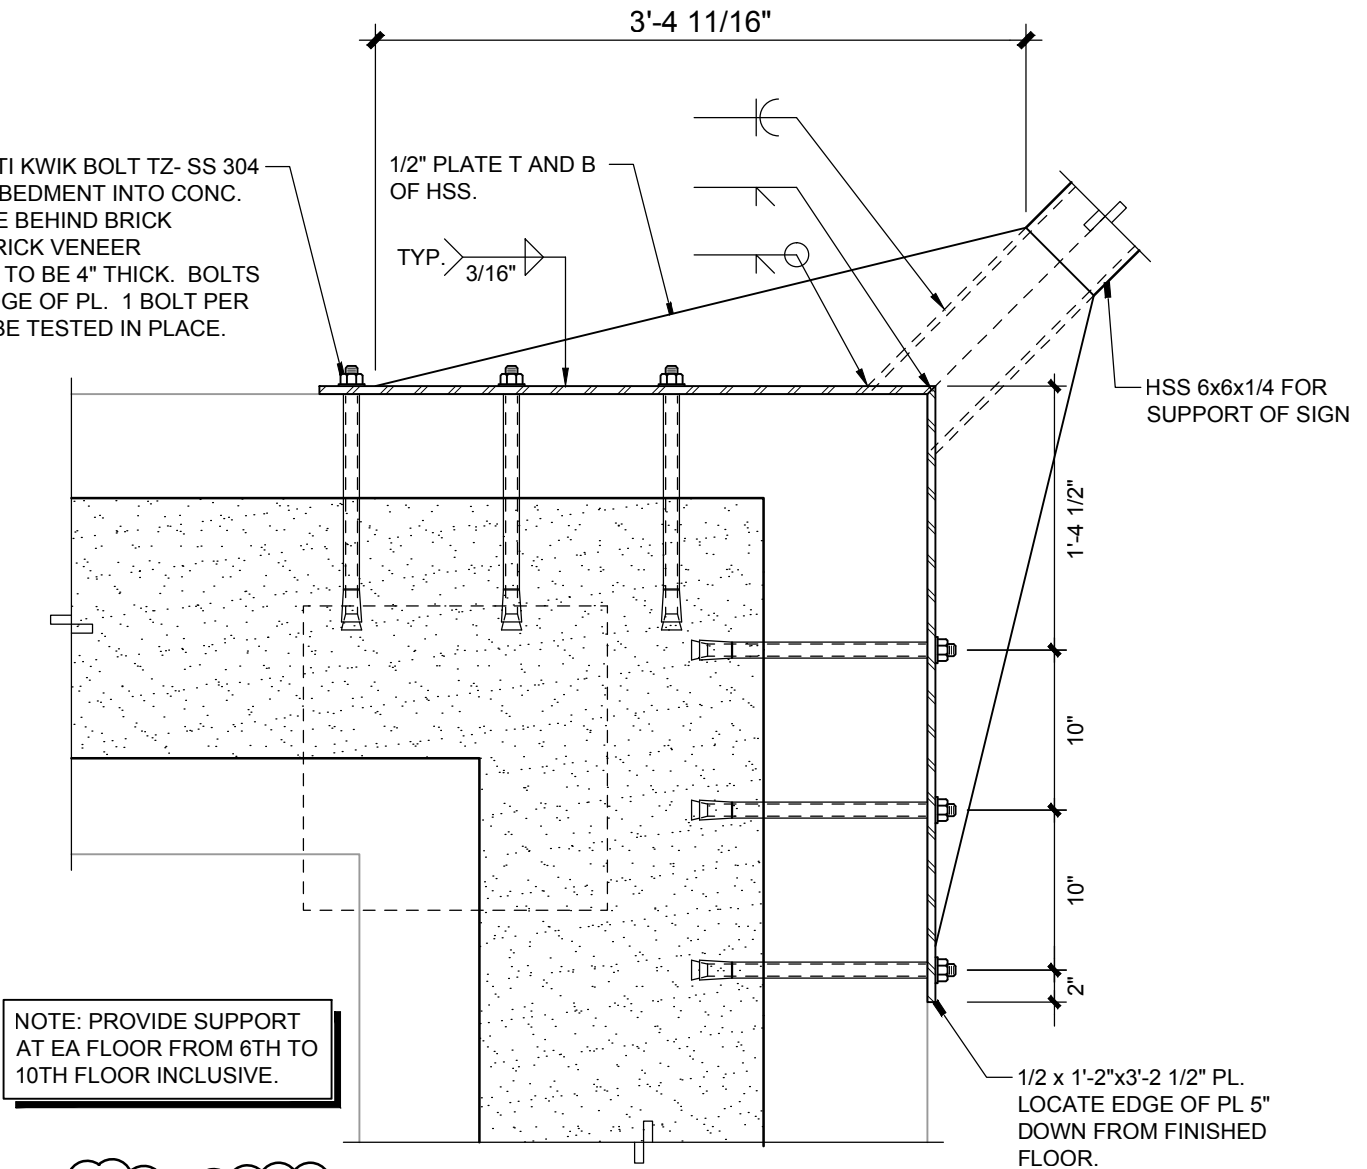

NOTE: PROVIDE SUPPORT
AT EA FLOOR FROM 6TH TO
10TH FLOOR INCLUSIVE.

1 : DETAIL MODIFIED

3 SIGN SUPPORT DETAIL

1" = 1'-0"




Job Number: 748-362
thompson, dreessen & dornier, inc.
10836 Old Mill Rd
Omaha, NE 68154
p.402.330.8860 www.td2co.com


Addendum: Addendum #1
Date: 06-22-12
Drawn By: DJS
Sheet: S0.00

Downtown Omaha Residence Inn by Marriott

Structural Notes

SDS-001

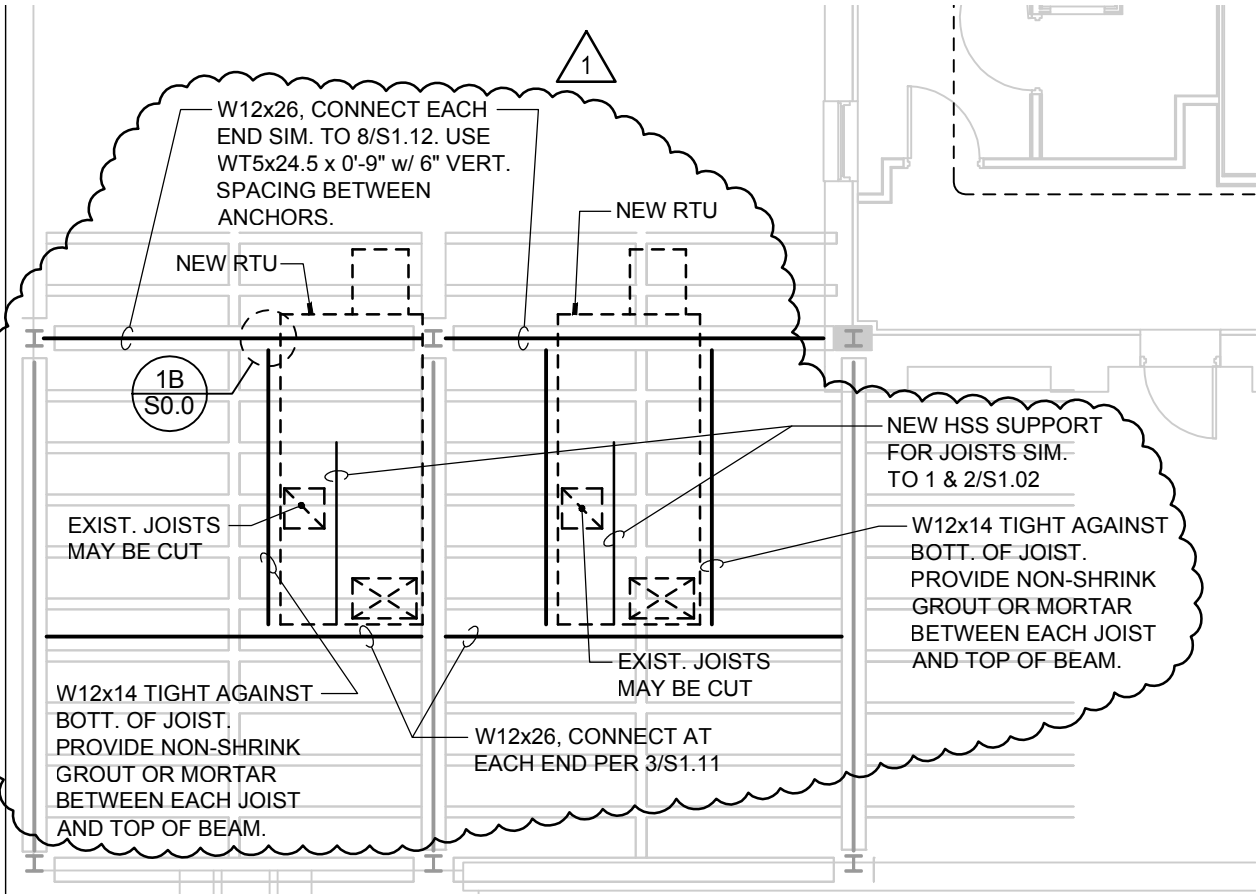

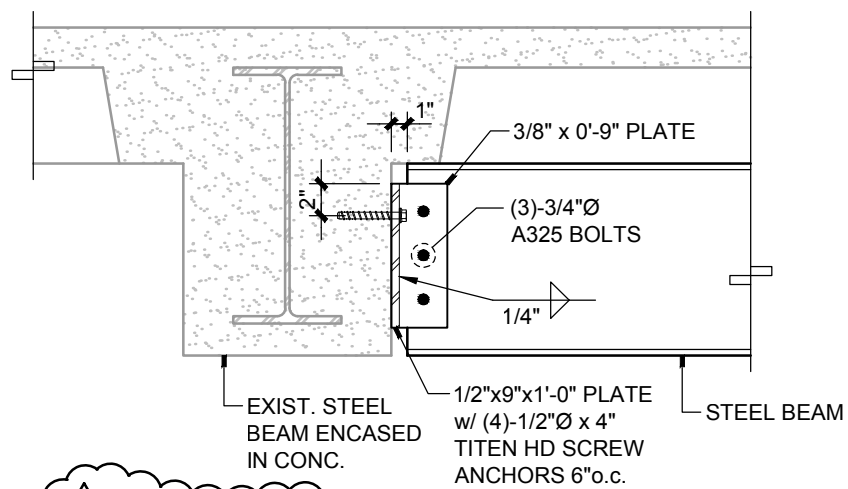

1 : DETAIL ADDED

3

SECTION

1" = 1'-0"




Job Number: 748-362
 thompson, dreessen & dornier, inc.
 10836 Old Mill Rd
 Omaha, NE 68154
 p.402.330.8860 www.td2co.com

Addendum: Addendum #1
 Date: 06-22-12
 Drawn By: DJS
 Sheet: S1.11

Downtown Omaha Residence Inn by Marriott

11th & 12th Floor Plans

SDS-003

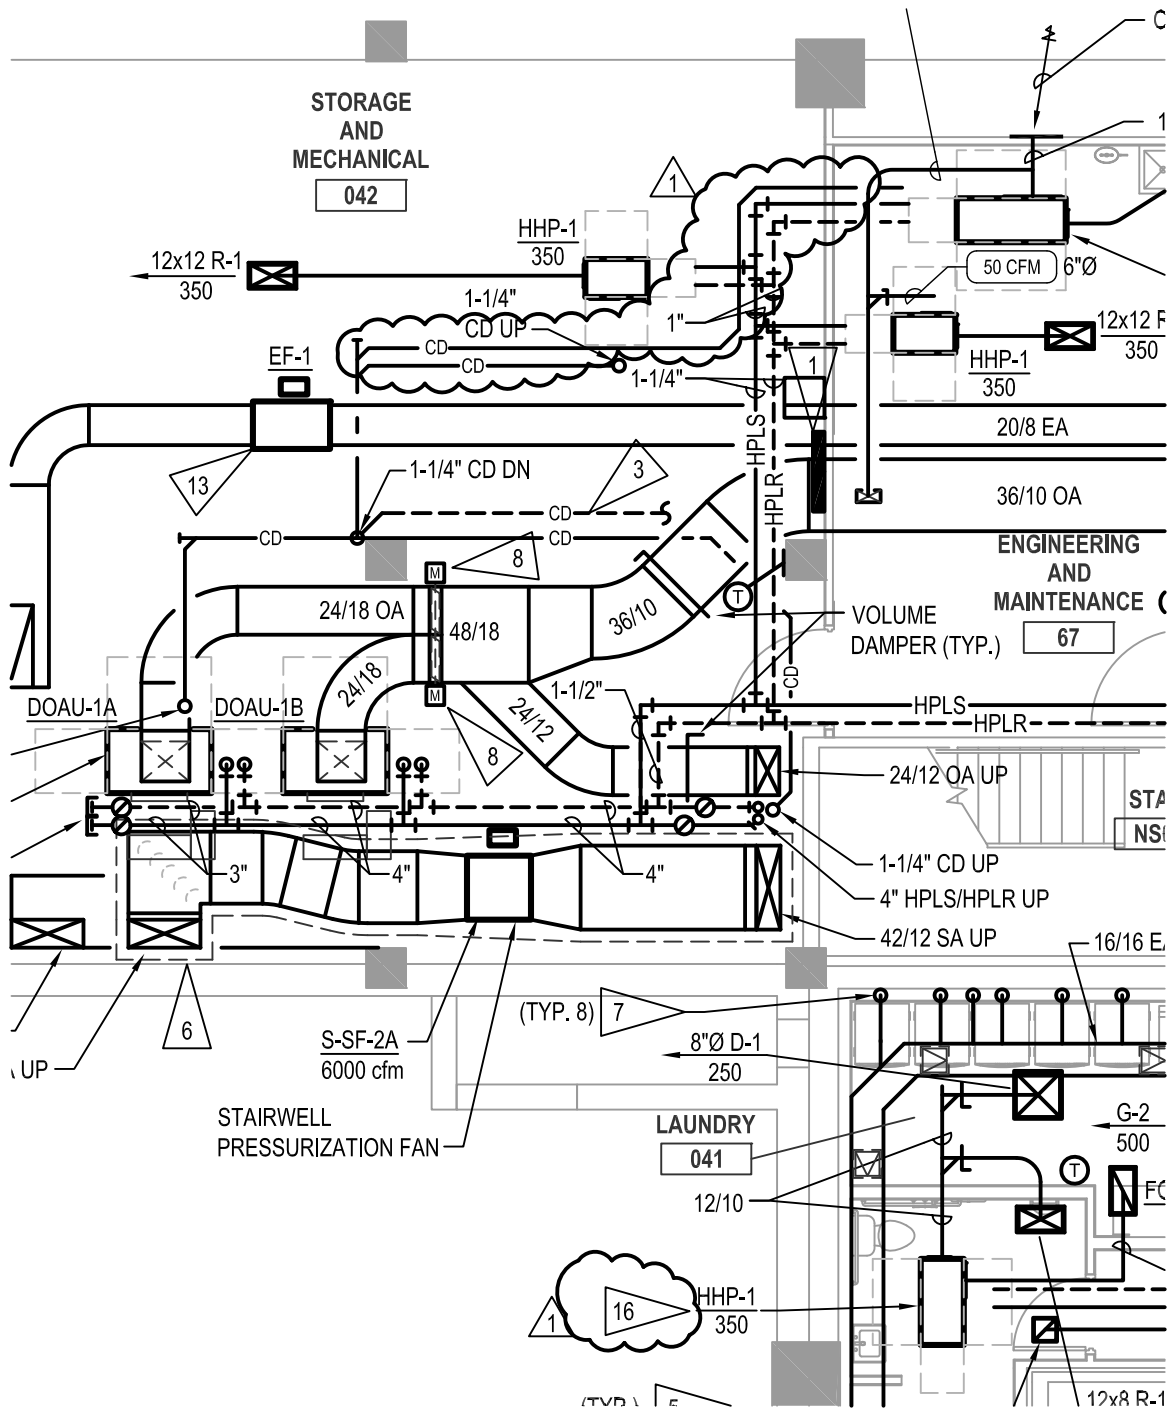

- 15 SIZE REFRIGERANT PIPING PER MANUFACTURERS RECOMMENDATIONS. CONNECT 3/4" COPPER CONDENSATE PIPE INTO CONDENSATE PIPING BELOW FLOOR
- 16 CONNECT 3/4" COPPER CONDENSATE PIPING INTO CONDENSATE MAIN BELOW FLOOR



mechanical | electrical | technology | commissioning

4940 North 118th Street
Omaha, NE 68164


P: 402.491.4144

www.morrisseyengineering.com

Downtown Omaha Residence Inn by Marriott

project no.: 11290	drawing referenced: M1.00
date: 06-22-2012	addendum no.: 1

sketch **M1.00a**

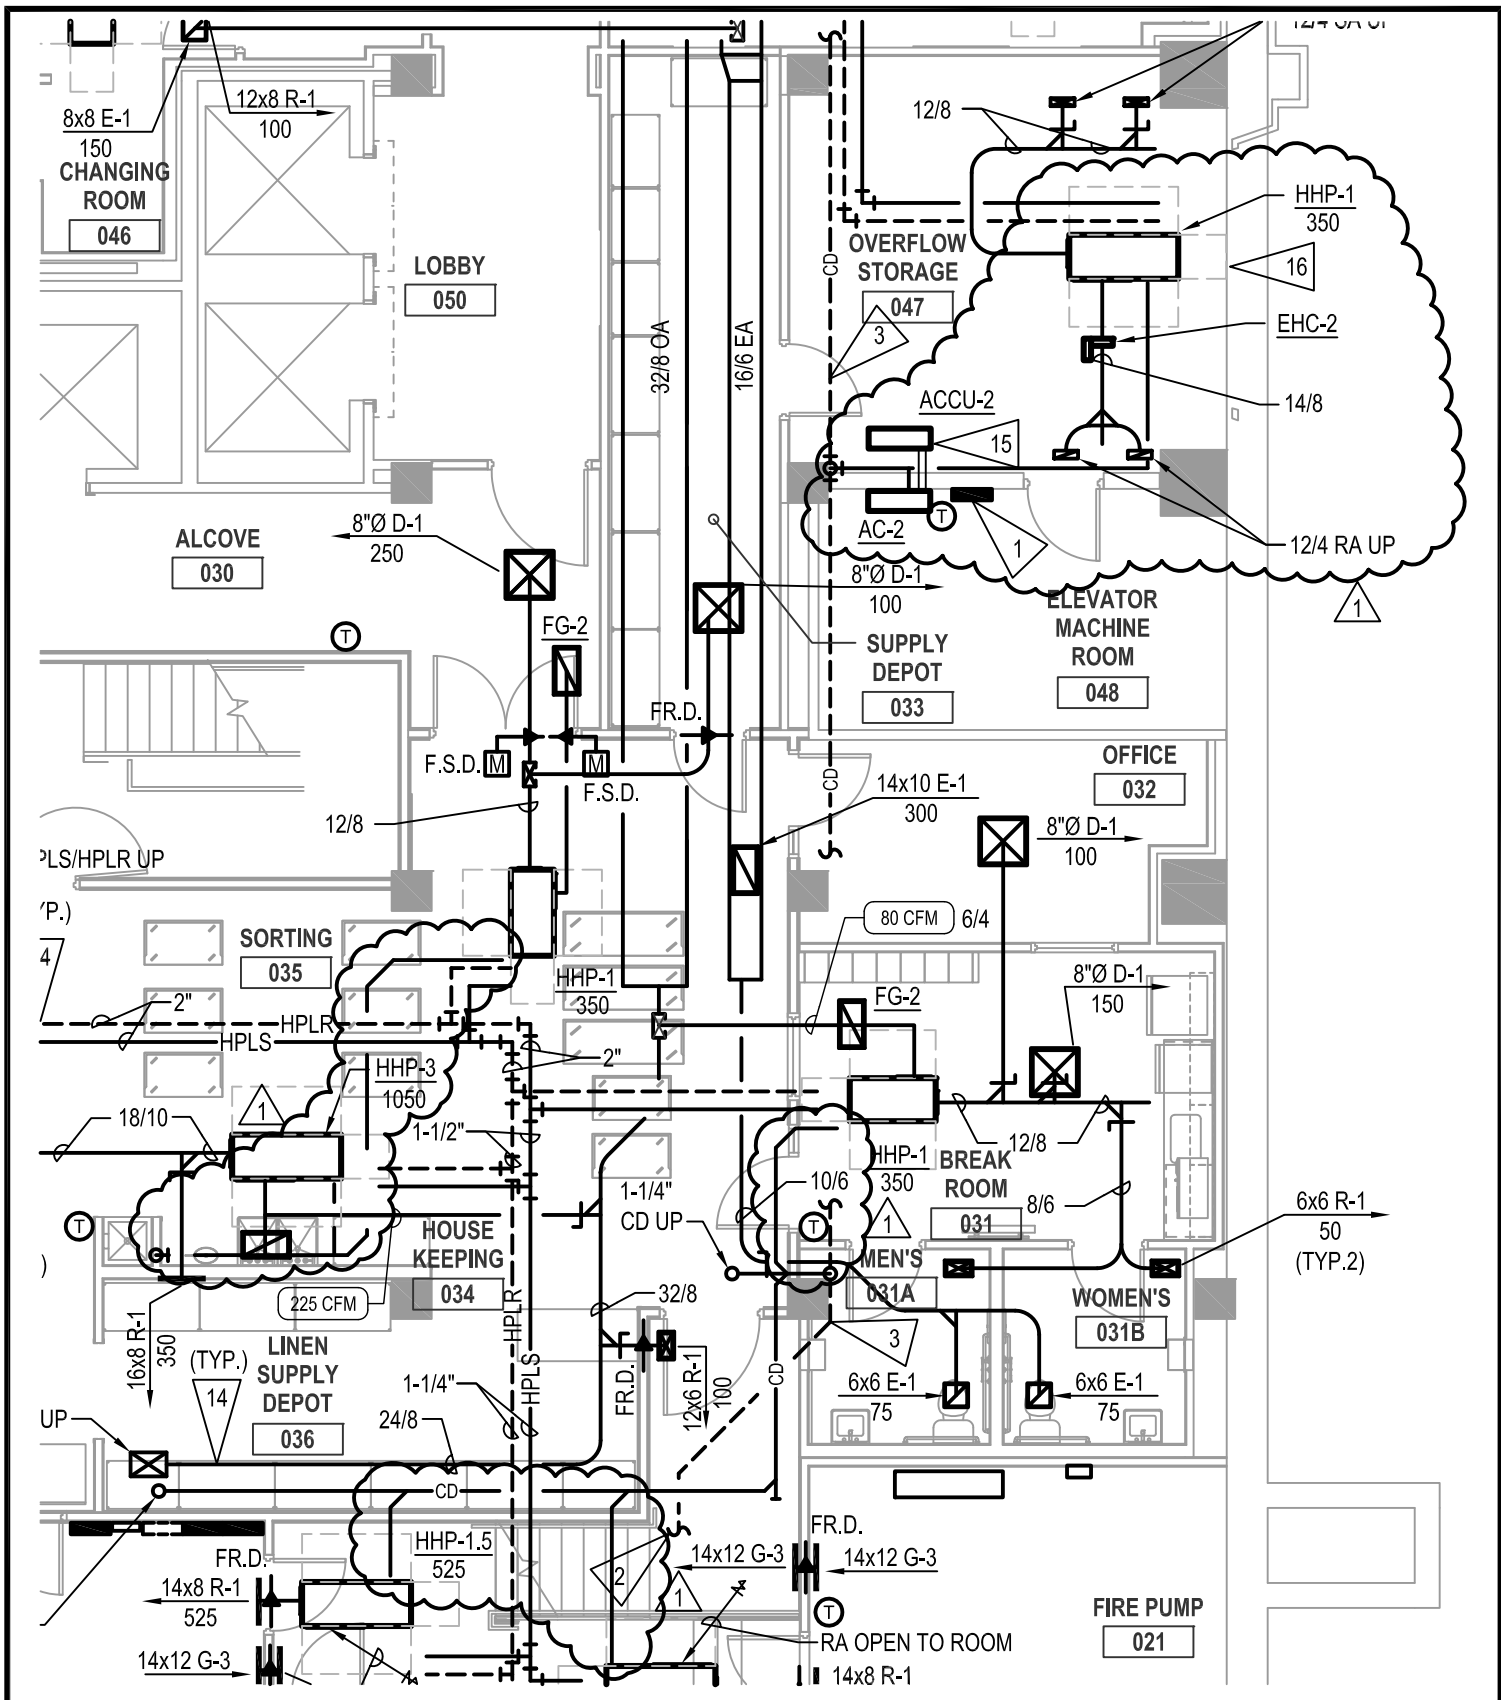

mechanical | electrical | technology | commissioning

4940 North 118th Street
Omaha, NE 68164

P: 402.491.4144

www.morrisseyengineering.com

Downtown Omaha Residence Inn by Marriott



project no.: 11290

drawing referenced: M1.00

date: 06-22-2012

addendum no.: 1

sketch **M1.00b**

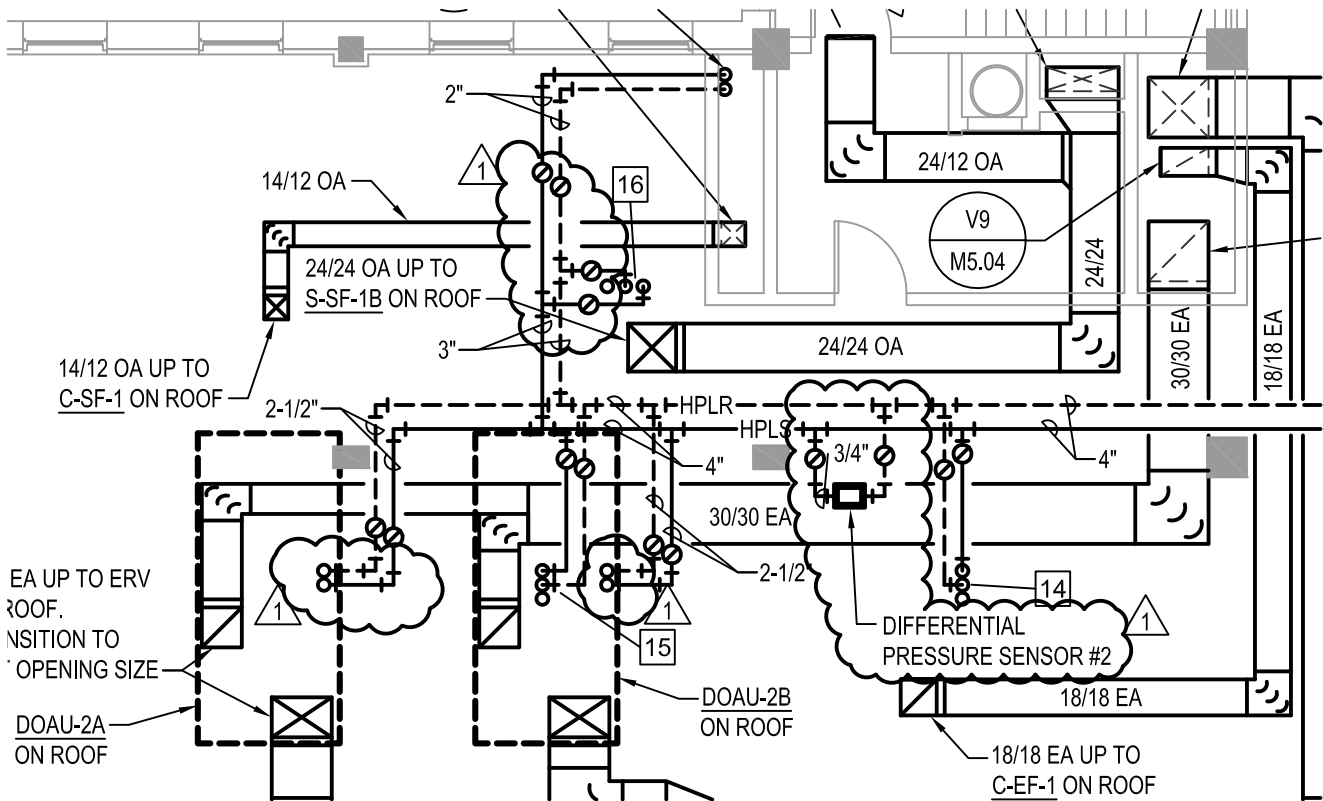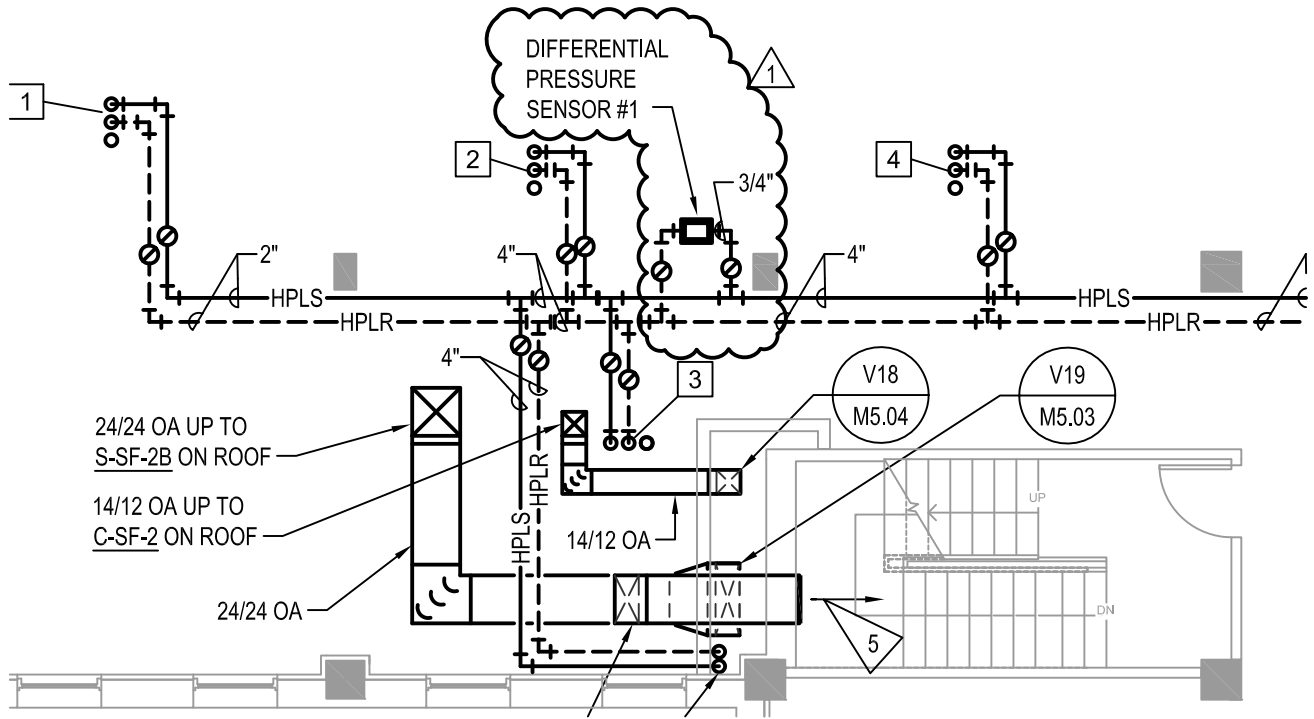

mechanical | electrical | technology | commissioning

4940 North 118th Street
Omaha, NE 68164

P: 402.491.4144

www.morrisseyengineering.com

Downtown Omaha Residence Inn by Marriott

project no.: 11290

drawing referenced:


M1.04

date: 06-22-2012

addendum no.:

1

sketch **M1.04a**

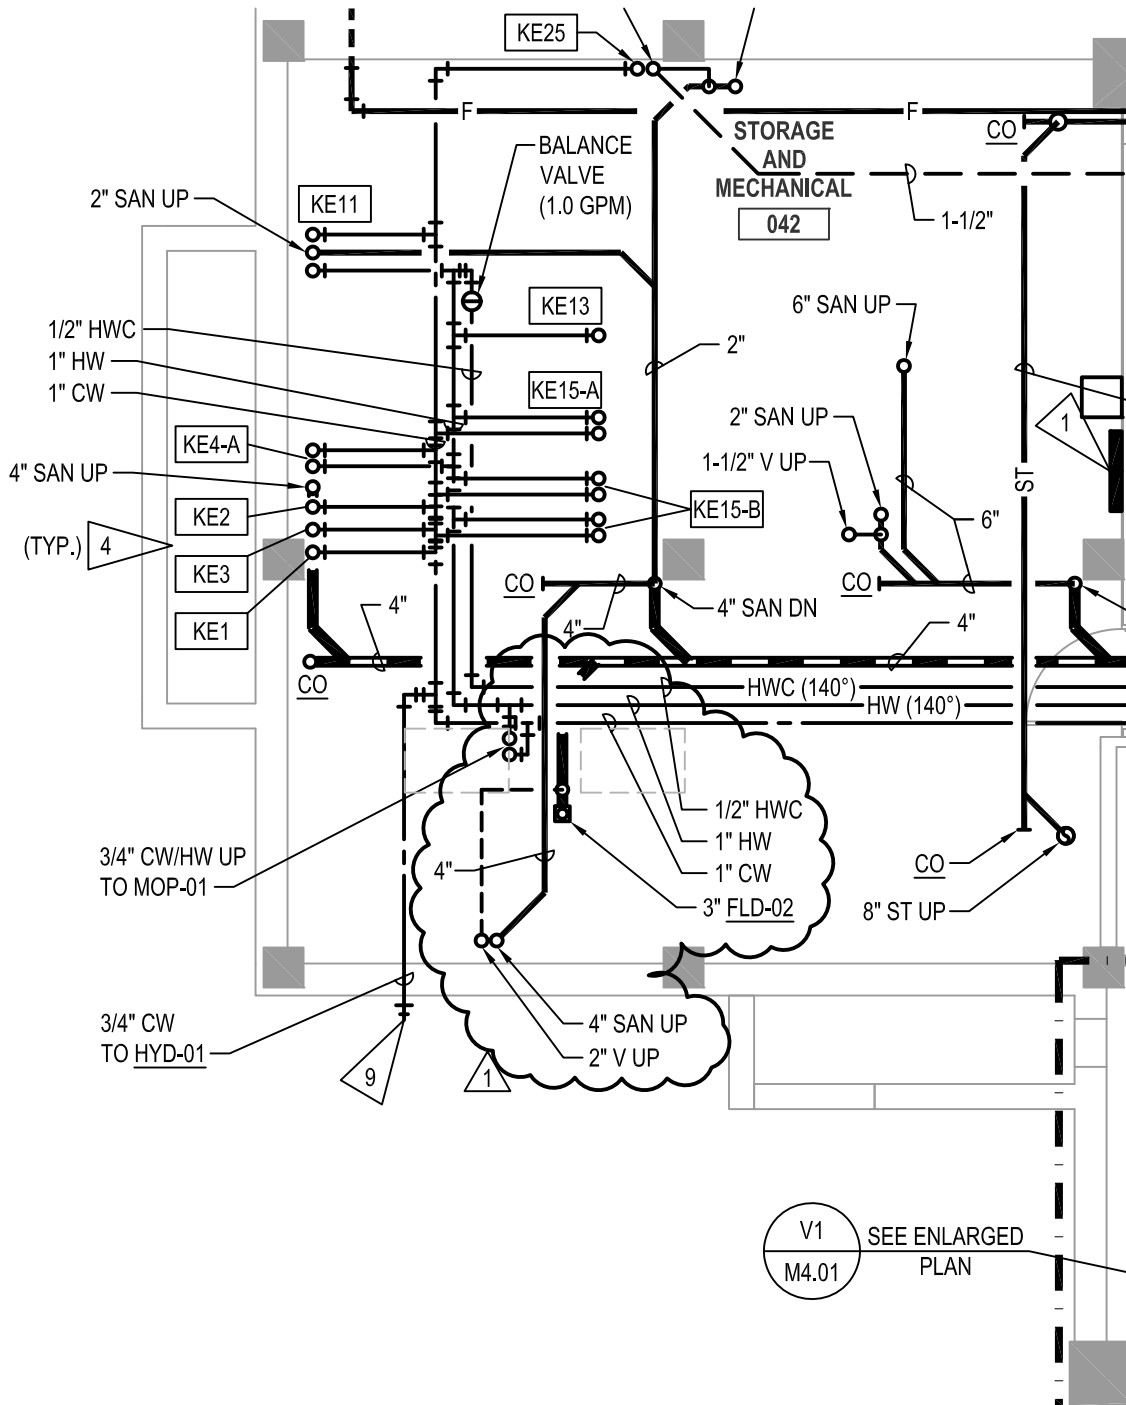

mechanical | electrical | technology | commissioning

4940 North 118th Street
Omaha, NE 68164

P: 402.491.4144

www.morrisseyengineering.com

Downtown Omaha Residence Inn by Marriott

project no.: 11290

drawing referenced:

M2.00



date: 06-22-2012

addendum no.:

1

sketch

M2.00a

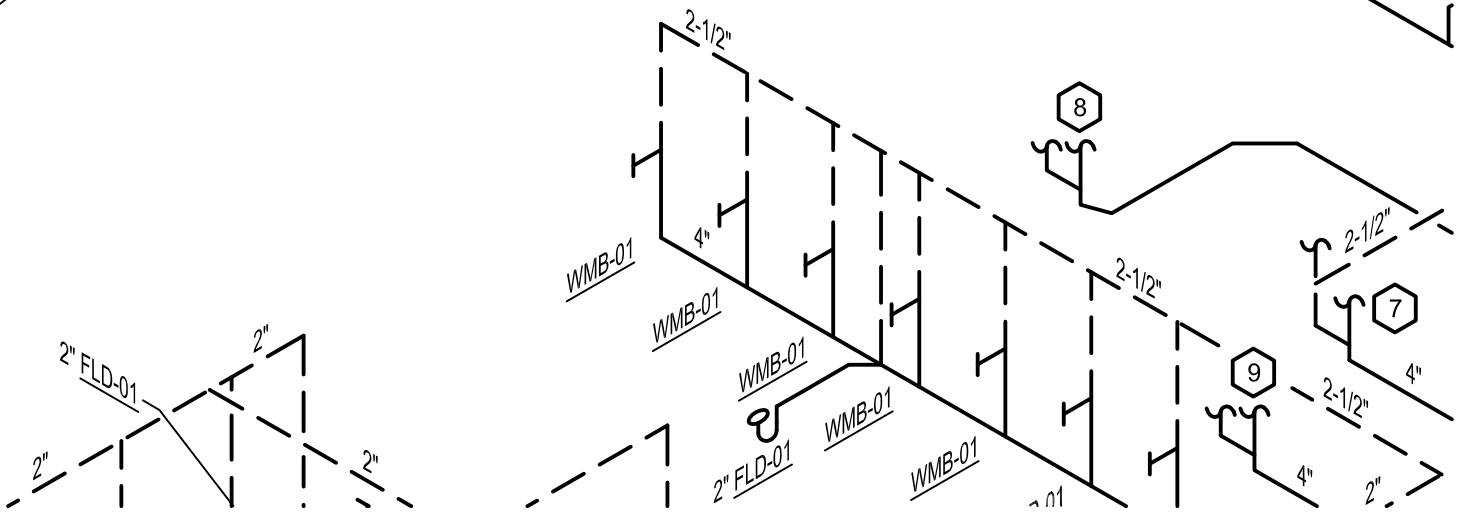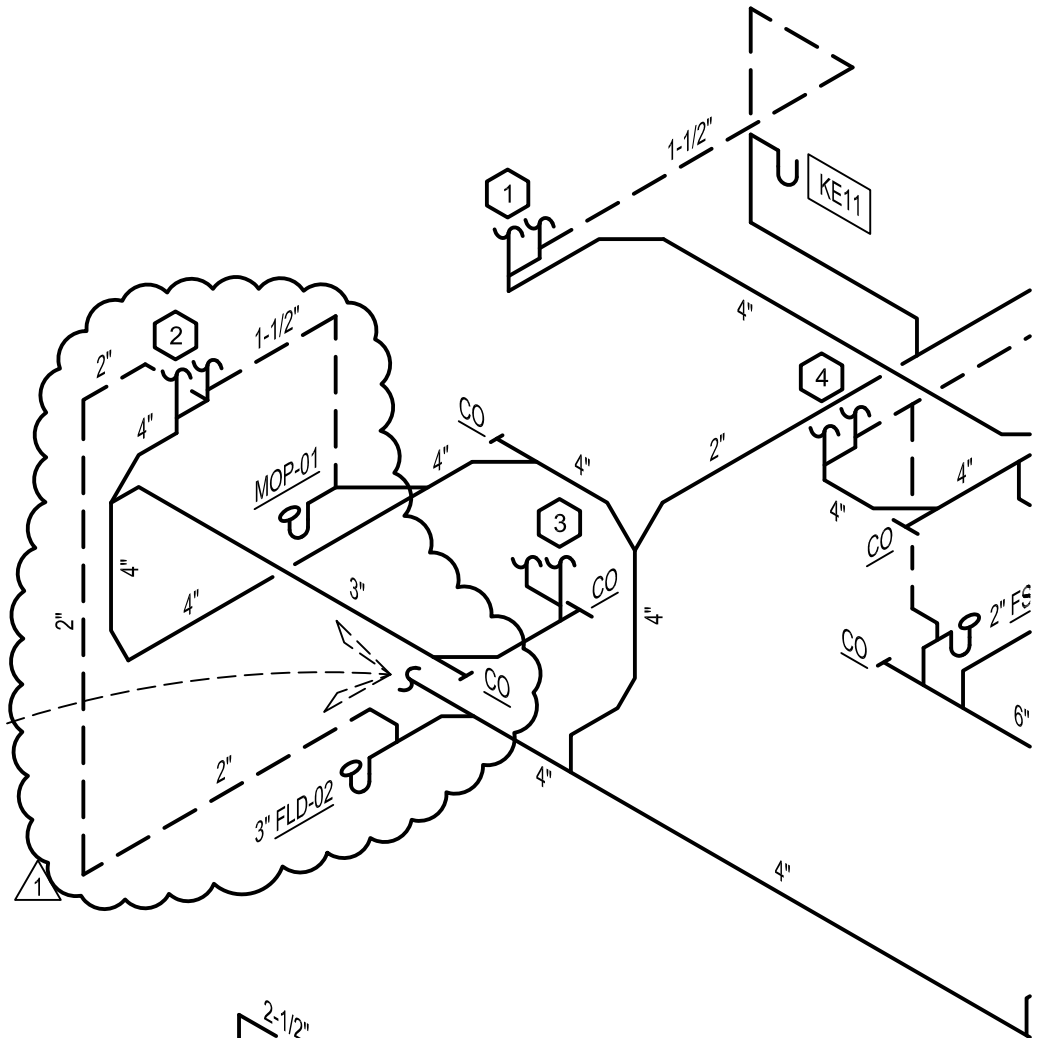

morrissey
engineering inc

mechanical | electrical | technology | commissioning

4940 North 118th Street
Omaha, NE 68164

P: 402.491.4144

www.morrisseyengineering.com

Downtown Omaha Residence Inn by Marriott

project no.: 11290

drawing referenced:

M4.09

date: 06-22-2012

addendum no.:

1

sketch

M4.09a

DUCTLESS SPLIT AIR CONDITIONER

	PLAN TAG	AC-1 / ACCU-1	AC-2 / ACCU-2	
GENERAL	MANUFACTURER (8)	CARRIER	CARRIER	
	MODEL NUMBER	(1)	(7)	
	SERVES	SEE PLANS	SEE PLANS	
	CONFIGURATION	WALL (1)	WALL (7)	
	MAXIMUM SIZE (LxWxH)(IN)	(2)	(8)	
	ACCESSORIES	(3)	(3)	
	REMARKS	(4) (5)	(4) (5)	
	AIRFLOW	INSIDE AIRFLOW (CFM)	750 (MED)	235
FAN SPEED		3	3	
ELECTRICAL	VOLTS	208	208	
	PHASE	1	1	
	OVERCURRENT PROT. (INDOOR/OUTDOOR)	15/40	15/15	
	MINIMUM CIRCUIT AMP. (INDOOR/OUTDOOR)	0.55/23.8	-	
	REMARKS	(6)	(6)	
HEAT	MBH (KW)	-	-	
	STAGES	-	-	
	KW / STAGE	-	-	
	REMARKS	-	-	
COOLING	AMBIENT AIR DB (°F)	95	95	
	ENTERING AIR DB/WB (°F)	80/67	80/67	
	TOTAL CAPACITY (MBH)	36.0	12.0	
	SENSIBLE CAPACITY (MBH)	-	9.0	
	REFRIGERANT TYPE	R-410A	R-410A	
	MINIMUM SEER	13.0	13.0	
REMARKS	(4)	(4)		
REMARKS	(1) MODEL NO: INDOOR UNIT: 40QNC036 OUTDOOR UNIT: 38HDF036			
	(2) SIZE: INDOOR UNIT: 58x14x10 OUTDOOR UNIT: 45x38x18			
(3) PROVIDE MANUFACTURER'S WIRED WALL MOUNTED DIGITAL CONTROL THERMOSTAT.				
(4) PROVIDE LOW AMBIENT ACCESSORIES (COOLING TO -20°F) AND WITH MANUFACTURER'S WASHABLE FILTERS.				
(5) PROVIDE COMPRESSORS WITH 5-YEAR WARRANTY.				
(6) POWER FOR INDOOR UNIT SHALL COME OFF OF OUTDOOR CONDENSING UNIT.				
<div style="border: 1px solid black; border-radius: 50%; padding: 10px; display: inline-block;"> (7) MODEL NO: INDOOR UNIT: 40QNC012 OUTDOOR UNIT: 38HDF012 </div>				
(8) SIZE: INDOOR UNIT: 31x10x8 OUTDOOR UNIT: 30x23x11				



mechanical | electrical | technology | commissioning

4940 North 118th Street
Omaha, NE 68164

P: 402.491.4144

www.morrisseyengineering.com

Downtown Omaha Residence Inn by Marriott

project no.: 11290

drawing referenced: M7.03

date: 06-22-2012

addendum no.: 1

sketch **M7.03a**

HEATING COIL SCHEDULE

	PLAN TAG	EDH-1	EDH-1A	EDH-1B	EDH-2
GENERAL	MANUFACTURER	INDEECO	INDEECO	INDEECO	INDEECO
	MODEL NUMBER	-	-	-	-
	SERVES	CORRIDOR	DOAU-1A	DOAU-1B	CORRIDOR
	APPROXIMATE SIZE (LxW)(IN)	12x8	24x24	24x24	14x8
	TYPE	OPEN COIL	FINNED TUBULAR	FINNED TUBULAR	OPEN COIL
	MAX. FINS PER INCH	-	-	-	-
	REMARKS	(2)	(2)	(2)	(2)
	AIR	AIRFLOW (CFM)	420	2,000	2,000
MAX. FACE VELOCITY		630	500	500	420
MAX. AIR PRESSURE DROP (IN. WG)		0.1	0.1	0.1	0.1
ENTERING AIR TEMP (°F)		60.0	-10.0	-10.0	60.0
LEAVING AIR TEMP (°F)		75.0	40.0	40.0	87.0
TOTAL CAPACITY (MBH)		6.82	109.1	109.1	10.2
REMARKS		-	-	-	-
ELECTRIC	VOLTAGE/PHASE	208 / 3	208 / 3	208 / 3	208 / 1
	CAPACITY (KW)	2.0	32	32	3.0
	NUMBER OF STAGES	SCR	SCR	SCR	STAGED
	KW PER STAGE	-	-	-	1.5 KW/STAGE
	REMARKS	(1)	(1)	(1)	-
REMARKS	<p>(1) PROVIDE WITH: - SCR CONTROL - ELECTRIC HEATER CONTROLLED BY TEMPERATURE CONTROL SYSTEM</p> <p>(2) FLANGED HEATER</p> <p>(3) PROVIDE WITH: - PROTECTIVE SCREENS ON INLET AND OUTLET (3/8" WIRE MESH SCREEN)</p>				



mechanical | electrical | technology | commissioning

4940 North 118th Street
 Omaha, NE 68164

P: 402.491.4144

www.morrisseyengineering.com

Downtown Omaha Residence Inn by Marriott


project no.: 11290

drawing referenced: M7.03

date: 06-22-2012

addendum no.: 1

sketch **M7.03b**

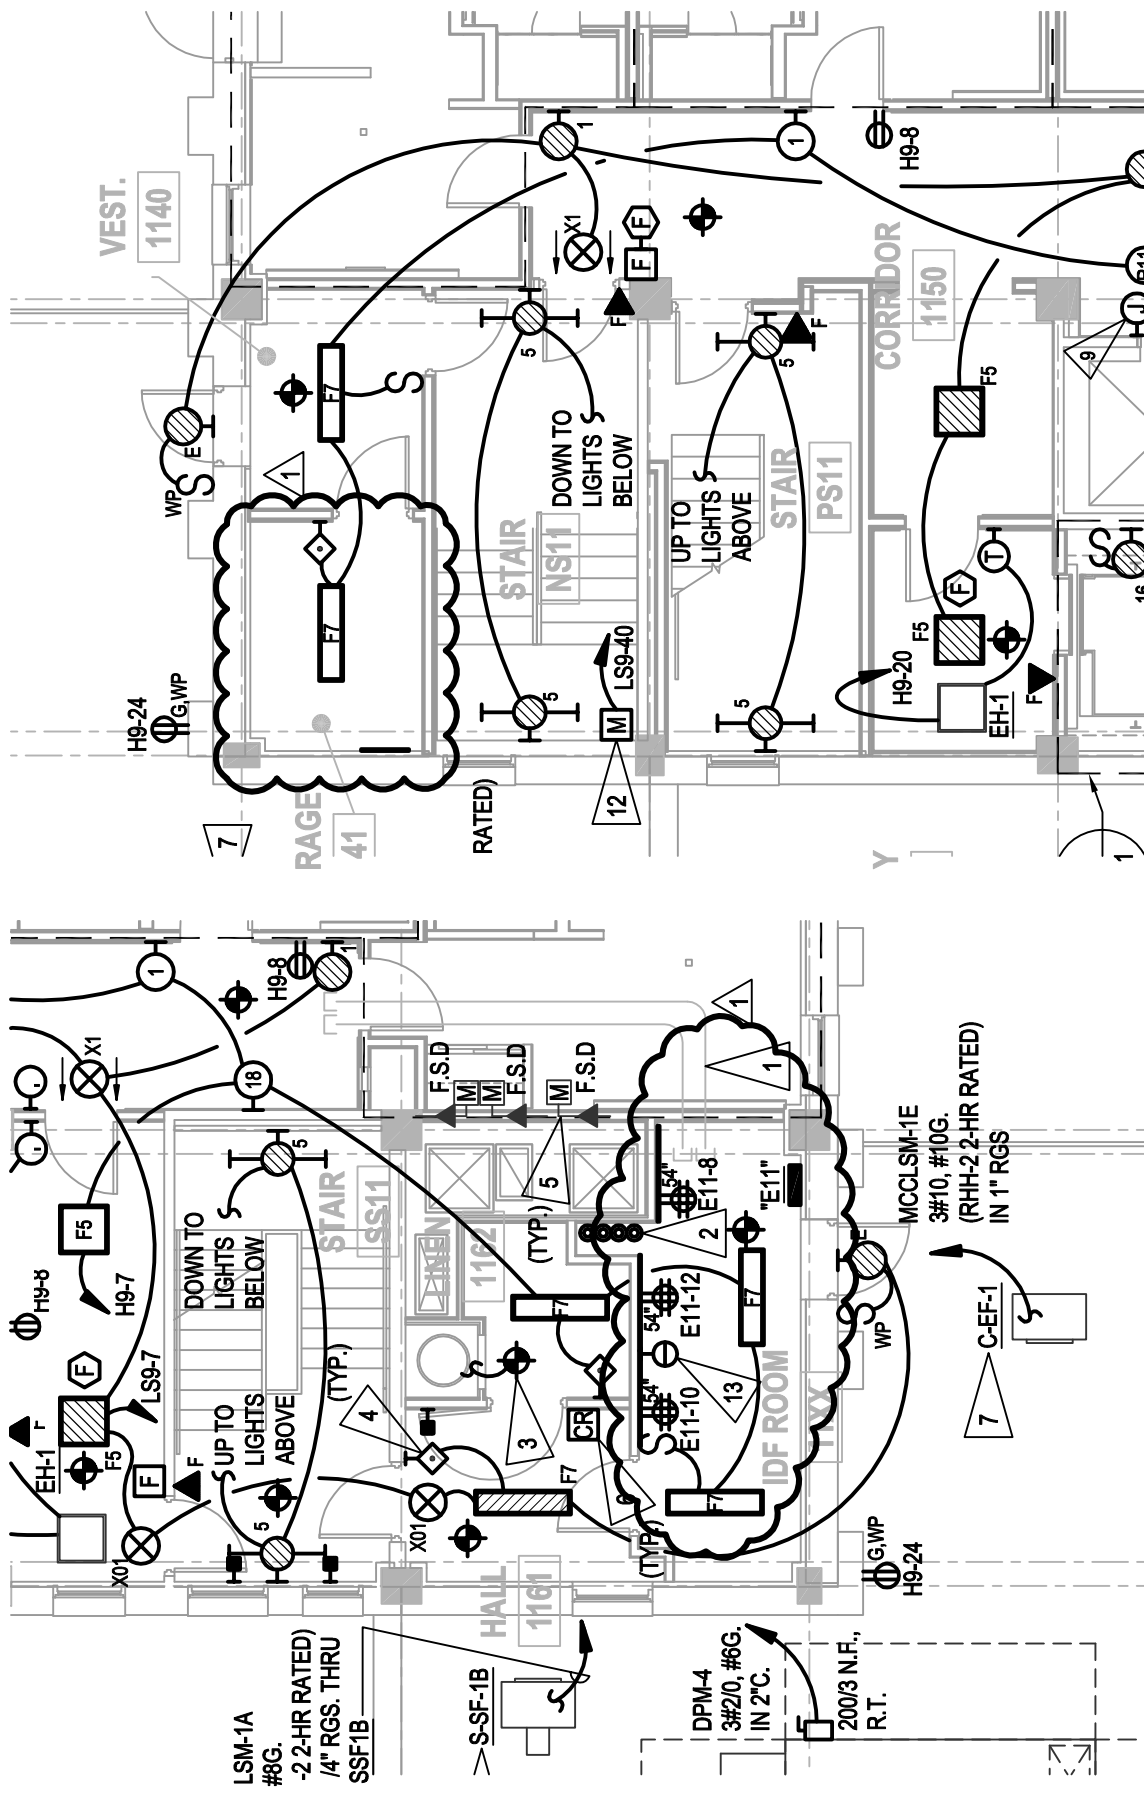

**DOWNTOWN OMAHA RESIDENCE INN
BY MARRIOTT
106 SOUTH 15TH STREET OMAHA, NE**

morrissey engineering inc
 mechanical | electrical | technology | commissioning
 4940 North 118th Street
 Omaha, NE 68164
 P: 402.491.4144
 www.morrisseyengineering.com

project no.:	11290	drawing referenced:	E1.05
date:	6/22/2012	addendum no.:	1

E1.05a

1 sketch

TELECOMMUNICATIONS - LOW VOLTAGE SPECIFICATIONS																																																																																																																											
<p>A. PROJECT DESCRIPTION: 1. THIS PROJECTS INVOLVES THE RENOVATION OF PROPERTY SPACE AT 106 S. 15TH ST. OMAHA, NEBRASKA INTO THE NEW OFB RESIDENCE INN HOTEL. THE SCOPE OF THESE DOCUMENTS ARE LIMITED TO THE LOW VOLTAGE TELECOMMUNICATIONS SYSTEM FOR VOICE/DATA/VHSIA/AUDIO/CCCTV/INTERCOM AND THE POWER AND GROUNDING REQUIREMENTS ASSOCIATED WITH THAT SYSTEM.</p> <p>B. PROJECT CLOSE-OUT REQUIREMENTS: 1. THE COMMUNICATIONS CONTRACTOR (C.C.) SHALL BE REQUIRED TO COMPLETELY TEST AND CERTIFY ALL CABLE AND FIBER TERMINATIONS AND MEET THE SPECIFIED SYSTEM PERFORMANCE SPECIFICATIONS FOR ALL CABLES INSTALLED ON THIS PROJECT. 2. UTP COPPER CAT 6 HORIZONTAL AND VERTICAL CABLE TESTING; CERTIFICATION OF THE UTP WIRING SYSTEM SHALL BE PERFORMED AND DOCUMENTED BY THE C.C. THE TESTS MUST BE THE MOST CURRENT STANDARD TIA/EIA 568-B, CATEGORY CAT.6 PERMANENT LINK TEST FOR 100 OHM UTP 4-PAIR CABLE. TEST PARAMETERS SHALL INCLUDE PROPAGATION DELAY, DELTA BY SKEW, WIRE MATH LENGTH, ATTENUATION, ICR, NEAR-END-CROSS-TALK (NEXT), FAR-END-CROSS-TALK (FEXT), INSERTION LOSS (IL), RETURN LOSS (RL), EQUAL LEVEL FAR END CROSS-TALK (ELFEXT). 3. TEST RESULT PRINTOUT; EACH CABLE TESTED SHALL BE DISPLAYED ON A SINGLE SHEET OF THE REPORT. THE FIRST PAGE OF THE REPORT SHALL BE A REPORT SUMMARY OF ALL TEST RESULTS INDICATING THE FOLLOWING: CABLE ID, TIME/DATE OF TEST, LONGEST PAIR LENGTH AND PASS/FAIL. 4. APPROVED UTP TEST EQUIPMENT; LEVEL 11+E TEST EQUIPMENT IS REQUIRED. FLUKE DTX-1200/1800 SERIES COPPER CATEGORY 6 AND FIBER OPTIC SCANNER. THE CONTRACTOR IS REQUIRED TO GET WRITTEN AUTHORIZATION TO USE TEST EQUIPMENT THAT IS NOT LISTED AS APPROVED. TEST RESULT SUBMITTALS: THE C.C. SHALL SUBMIT TO OWNER ONE (1) HARD COPY BOX OF ALL UTP CABLE AND FIBER OPTIC TEST RESULTS/SUMMARY REPORT AND CD-ROM/LASH DRIVE OF TEST DATA PDF FORMAT. 5. THE C.C. SHALL BE RESPONSIBLE FOR SUBMITTING A COMPLETE SET OF AS-BUILT DOCUMENTS AT THE COMPLETION OF THE PROJECT. DRAWINGS SHALL BE SUBMITTED IN HARD COPY AND ELECTRONIC FORMATS. SUBMITTAL SHALL INCLUDE ALL DRAWINGS REVISED AS PER ACTUAL INSTALLATION FOR THE RISER AND STATION IDENTIFICATION PLANS. THE ELECTRONIC FORMAT SHALL BE SUBMITTED VIA CD-ROM/LASH DRIVE OR EMAIL IN PDF/AUTOCAD VER. 9 FLOORS BASEMENT AND 1ST FLOORS. ALL TERMINATIONS PERFORMED UNDER THIS PROJECT SHALL BE CLEARLY IDENTIFIED AT BOTH ENDS WITH PERMANENT IDENTIFICATION INK OR LABEL. TYPE WRITTEN SELF-ADHERING LABEL WORK AREA FACE PLATE TAGS MUST MATCH THE PATCH PANEL TAGS IDENTICALLY. INCLUDE INDIVIDUAL PORT LABELS AT ALL FACE PLATES AT EACH INDIVIDUAL PORT EXCEPT WITHIN GUEST ROOMS WHERE NO VISUAL LABELING IS TO BE DONE. ALL VENDORS SHALL HAVE PERMANENT IDENTIFICATION INK OR LABEL LOCATED ON THE CABLE JACKET WITHIN 6" OF EACH TERMINATION.</p> <p>C. GENERAL REQUIREMENTS: 1. ALL PRODUCTS AND MATERIALS SHALL BE NEW UNLESS NOTED OTHERWISE, AND SHALL BE CLEAN AND FREE OF DEFECTS, DAMAGE AND CORROSION. DISTRIBUTION FRAME LADDER RACKS, THEIR SUPPORTS, SPLICES AND FASTENERS SHALL BE SUPPLIED BY G.C. FROM RECYCLED EQUIPMENT FROM PREVIOUS BUILDING TENANT CURRENTLY HELD IN STORAGE. ADDITIONAL LADDER RACK MATERIAL NECESSARY SHALL BE SUPPLIED BY C.C. 2. ALL PRODUCTS AND MATERIALS SHALL BE LISTED AND LABELED BY UL, C.S.A., E.T.L., OR ANOTHER CERTIFIED TESTING LABORATORY. 3. THE E.C. IS RESPONSIBLE FOR OBTAINING, AND PAYMENT OF ALL PERMITS, INSPECTIONS, TESTS, ETC., NECESSARY FOR THE PROPER EXECUTION AND COMPLETION OF ALL ELECTRICAL WORK REQUIRED AND OBTAINING CERTIFICATE OF OCCUPANCY. 4. THE C.C. SHALL PROVIDE A WRITTEN, ONE YEAR GUARANTEE OF ALL WORK AND MATERIAL UPON PROJECT COMPLETION AND ACCEPTANCE. THE C.C. SHALL BE REQUIRED TO SUBMIT VENDOR DOCUMENTATION REQUIRED FOR THE 15 YEAR PANDUIT/GENERAL OR EQUIVALENT CERTIFICATION. 5. THIS CONTRACTOR SHALL BE RESPONSIBLE FOR COMPLYING WITH ALL BUILDING STANDARDS, RULES AND REGULATIONS. 6. REFER TO ARCHITECTURAL PLANS AND DETAILS FOR: A. ROOM NAMES AND NUMBERS. B. MOUNTING HEIGHTS AND ORIENTATION OF ALL LOW VOLTAGE / ELECTRICAL DEVICES. C. DIMENSIONS AND FINAL LOCATIONS OF FURNITURE AS RELATED TO LOW VOLTAGE / ELECTRICAL DEVICES. D. DEVICE BACK-BOX AND FACEPLATE COLORS. 7. ALL WORK SHALL BE PERFORMED IN A NEAT AND WORKMAN LIKE MANNER. ALL CONDUIT, JUNCTION BOXES, HANGERS, SUPPORT CHANNELS, ETC. SHALL BE INSTALLED STRAIGHT AND/OR PERPENDICULAR TO BUILDING CONSTRUCTION. SPECIAL CARE SHALL BE TAKEN TO ALIGN HANGING DEVICES AT EXPOSED "OPEN" CEILINGS. 8. SHOP DRAWINGS SUBMITTAL THE C.C. SHALL PROVIDE A COMPLETE OUT SHEET SUBMITTAL PACKAGE OF ALL MATERIALS AND COMPONENTS OF THIS PROJECT. INCLUDE SETS FOR SUBMITTALS FOR DISTRIBUTION AS REQUIRED.</p> <p>D. CONTRACTOR QUALIFICATIONS: THE C.C. MUST BE A CERTIFIED PANDUIT/GENERAL OR EQUIVALENT INSTALLER AND THE CONTRACTOR SHALL ALSO EMPLOY/RETAIN AT LEAST ONE BICSI CERTIFIED RCDD (REGISTERED COMMUNICATION DISTRIBUTION DESIGNER).</p> <p>E. CABLE MANAGEMENT: THE C.C. SHALL BE RESPONSIBLE FOR PROPERLY SUPPORTING AND MANAGING ALL EXPOSED AND ACCESSIBLE LOW VOLTAGE CABLING.</p> <p>F. CABLE SUPPORT AND BUNDLES: 1. HOTEL GUEST, PUBLIC AND ADMIN-BACK OF HOUSE FLOORS: THE C.C. SHALL BE RESPONSIBLE FOR PROPERLY SUPPORTING AND MANAGING ALL EXPOSED AND CONCEALED LOW VOLTAGE CABLING. THIS PROJECT DESIGN SHALL MEET THE FOLLOWING CRITERIA: THE HORIZONTAL CABLING SHALL BE ROUTED VIA OVERHEAD PATHS IN OPEN NON-PLENUM SPACE EXCEPT WHERE CONCEALED, WHERE THE E.C. WILL PROVIDE A CONDUIT RACEWAY SYSTEM. THE ACCESSIBLE OVERHEAD CABLING SHALL BE SUPPORTED VIA A CABLE RUNWAY/J-HOOK SYSTEM THAT IS SUPPORTED AT A MAXIMUM SPACING OF EVERY 5'-0". ALL EXPOSED CABLES SHALL BE NEATLY BUNDLED WITH VELCRO CABLE STRAPS AND/OR PLASTIC TY-WRAPPS. CABLE BUNDLES SHALL BE BUNDLED AND SECURED TO THE HORIZONTAL AND VERTICAL CABLE MANAGEMENT SYSTEMS. USE OF PLASTIC TY-WRAPPS SHALL ONLY BE PERMITTED IF THE TY-WRAP IS INSTALLED IN SUCH A WAY AS TO BE EASILY TWISTED AROUND BUNDLE BY HAND. OVER TIGHTENING OF THE TY-WRAPPS SHALL NOT BE PERMITTED. CABLE BUNDLES IN THE DEMARC, MDF AND (DFS)(2) SHALL BE SUPPORTED BY VELCRO STRAPS ONLY. 2. CABLE RUNWAY: THE C.C. SHALL FURNISH AND INSTALL A COMPLETE CABLE RUNWAY SYSTEM IN THE DEMARC TELCO NET-POP, MDF, (DFS)(2), MATV H.E. ROOMS.</p> <p>G. ACCESSIBLE CABLE PLANT: THE ELECTRICAL CONTRACTOR (E.C.) SHALL COORDINATE LOCATION AND NUMBER OF LOW VOLTAGE TEL/DATA/CAT-6/HSA-AUDIO-CCTV OUTLETS WITH ARCHITECTURAL AND SUPPLEMENTAL DRAWINGS AND SHALL PROVIDE THE SAME. THE E.C. SHALL PROVIDE APPROPRIATE JUNCTION BOXES, CONDUITS AND SLEEVES TO PROVIDE A 100% ACCESSIBLE LOW VOLTAGE CABLE PLANT. THE E.C. SHALL REFER TO MARRIOTT PROTOTYPES, ARCHITECTURAL AND SUPPLEMENTAL DRAWINGS FOR ALL GUEST ROOM, PUBLIC, BOH AND ADMIN LOCATIONS AND QUANTITIES.</p> <p>H. CONDUIT STUB-UP: ALL CONDUIT PATHWAYS, CORES, PENETRATIONS, EMENT CONDUITS, SLEEVES, BUSHINGS, JUNCTION BOXES INCLUDING IN-FLOOR AND IN-CEILING, PULL-BOXES, BACK-BOXES, DRYWALL RACEWAYS AND FIRE-STOPPING AT ALL PENETRATIONS AND WITHIN JUNCTION BOXES SHALL BE FURNISHED AND INSTALLED BY THE E.C. MINIMUM CONDUIT SIZE SHALL BE 3/4" EXCEPT WHERE NOTED. SINGLE GANG PLASTER RING TO BE USED ON ALL LOCATIONS EXCEPT WHERE NOTED. CONFIRM JUNCTION BOX MOUNTING ORIENTATION WITH ARCHITECT.</p> <p>I. HORIZONTAL CONDUIT PATHWAY LENGTH LIMITS: CAT 6 VOICE/DATA/HSA CONDUIT PATHWAY MAXIMUM LENGTH REQUIREMENTS: IT IS CRITICAL THAT THE GUEST ROOM AND BACKBONE VOICE/DATA HORIZONTAL CABLING LENGTHS DO NOT EXCEED 295-FEET FROM OUTLET TO PATCH PANEL. THE E.C. SHALL COORDINATE WITH THE C.C. TO VERIFY THAT THE CONDUIT RACEWAY IS RUN IN THE MOST DIRECT ROUTE FROM THE OUTLET TO THE TERMINATION DISTRIBUTION FRAMES, AND MEETS THE FOLLOWING PARAMETERS: 1. THE CONDUIT PATHWAY SYSTEM LENGTH SHALL NOT EXCEED 275- FEET FOR ADMIN AND BOH DATA-VOICE DEVICES AND WORKSTATIONS. 2. THERE ARE NO MORE THAN TWO 90-DEGREE BENDS IN THE CONTINUOUS CONDUIT RACEWAY BETWEEN PULL POINTS. 3. THAT THE AREA FILL PERCENTAGE OF THE COMMUNICATION CABLES IN THE CONDUIT DOES NOT EXCEED 40%. 4. ALL OPEN EMT CONDUIT ENDS ARE PROVIDED WITH A PLASTIC BUSHING OR PLASTIC SLEEVE.</p> <p>IF A COMPLETED CONDUIT SYSTEM RESULTS IN CAT 6 COMMUNICATION CABLE MEASUREMENT EXCEEDING 295- FEET, THE FOLLOWING CORRECTIVE MEASURES WILL BE THE RESPONSIBILITY OF THE ELECTRICAL AND COMMUNICATIONS CONTRACTORS. THE E.C. WILL BE LIABLE FOR ALL ADDED COSTS (INCLUDING PREMIUM TIME ASSOCIATED WITH RE-WORKING OF A CONDUIT SYSTEM) TO MAKE THE COMMUNICATION CABLING SYSTEM LENGTH COMPLIANT. THE C.C. SHALL BE LIABLE FOR ALL ADDED COSTS (INCLUDING PREMIUM TIME) ASSOCIATED WITH RE-WORKING OF ALL EFFECTED CABLING, RE-TERMINATION AND RE-TESTING TO MAKE THE COMMUNICATION CABLING SYSTEM TIA-568 COMPLIANT. IT IS THE C.C. AND E.C.'S RESPONSIBILITIES TO IDENTIFY ANY LOCATIONS WHERE IT IS NOT PHYSICALLY POSSIBLE TO MEET THESE REQUIREMENTS PRIOR TO INSTALLATION.</p>	<p>J. CONNECTIVITY REQUIREMENTS: DATA-VOICE-HSA OUTLETS: CAT 6 DATA-VOICE-HSA CABLES ARE TO BE INDIVIDUAL AND HOME RUN TO ASSOCIATED DISTRIBUTION FRAMES. SPLIT PAIR AND/OR SPLICING IS NOT PERMITTED.. DATA OUTLETS (RJ-45 CAT 6 KEYS) ARE BLUE OR ORANGE. FINAL TBD. VOICE OUTLETS (RJ-45 CAT-6 KEYS) ARE WHITE OR VIOLET. NO MAT ELECTRICAL COMPONENTS. FINAL TBD. OUTLETS SHALL BE PROVIDED WITH 4-PAIR, CATEGORY-6 UTP CABLES. CABLE IN-PIN-OUT: ALL DATA/VOICE/HSA STATIONS TO BE TERMINATED USING 568B PIN-OUT CONFIGURATION. DATA/HSA 4-PAIR CAT 6 UTP TIA-568B JACKET COLOR: BLUE VOICE- 4-PAIR CAT 6 UTP TIA-568B JACKET COLOR: WHITE MATV-CATV RG-6 COAXIAL CABLES TO BE INSTALLED BY C.C. AND TERMINATED AT THE DEVICE END ONLY. FINAL TERMINATIONS AT HEAD-END AND INTERMEDIATE DISTRIBUTION FRAMES TO BE PERFORMED BY MATV-CATV CONTRACTOR. MATV-CATV RG-11 AND/OR HARDLINE, COAXIAL CABLES ARE TO BE INSTALLED BY C.C. AND TERMINATED BY MATV-CATV PROVIDER. THIS INCLUDES CABLES TO ROOF-TOP SATELLITE LOCATIONS. HSA IN-CEILING WIRELESS ACCESS-POINT CABLES TO BE TERMINATED RJ-45 CAT-6 KEYSTONE (BLUE OR ORANGE-TBD), HOUSED IN SINGLE PORT SURFACE MOUNT ENCLOSURE (BISCUIT), COLED WITH APPROXIMATELY 20" ADDITIONAL CABLE AND LEFT IN ACCESSIBLE CEILING AREA. JACKET COLOR BLUE. INTERCOM CABLES WILL BE CONNECTED TO MASTER AND REMOTE APHONE STATIONS SUPPLIED BY C.C.</p> <p>K. STATION IDENTIFICATION: ADMIN, PUBLIC AND BOH FACEPLATES, UNLESS REQUESTED OTHERWISE: THE OUTLET IDENTIFICATION SCHEME WILL INCLUDE: "MDF-IDF DATA OR VOICE STATION NUMBER"; EXAMPLE: M-D01 AND/OR M-V-01. GUEST ROOM CABLES TO BE IDENTIFIED BY ROOM NUMBER AT DISTRIBUTION FRAME SIDE ONLY AT PATCH PANEL AND/OR 110 BLOCKS. FOR DATA, EXAMPLE DATA GUEST ROOM 202 # 0202. GUEST ROOM VOICE IDENTIFIED BY ROOM NUMBER AND LOCATION SUB-SET; DESK-A, BED-B, BED-C; EXAMPLE VOICE CABLE AT BED 1 AT ROOM 202 # V0202 HSA CABLES TO BE LABELED WITH ROOM NUMBER OF CLOSEST PROXIMITY ROOM ON GUESTROOM FLOORS 2-12 AND BY ROOM NUMBERS OF ON FLOORS BASEMENT AND 1ST FLOORS. ALL TERMINATIONS PERFORMED UNDER THIS PROJECT SHALL BE CLEARLY IDENTIFIED AT BOTH ENDS WITH PERMANENT IDENTIFICATION INK OR LABEL. TYPE WRITTEN SELF-ADHERING LABEL WORK AREA FACE PLATE TAGS MUST MATCH THE PATCH PANEL TAGS IDENTICALLY. INCLUDE INDIVIDUAL PORT LABELS AT ALL FACE PLATES AT EACH INDIVIDUAL PORT EXCEPT WITHIN GUEST ROOMS WHERE NO VISUAL LABELING IS TO BE DONE. ALL VENDORS SHALL HAVE PERMANENT IDENTIFICATION INK OR LABEL LOCATED ON THE CABLE JACKET WITHIN 6" OF EACH TERMINATION.</p> <p>L. LOW VOLTAGE HORIZONTAL TRANSMISSION MEDIA: PER ARCHITECT SUBMISSION, NO ABOVE CEILING AIR-PLENUM SPACE IS EVIDENT IN THIS PROJECT. AS SUCH, RISER RATED CMR CABLE WILL BE USED. DATA/HSA: CATEGORY-6 UNSHIELDED TWISTED PAIRS, 4-PAIR, 23 AWG - CMR RISER-BLUE. VOICE: CATEGORY-4 UNSHIELDED TWISTED PAIRS, 4-PAIR, 23 AWG - CMR RISER-WHITE. MATV-CATV: RG 11 DUAL OR QUAD SHIELD C/SC CMR RISER COAXIAL CABLE-WHITE. FINAL SHIELD REQUIREMENTS TBD BY MATV PROVIDER. MATV-CATV: RG 11 DUAL OR QUAD SHIELD C/SC CMR RISER COAXIAL CABLE-BLACK OR 5 HARDLINE COAXIAL CABLE-BLACK. FINAL SHIELD AND TYPE REQUIREMENTS TBD BY MATV-CATV PROVIDER. CCTV SHALL BE CATEGORY 6 UTP OR SIAMSE CMR RATED. FINAL TBD. COLOR NOT SIGNIFICANT. AUDIO CABLES SHALL BE 182 STRANDED CMR, COLOR NOT SIGNIFICANT. INTERCOM CABLES SHALL BE 20X CMR AS REQUIRED BY LOCATION. COLOR NOT SIGNIFICANT. ALL AUDIO/PA FEEDS TERMINATE IN AUDIO RACK, 1ST FLOOR MDF. ALL DIGITAL VIDEO SIGNAGE FEEDS TERMINATE IN 1ST FLOOR MDF. ALL CCTV VIDEO SURV. CAMERAS MOUNTING HEIGHT T.B.D. CCTV FEEDS TERMINATE IN VIDEO CABINET AT 1ST FLOOR REGISTRATION AREA. ALL INTERCOM CABLE FEEDS TERMINATE IN 1ST FLOOR MDF.</p> <p>M. VERTICAL BACKBONE TRANSMISSION MEDIA: DEMARC-MDF, MDF-(DFS)(2) FIBER: 6-STRAND MULTI MODE 90 MICRON 10G ARMORED RISER RATED BACKBONE CABLE TO BULK-HEAD/FIBER PATCH PANEL TERMINATED I.C. C.C. TO SUPPLY 1-2 METER, 50 MICRON, LC-LO DUPLEX FIBER PATCH CORDS AS REQUIRED. VOICE: COPPER 25.50, 100 PAIR RISER RATED CATEGORY 3 BACKBONE CABLE AS REQUIRED. DATA COPPER UTP CAT. 6 CMR. T1: COPPER UTP CAT.6 CMR OR 24 PAIR T1 RATED BACKBONE CABLE. MATV-CATV: RG 11 DUAL OR QUAD SHIELD C/SC CMR RISER COAXIAL CABLE-BLACK OR 5 HARDLINE COAXIAL CABLE-BLACK. FINAL SHIELD AND TYPE REQUIREMENTS TBD BY MATV-CATV PROVIDER.</p> <p>N. DATA ACTIVATION JUMPERS AND PATCH CORDS: 1. DATA: THE OWNER OR THEIR ASSIGNS SHALL FURNISH & INSTALL ALL DATA ACTIVATION JUMPERS OR CABLES BETWEEN THE STATION PATCH PANEL AND THE LAN SWITCHES AND WIRELESS ACCESS POINTS. 2. FIBER CROSS CONNECTIONS: THE C.C. WILL PROVIDE FIBER PATCH CABLES AS REQUIRED UNLESS OTHERWISE NOTIFIED BY OWNER.</p> <p>O. VOICE ACTIVATION JUMPERS: 1. VOICE CROSS CONNECTIONS AT THE MDF/IDF ROOMS: C.C. SHALL CROSS CONNECT ALL PHONE STATIONS TO THE MDF AND (DFS) 110 BLOCKS TO COUPLER ALL TELEPHONE EXTENSIONS TO PBX LOCATED IN MDF. C.C. WILL CROSS CONNECT POTS LINES TO ELEVATOR AND FIRE CONTROL ROOMS AS REQUIRED. THE PBX VENDOR SHALL CROSS CONNECT ALL PHONE STATIONS TO THE 110 BLOCKS PBX LINK THE PHONE PATCH PANELS TO THE PBX WALL FIELD. 2. THE PBX CONTRACTOR SHALL PROVIDE ALL PBX-TELEPHONE PATCH CABLES AT THE PBX SIDE AND THE DEVICE END.</p> <p>P. SUMMARY OF OWNER PROVIDED DATA-TELECOMMUNICATION OR LOW VOLTAGE ITEMS: A. ALL RACK MOUNTED ELECTRONICS, ETHERNET LAN SWITCHES, ROUTERS, DATA PATCH CABLES, ETC. B. PBX EQUIPMENT, VOICE MAIL, SERVER AND VOICE MAIL TERMINAL. C. PROPERTY MANAGEMENT SYSTEM (PMS). D. PHONE HANDSETS SHALL BE FURNISHED AND INSTALLED BY PHONE SWITCH VENDOR OR OTHERS. E. ELECTRONIC KEY SYSTEM, DOOR CARD SWIPES. F. CCTV EQUIPMENT. G. HSA WIRELESS ACCESS POINTS. H. POS EQUIPMENT.</p> <p>Q. VOICE LINE CORDS AT THE WORKSTATIONS: FURNISHED AND INSTALLED BY OTHERS.</p>																																																																																																																										
<p>1. COMMUNICATION CONTRACTOR (G.C.): A. THE STRUCTURED LOW VOLTAGE CABLE PLANT SYSTEM VOICE/DATA/VHSIA/AUDIO/CCTV/INTERCOM). B. LOW VOLTAGE HORIZONTAL CABLE PLANT. C. MDF/IDF EQUIPMENT ROOM RACKING AND ASSOCIATED CABLE MANAGEMENT COMPONENTS. D. ALL VOICE AND DATA COMMUNICATIONS SYSTEMS TERMINATIONS EXCEPT AS NOTED IN TELECOMMUNICATION SPECIFICATIONS, TESTING, LABELING AND DATA CABLING SYSTEM CERTIFICATIONS. E. FIRESTOPPING OF THE INTERIOR OF THE RISER SLEEVES THROUGH FIRE RATED WALL AND FLOORS. F. ALL STATION AND JACK PANEL STATION ID LABELING AS SPECIFIED.</p> <p>2. ELECTRICAL CONTRACTOR (E.C.): A. THE E.C. SHALL FURNISH AND INSTALL ALL BRANCH POWER IN ACCORDANCE WITH THESE DOCUMENTS AND THE MEP CONSULTANT'S REQUIREMENTS. B. THE E.C. SHALL FURNISH AND INSTALL ALL LOW VOLTAGE CONDUIT PER THE LAYOUT ON THESE DRAWINGS. C. THE TELECOMMUNICATIONS GROUNDING RISER, TMSB AND TGB GROUND BUSSES AND BRANCH TELECOMMUNICATION GROUNDING WITHIN THE DISTRIBUTION FRAMES, HEAD-END AND DEMARC TELCO NETPOP. D. THE E.C. SHALL INCLUDE THE INSTALLATION OF PLASTIC BUSHING AT THE ENDS OF ALL CONDUIT ENDS THAT ARE USED FOR VOICE AND DATA SYSTEMS. F. THE E.C. SHALL FURNISH AND INSTALL 200 POUND TENSILE, RATED NYLON PULL STRING IN ALL VOICE/DATA AND AV CONDUITS SYSTEMS IDENTIFIED ON THESE DRAWINGS. G. FIRESTOP OF CONDUIT PENETRATIONS THROUGH FIRE RATED WALL AND FLOORS AND IN JUNCTION BOX FIRSTSTOP CAUSED BY THE LOW VOLTAGE RACEWAYS FOR THIS PROJECT. H. THE E.C. SHALL INCLUDE THE LABOR, MATERIAL AND TOOLS NEEDS TO X-RAY OR SCAN ALL PROPOSED CORE AND SAW-CUTTING LOCATIONS IF NECESSARY. I. PROVIDE AND COORDINATE MECHANICAL CONTRACTOR TO INSTALL ENVIRONMENTAL HVAC EQUIPMENT IN DISTRIBUTION FRAMES AS REQUIRED AND DESCRIBED IN D-V DETAILS.</p>	<p>LOW VOLTAGE DRAWING LIST</p> <table border="1"> <tr><td>D-V 1.0</td><td>COVER SHEET</td></tr> <tr><td>D-V 2.0</td><td>BASEMENT LOW VOLTAGE PLAN</td></tr> <tr><td>D-V 3.0</td><td>FIRST FLOOR LOW VOLTAGE PLAN</td></tr> <tr><td>D-V 4.0</td><td>DISTRIBUTION FRAME DETAIL</td></tr> <tr><td>D-V 5.0</td><td>RISER-CONDUIT SCHEDULE</td></tr> <tr><td>D-V 6.0</td><td>TYPICAL GUEST FLOOR PLAN (FLOORS 2-10)</td></tr> <tr><td>D-V 7.0</td><td>ELEVENTH FLOOR LOW VOLTAGE PLAN</td></tr> <tr><td>D-V 8.0</td><td>TWELFTH FLOOR LOW VOLTAGE PLAN</td></tr> </table>	D-V 1.0	COVER SHEET	D-V 2.0	BASEMENT LOW VOLTAGE PLAN	D-V 3.0	FIRST FLOOR LOW VOLTAGE PLAN	D-V 4.0	DISTRIBUTION FRAME DETAIL	D-V 5.0	RISER-CONDUIT SCHEDULE	D-V 6.0	TYPICAL GUEST FLOOR PLAN (FLOORS 2-10)	D-V 7.0	ELEVENTH FLOOR LOW VOLTAGE PLAN	D-V 8.0	TWELFTH FLOOR LOW VOLTAGE PLAN	<p>ABBREVIATIONS</p> <table border="1"> <tr><td>AFF</td><td>ABOVE FINISHED FLOOR</td></tr> <tr><td>AFB</td><td>ABOVE FINISHED CEILING</td></tr> <tr><td>BOH</td><td>BACK OF HOUSE</td></tr> <tr><td>C/B</td><td>CIRCUIT BREAKER</td></tr> <tr><td>CATV</td><td>COMMUNITY-CABLE ACCESS TV</td></tr> <tr><td>CCTV</td><td>CLOSED CIRCUIT TV</td></tr> <tr><td>C.C.</td><td>COMMUNICATIONS CONTRACTOR</td></tr> <tr><td>DEMARC</td><td>TELECO POINT OF DEMARCATION</td></tr> <tr><td>E.C.</td><td>ELECTRICAL CONTRACTOR</td></tr> <tr><td>EMT</td><td>ELECTRICAL METALLIC TUBING</td></tr> <tr><td>ENT</td><td>ELECTRICAL NON-METALLIC TUBING</td></tr> <tr><td>F&I</td><td>FURNISH AND INSTALL</td></tr> <tr><td>G.C.</td><td>GENERAL CONTRACTOR</td></tr> <tr><td>HSA</td><td>HIGH SPEED INTERNET ACCESS</td></tr> <tr><td>IDF</td><td>INTERMEDIATE DISTRIBUTION FRAME</td></tr> <tr><td>LEC</td><td>LOCAL EXCHANGE CARRIER</td></tr> <tr><td>MATV</td><td>MASTER ANTENNA TV (SATELLITE)</td></tr> <tr><td>MC</td><td>MECHANICAL CONTRACTOR</td></tr> <tr><td>MDF</td><td>MAIN DISTRIBUTION FRAME</td></tr> <tr><td>NETPOP</td><td>NETWORK POINT OF PRESENCE</td></tr> <tr><td>PMS</td><td>PROPERTY MANAGEMENT SYSTEM</td></tr> <tr><td>POWER</td><td>POWER OVER ETHERNET</td></tr> <tr><td>POS</td><td>POINT OF SALE</td></tr> <tr><td>TBD</td><td>TO BE DETERMINED</td></tr> <tr><td>TGB</td><td>TELECOM GROUNDING BUS</td></tr> <tr><td>TMSB</td><td>TELECOM MAIN GROUNDING BUS</td></tr> <tr><td>UNO</td><td>UNLESS NOTED OTHERWISE</td></tr> <tr><td>VF</td><td>VERIFY IN FIELD</td></tr> <tr><td>WAP</td><td>WIRELESS ACCESS POINT</td></tr> </table>	AFF	ABOVE FINISHED FLOOR	AFB	ABOVE FINISHED CEILING	BOH	BACK OF HOUSE	C/B	CIRCUIT BREAKER	CATV	COMMUNITY-CABLE ACCESS TV	CCTV	CLOSED CIRCUIT TV	C.C.	COMMUNICATIONS CONTRACTOR	DEMARC	TELECO POINT OF DEMARCATION	E.C.	ELECTRICAL CONTRACTOR	EMT	ELECTRICAL METALLIC TUBING	ENT	ELECTRICAL NON-METALLIC TUBING	F&I	FURNISH AND INSTALL	G.C.	GENERAL CONTRACTOR	HSA	HIGH SPEED INTERNET ACCESS	IDF	INTERMEDIATE DISTRIBUTION FRAME	LEC	LOCAL EXCHANGE CARRIER	MATV	MASTER ANTENNA TV (SATELLITE)	MC	MECHANICAL CONTRACTOR	MDF	MAIN DISTRIBUTION FRAME	NETPOP	NETWORK POINT OF PRESENCE	PMS	PROPERTY MANAGEMENT SYSTEM	POWER	POWER OVER ETHERNET	POS	POINT OF SALE	TBD	TO BE DETERMINED	TGB	TELECOM GROUNDING BUS	TMSB	TELECOM MAIN GROUNDING BUS	UNO	UNLESS NOTED OTHERWISE	VF	VERIFY IN FIELD	WAP	WIRELESS ACCESS POINT	<p>LOW VOLTAGE LEGEND</p> <table border="1"> <tr><td>□</td><td>TV - 1 PORT - WALL MOUNTED SINGLE GANG, BACK-BOX AND 3/4" CONDUIT STUB BY E.C. HEIGHT AND ORIENTATION TBD.</td></tr> <tr><td>▼</td><td>VOICE - PHONE 1 PORT - WALL MOUNTED, SINGLE GANG, BACK-BOX AND 3/4" CONDUIT STUB BY E.C. HEIGHT AND ORIENTATION TBD.</td></tr> <tr><td>▽</td><td>DATA - 1 PORT - WALL MOUNTED SINGLE GANG, BACK-BOX AND 3/4" CONDUIT STUB BY E.C. HEIGHT AND ORIENTATION TBD.</td></tr> <tr><td>▽</td><td>COMBINATION DATA-PHONE 2 PORT, SINGLE GANG, BACK-BOX AND 3/4" CONDUIT STUB BY E.C. HEIGHT AND ORIENTATION TBD.</td></tr> <tr><td>↘</td><td>DUAL COMBINATION DATA-PHONE 4 PORT, SINGLE GANG, BACK-BOX AND 3/4" CONDUIT STUB BY E.C. HEIGHT AND ORIENTATION TBD.</td></tr> <tr><td>F&I</td><td>FURNISH AND INSTALL</td></tr> <tr><td>G.C.</td><td>GENERAL CONTRACTOR</td></tr> <tr><td>HSA</td><td>HIGH SPEED INTERNET ACCESS</td></tr> <tr><td>IDF</td><td>INTERMEDIATE DISTRIBUTION FRAME</td></tr> <tr><td>LEC</td><td>LOCAL EXCHANGE CARRIER</td></tr> <tr><td>MATV</td><td>MASTER ANTENNA TV (SATELLITE)</td></tr> <tr><td>MC</td><td>MECHANICAL CONTRACTOR</td></tr> <tr><td>MDF</td><td>MAIN DISTRIBUTION FRAME</td></tr> <tr><td>NETPOP</td><td>NETWORK POINT OF PRESENCE</td></tr> <tr><td>PMS</td><td>PROPERTY MANAGEMENT SYSTEM</td></tr> <tr><td>POWER</td><td>POWER OVER ETHERNET</td></tr> <tr><td>POS</td><td>POINT OF SALE</td></tr> <tr><td>TBD</td><td>TO BE DETERMINED</td></tr> <tr><td>TGB</td><td>TELECOM GROUNDING BUS</td></tr> <tr><td>TMSB</td><td>TELECOM MAIN GROUNDING BUS</td></tr> <tr><td>UNO</td><td>UNLESS NOTED OTHERWISE</td></tr> <tr><td>VF</td><td>VERIFY IN FIELD</td></tr> <tr><td>WAP</td><td>WIRELESS ACCESS POINT</td></tr> </table>	□	TV - 1 PORT - WALL MOUNTED SINGLE GANG, BACK-BOX AND 3/4" CONDUIT STUB BY E.C. HEIGHT AND ORIENTATION TBD.	▼	VOICE - PHONE 1 PORT - WALL MOUNTED, SINGLE GANG, BACK-BOX AND 3/4" CONDUIT STUB BY E.C. HEIGHT AND ORIENTATION TBD.	▽	DATA - 1 PORT - WALL MOUNTED SINGLE GANG, BACK-BOX AND 3/4" CONDUIT STUB BY E.C. HEIGHT AND ORIENTATION TBD.	▽	COMBINATION DATA-PHONE 2 PORT, SINGLE GANG, BACK-BOX AND 3/4" CONDUIT STUB BY E.C. HEIGHT AND ORIENTATION TBD.	↘	DUAL COMBINATION DATA-PHONE 4 PORT, SINGLE GANG, BACK-BOX AND 3/4" CONDUIT STUB BY E.C. HEIGHT AND ORIENTATION TBD.	F&I	FURNISH AND INSTALL	G.C.	GENERAL CONTRACTOR	HSA	HIGH SPEED INTERNET ACCESS	IDF	INTERMEDIATE DISTRIBUTION FRAME	LEC	LOCAL EXCHANGE CARRIER	MATV	MASTER ANTENNA TV (SATELLITE)	MC	MECHANICAL CONTRACTOR	MDF	MAIN DISTRIBUTION FRAME	NETPOP	NETWORK POINT OF PRESENCE	PMS	PROPERTY MANAGEMENT SYSTEM	POWER	POWER OVER ETHERNET	POS	POINT OF SALE	TBD	TO BE DETERMINED	TGB	TELECOM GROUNDING BUS	TMSB	TELECOM MAIN GROUNDING BUS	UNO	UNLESS NOTED OTHERWISE	VF	VERIFY IN FIELD	WAP	WIRELESS ACCESS POINT
D-V 1.0	COVER SHEET																																																																																																																										
D-V 2.0	BASEMENT LOW VOLTAGE PLAN																																																																																																																										
D-V 3.0	FIRST FLOOR LOW VOLTAGE PLAN																																																																																																																										
D-V 4.0	DISTRIBUTION FRAME DETAIL																																																																																																																										
D-V 5.0	RISER-CONDUIT SCHEDULE																																																																																																																										
D-V 6.0	TYPICAL GUEST FLOOR PLAN (FLOORS 2-10)																																																																																																																										
D-V 7.0	ELEVENTH FLOOR LOW VOLTAGE PLAN																																																																																																																										
D-V 8.0	TWELFTH FLOOR LOW VOLTAGE PLAN																																																																																																																										
AFF	ABOVE FINISHED FLOOR																																																																																																																										
AFB	ABOVE FINISHED CEILING																																																																																																																										
BOH	BACK OF HOUSE																																																																																																																										
C/B	CIRCUIT BREAKER																																																																																																																										
CATV	COMMUNITY-CABLE ACCESS TV																																																																																																																										
CCTV	CLOSED CIRCUIT TV																																																																																																																										
C.C.	COMMUNICATIONS CONTRACTOR																																																																																																																										
DEMARC	TELECO POINT OF DEMARCATION																																																																																																																										
E.C.	ELECTRICAL CONTRACTOR																																																																																																																										
EMT	ELECTRICAL METALLIC TUBING																																																																																																																										
ENT	ELECTRICAL NON-METALLIC TUBING																																																																																																																										
F&I	FURNISH AND INSTALL																																																																																																																										
G.C.	GENERAL CONTRACTOR																																																																																																																										
HSA	HIGH SPEED INTERNET ACCESS																																																																																																																										
IDF	INTERMEDIATE DISTRIBUTION FRAME																																																																																																																										
LEC	LOCAL EXCHANGE CARRIER																																																																																																																										
MATV	MASTER ANTENNA TV (SATELLITE)																																																																																																																										
MC	MECHANICAL CONTRACTOR																																																																																																																										
MDF	MAIN DISTRIBUTION FRAME																																																																																																																										
NETPOP	NETWORK POINT OF PRESENCE																																																																																																																										
PMS	PROPERTY MANAGEMENT SYSTEM																																																																																																																										
POWER	POWER OVER ETHERNET																																																																																																																										
POS	POINT OF SALE																																																																																																																										
TBD	TO BE DETERMINED																																																																																																																										
TGB	TELECOM GROUNDING BUS																																																																																																																										
TMSB	TELECOM MAIN GROUNDING BUS																																																																																																																										
UNO	UNLESS NOTED OTHERWISE																																																																																																																										
VF	VERIFY IN FIELD																																																																																																																										
WAP	WIRELESS ACCESS POINT																																																																																																																										
□	TV - 1 PORT - WALL MOUNTED SINGLE GANG, BACK-BOX AND 3/4" CONDUIT STUB BY E.C. HEIGHT AND ORIENTATION TBD.																																																																																																																										
▼	VOICE - PHONE 1 PORT - WALL MOUNTED, SINGLE GANG, BACK-BOX AND 3/4" CONDUIT STUB BY E.C. HEIGHT AND ORIENTATION TBD.																																																																																																																										
▽	DATA - 1 PORT - WALL MOUNTED SINGLE GANG, BACK-BOX AND 3/4" CONDUIT STUB BY E.C. HEIGHT AND ORIENTATION TBD.																																																																																																																										
▽	COMBINATION DATA-PHONE 2 PORT, SINGLE GANG, BACK-BOX AND 3/4" CONDUIT STUB BY E.C. HEIGHT AND ORIENTATION TBD.																																																																																																																										
↘	DUAL COMBINATION DATA-PHONE 4 PORT, SINGLE GANG, BACK-BOX AND 3/4" CONDUIT STUB BY E.C. HEIGHT AND ORIENTATION TBD.																																																																																																																										
F&I	FURNISH AND INSTALL																																																																																																																										
G.C.	GENERAL CONTRACTOR																																																																																																																										
HSA	HIGH SPEED INTERNET ACCESS																																																																																																																										
IDF	INTERMEDIATE DISTRIBUTION FRAME																																																																																																																										
LEC	LOCAL EXCHANGE CARRIER																																																																																																																										
MATV	MASTER ANTENNA TV (SATELLITE)																																																																																																																										
MC	MECHANICAL CONTRACTOR																																																																																																																										
MDF	MAIN DISTRIBUTION FRAME																																																																																																																										
NETPOP	NETWORK POINT OF PRESENCE																																																																																																																										
PMS	PROPERTY MANAGEMENT SYSTEM																																																																																																																										
POWER	POWER OVER ETHERNET																																																																																																																										
POS	POINT OF SALE																																																																																																																										
TBD	TO BE DETERMINED																																																																																																																										
TGB	TELECOM GROUNDING BUS																																																																																																																										
TMSB	TELECOM MAIN GROUNDING BUS																																																																																																																										
UNO	UNLESS NOTED OTHERWISE																																																																																																																										
VF	VERIFY IN FIELD																																																																																																																										
WAP	WIRELESS ACCESS POINT																																																																																																																										
<p>LOW VOLTAGE KEYED NOTES</p> <ol style="list-style-type: none"> INTERCOM MASTER INTERCOM REMOTE INTERCOM POWER, 24 VAC IN CEILING POTS LINES-ELEVATOR(S) POTS LINES-FIRE ALARM CARD READER IN-CEILING POWER AND J-BOX FOR PROJECTOR EMPLOYEE TIME CLOCK JACK-PACK MULTI MEDIA CONNECTOR DIGITAL SIGNAGE-MONITOR ATM / KIOSK NETWORK PRINTER LOW VOLTAGE SLEEVES CEILING / FLOOR POS TERMINAL POS PRINTER <ol style="list-style-type: none"> CEILING HATCH, 12" X 12" W/ 1 1/2" FLANGE, USED TO ALLOW ACCESS TO W.A.P. IF APPLICABLE. VIDEO SURVEILLANCE CAMERA, 1 PORT, SINGLE GANG, BACK-BOX AND 3/4" CONDUIT STUB BY E.C. HEIGHT AND ORIENTATION TBD. IN-FLOOR FLUSH POKE THROUGH OR FLUSH FLOOR BOX, COMBINATION POWER RECEPTACLES AND 2 PORT DATA-VOICE, E.C. TO PROVIDE. INTERCOM 1 PORT, SINGLE GANG, BACK-BOX AND 3/4" CONDUIT STUB BY E.C. HEIGHT AND ORIENTATION TBD. CARD READER 1 PORT, SINGLE GANG, BACK-BOX AND 3/4" CONDUIT STUB BY E.C. HEIGHT AND ORIENTATION TBD. CCTV MONITOR, 1 PORT LOW VOLTAGE SINGLE GANG, BACK-BOX AND 3/4" CONDUIT STUB BY E.C. AND DUPLEX POWER RECEPTACLE, HEIGHT AND ORIENTATION TBD. 	<p>By: A-Tech Computer Service, Inc. 296 Williams Pl. East Dunehee, IL 60118 847-428-9199 www.a-techinc.com</p>	<p>OFB RESIDENCE INN OMAHA, NEBRASKA</p>	<p>SHEET AUTHOR A-T</p> <p>CHECKED BY A-T</p> <p>SCALE N/A</p> <p>ISSUE DATE 6-12-12</p> <p>ISSUE TITLE</p> <p>ISSUED FOR CONSTRUCTION</p> <p>REVISION SCHEDULE 6-19-12</p> <p>SHEET NAME COVER SET LOW VOLTAGE</p> <p>SHEET NUMBER D-V 1.0</p>																																																																																																																								

For:
First OFB
10275 W. Higgins Rd.
Ste. 300
Rosemont, IL 60018
847-299-9040

By:
A-Tech Computer Service, Inc.
296 Williams Pl.
East Dunehee, IL 60118
847-428-9199
www.a-techinc.com

OFB RESIDENCE INN
OMAHA, NEBRASKA

SHEET AUTHOR
A-T

CHECKED BY
A-T

SCALE
N/A

ISSUE DATE
6-12-12


ISSUE TITLE

ISSUED FOR CONSTRUCTION


REVISION SCHEDULE
6-19-12

SHEET NAME
COVER SET
LOW VOLTAGE

SHEET NUMBER
D-V 1.0

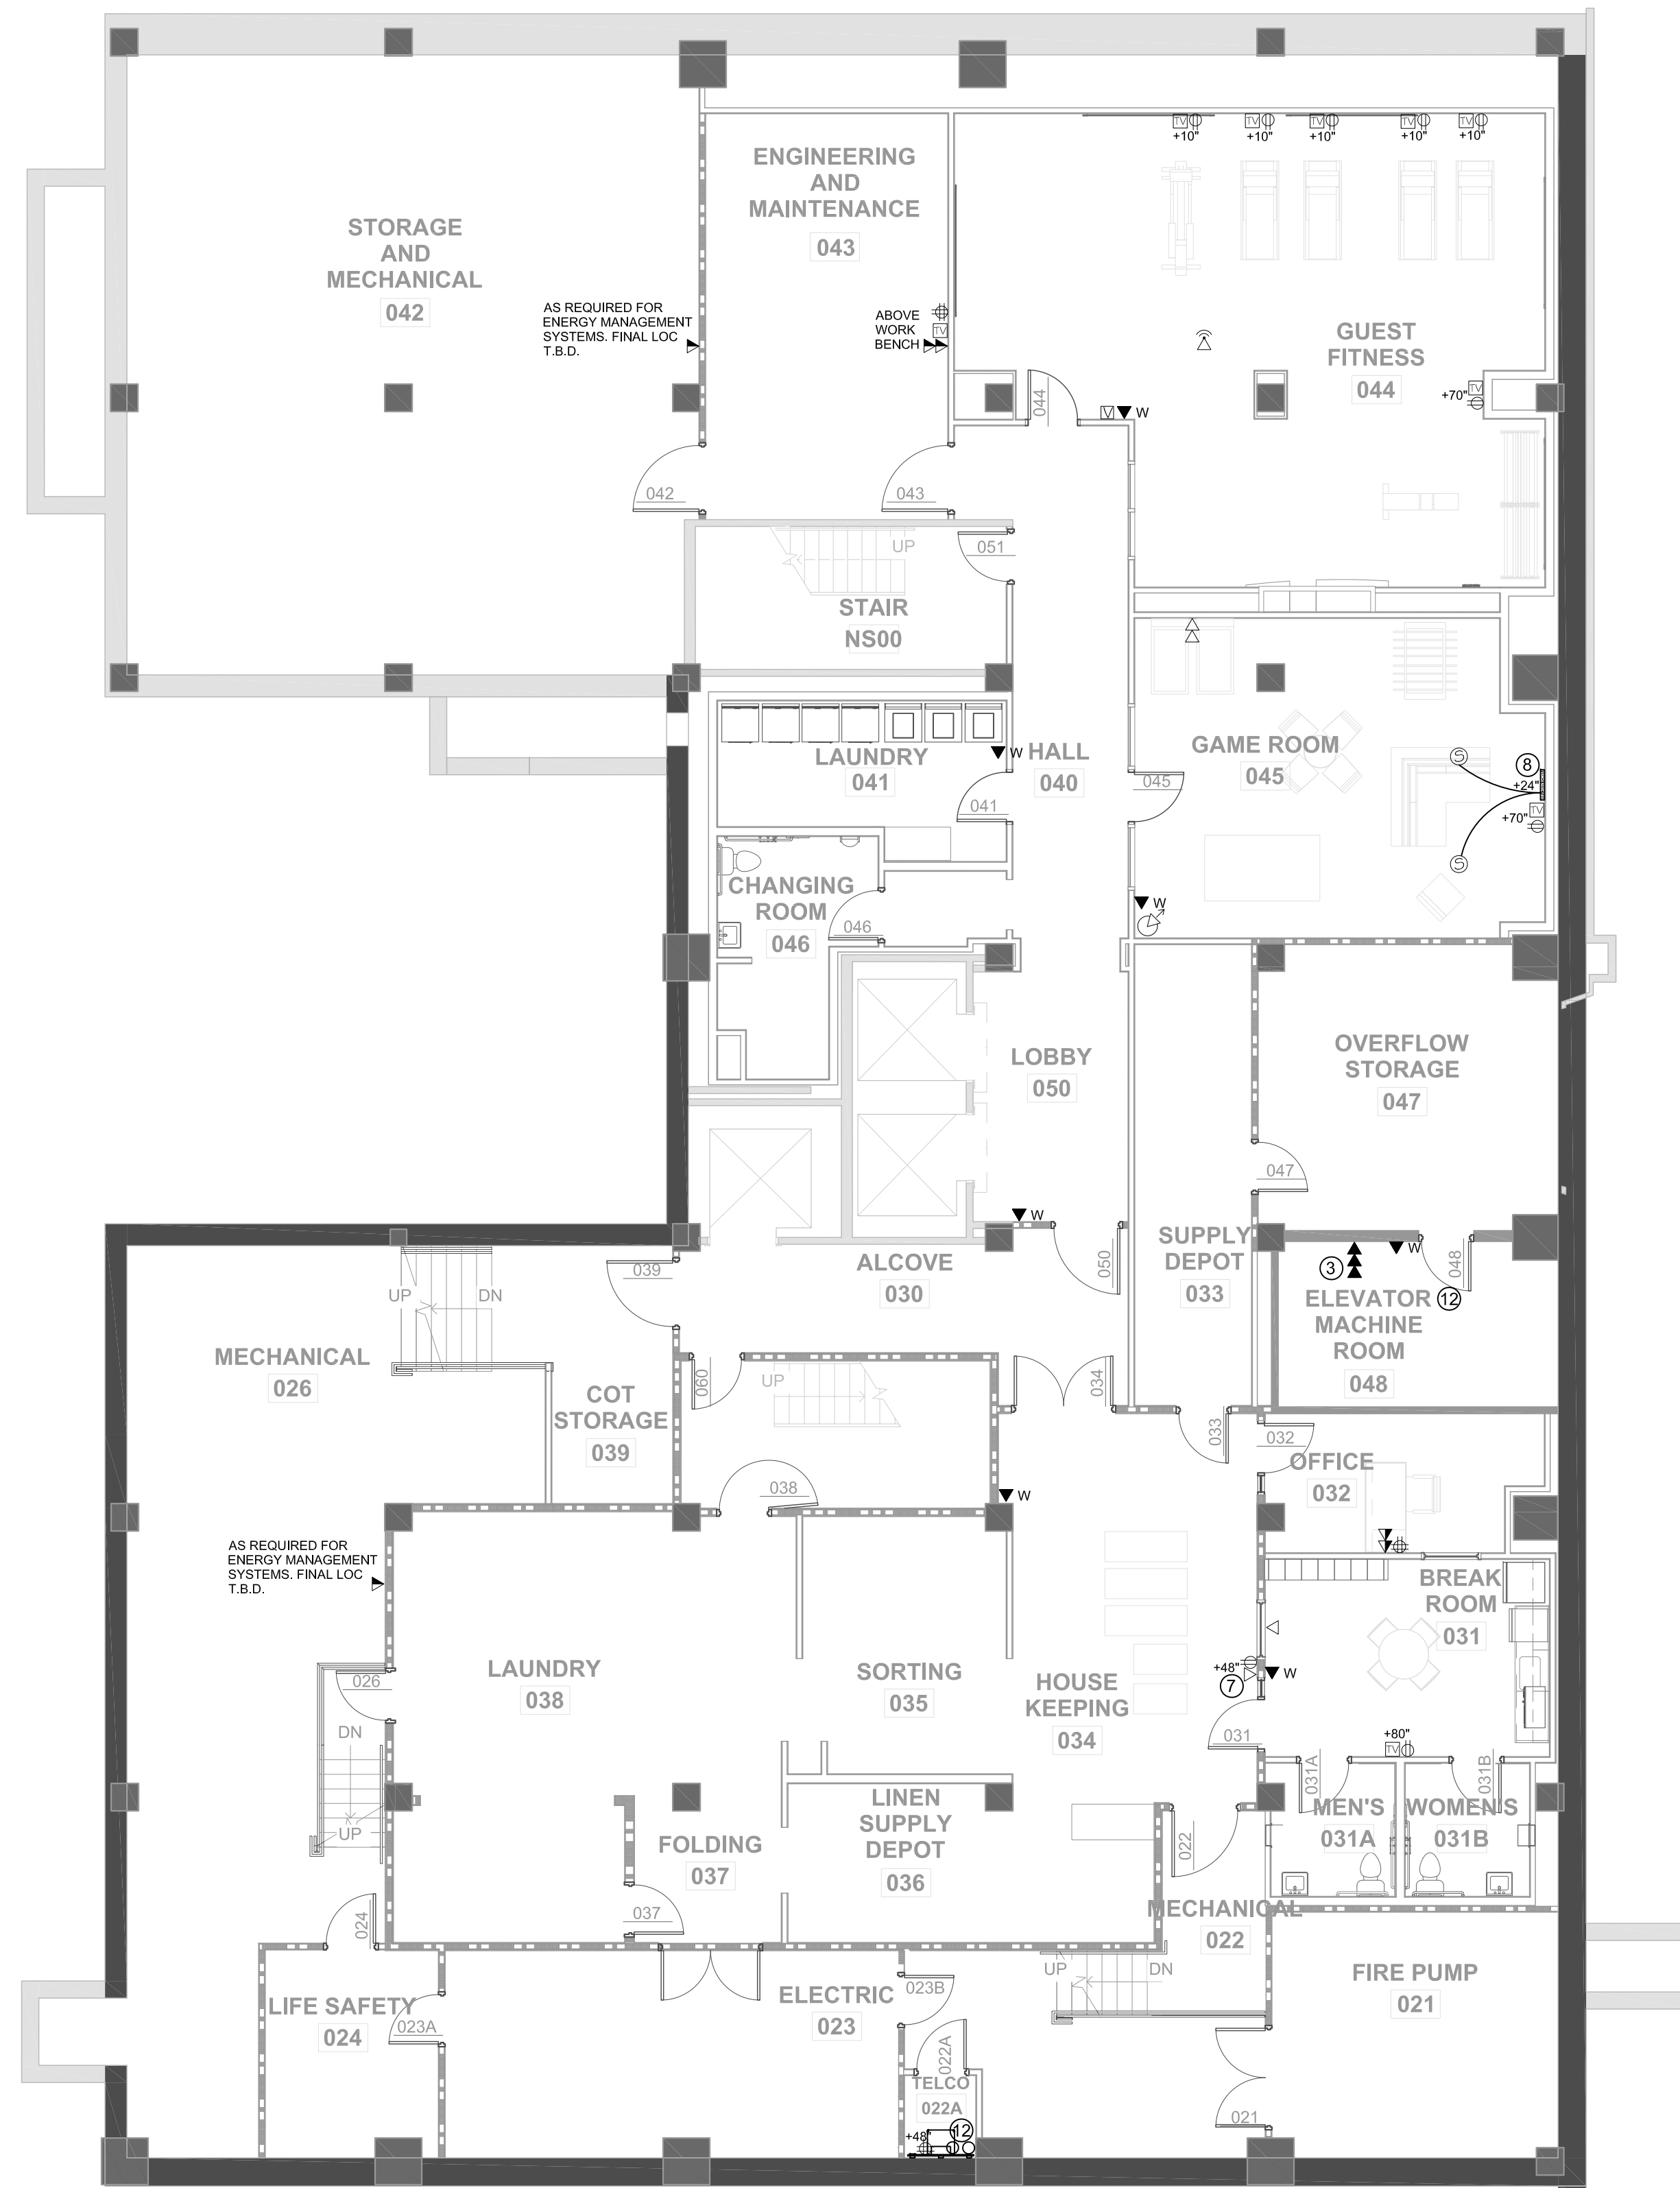


BASEMENT
SCALE: 1/8" = 1'

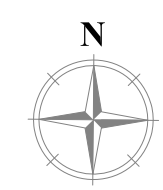

- LOW VOLTAGE LEGEND**
- TV
 - VOICE - PHONE
 - DATA
 - COMBINATION DATA-PHONE
 - DUAL COMB. DATA-PHONE
 - TRI-COMB. DATA-PHONE
REQUIRES 1" CONDUIT FEED
 - WALL PHONE, HEIGHT PER
ADA COMPLIANCE
 - WIRELESS ACCESS POINT (P.O.E.)
IN CEILING (TYPICAL)
 - SPEAKER
 - VOLUME CONTROL
 - JUNCTION BOX SINGLE GANG 1900
 - JUNCTION BOX, 4" W/ 2" CONDUIT
FEED, DOUBLE GANG
 - DUPLEX RECEPTACLE 5-20R
 - QUAD RECEPTACLE 5-20R
 - ISOLATED GROUND CIRCUIT
& RECEPTACLE 5-20IGR
 - CEILING HATCH
 - VIDEO SURVEILLANCE CAMERA
 - IN-FLOOR LOW VOLTAGE
AND 120 VAC POWER
 - INTERCOM
 - CARD READER
 - CCTV MONITOR

- LOW VOLTAGE KEYED NOTES**
- 1 INTERCOM MASTER
 - 2 INTERCOM REMOTE
 - 3 INTERCOM POWER, 24 VAC
IN CEILING
 - 4 POTS LINES-ELEVATOR(S)
 - 5 POTS LINES-FIRE ALARM
 - 6 CARD READER
 - 7 IN-CEILING POWER AND
J-BOX FOR PROJECTOR
 - 8 EMPLOYEE TIME CLOCK
 - 9 JACK-PACK MULTI MEDIA
CONNECTOR
 - 10 DIGITAL SIGNAGE-MONITOR
 - 11 ATM / KIOSK
 - 12 NETWORK PRINTER
 - 13 LOW VOLTAGE SLEEVES
CEILING / FLOOR
 - 14 POS TERMINAL
 - 15 POS PRINTER

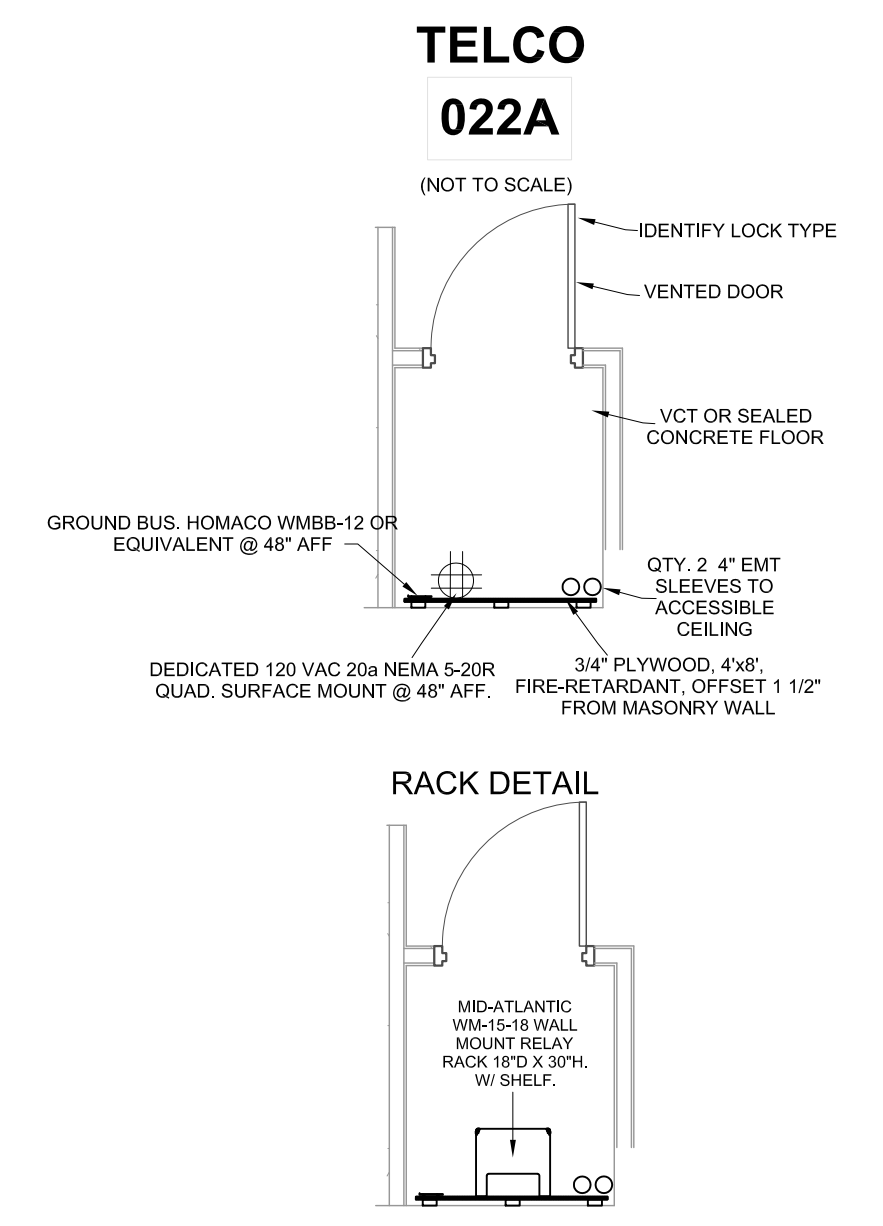

For:
First OFB
10275 W. Higgins Rd.
Ste. 300
Rosemont, IL 60018
847-299-9040

By:
**A-Tech Computer
Service, Inc.**
296 Williams Pl.
East Dundee, IL 60118
847-428-9199
www.a-techinc.com

OFB RESIDENCE INN
OMAHA, NEBRASKA


SHEET AUTHOR	A-T
CHECKED BY	A-T
SCALE	1/8" = 1'
JOB NUMBER	031912-FHG-OM2

ISSUE DATE	6-12-12
ISSUE TITLE	

ISSUED FOR CONSTRUCTION

REVISION SCHEDULE	6-19-12
-------------------	---------

SHEET NAME
**BASEMENT
LOW VOLTAGE
PLAN**
SHEET NUMBER
D-V 2.0

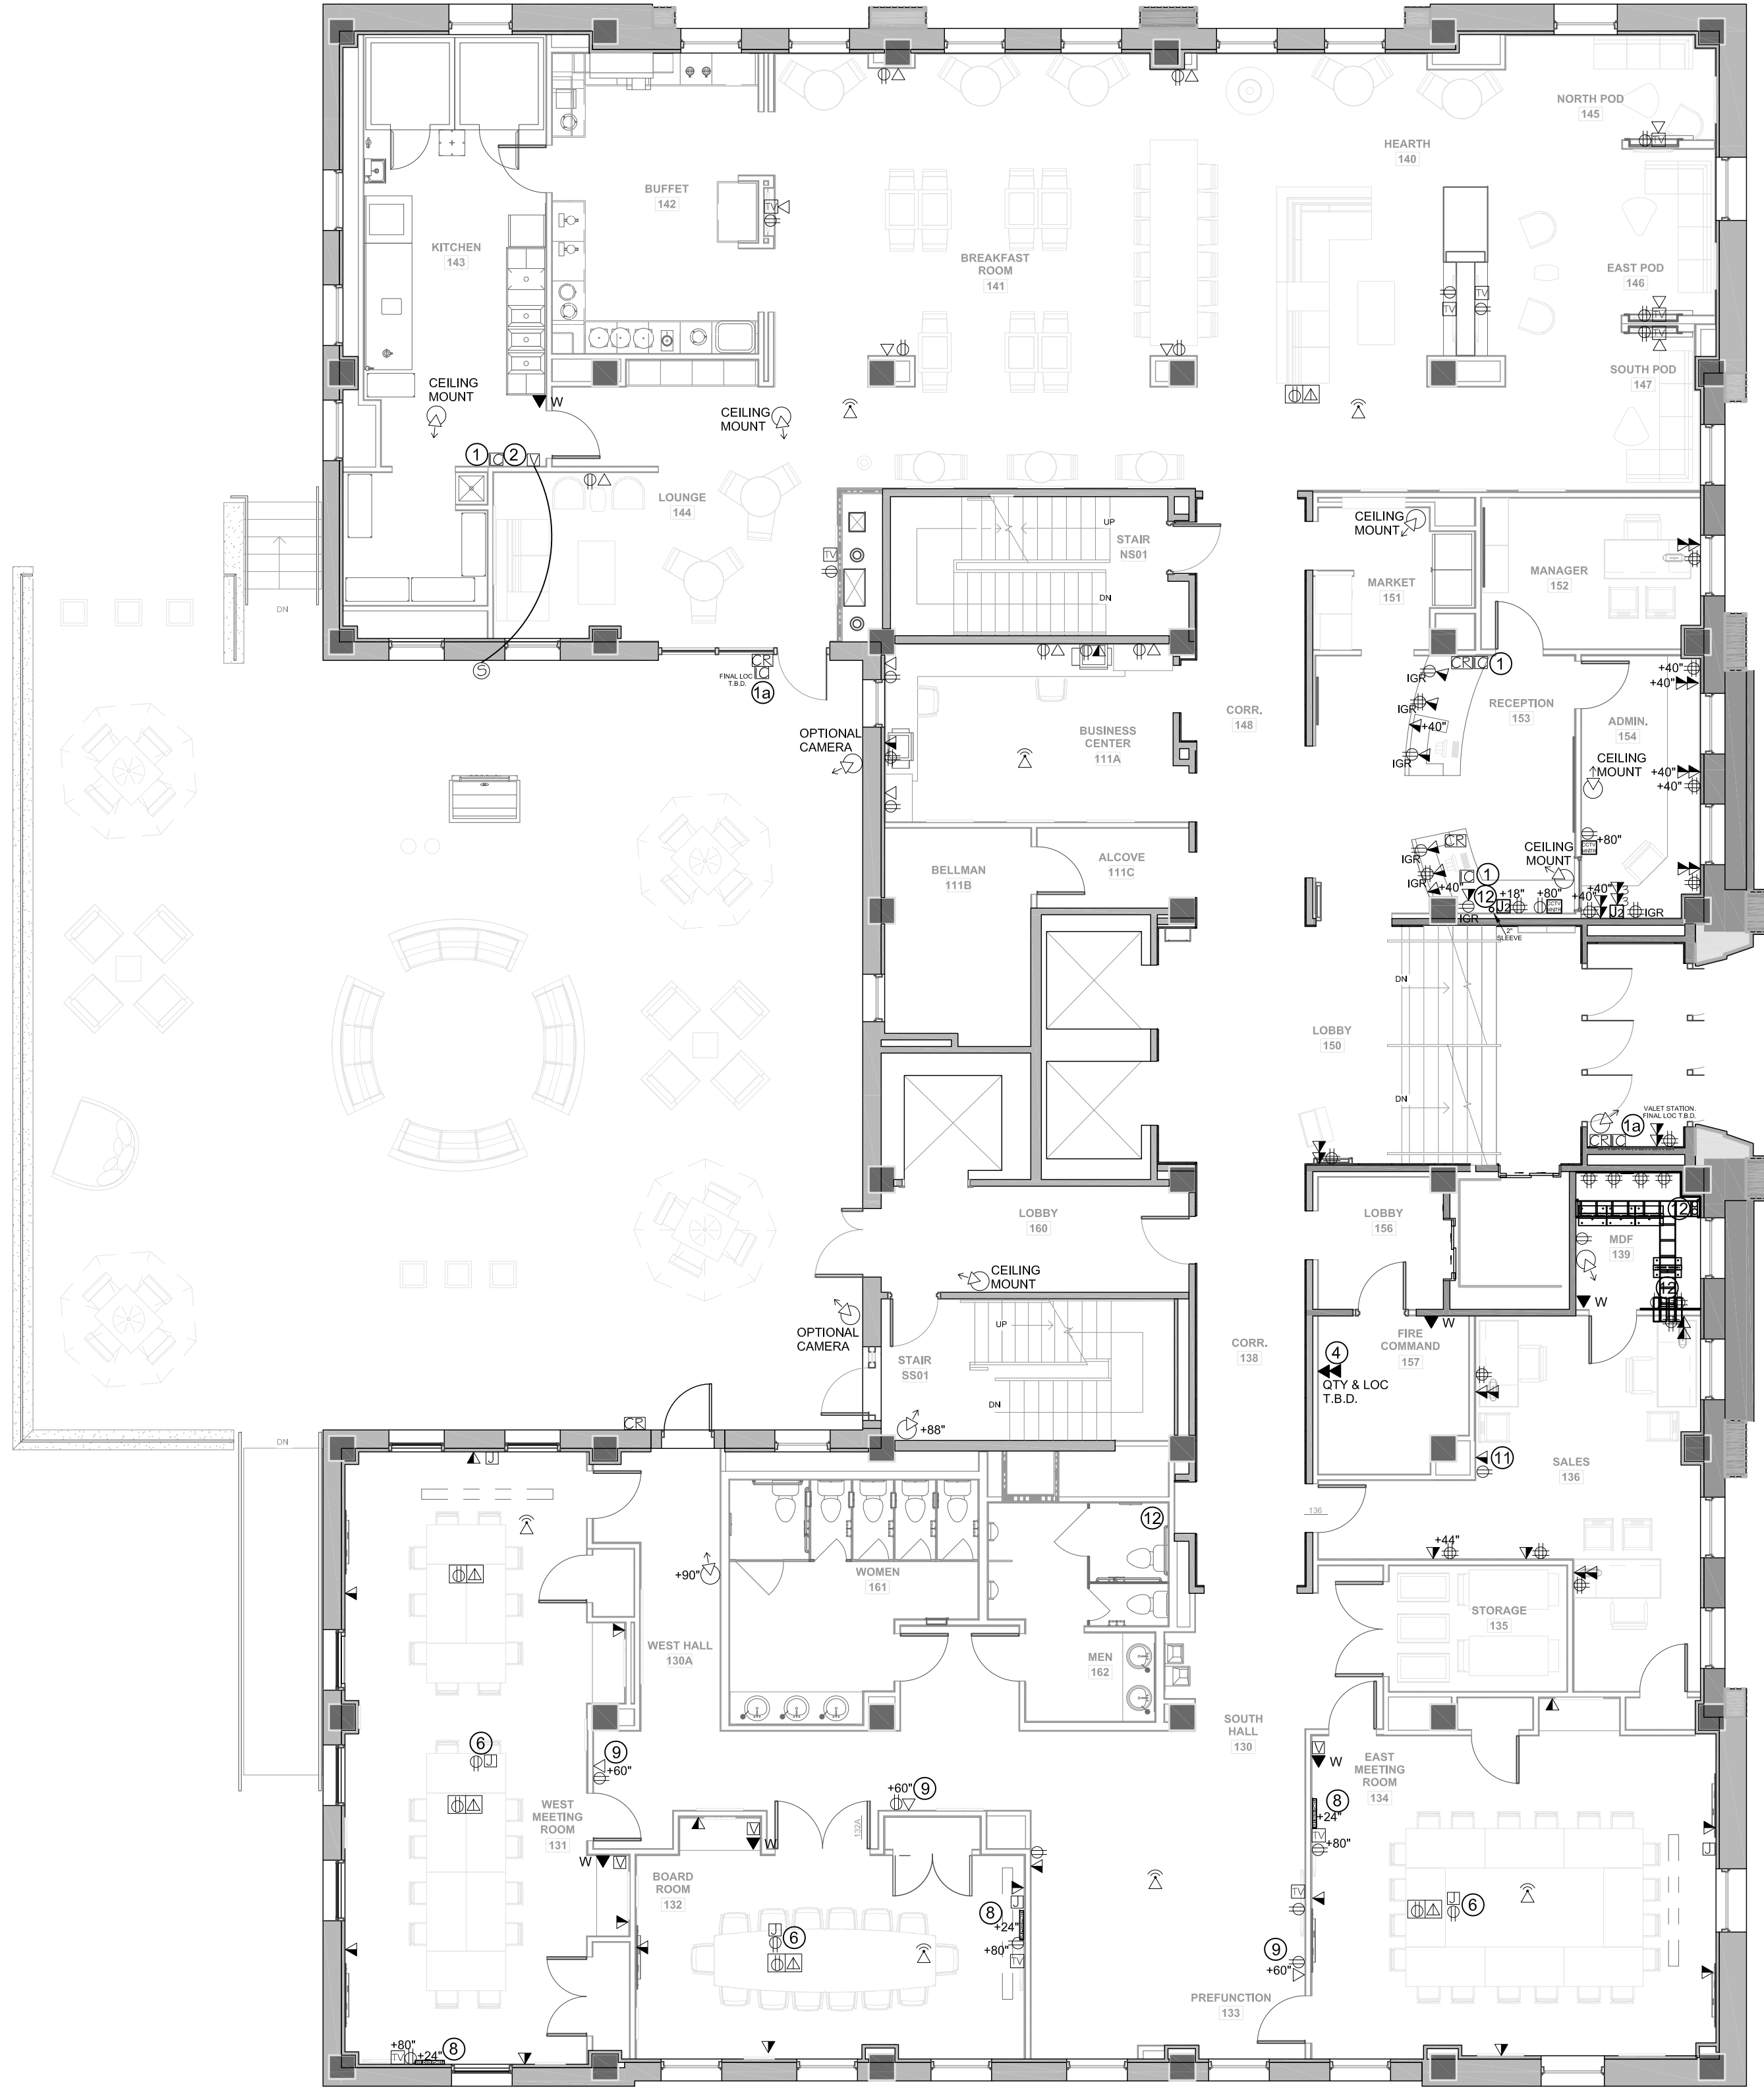



1ST FLOOR
SCALE: 1/8" = 1'



- LOW VOLTAGE LEGEND**
- TV
 - VOICE - PHONE
 - DATA
 - COMBINATION DATA-PHONE
 - DUAL COMB. DATA-PHONE
 - TRI-COMB. DATA-PHONE REQUIRES 1" CONDUIT FEED
 - WALL PHONE, HEIGHT PER ADA COMPLIANCE
 - WIRELESS ACCESS POINT (P.O.E.) IN CEILING (TYPICAL)
 - SPEAKER
 - VOLUME CONTROL
 - JUNCTION BOX SINGLE GANG 1900
 - JUNCTION BOX, 4" W/ 2" CONDUIT FEED, DOUBLE GANG.
 - DUPLEX RECEPTACLE 5-20R
 - QUAD RECEPTACLE 5-20R
 - ISOLATED GROUND CIRCUIT & RECEPTACLE 5-20IGR
 - CEILING HATCH
 - VIDEO SURVEILLANCE CAMERA
 - IN-FLOOR LOW VOLTAGE AND 120 VAC POWER
 - INTERCOM
 - CARD READER
 - CCTV MONITOR

- LOW VOLTAGE KEYED NOTES**
- 1 INTERCOM MASTER
 - 2 INTERCOM REMOTE
 - 3 INTERCOM POWER, 24 VAC IN CEILING
 - 4 POTS LINES-ELEVATOR(S)
 - 5 POTS LINES-FIRE ALARM
 - 6 CARD READER
 - 7 IN-CEILING POWER AND J-BOX FOR PROJECTOR
 - 8 EMPLOYEE TIME CLOCK
 - 9 JACK-PACK MULTI MEDIA CONNECTOR
 - 10 DIGITAL SIGNAGE-MONITOR
 - 11 ATM / KIOSK
 - 12 NETWORK PRINTER
 - 13 LOW VOLTAGE SLEEVES CEILING / FLOOR
 - 14 POS TERMINAL
 - 15 POS PRINTER

1ST FLOOR MDF 139

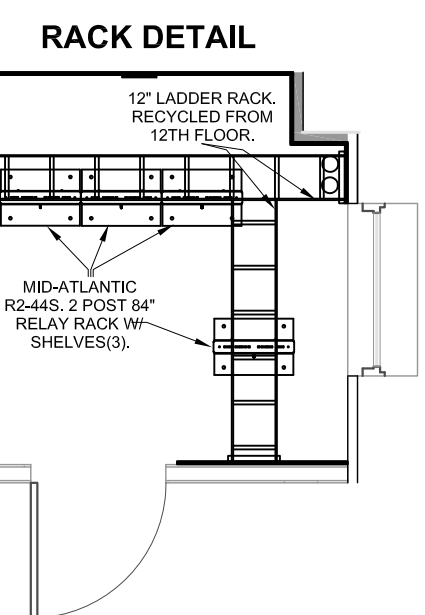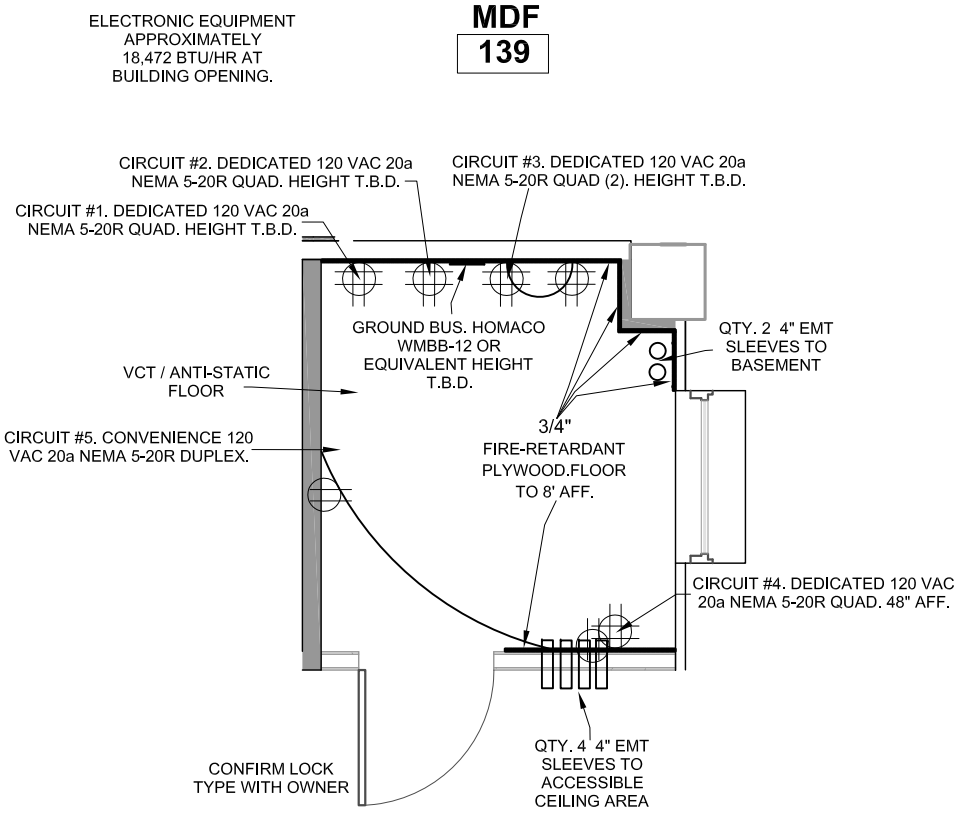

FOR: **First OFB**
10275 W. Higgins Rd.
Ste. 300
Rosemont, IL 60018
847-299-9040

BY: **A-Tech Computer Service, Inc.**
296 Williams Pl.
East Dundee, IL 60118
847-428-9199
www.a-techinc.com

OFB RESIDENCE INN
OMAHA, NEBRASKA

SHEET AUTHOR: A-T
CHECKED BY: A-T
SCALE: 1/8" = 1'
JOB NUMBER: 031912-FHG-OWA2


ISSUE DATE: 6-12-12
ISSUE TITLE:

ISSUED FOR CONSTRUCTION


REVISION SCHEDULE: 6-19-12

SHEET NAME: 1ST FLOOR LOW VOLTAGE PLAN
SHEET NUMBER: D-V 3.0



**BASEMENT
TELCO
DEMARC
022A**

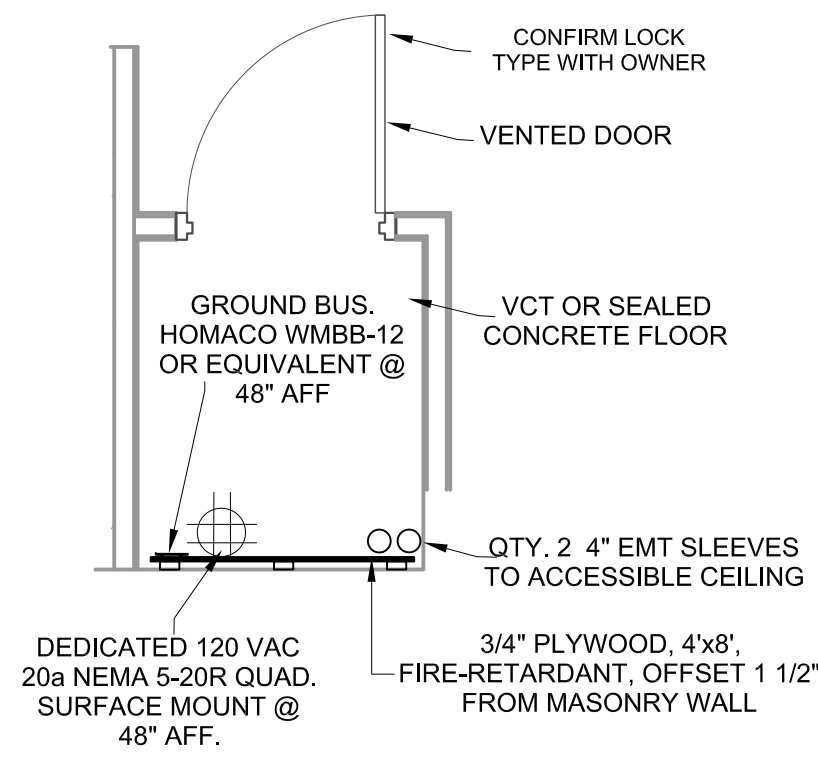



COMMUNICATION CONTRACTOR (C.C.) TO FURNISH AND INSTALL MID-ATLANTIC (OR EQUIVALENT) FLOOR AND WALL RELAY RACKS AND VERTICAL AND HORIZONTAL CABLE MANAGEMENT SYSTEMS. 12" LADDER RACK AND ASSOCIATED HARDWARE TO BE RE-USED FROM RECYCLED RACK SYSTEM FROM EXISTING 12TH FLOOR TELECOM ROOM. EQUIPMENT IS BEING HELD IN STORAGE BY G.C. UNTIL INSTALLATION. SUPPLY ADDITIONAL WALL MOUNT BRACKETS, TEE AND BUTT SPLICE KITS, FASTENERS, GROUND POINTS AND HARDWARE AS REQUIRED.

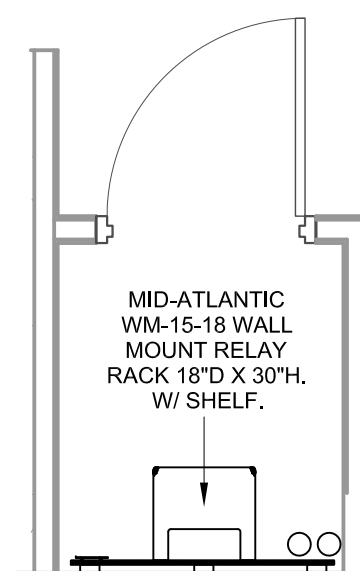



**1ST
FLOOR
MDF
139**

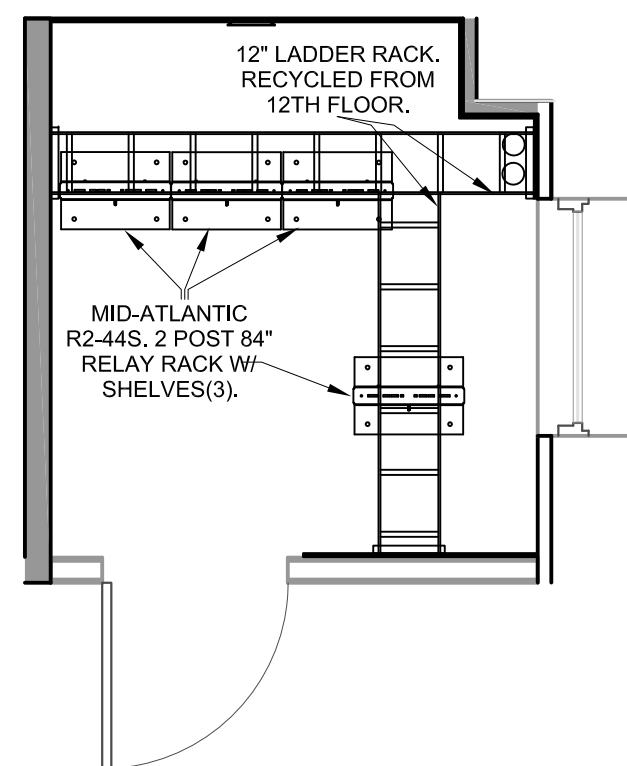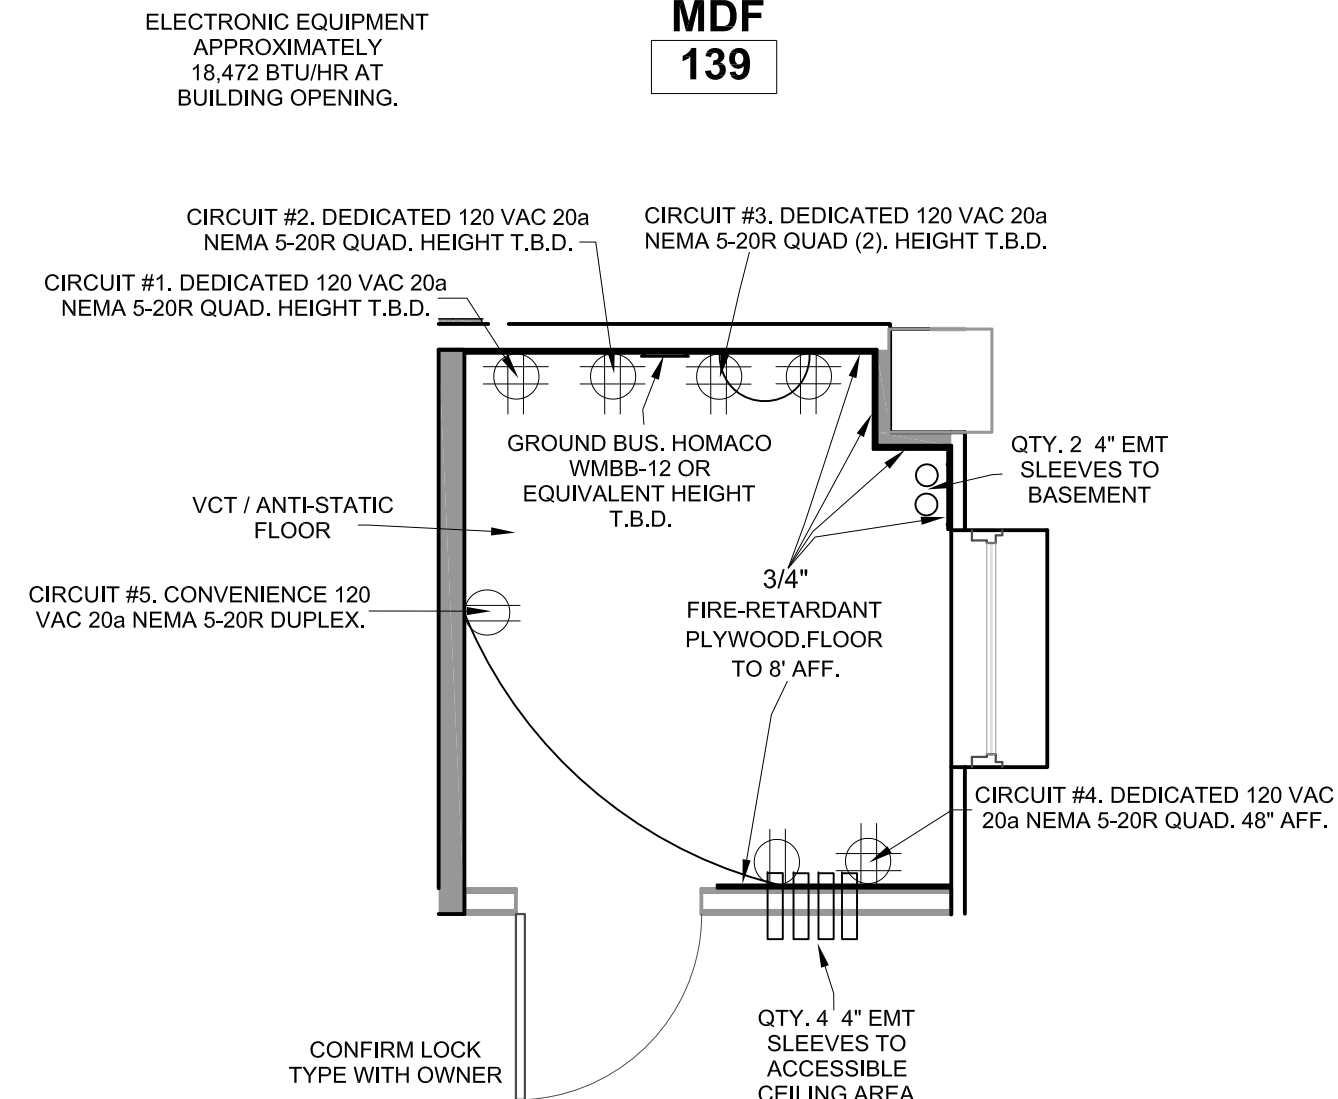

**6TH
FLOOR
IDF
663**

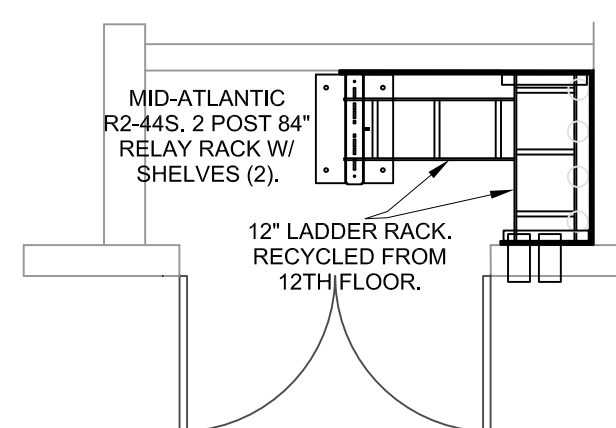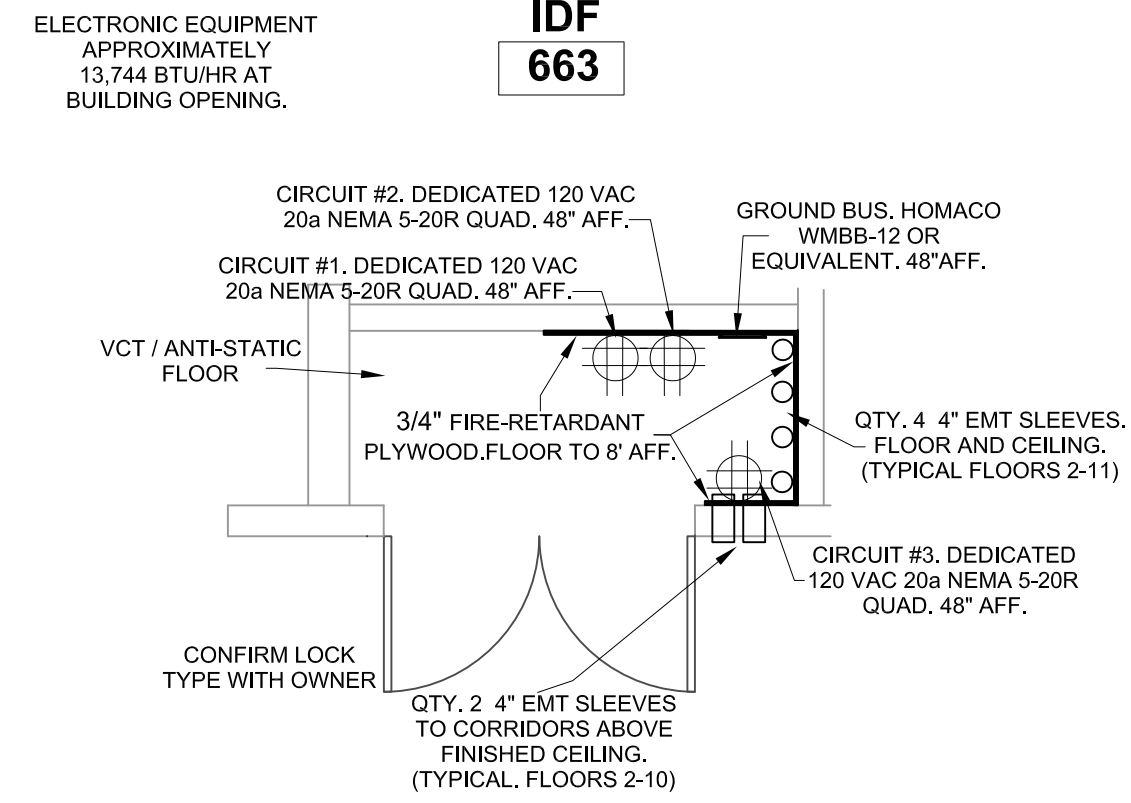

**11TH FLOOR
MATV HEAD END-
DATA IDF
1163**

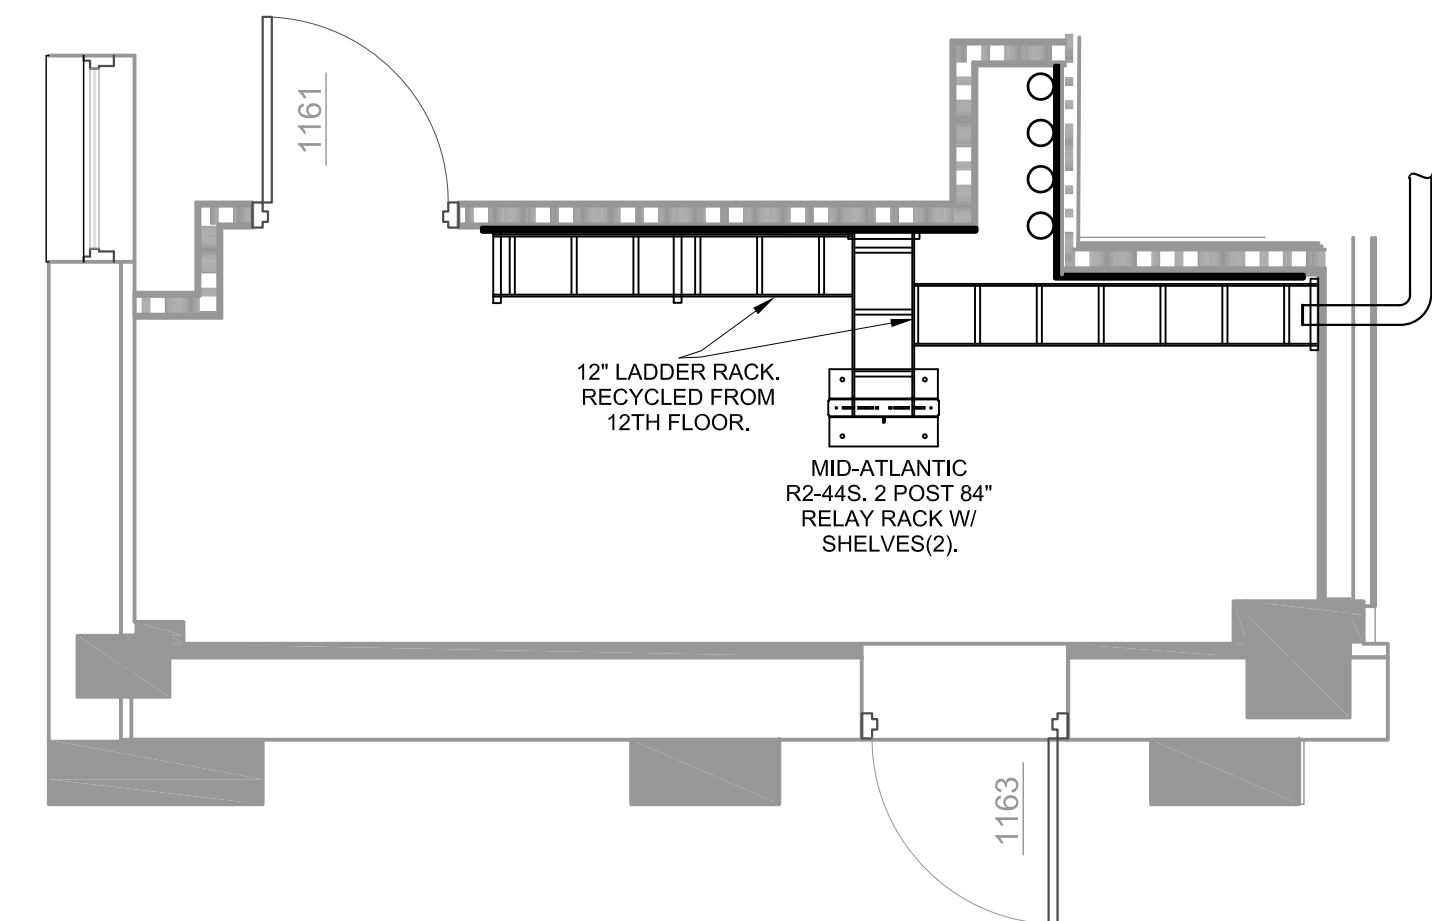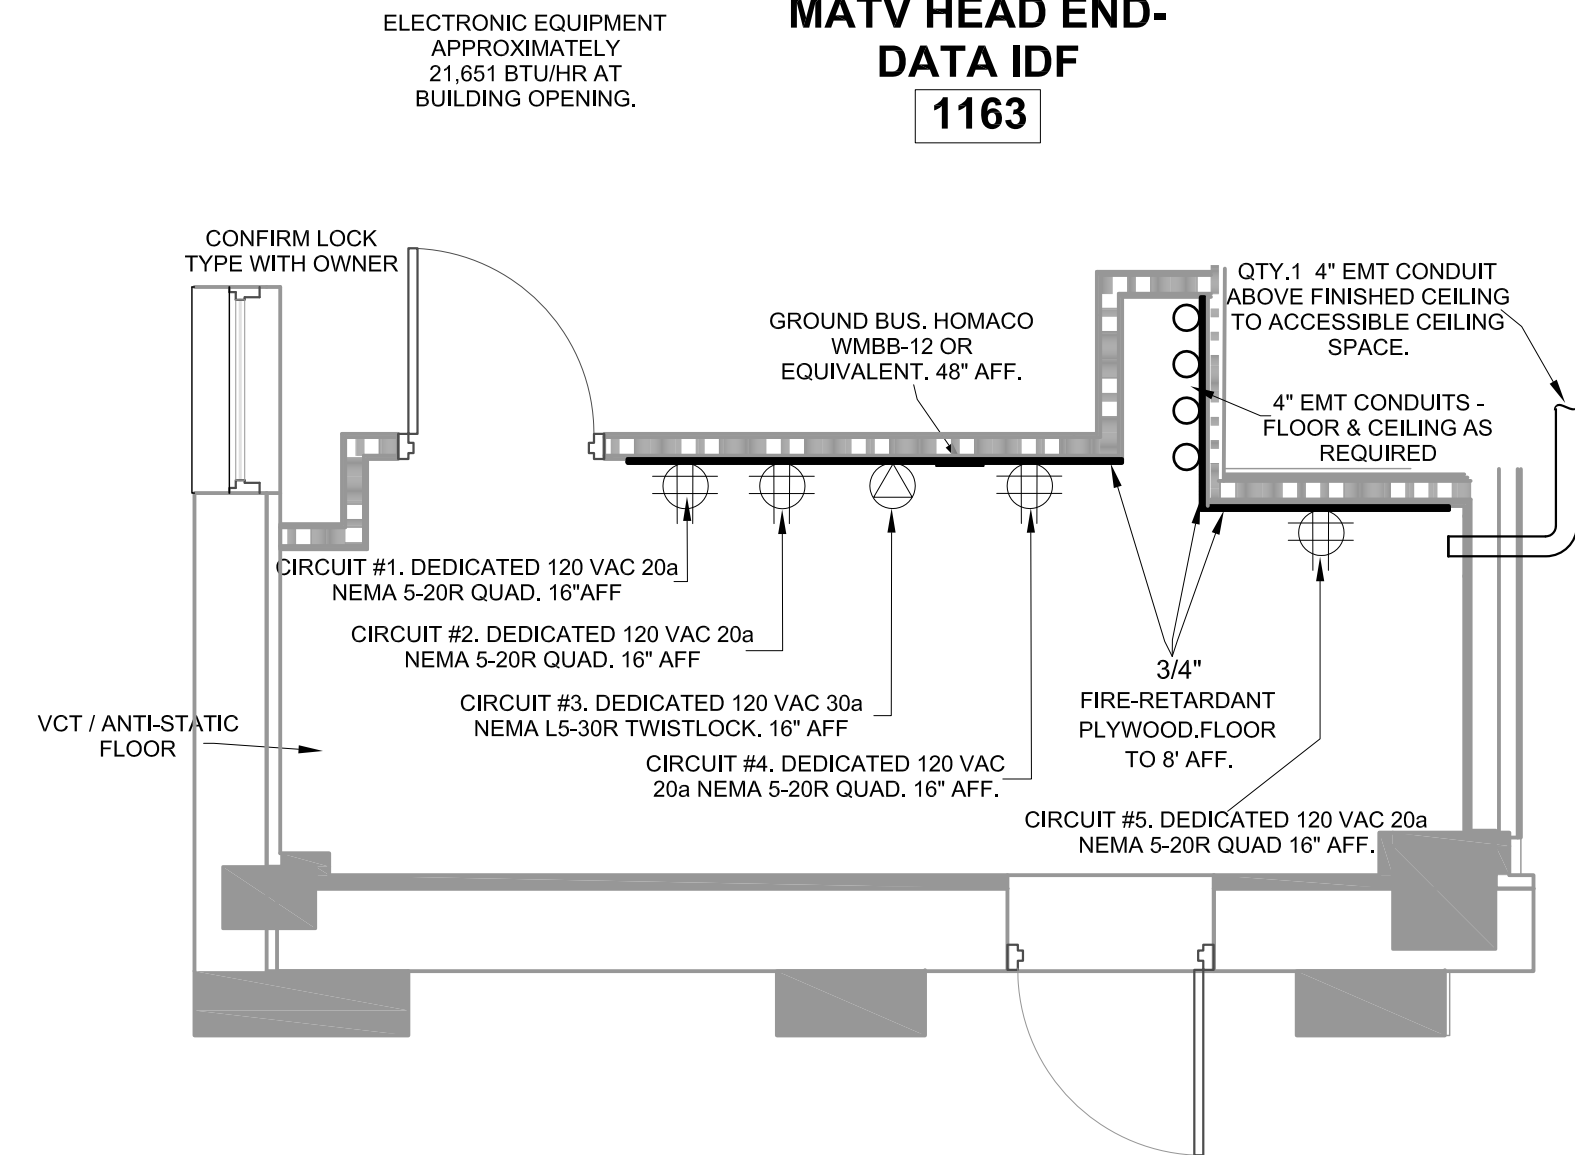

For:
First OFB
10275 W. Higgins Rd.
Ste. 300
Rosemont, IL 60018
847-299-9040

By:
A-Tech Computer Service, Inc.
296 Williams Pl.
East Dundee, IL 60118
847-428-9199
www.a-techinc.com

OFB RESIDENCE INN
OMAHA, NEBRASKA

SHEET AUTHOR
A-T
CHECKED BY
A-T
SCALE
N/A
JOB NUMBER
031912-FHG-OM2


ISSUE DATE
6-3-12
ISSUE TITLE

ISSUED FOR CONSTRUCTION

REVISION SCHEDULE
6-19-12


SHEET NAME
**LOW VOLTAGE
DISTRIBUTION
FRAME DETAIL**

SHEET NUMBER
D-V 4.0

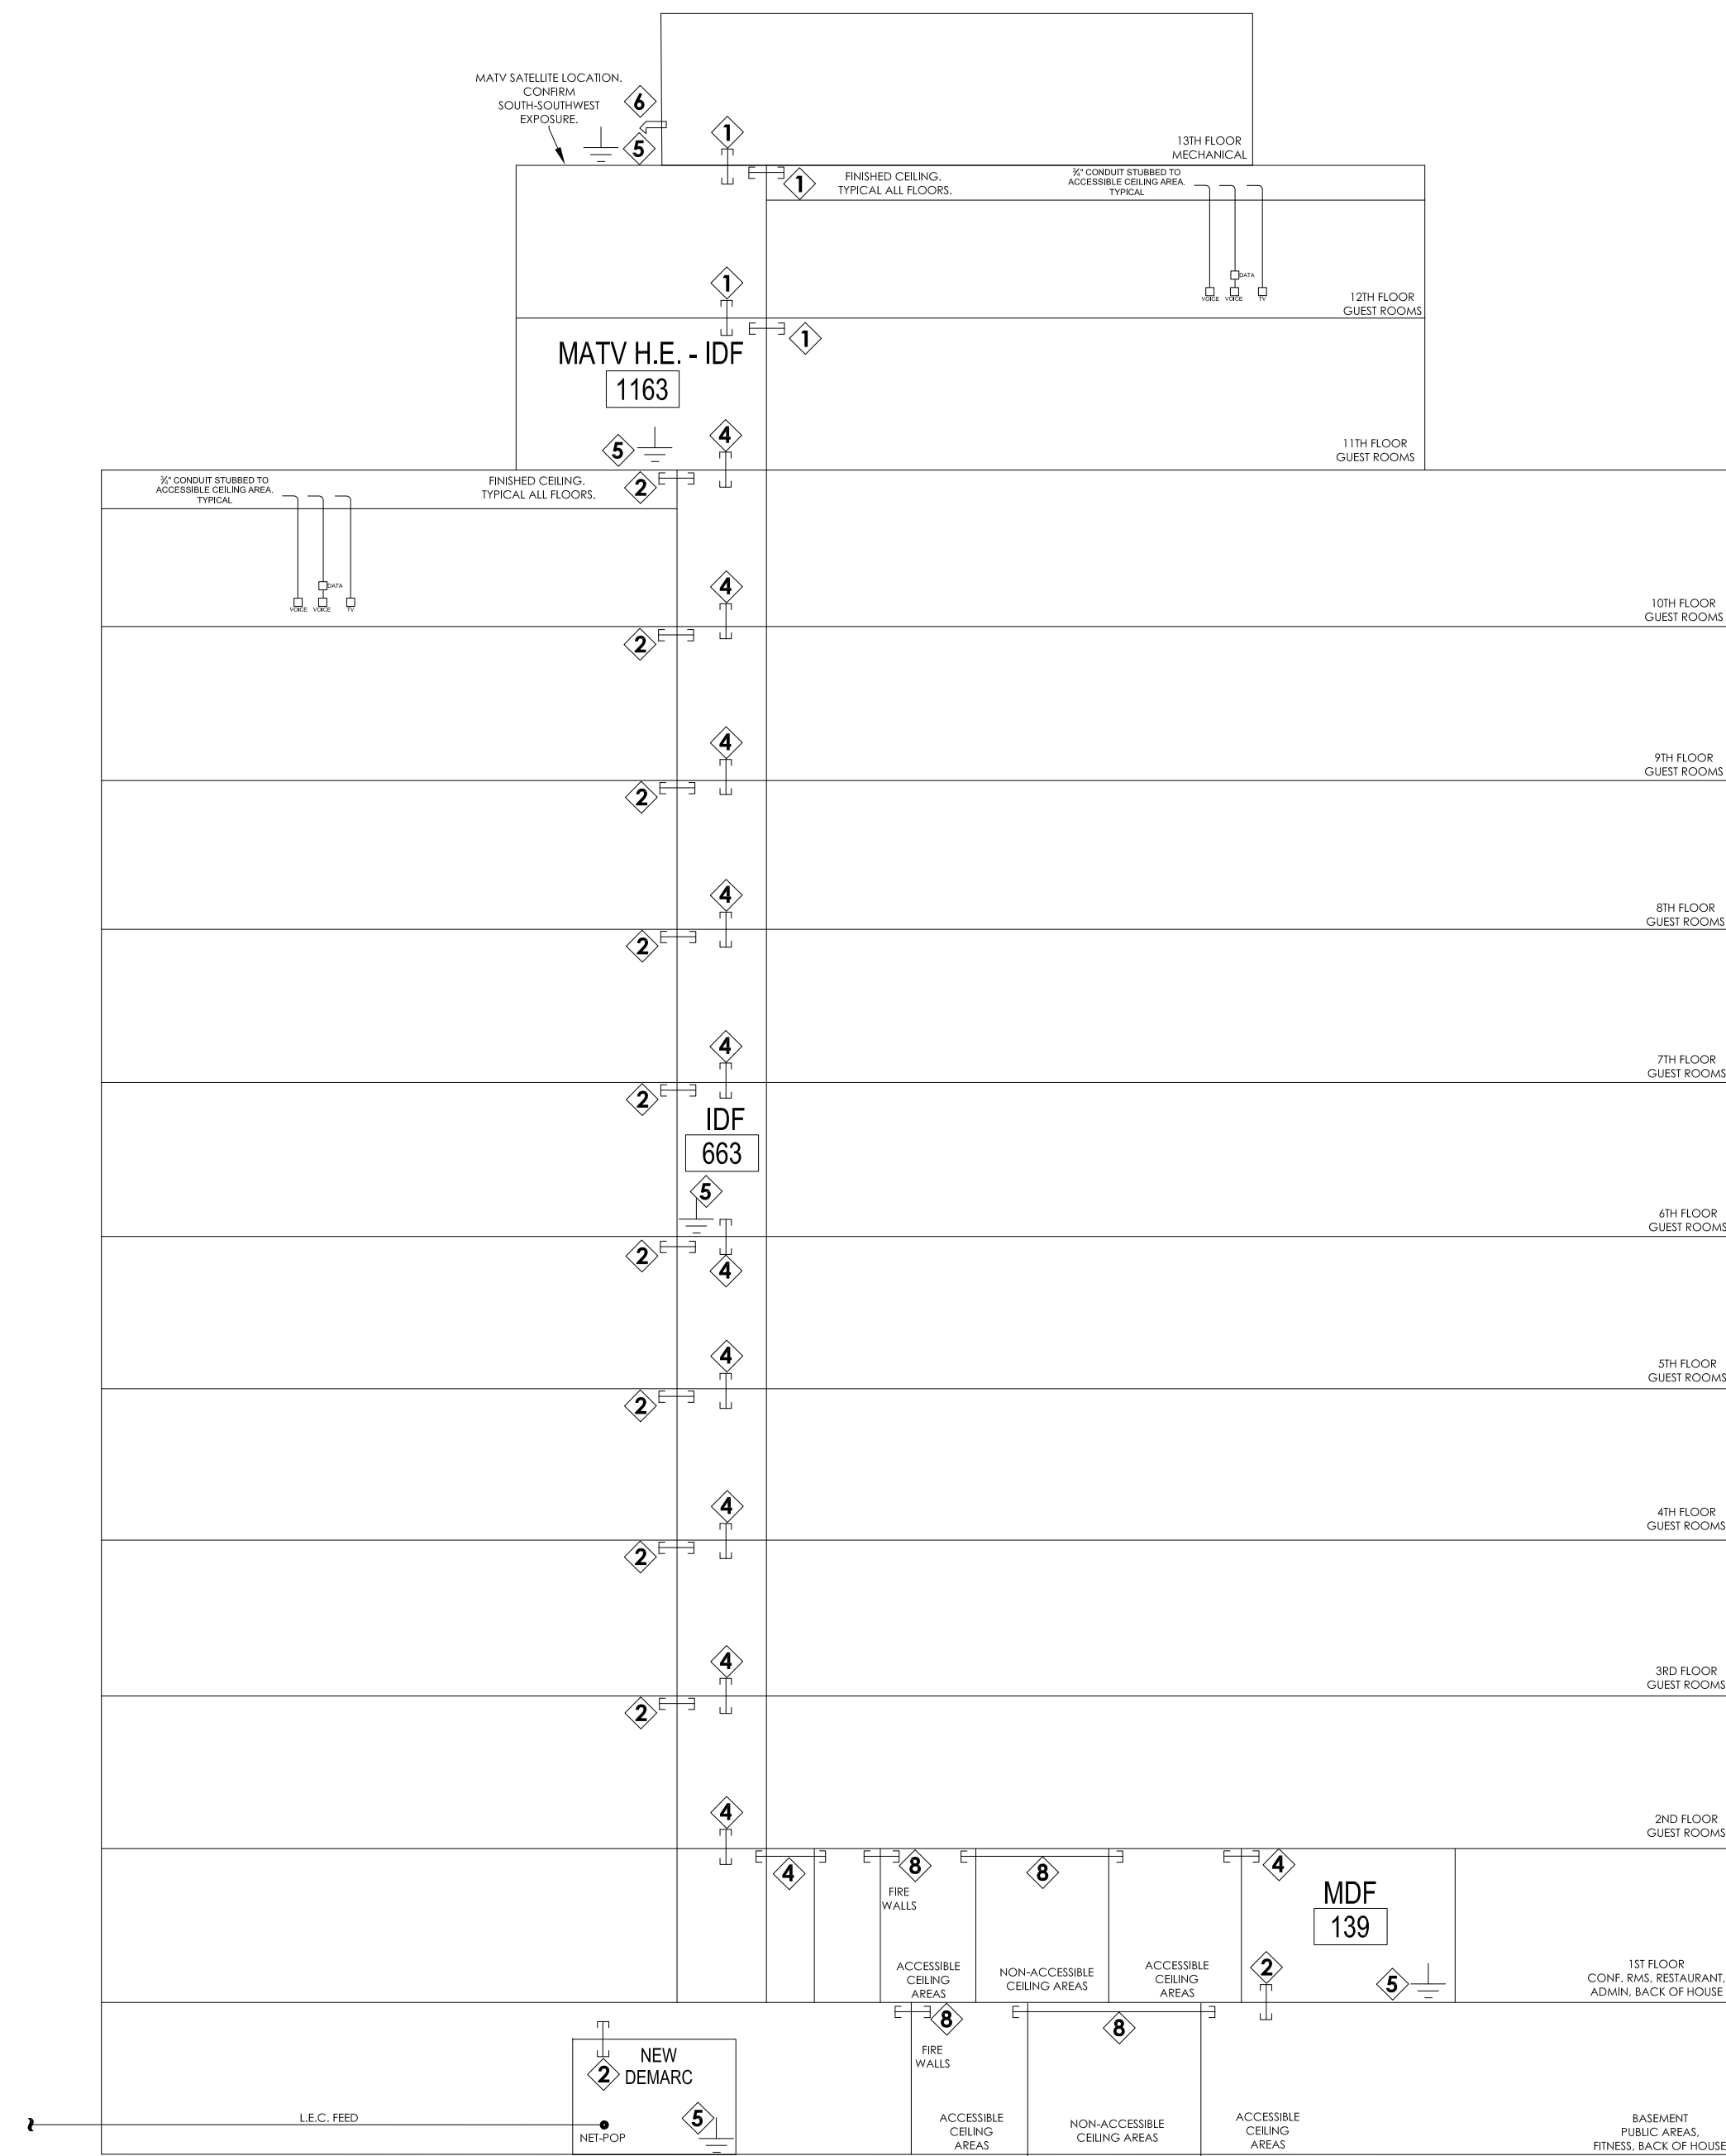

1 CONDUIT / SLEEVE SCHEMATIC RISER
SCALE: NONE

CONDUIT / SLEEVE KEYED NOTES	
①	(1) 4" EMT CONDUIT SLEEVE TOTAL
②	(2) 4" EMT CONDUIT SLEEVES TOTAL
③	(3) 4" EMT CONDUIT SLEEVES TOTAL
④	(4) 4" EMT CONDUIT SLEEVES TOTAL
⑤	GROUND POINT TO BLDG. SVC. GROUND ELECTRODE
⑥	(1) 3" EMT CONDUIT SLEEVE W/ WEATHERHEAD
⑦	(1) 2" EMT CONDUIT SLEEVE
⑧	EMT CONDUIT SLEEVES AS REQUIRED. E.C. TO CONFIRM SIZE AND LOCATION.

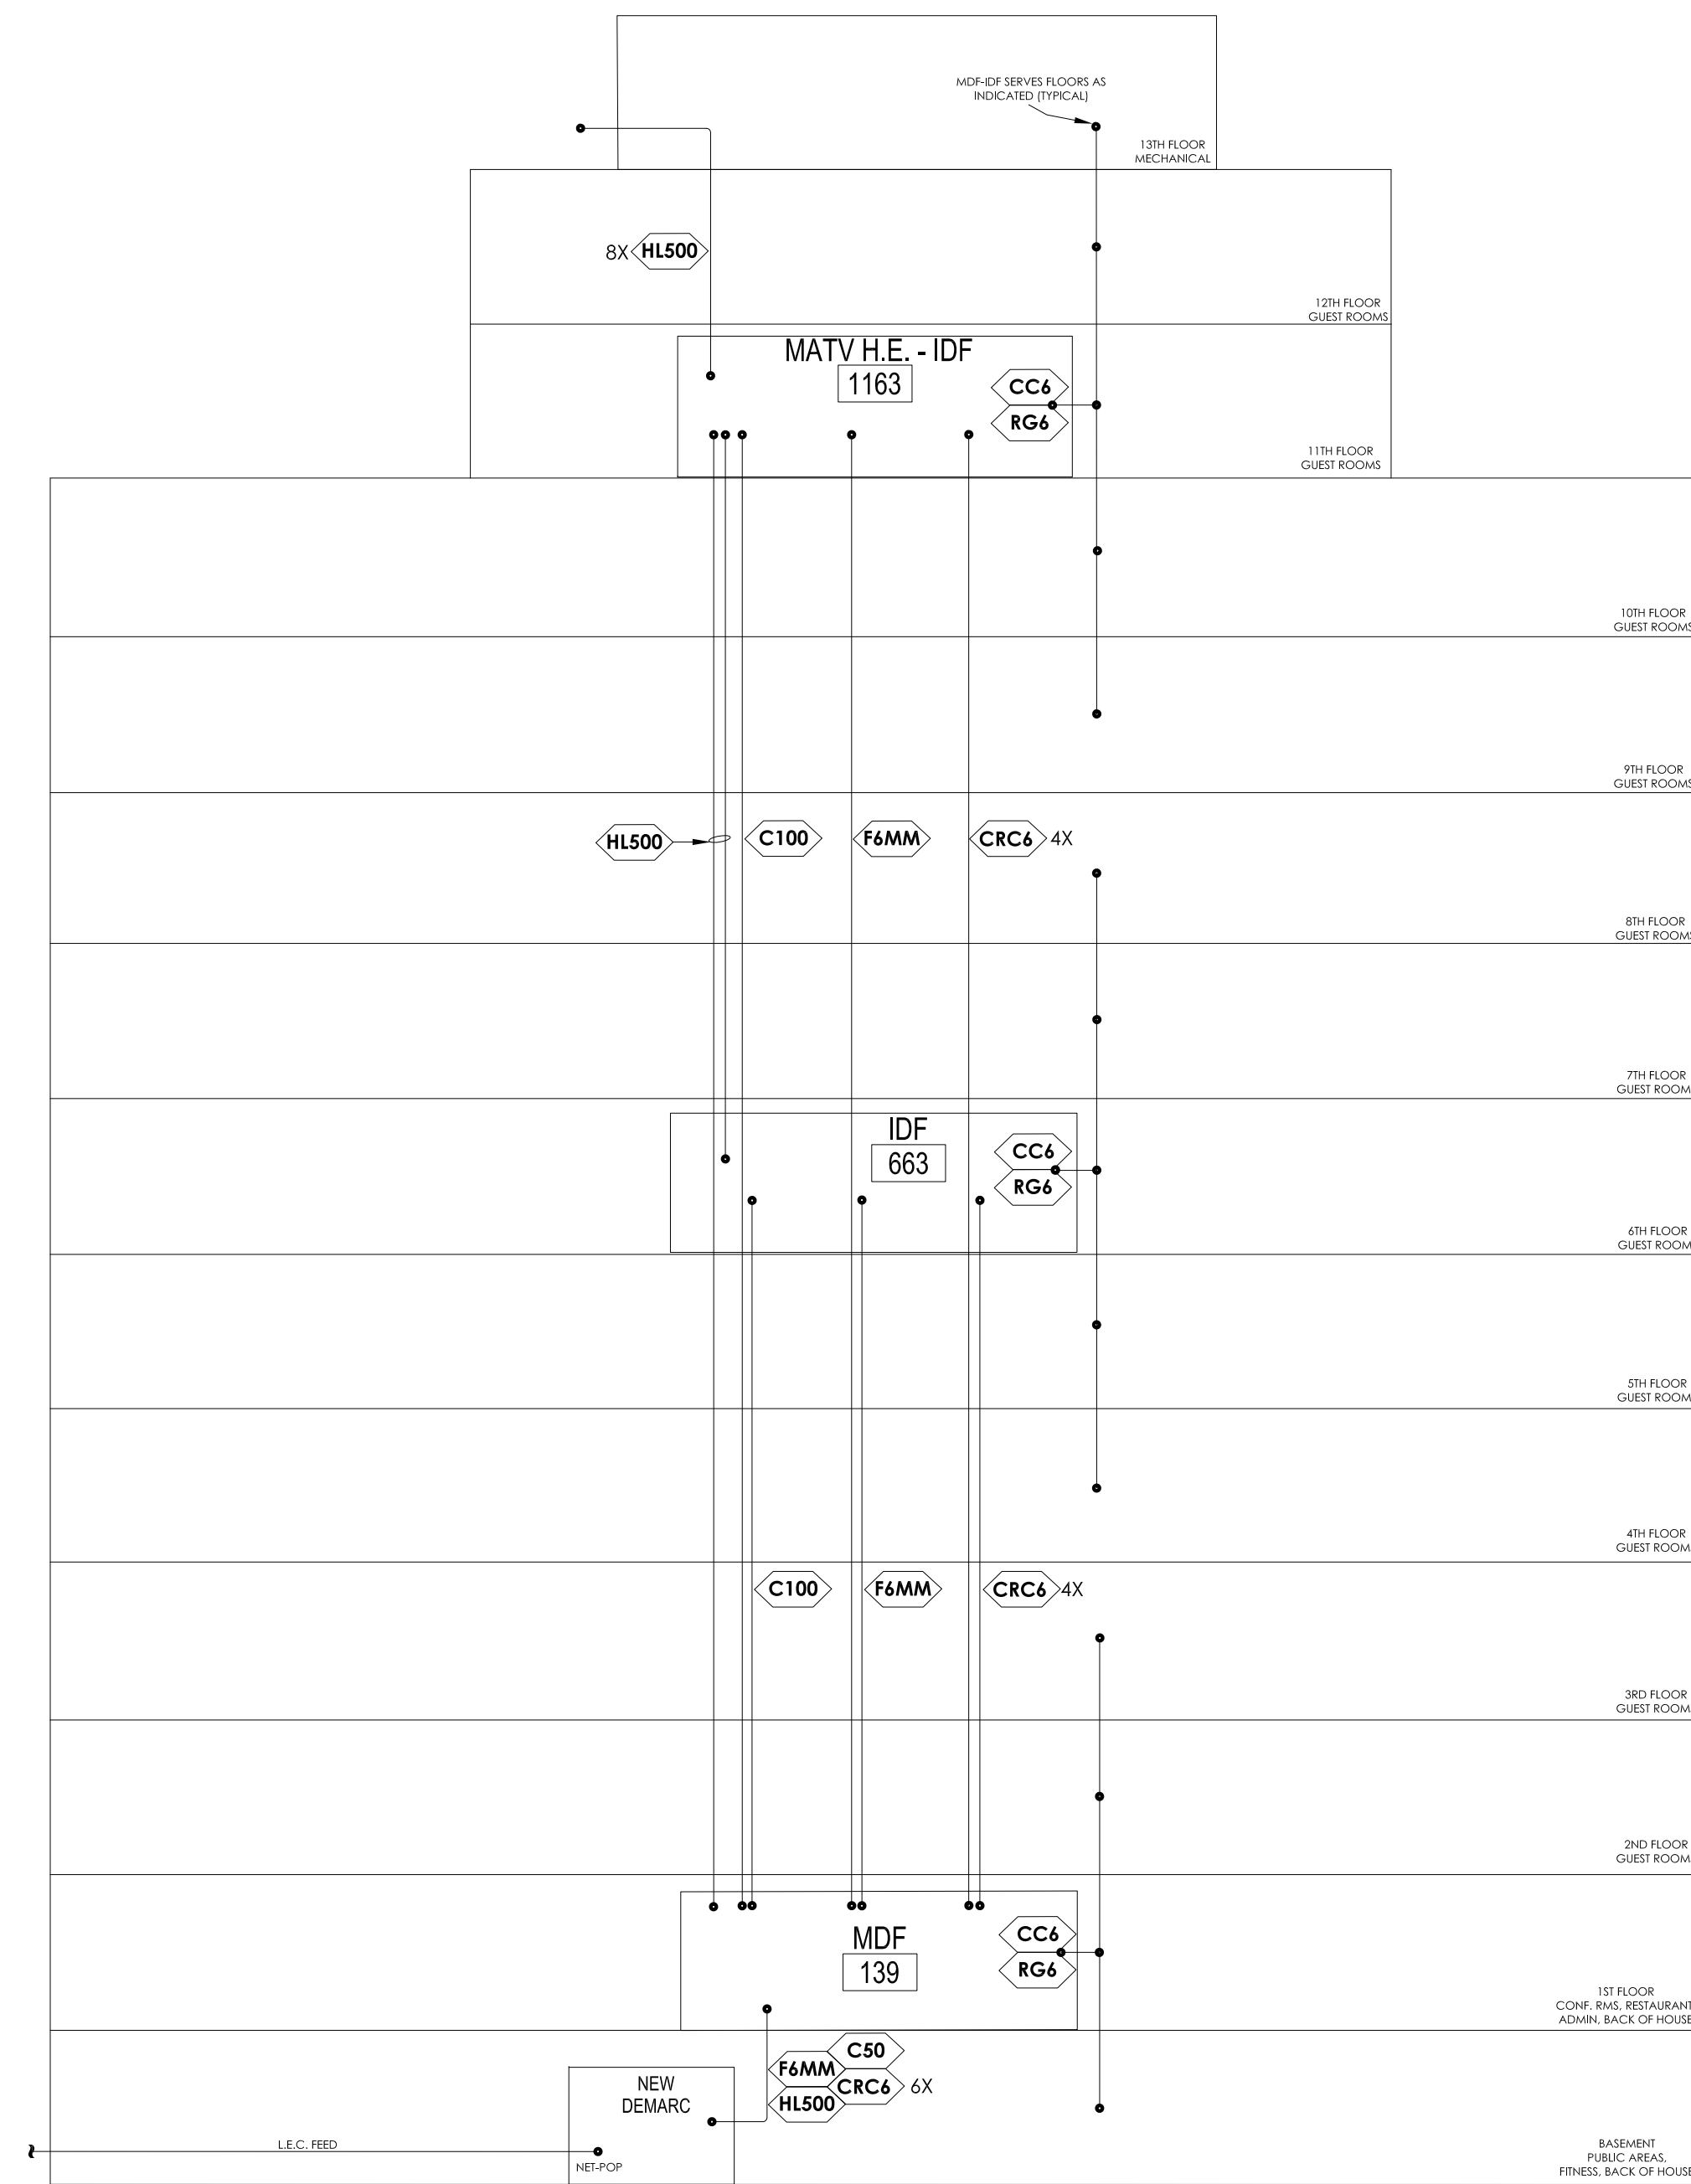

2 DATA-VOICE-VIDEO SCHEMATIC RISER
SCALE: NONE

CABLE LEGEND	
C100	MULTIPAIR RISER COPPER BACKBONE CABLE
C50	MULTIPAIR RISER COPPER BACKBONE CABLE
CRC6	CATEGORY 6 RISER COPPER BACKBONE
HL500	HARD LINE .5 / RG-11 (T.B.D.)
F6MM	6 STRAND MULTI-MODE 50u FIBER OPTIC CABLE
CC6	CATEGORY 6 HORIZ COPPER
RG6	RG6 DUAL/QUAD CATV HORIZ COAX

For: **First OFB**
10275 W. Higgins Rd.
Ste. 300
Rosemont, IL 60018
847-299-9040

By: **A-Tech Computer Service, Inc.**
296 Williams Pl.
East Dundee, IL 60118
847-428-9199
www.a-techinc.com

OFB RESIDENCE INN

OMAHA, NEBRASKA

SHEET AUTHOR: A-T
CHECKED BY: A-T
SCALE: N/A
JOB NUMBER: 031912-FHG-OWA2

ISSUE DATE: 6-12-12
ISSUE TITLE: ISSUED FOR CONSTRUCTION


REVISION SCHEDULE: 6-19-12

SHEET NAME:

RISER-CONDUIT SCHEDULE LOW VOLTAGE

SHEET NUMBER:

D-V 5.0

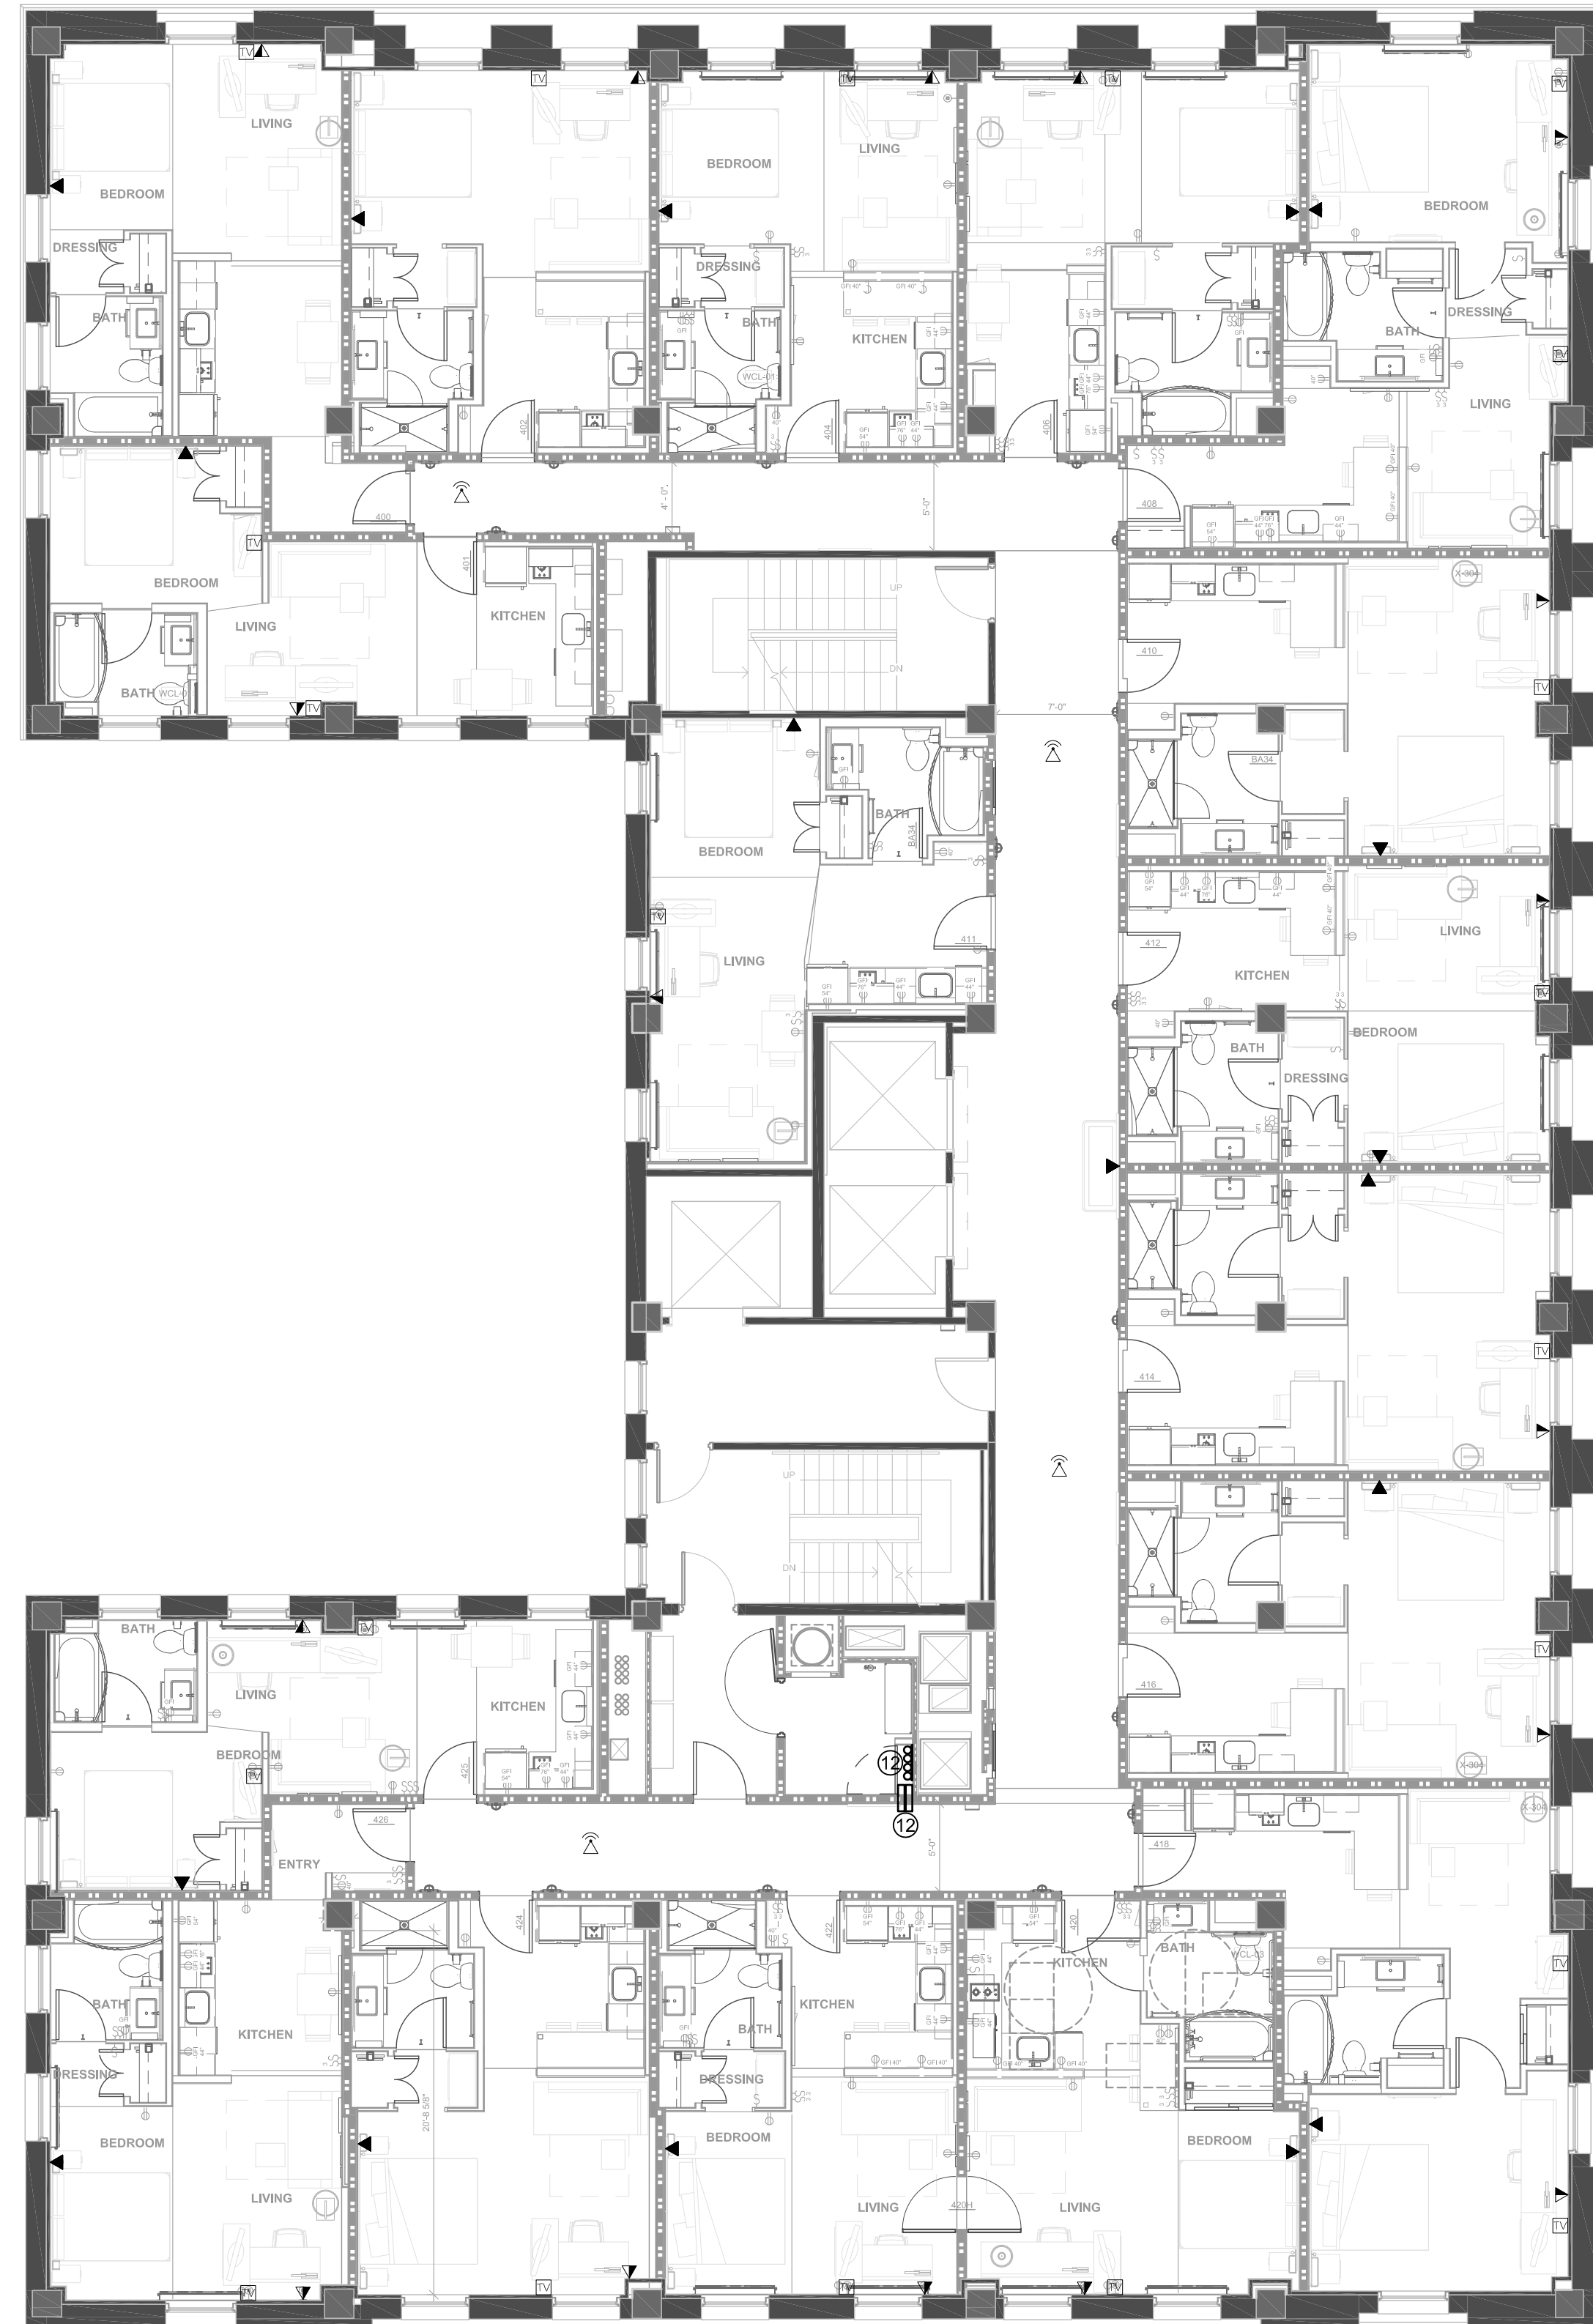

TYPICAL GUEST ROOM FLOORS 2-10

SCALE: 1/8" = 1'



LOW VOLTAGE LEGEND

- TV
- VOICE - PHONE
- DATA
- COMBINATION DATA-PHONE
- DUAL COMB. DATA-PHONE
- TRI-COMB. DATA-PHONE
REQUIRES 1" CONDUIT FEED
- WALL PHONE, HEIGHT PER
ADA COMPLIANCE
- WIRELESS ACCESS POINT (P.O.E.)
IN CEILING (TYPICAL)
- SPEAKER
- VOLUME CONTROL
- JUNCTION BOX SINGLE GANG 1900
- JUNCTION BOX, 4" W/ 2" CONDUIT
FEED, DOUBLE GANG.
- DUPLEX RECEPTACLE 5-20R
- QUAD RECEPTACLE 5-20R
- ISOLATED GROUND CIRCUIT
& RECEPTACLE 5-20IGR
- CEILING HATCH
- VIDEO SURVEILLANCE CAMERA
- IN-FLOOR LOW VOLTAGE
AND 120 VAC POWER
- INTERCOM
- CARD READER
- CCTV MONITOR

LOW VOLTAGE KEYED NOTES

- 1 INTERCOM MASTER
- 1a INTERCOM REMOTE
- 2 INTERCOM POWER, 24 VAC
IN CEILING
- 3 POTS LINES-ELEVATOR(S)
- 4 POTS LINES-FIRE ALARM
- 5 CARD READER
- 6 IN-CEILING POWER AND
J-BOX FOR PROJECTOR
- 7 EMPLOYEE TIME CLOCK
- 8 JACK-PACK MULTI MEDIA
CONNECTOR
- 9 DIGITAL SIGNAGE-MONITOR
- 10 ATM / KIOSK
- 11 NETWORK PRINTER
- 12 LOW VOLTAGE SLEEVES
CEILING / FLOOR
- 13 POS TERMINAL
- 14 POS PRINTER

For: **First OFB**
10275 W. Higgins Rd.
Ste. 300
Rosemont, IL 60018
847-299-9040

By: **A-Tech Computer
Service, Inc.**
296 Williams Pl.
East Dundee, IL 60118
847-428-9199
www.a-techinc.com

OFB RESIDENCE INN
OMAHA, NEBRASKA

SHEET AUTHOR

A-T

CHECKED BY

A-T

SCALE

1/8" = 1'

JOB NUMBER
031912-FHG-OWA2

ISSUE DATE

6-12-12

ISSUE TITLE

ISSUED FOR CONSTRUCTION

REVISION SCHEDULE


6-19-12

SHEET NAME



TYPICAL GUEST
ROOM FLOORS
2-10 LOW
VOLTAGE PLAN

SHEET NUMBER

D-V 6.0

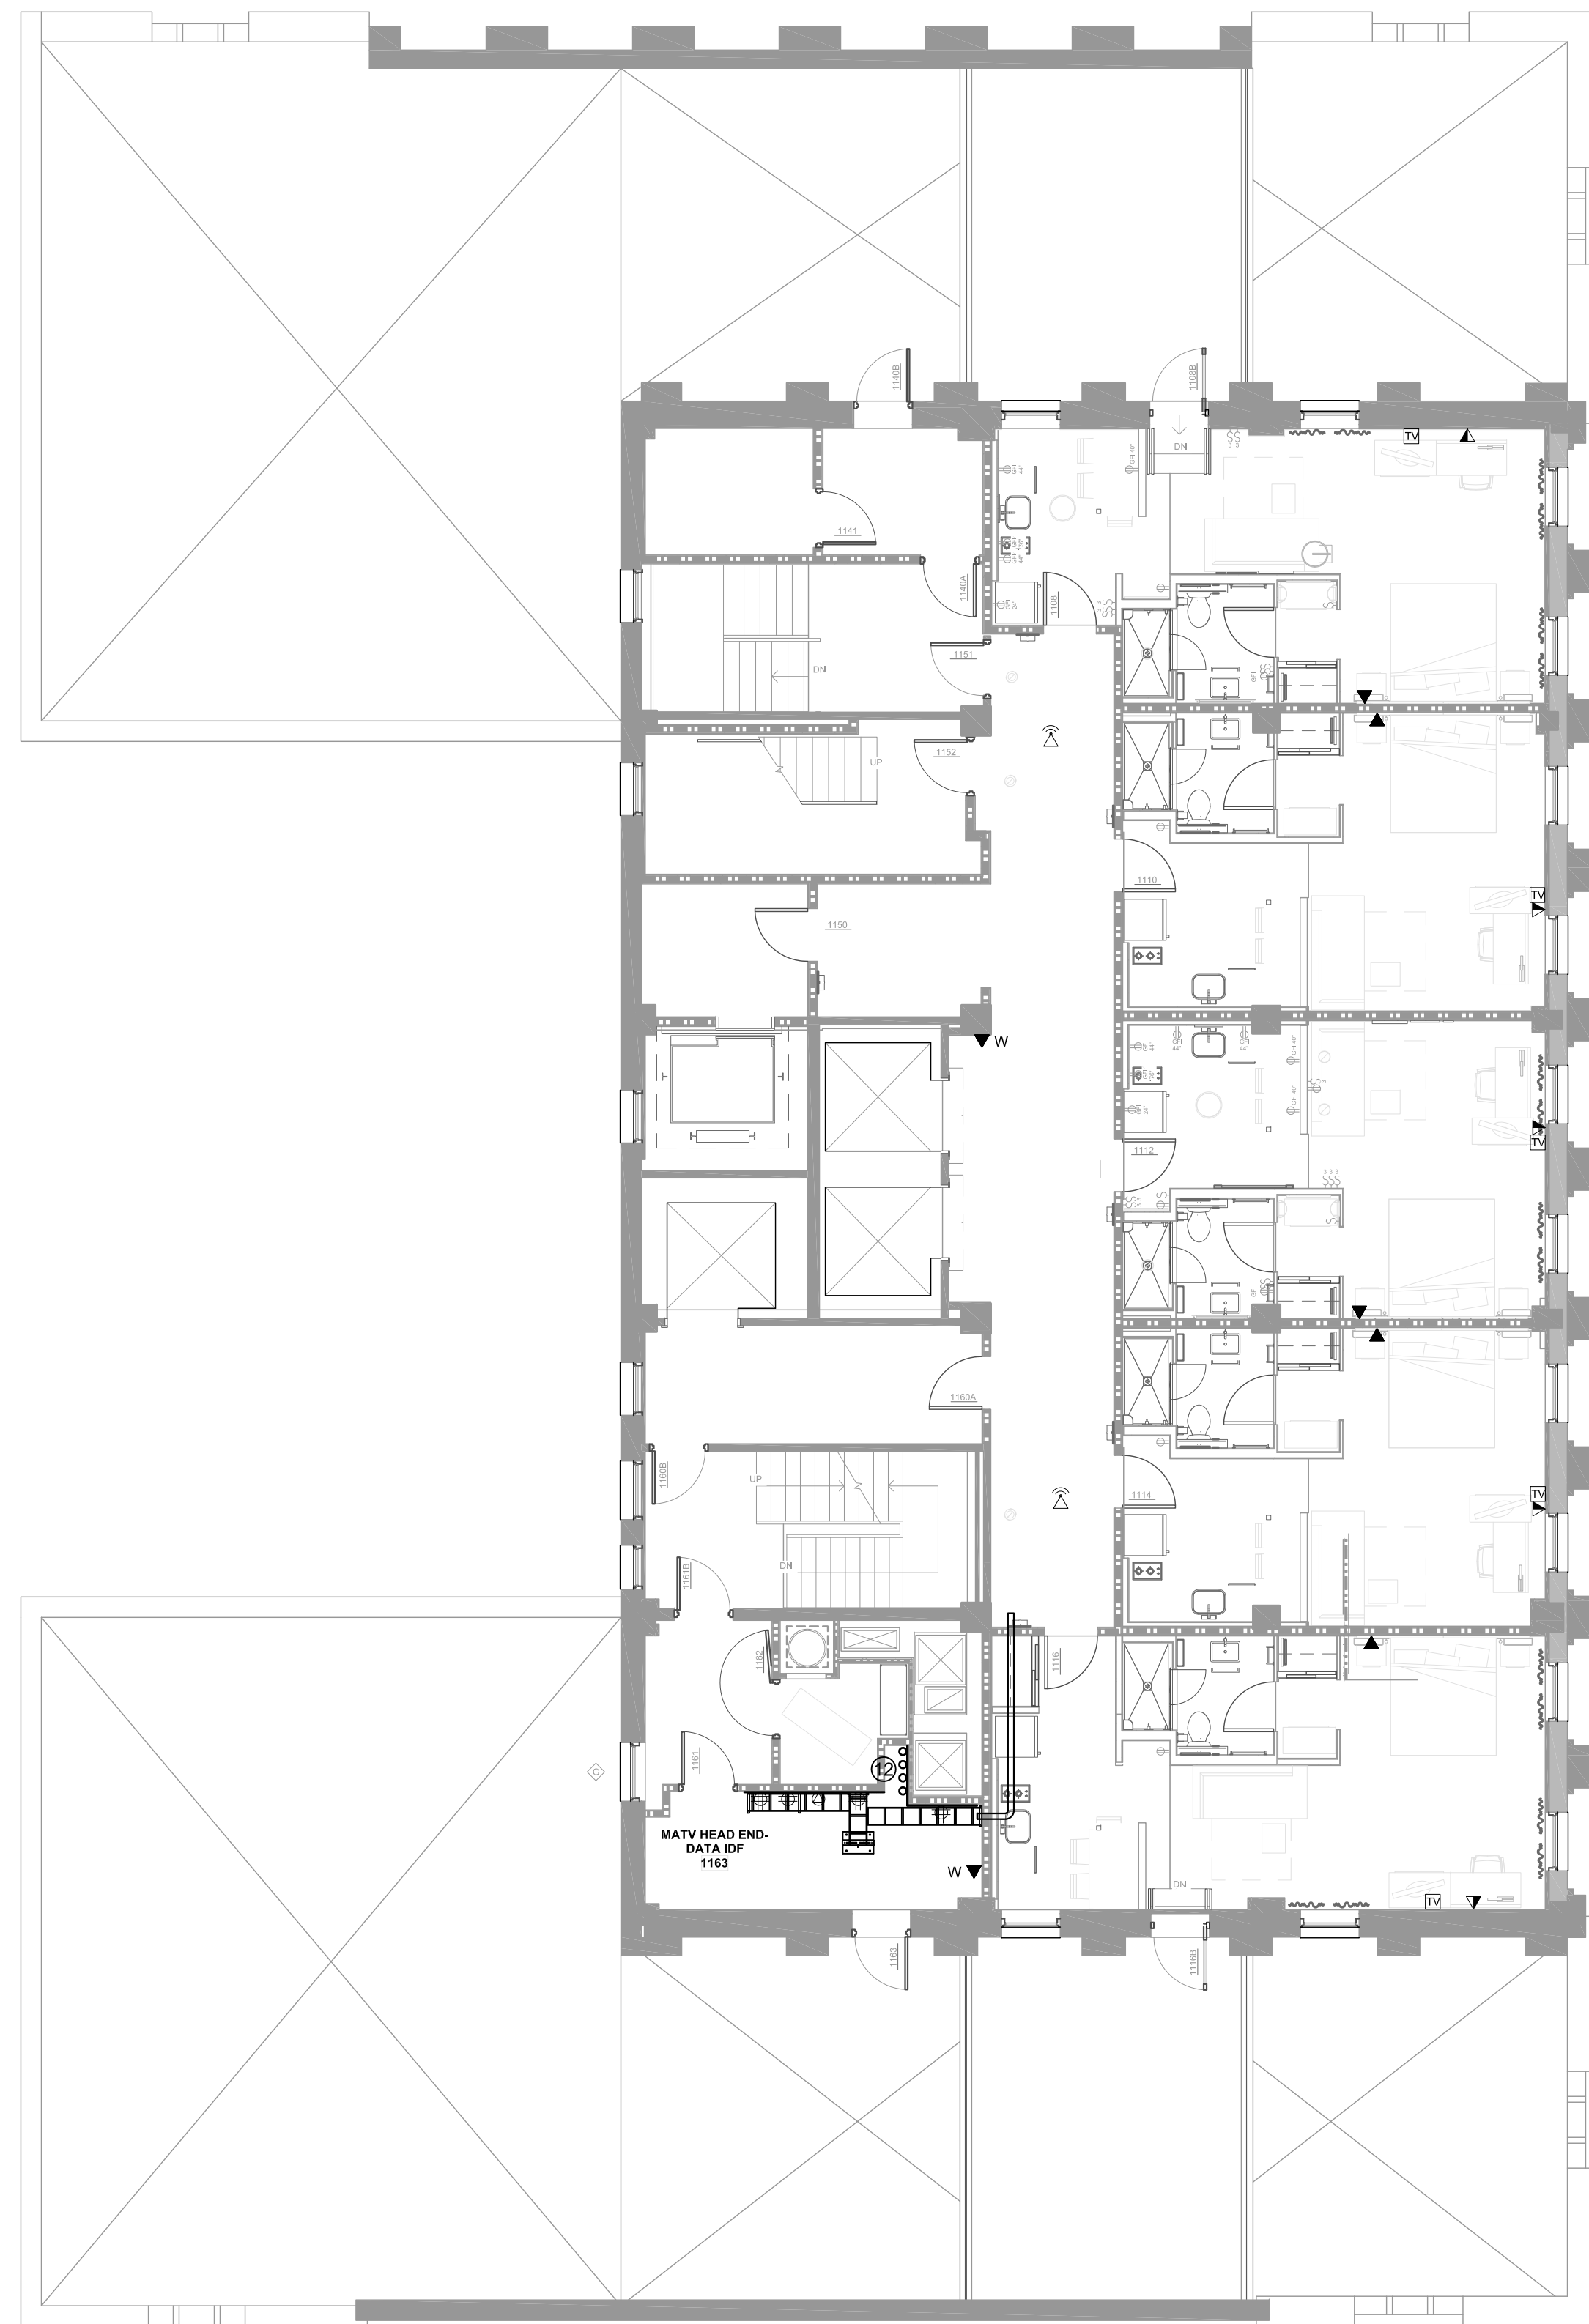

11TH FLOOR
SCALE: 1/8" = 1'

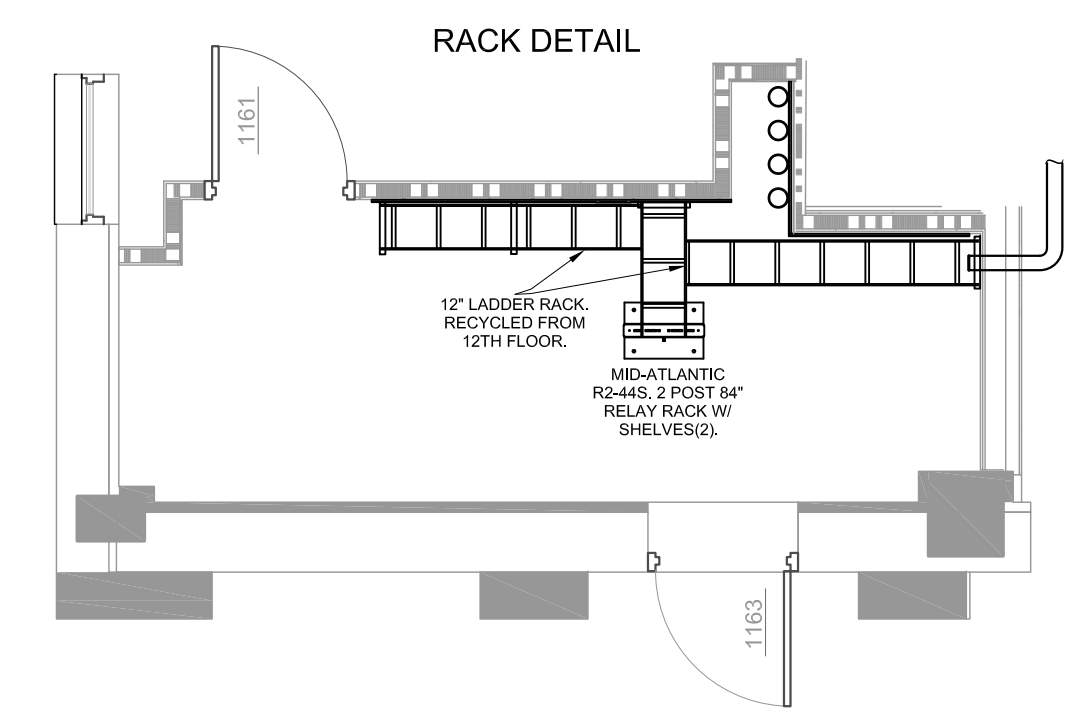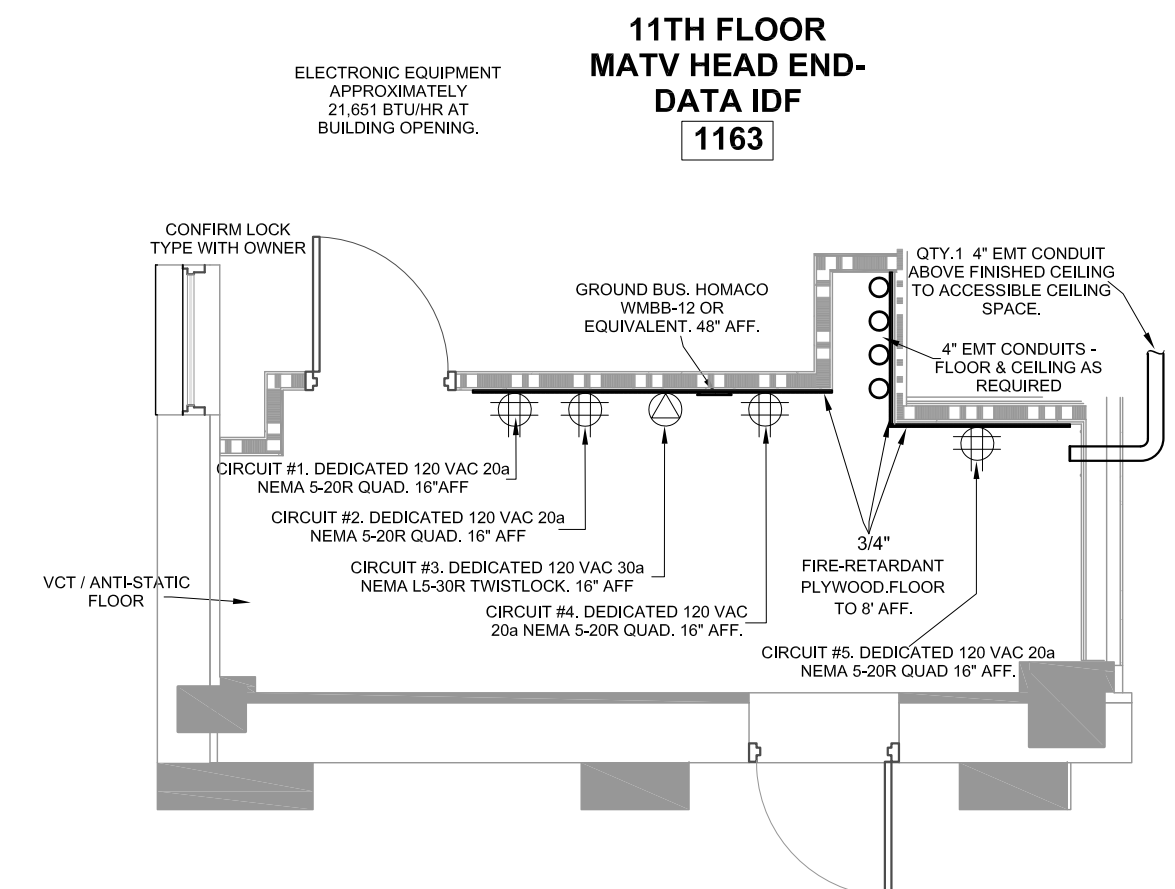

- LOW VOLTAGE LEGEND**
- TV TV
 - VOICE - PHONE
 - DATA
 - COMBINATION DATA-PHONE
 - DUAL COMB. DATA-PHONE
 - TRI-COMB. DATA-PHONE REQUIRES 1" CONDUIT FEED
 - W WALL PHONE, HEIGHT PER ADA COMPLIANCE
 - WIRELESS ACCESS POINT (P.O.E.) IN CEILING (TYPICAL)
 - S SPEAKER
 - VOLUME CONTROL
 - JUNCTION BOX SINGLE GANG 1900
 - JUNCTION BOX, 4" W/ 2" CONDUIT FEED, DOUBLE GANG
 - DUPLEX RECEPTACLE 5-20R
 - QUAD RECEPTACLE 5-20R
 - ISOLATED GROUND CIRCUIT & RECEPTACLE 5-20IGR
 - H CEILING HATCH
 - VIDEO SURVEILLANCE CAMERA
 - IN-FLOOR LOW VOLTAGE AND 120 VAC POWER
 - I INTERCOM
 - CR CARD READER
 - CCTV MONITOR

- LOW VOLTAGE KEYED NOTES**
- 1 INTERCOM MASTER
 - 2 INTERCOM REMOTE
 - 3 INTERCOM POWER, 24 VAC IN CEILING
 - 4 POTS LINES-ELEVATOR(S)
 - 5 POTS LINES-FIRE ALARM
 - 6 CARD READER
 - 7 IN-CEILING POWER AND J-BOX FOR PROJECTOR
 - 8 EMPLOYEE TIME CLOCK
 - 9 JACK-PACK MULTI MEDIA CONNECTOR
 - 10 DIGITAL SIGNAGE-MONITOR
 - 11 ATM / KIOSK
 - 12 NETWORK PRINTER
 - 13 LOW VOLTAGE SLEEVES CEILING / FLOOR
 - 14 POS TERMINAL
 - 15 POS PRINTER

For: **First OFB**
10275 W. Higgins Rd.
Ste. 300
Rosemont, IL 60018
847-299-9040

By: **A-tech Computer Service, Inc.**
296 Williams Pl.
East Dundee, IL 60118
847-428-9199
www.a-techinc.com

OFB RESIDENCE INN
OMAHA, NEBRASKA

SHEET AUTHOR
A-T
CHECKED BY
A-T
SCALE
1/8" = 1'
JOB NUMBER
031912-FHG-OM2


ISSUE DATE
6-12-12
ISSUE TITLE

ISSUED FOR CONSTRUCTION

REVISION SCHEDULE
6-19-12

SHEET NAME
11TH FLOOR
LOW VOLTAGE
PLAN

SHEET NUMBER
D-V 7.0

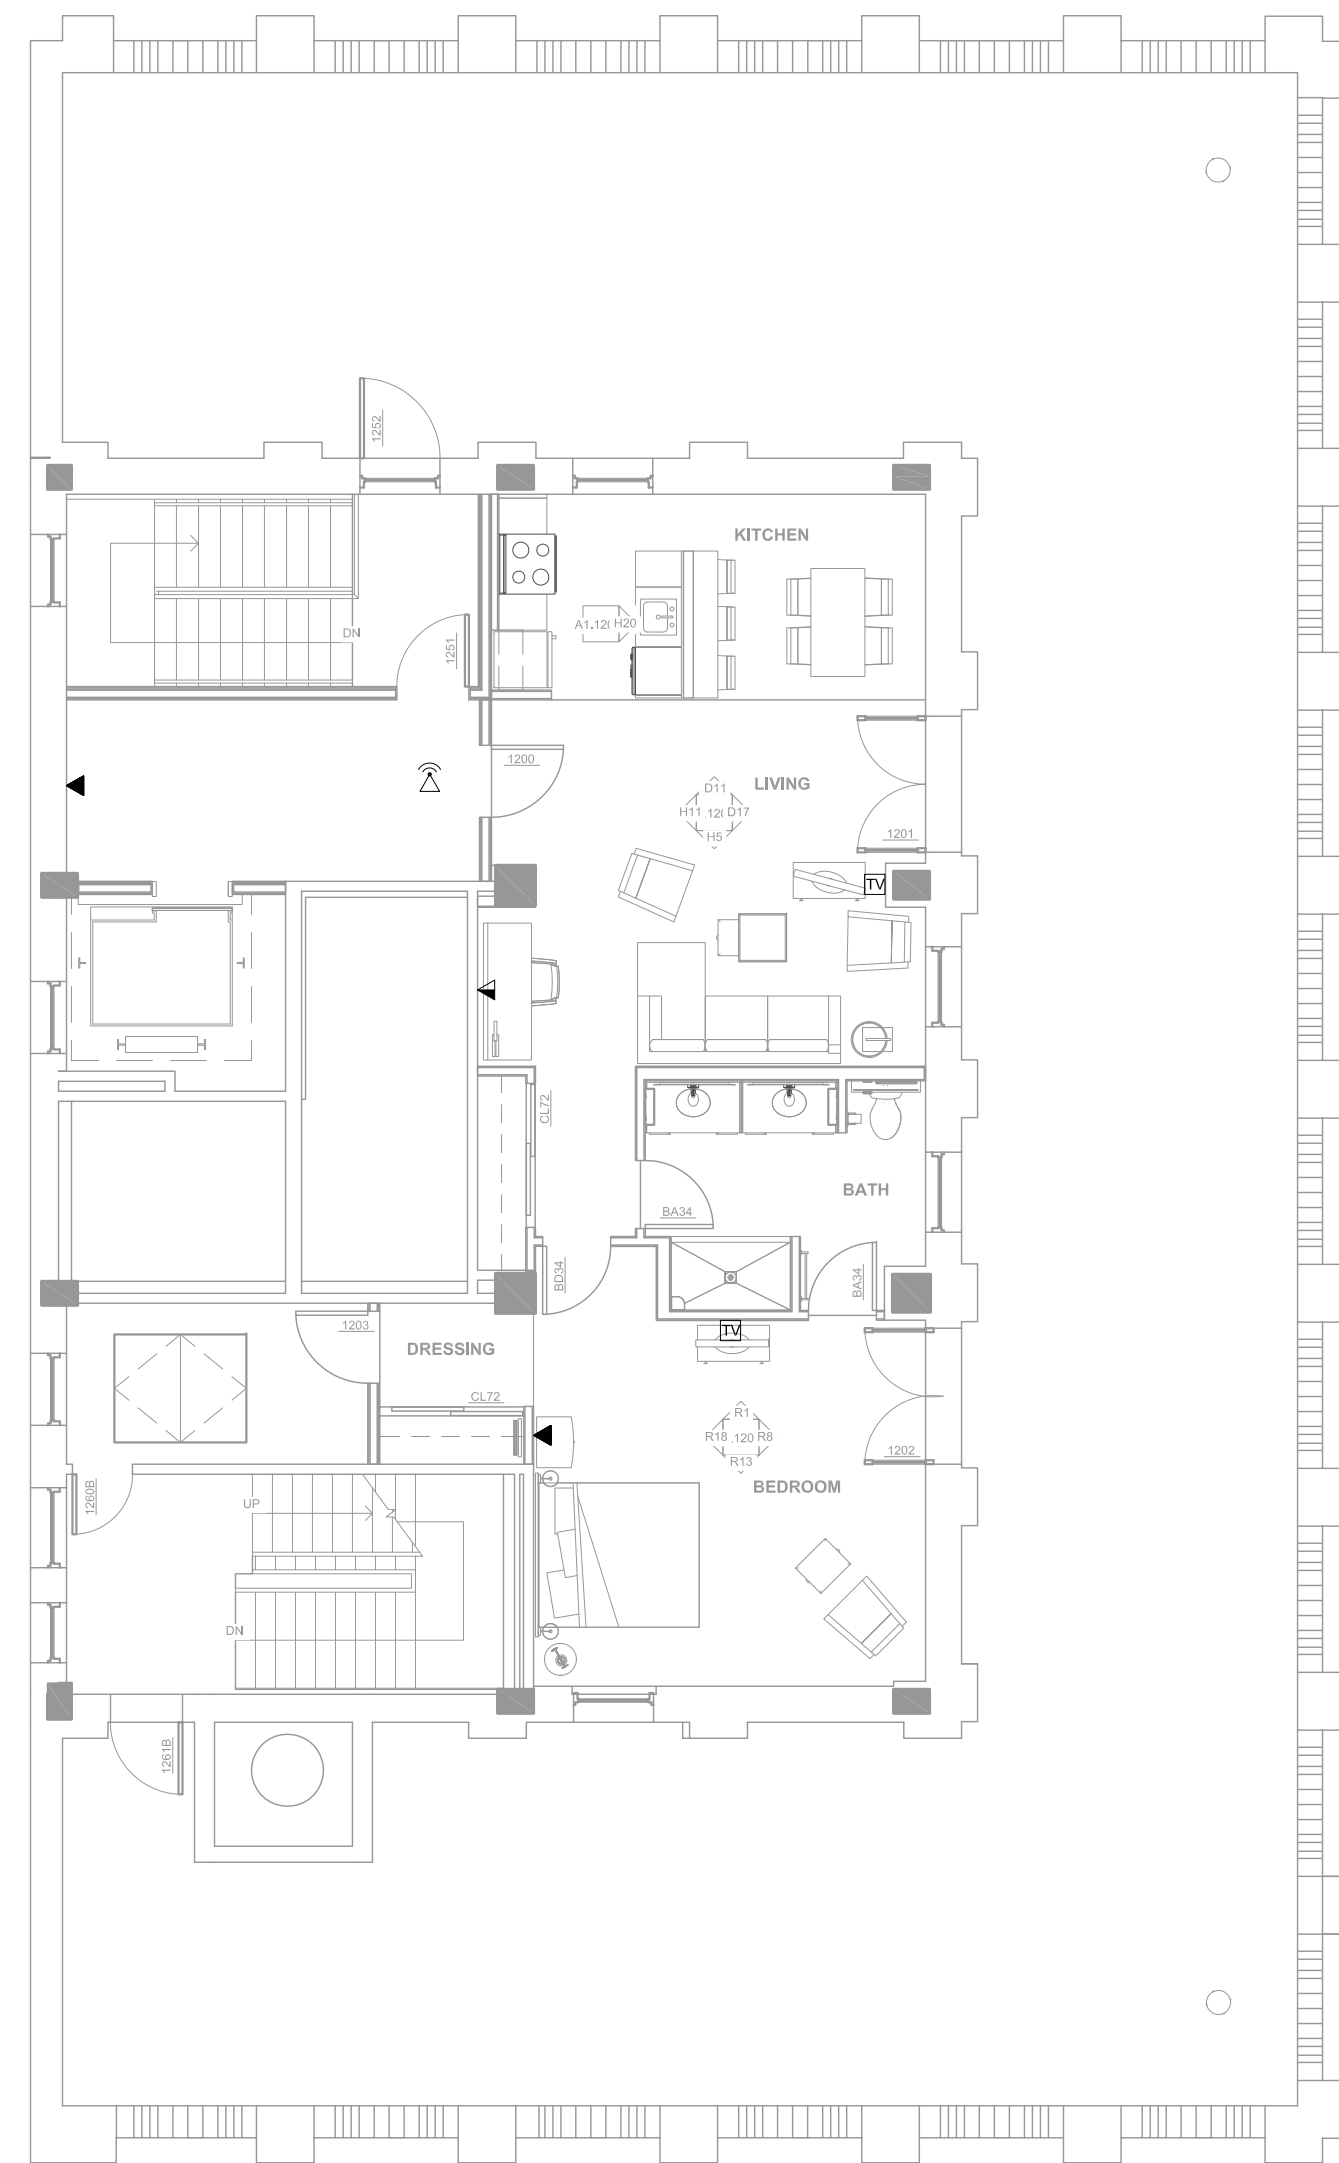

12TH FLOOR
SCALE: 1/8" = 1'



LOW VOLTAGE LEGEND

- TV TV
- VP VOICE - PHONE
- DATA DATA
- CDP COMBINATION DATA-PHONE
- DCDP DUAL COMB. DATA-PHONE
- TRCDP TRI-COMB. DATA-PHONE
REQUIRES 1" CONDUIT FEED
- W WALL PHONE, HEIGHT PER
ADA COMPLIANCE
- WAP WIRELESS ACCESS POINT (P.O.E.)
IN CEILING (TYPICAL)
- S SPEAKER
- VC VOLUME CONTROL
- JBS JUNCTION BOX SINGLE GANG 1900
- JBD JUNCTION BOX, 4" W/ 2" CONDUIT
FEED, DOUBLE GANG.
- DR DUPLEX RECEPTACLE 5-20R
- QR QUAD RECEPTACLE 5-20R
- IGR ISOLATED GROUND CIRCUIT
& RECEPTACLE 5-20IGR
- H CEILING HATCH
- VS VIDEO SURVEILLANCE CAMERA
- IFLV IN-FLOOR LOW VOLTAGE
AND 120 VAC POWER
- IC INTERCOM
- CR CARD READER
- CM CCTV MONITOR

LOW VOLTAGE KEYED NOTES

- 1 INTERCOM MASTER
- 2 INTERCOM REMOTE
- 3 INTERCOM POWER, 24 VAC
IN CEILING
- 4 POTS LINES-ELEVATOR(S)
- 5 POTS LINES-FIRE ALARM
- 6 CARD READER
- 7 IN-CEILING POWER AND
J-BOX FOR PROJECTOR
- 8 EMPLOYEE TIME CLOCK
- 9 JACK-PACK MULTI MEDIA
CONNECTOR
- 10 DIGITAL SIGNAGE-MONITOR
- 11 ATM / KIOSK
- 12 NETWORK PRINTER
- 13 LOW VOLTAGE SLEEVES
CEILING / FLOOR
- 14 POS TERMINAL
- 15 POS PRINTER

For:
First OFB
10275 W. Higgins Rd.
Ste. 300
Rosemont, IL 60018
847-299-9040

By:
**A-Tech Computer
Service, Inc.**
296 Williams Pl.
East Dundee, IL 60118
847-428-9199
www.a-techinc.com

OFB RESIDENCE INN
OMAHA, NEBRASKA

SHEET AUTHOR
A-T
CHECKED BY
A-T
SCALE
1/8" = 1'
JOB NUMBER
031912-FHG-OM2

ISSUE DATE
6-12-12
ISSUE TITLE

ISSUED FOR CONSTRUCTION

REVISION SCHEDULE
6-19-12

SHEET NAME

12TH FLOOR
LOW VOLTAGE
PLAN

SHEET NUMBER

D-V 8.0