



ARCHITECTURE • ENGINEERING • INTERIOR DESIGN

ADDENDUM

PROJECT: Palmer Public Schools
Classroom Additions 2014
Palmer, Nebraska

ADDENDUM NUMBER

AD-2

ISSUED BY:

Leroy Svatora, Architect
Jon Dalton, Electrical Engineer
Bryce Johnson, Mechanical Engineer

PROJECT #: 14-0256

DATE ISSUED: Tuesday, January 13, 2015

This addendum is issued by the Architect to all known bidders before receipt of proposals, for the purpose of explaining, interpreting, or modifying the original plans and specifications. When enumerated by the bidder upon the proposal sheet, the information or instructions given hereon will be equally binding upon all parties as if included in the original plans and specifications.
BIDDER MUST ENTER THE NUMBER OF THIS ADDENDUM ON HIS PROPOSAL SHEET

THE FOLLOWING ITEMS ARE APPLICABLE TO THE "REQUEST FOR PROPOSAL" DOCUMENT:

AD-2, ITEM 1:

In reference to Article 4, Subparagraph D, add sentence reading "Construction Manager shall advise if they believe this project can be completed within this budget and, if not, provide a range of \$25,000 that they believe the project can be constructed."

AD-2, ITEM 2:

In reference to Article 6, revise the reference reading "section 3B of the policy" to read "section 7 below."

AD-2, ITEM 3:

In reference to Article 7, revise to read "PROPOSAL REQUIREMENTS. The proposal shall include the following (*with weighted points up to 150 indicated*):

AD-2, ITEM 4:

In reference to Article 7, make the following changes:

Sub-paragraph A, revise to read "The financial resources of the CM to complete the project (~~up to 10%~~ **10 points**)."

Sub-paragraph B, revise to read "The ability of the proposed personnel of the CM to perform (~~up to 30%~~ **25 points**)."

Sub-paragraph C, revise to read "The character, integrity, reputation, judgment, experience, and efficiency of the CM (~~up to 30%~~ **30 points**)."

Sub-paragraph D, revise to read "The quality of performance on previous projects (~~up to 30%~~ **25 points**)."

Sub-paragraph E, revise to read "The ability of the CM to perform within the time specified (~~up to 30%~~ **30 points**)."

Sub-paragraph F, revise to read "The previous and existing compliance of the CM with laws relating to the contract (~~up to 10%~~ **10 points**)."

Sub-paragraph G, revise to read "Such other information as may be secured having a bearing on the selection (~~up to 20~~ **20 points**)."

THE FOLLOWING ITEMS ARE APPLICABLE TO THE SPECIFICATIONS:

AD-2, ITEM 5:

In reference to Section 042000 - Unit Masonry, Page 042000-2, under Article 2.2, Paragraph B, Sub-paragraph 1, add sub-subparagraph b reading as follows:

b. "Approved Brick:

- (1) Cloud Ceramics, "Cameo Blend."
- (2) Size: Modular.
- (3) Texture: Shadotex.
- (4) Color: Final color blend is to be determined.

AD-2, ITEM 6:

In reference to Section 083613 - Sectional Doors, Page 083613-3, under Article 2.2, add Paragraph D reading as follows:

- D. Windows: Manufacturer's standard insulated tempered glass window units (approximately 24" x 6"); two each total at approximately 1/3 points in 3rd panel from bottom.

THE FOLLOWING ITEMS ARE APPLICABLE TO THE DRAWINGS:

AD-2, ITEM 7:

In reference to Sheet A-101, Area A Demolition Plan, add note reading as follows:

Remove existing signs attached to exterior wall and re-install in similar positions on walls of new additions.

AD-2, ITEM 8:

In reference to Sheet A-102, Area A Floor Plan, delete Fire Service Room 108. Re-locate Janitor's Closet 109 to other side of corridor, replacing one single toilet. See attached Supplemental Drawing A-102.1.

AD-2, ITEM 9:

In reference to Sheet A-102, Area A Floor Plan, handi-cap signs noted at concrete parking slab between each addition are existing ADA signs / posts to be re-located.

AD-2, ITEM 10:

In reference to Sheet A-102, Area A Floor Plan, vehicle stop noted at concrete parking slab between each addition are to be standard precast concrete curb stops with dowels pinning them into place on the concrete slab.

AD-2, ITEM 11:

In reference to Sheet A-102, Area A Floor Plan Floor Plan, provide a 12' x 4' marker board and 6' x 4' tack board (refer to Section 101100 "Visual Display Units") in Classrooms 103, 104, 107, and 110. Location to be decided.

AD-2, ITEM 12:

In reference to Sheet A-102, Area A Floor Plan, revise Corridor 102 layout to allow for future recessed student lockers. See attached Supplemental Drawing A-102.2.

AD-2, ITEM 13:

In reference to Sheet A-102, Area B Floor Plan, provide 2-hour separation between Shop 127 and adjacent Rooms 121, 122, 123, 124, 125, and 126. Provide 2-hour shaft wall construction (Wall Type 7) on north side of existing east / west wall and laminate one additional layer of 1/2" Type X gypsum board on each side of existing wall between Shop 127 and Corridor 126. See attached Partition Type Schedule.

AD-2, ITEM 14:

In reference to Sheet A-102, Area B Floor Plan, provide 8' (H) by 1/2" a/c plywood wainscot on west, north, and east walls that were formerly gypsum board Music Room walls.

AD-2, ITEM 15:

In reference to Sheet A-102, Partial Floor Plans and associated specification Section 312000 "Earth Moving", suitable soils spoils from excavations are intended to be used as needed to provide positive drainage at the perimeter of the new additions prior to disposal of excess material off site.

AD-2, ITEM 16:

In reference to Sheet A-202, Interior Elevations, add Elevation No. 7 for casework in Classroom 103. See attached Supplemental Drawing A-202.1.

AD-2, ITEM 17:

In reference to Sheet A-601, add the attached Door Hardware Schedule.

AD-2, ITEM 18:

In reference to Sheet A-601, add the attached Supplemental Drawing A-601.1 showing the Room Finish Schedule.

AD-2, ITEM 19:

In reference to Sheet A-601, add the attached Supplemental Drawing A-601.2 showing the Partition Type Schedule.

AD-2, ITEM 20:

In reference to Sheet A-601, add note reading as follows:

A floor finish layout plan will be provided indicating the use of salvaged carpet tiles in the Music Room area. For bidding purposes, assume 80% of the existing carpet tile can be re-used and supplemented with new.

AD-2, ITEM 21:

In reference to Sheet A-601, existing door opening to Corridor 126 from Shop 127, provide new 3'-0" by 7'-0", 1-1/2 hour, Type A door (with 100 square inches of vision panel) into existing B-label door frame. Reference new door as 127B.

AD-2, ITEM 22:

In reference to Sheet A-601, Door and Frame Schedule, delete 20 minute rating on Doors 103, 104, 107, 109, 110, and 111.

AD-2, ITEM 23:

In reference to Sheet A-601, Door and Frame Schedule, delete Doors 108 and 112.

AD-2, ITEM 24:

In reference to Sheet F-100, Fire Sprinkler Plan, Legend & Notes. Per a discussion with the State Fire Marshal on January 8, 2015 the preliminary finding is that a fire sprinkler system is not required in the Shop area. Delete this scope of work from the Proposal.

AD-2, ITEM 25:

In reference to Sheet C-101, Utility Plan. Add General Note 2 to read: "CONTRACTOR SHALL INCLUDE PROVISIONS FOR A NEW SEWER MANHOLE TO BE INSTALLED SOUTH OF THE EXISTING MANHOLE AND NEW SANITARY SEWER PIPING ROUTED FROM THE EXISTING MANHOLE TO THE NEW MANHOLE AND NEW PIPING FROM THE NEW MANHOLE TO TIE BACK INTO THE EXISTING PIPING AT A LOCATION SOUTH OF THE NEW ADDITION."

AD-2, ITEM 26:

In reference to Sheet C-101, Utility Plan. Add General Note 3 to read: "CONTRACTOR SHALL USE SUITABLE SOILS SPOILS FROM EXCAVATIONS AS NEEDED TO PROVIDE POSITIVE DRAINAGE AT THE PERIMETER OF THE NEW ADDITIONS, PARTICULARLY FOR THE NORTH ADDITION, PRIOR TO DISPOSAL OF EXCESS MATERIAL OFF SITE."

AD-2, ITEM 27:

In reference to Sheet C-101, Utility Plan. Delete Keyed note 3. Fire Sprinkler Service will not be required for the RFP. See item above in reference to Sheet F-100.

AD-2, ITEM 28:

In reference to Sheet P-102, Plumbing Plans. Delete the floor drain and associated waste and vent piping shown in Fire Service 108, and delete all plumbing from one toilet room not being constructed. Plumbing for Janitor's closet will be in room adjacent to remaining toilet.

AD-2, ITEM 29:

In reference to Sheet E-101A, two existing lighting fixtures under south entrance canopies should have keyed note 2 deleted and keyed relocation reference R2 changed to R. Fixture shall be removed and turned over to the owner. Existing fixture on east side of east classroom wing, with an E designation shall be changed to an R1 designation. This fixture will be relocated.

AD-2, ITEM 30:

In reference to Sheet E-101B, Existing exterior fixture above overhead door into shop are shall have designation changed from E to R and fixture shown above door on north wall of existing music room shall be changed from R3 to R. Fixtures will be removed and turned over to the owner.

AD-2, ITEM 31:

In reference to Sheet E-101B, Keyed note 6 shall be changed to read "SMART SCREEN EQUIPMENT WILL BE DISCONNECTED, DE-MOUNTED, AND STORED FOR REMOUNTING IN NEW MUSIC ROOM BY OWNER. SEE SHEET E-103B FOR MORE INFORMATION."

AD-2, ITEM 32:

In reference to Sheet E-102A, One of the two toilets will not be constructed as shown. The janitor's closet will be constructed next to the new toilet on the other side of the corridor. The Fire Service room will not be constructed. Eliminate the lights and switches, and associated conduit and wire for one toilet and the Fire Service room from the scope. The fixture to be relocated and re-installed on the west side of the new west classroom addition shall be existing fixture E1, not E2. The fixture shown to be relocated and re-installed on the east side of the new east classroom addition shall be changed to a new Type W1 fixture. The existing fixture north of the new fixture shown on the east wall of the east classroom wing shall be a new Type W1 fixture. The existing fixture located above the egress doors on the east side of the east addition shall be replaced with a new Type W1 fixture.

AD-2, ITEM 33:

In reference to Sheet E-102B, the fixture shown above the overhead door into the shop area shall be changed from an existing fixture to a new Type W1 fixture. The fixture shown as a relocated E3 fixture above the door located in the northeast corner of the music room shall be changed to a new Type W1 fixture. A new Type W1 fixture shall be installed above the existing door that will be an egress door from the expanded shop. All three Type W1 fixtures shall be connected to the existing circuit currently connected to the existing fixture located above the overhead door.

AD-2, ITEM 34:

In reference to Sheet E-103A, One of the two toilets will not be constructed as shown. The janitor's closet will be constructed next to the new toilet on the other side of the corridor. The Fire Service Room will not be constructed. Eliminate the receptacles from the rooms not constructed. Water heater will be installed in the janitor's closet. Revise keyed note 1 to read "PROVIDE NEW BREAKER IN PANELBOARD SHOWN AND ROUTE NEC COMPLIANT CONDUCTORS AND 3/4" CONDUIT FOR HOMERUN. PROVIDE BREAKERS AS SHOWN ON PANEL SCHEDULES ON SHEET E-601 FOR RESPECTIVE LOADS.

AD-2, ITEM 35:

In reference to Sheet E-103A, under narrative for CLOCK/BELL SYSTEM, Delete the 6th sentence in the narrative and add the following: "CONTRACTOR SHALL INCORPORATE A NEW BELL IN THE SHOP AREA AND CONNECT TO THE NEAREST EXISTING BELL, MATCHING EXISTING WIRING."

AD-2, ITEM 36:

In reference to **Sheet E-103A**, under narrative for FIRE ALARM SYSTEM, revise the first sentence to read: "THE EXISTING FIRE ALARM SYSTEM IS A NOTIFIER 5000, CONVENTIONAL FIRE ALARM SYSTEM." Note that a new strobe is required in the new toilet on the east classroom wing addition and that all relocated and new devices shall be installed in compliance with current ADA Guidelines.

AD-2, ITEM 37:

In reference to **Sheet E-103B**, revised keyed note 4 to read "COORDINATE THE CONNECTION OF THE EXISTING SMART BOARD/SHORT-THROUGH PROJECTOR, RELOCATED AND REMOUNTED BY THE OWNER."


AD-2, ITEM 38:

In reference to **Sheet E-103B**, add the following to keyed note 5 "TIE IN 120 VOLT CIRCUIT FROM ROOM 125 RECEPTACLE TO RECEPTACLE IN RELOCATED CONDENSING UNIT DISCONNECT SWITCH."

AD-2, ITEM 39:

In reference to **Sheet E-601**, on the LIGHTING FIXTURE SCHEDULE, under fixture type W1, revise the specification number to read "LUMARK #XTOR5A-N-CBP", which is for a cold temperature battery to make the fixture an emergency egress fixture.

END AD-2

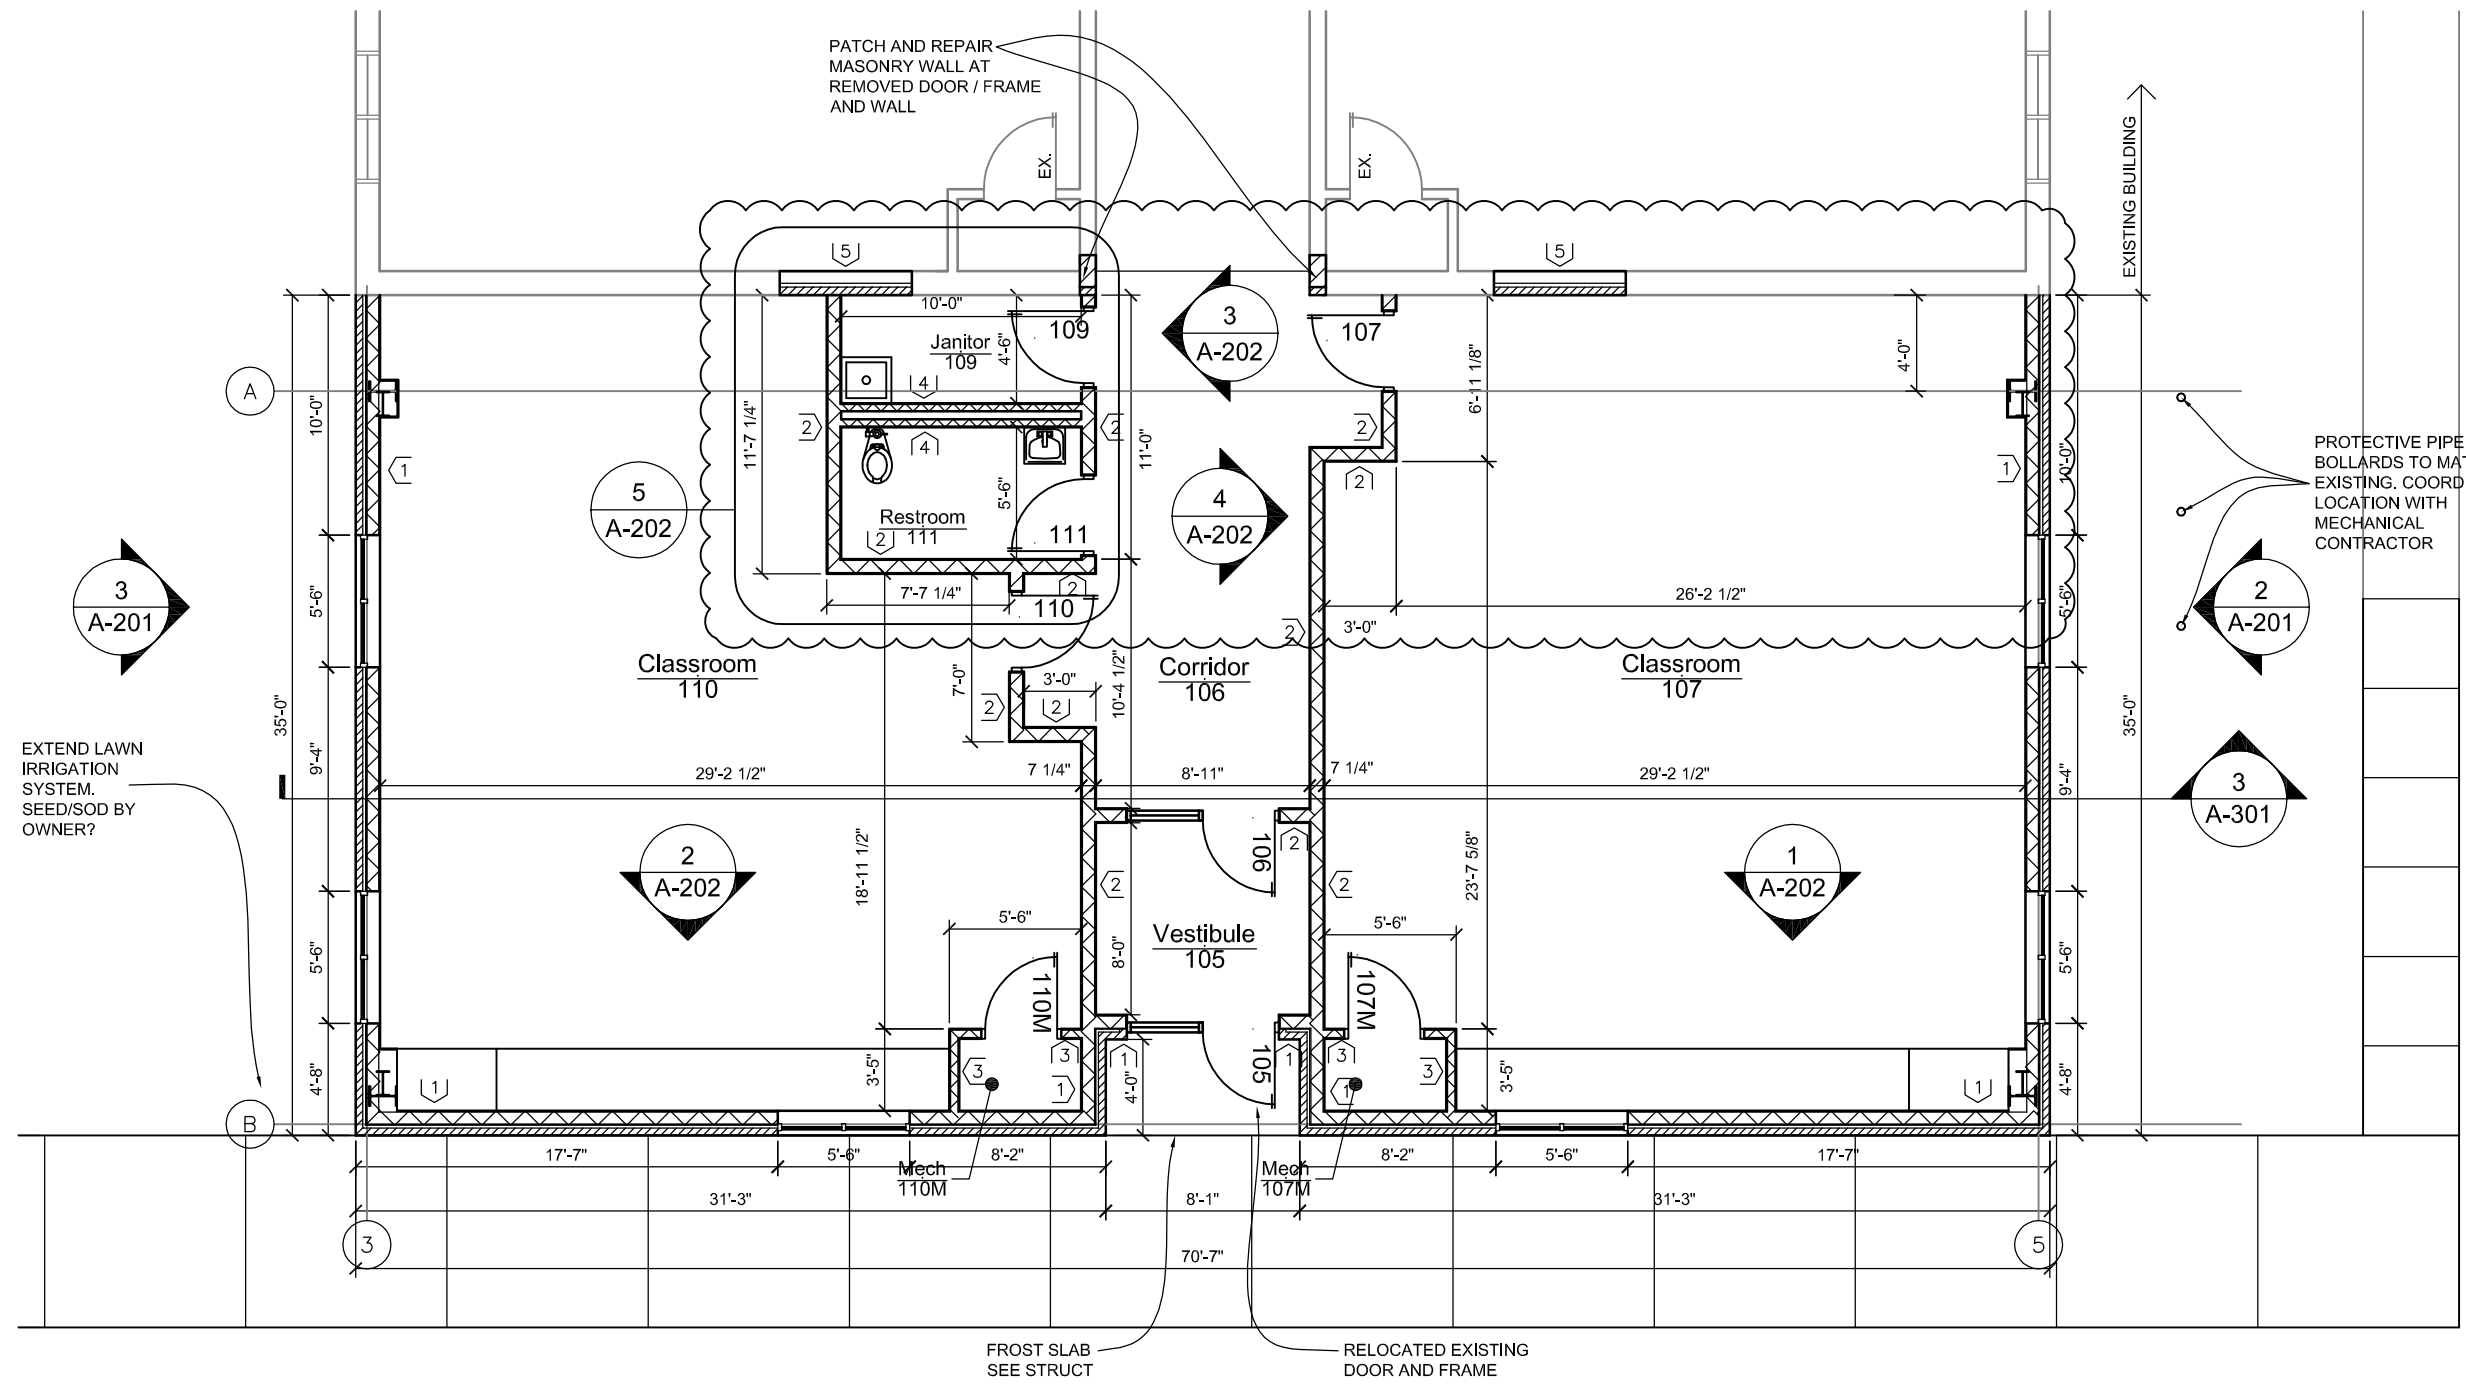


1

Area 'A' Floor Plan

Scale: 1/8" = 1'-0"

Lincoln
 1221 N Street, Suite 600
 Lincoln, NE 68508
 Phone 402-476-9700
 Fax 402-476-9722

Vermillion
 15 East Main, Suite 201
 Vermillion, SD 57069
 Phone 605-624-1081

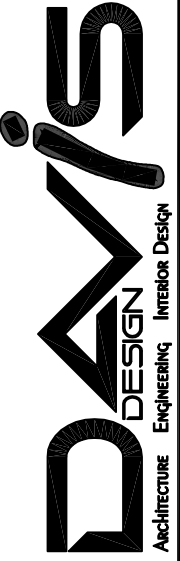

Preliminary
 not for
 Construction


Client Information
Palmer Public Schools
 202 Commercial St.
 Palmer, NE 68864

Project Information
Classroom Addition

Issue Date	01-13-2015
Job #	14-0256
Drawn by:	ktr
CADD file:	A-102
COPYRIGHT © DAVIS DESIGN ALL RIGHTS RESERVED	

Drawing Title
 Partial Floor Plan

From Sheet:	A-102	for CA use:
Drawing #	A-102.1	

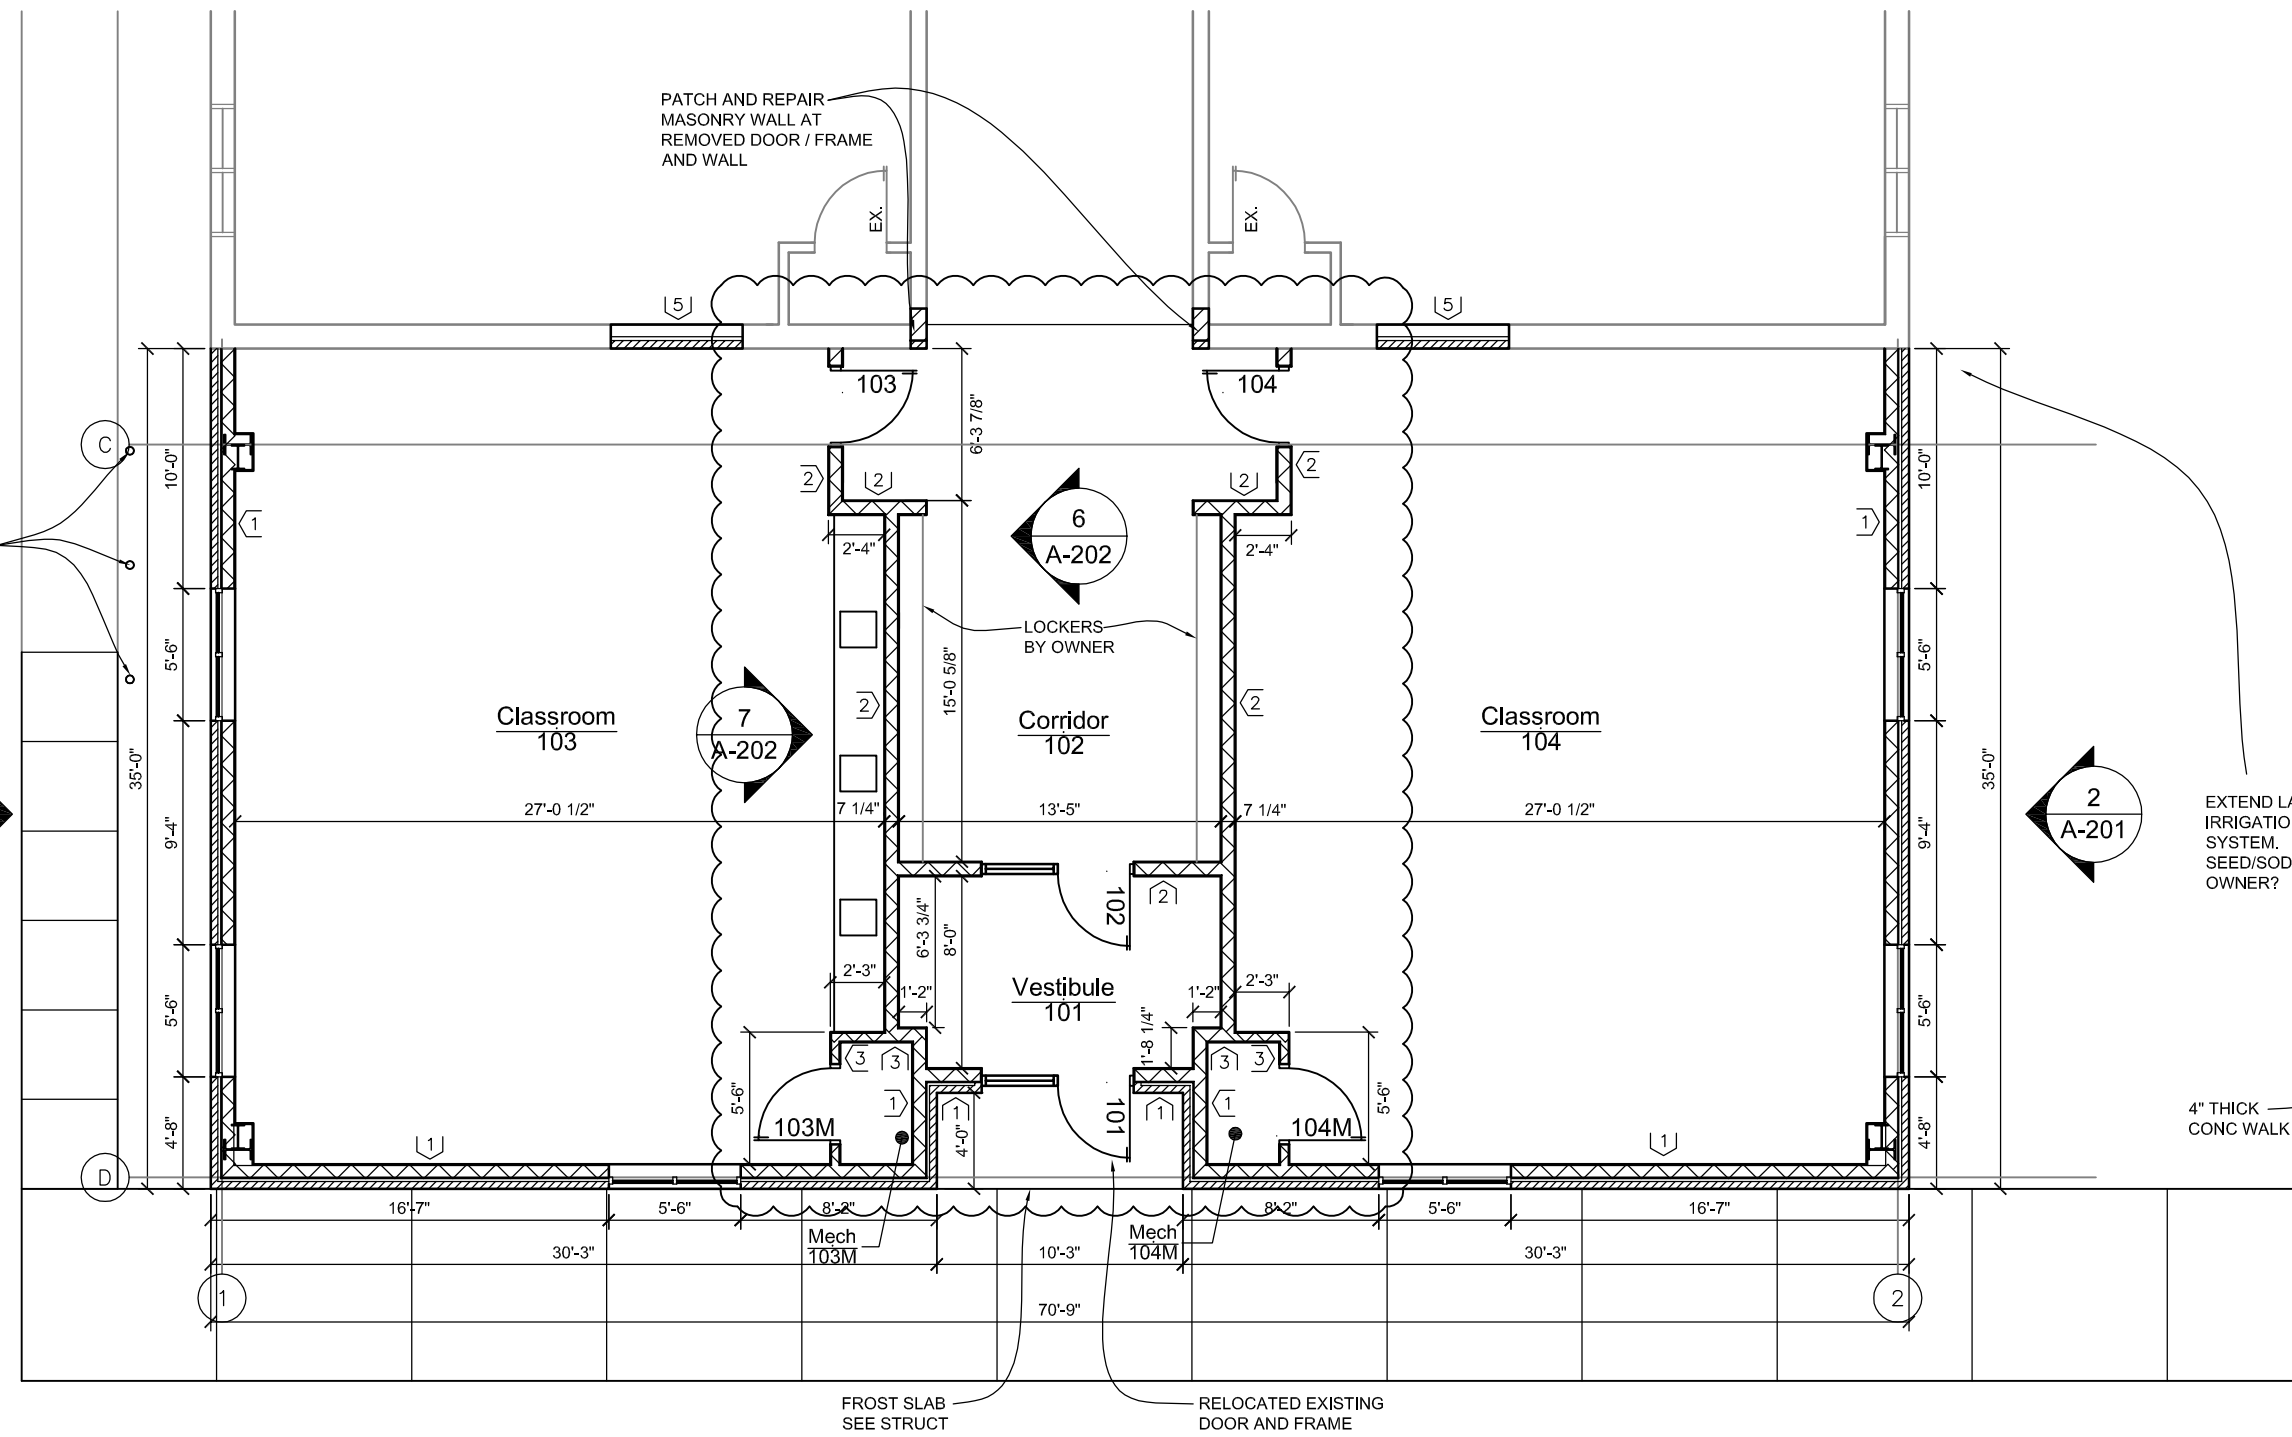


PROTECTIVE PIPE BOLLARDS TO MATCH EXISTING. COORDINATE LOCATION WITH MECHANICAL CONTRACTOR

PATCH AND REPAIR MASONRY WALL AT REMOVED DOOR / FRAME AND WALL

EXTEND LAWN IRRIGATION SYSTEM. SEED/SOD BY OWNER?

4" THICK CONC WALK

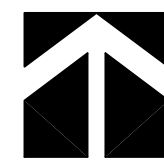


1

Area 'A' Floor Plan

Scale: 1/8" = 1'-0"

Lincoln
1221 N Street, Suite 600
Lincoln, NE 68508
Phone 402-476-9700
Fax 402-476-9722

Vermillion
15 East Main, Suite 201
Vermillion, SD 57069
Phone 605-624-1081

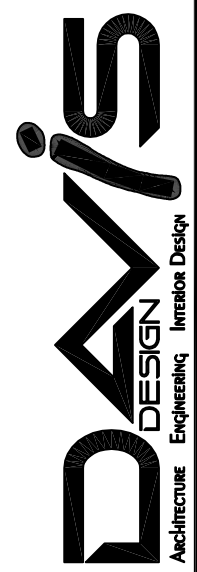

Preliminary
not for
Construction


Client Information
Palmer Public Schools
202 Commercial St.
Palmer, NE 68864

Project Information
Classroom Addition

Issue Date	01-13-2015
Job #	14-0256
Drawn by:	ktr
CADD file:	A-102
COPYRIGHT © DAVIS DESIGN ALL RIGHTS RESERVED	

Drawing Title
Partial Floor Plan

From Sheet:	A-102	for CA use:
Drawing #	A-102.1	

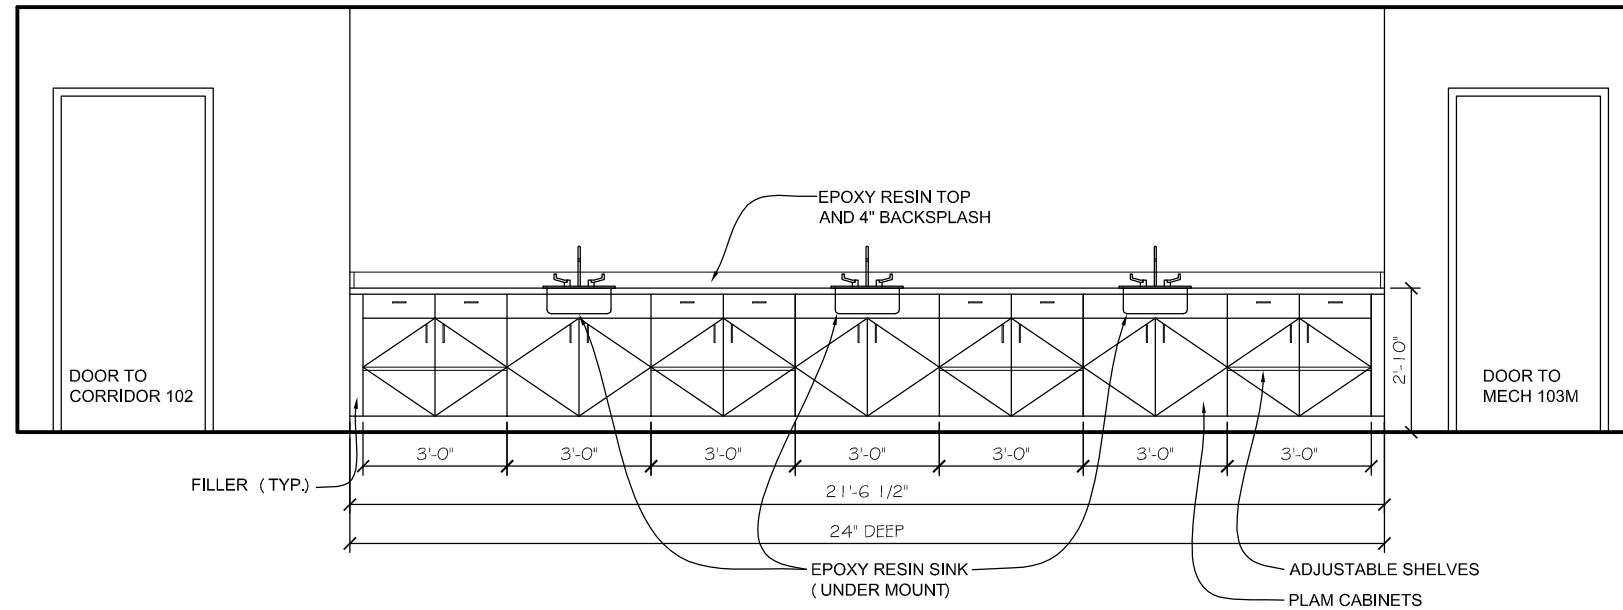

7 Classroom 103 Elevation
 Scale: 1/4" = 1'-0"

Lincoln
 1221 N Street, Suite 600
 Lincoln, NE 68508
 Phone 402-476-9700
 Fax 402-476-9722

Vermillion
 15 East Main, Suite 201
 Vermillion, SD 57069
 Phone 605-624-1081



Preliminary
 not for
 Construction

Client Information
Palmer Public Schools
 202 Commercial St.
 Palmer, NE 68864

Project Information
Classroom Addition

Issue Date	01-13-2015
Job #	14-0256
Drawn by:	ktr
CADD file:	A-202
COPYRIGHT © DAVIS DESIGN ALL RIGHTS RESERVED	

Drawing Title
 Classroom 103 Elevation

From Sheet: A-202	for CA use:
Drawing # A-202.1	

**PALMER PUBLIC SCHOOLS
CLASSROOM ADDITIONS - 2014
PALMER, NEBRASKA**

DOOR HARDWARE SCHEDULE

MK - McKinney
PE - Pemko
YA - Yale
SA - Sargent
RO - Rockwood
NO - Norton

Set: 1.0

Doors 101, 105, 120, and 126:

Notes: Door, frame, and hardware to be relocated.

Set: 2.0

Doors 102 and 106:

1 Continuous Hinge	CFM83SLF-HD1		PE
1 Door Pull	BF150	US32D	RO
1 Push Bar	47	US32D	RO
1 Drop Plate	7788	689	NO
1 Door Closer	CPS7500T	689	NO
1 Blade Stop	6891	689	NO
1 Weatherstripping	By aluminum frame supplier		

Set: 3.0

Door 127C:

1 Rim Exit Device (Cyl. Dog,Ext. Pull)	16 8804 PSB	US32D	SA
2 Cylinder	To Match Owner's existing system	US32D	SA

Notes: Existing door, frame, and hardware to remain unless specified as new above. Verify specified pull will cover existing lock prep.

Set: 4.0

Doors 103M, 104M, 107M, 109, and 110M:

3 Hinge	TA2714 NRP 4-1/2" x 4-1/2"	US4	MK
1 Cylindrical Lock (Storeroom)	AU 5405LN	606	YA
1 Door Closer	PR7500	696	NO
1 Kick Plate	K1050 10" x 2" LDW CSK 4BE	US4	RO

**PALMER PUBLIC SCHOOLS
CLASSROOM ADDITIONS - 2014
PALMER, NEBRASKA**

1 Wall Stop	409	US4	RO
1 Gasketing	S88D		PE

Set: 5.0

Door 125:

3 Hinge	TA2714 NRP 4-1/2" x 4-1/2"	US4	MK
1 Cylindrical Lock (Storeroom)	AU 5405LN	606	YA
1 Door Closer	PR7500	696	NO
1 Kick Plate	K1050 10" x 2" LDW CSK 4BE	US4	RO
1 Wall Stop	409	US4	RO
1 Gasketing	S88D		PE

Set: 6.0

Door 111:

3 Hinge	TA2714 4-1/2" x 4-1/2"	US4	MK
1 Cylindrical Lock (Keyed Privacy)	AU 5406LN	606	YA
1 Door Closer	PR7500	696	NO
1 Kick Plate	K1050 10" x 2" LDW CSK 4BE	US4	RO
1 Wall Stop	409	US4	RO
1 Gasketing	S88D		PE

Set: 7.0

Doors 103, 104, 107, 110, 121, 122, 123, AND 124:

3 Hinge	TA2714 4-1/2" x 4-1/2"	US4	MK
1 Cylindrical Lock (Classroom)	AU 5408LN	606	YA
1 Wall Stop	409	US4	RO

Set: 8.0

Door 127A:

Notes: All hardware by door supplier.

Set: 9.0

Door 127B:

Notes: Provide new rated door; existing rated frame and hardware to remain. Verify required prep required for existing hardware prior to ordering door.

END OF DOOR HARDWARE SCHEDULE

Room Finish Schedule

ROOM DESIGNATIONS		FLOOR	BASE	WALL MAT'L / FINISH				CEILING		REMARKS	RM. #
RM. #	ROOM NAME	MATERIAL / FINISH	MAT'L	NORTH	EAST	SOUTH	WEST	MAT'L/FIN	HEIGHT		
101	VESTIBULE	VCT	VB	CT/GWB/PT	CT/GWB/PT	GWB/PT	CT/GWB/PT	APC-1 (NOTE 5)	9'-0"	NOTE 2	101
102	CORRIDOR	VCT	VB	CT/EXBRK/PT	CT/GWB/PT	GWB/PT	CT/GWB/PT	APC-1	9'-0"	NOTE 2	102
103	CLASSROOM	CPT-1	VB	EXBRK/PT	GWB/PT	GWB/PT	GWB/PT	APC-1	9'-0"		103
103M	MECHANICAL	---	VB	GWB/PT	GWB/PT	GWB/PT	GWB/PT	GWB	9'-0"		103M
104	CLASSROOM	CPT-1	VB	EXBRK/PT	GWB/PT	GWB/PT	GWB/PT	APC-1	9'-0"		104
104M	MECHANICAL	---	VB	GWB/PT	GWB/PT	GWB/PT	GWB/PT	GWB	9'-0"		104M
105	VESTIBULE	VCT	VB	CT/GWB/PT	CT/GWB/PT	GWB/PT	CT/GWB/PT	APC-1 (NOTE 5)	9'-0"	NOTES 2, 5	105
106	CORRIDOR	VCT	VB	CT/EXBRK/PT	CT/GWB/PT	GWB/PT	CT/GWB/PT	APC-1	9'-0"	NOTE 2	106
107	CLASSROOM	CPT-1	VB	GWB/PT	GWB/PT	GWB/PT	GWB/PT	APC-1	9'-0"		107
107M	MECHANICAL	---	VB	GWB/PT	GWB/PT	GWB/PT	GWB/PT	GWB	9'-0"		107M
109	JANITOR	---	VB	EXBRK/PT	GWB/PT	GWB/PT	GWB/PT	GWB	9'-0"		109
110	CLASSROOM	CPT-1	VB	EXBRK/PT	GWB/PT	GWB/PT	GWB/PT	APC-1	9'-0"		110
110M	MECHANICAL	---	VB	GWB/PT	GWB/PT	GWB/PT	GWB/PT	GWB	9'-0"		110M
111	RESTROOM	CT	CTB	CT/GWB/PT	CT/GWB/PT	CT/GWB/PT	CT/GWB/PT	GWB	9'-0"		111
120	CLASSROOM	CPT-2 (NOTE 3)	VB	GWB/PT	GWB/PT	GWB/PT	GWB/PT	APC-1	9'-0"		120
121	OFFICE	CPT-2 (NOTE 3)	VB	GWB/PT	GWB/PT	GWB/PT	GWB/PT	APC-1	9'-0"		121
122	PRACTICE	CPT-2 (NOTE 3)	VB	GWB/PT	GWB/PT	GWB/PT	GWB/PT	APC-1	9'-0"		122
123	PRACTICE	CPT-2 (NOTE 3)	VB	GWB/PT	GWB/PT	GWB/PT	GWB/PT	APC-1	9'-0"		123
124	PRACTICE	CPT-2 (NOTE 3)	VB	GWB/PT	GWB/PT	GWB/PT	GWB/PT	APC-1	9'-0"		124
125	MECHANICAL	---	VB	GWB/PT	GWB/PT	GWB/PT	GWB/PT	GWB	9'-0"		125
126	CORRIDOR	VCT	VB	GWB/PT	GWB/PT	GWB/PT	EX MTL PNL/PT	APC-1	9'-0"		126
127	SHOP	EX CONC (NOTE 1)	---	(NOTE 4)	(NOTE 4)	(NOTE 4)	(NOTE 4)	EXIST (NOTE 6)	VARIES	NOTES 4,6	127

ROOM FINISH SCHEDULE NOTES

- NOTE 1 CLEAN/REMOVE CPT TILE ADHESIVE AND CLEAN EXIST CONCRETE FLOOR TO REMAIN EXPOSED
- NOTE 2 5' HIGH CT WALL WAINSCOT WITH PAINTED GWB ABOVE
- NOTE 3 REFER TO FLOOR FINISH LAYOUT PLAN FOR EXTENT OF SALVAGED CPT TILE AND NEW CPT-2, (ASSUME 80% CPT SALVAGED FROM EXISTING MUSIC ROOM)
- NOTE 4 PAINT FORMER REMAINING MUSIC ROOM PERIMETER WALLS
- NOTE 5 PROVIDE AND INSTALL APC HOLD-DOWN CLIPS
- NOTE 6 EXPOSED EXIST ROOF INSUL AND STRUCTURE TO REMAIN AFTER EXIST SUSPENDED CLG IS REMOVED

FLOOR MATERIALS	
ABBREV.	MATERIAL TYPE AND MANUF.
CPT-1	CARPET TILE TYPE NO. 1
CPT-2	CARPET TILE TYPE NO. 2
VCT	VINYL COMPOSITION TILE
CT	PORCELAIN TILE (12 X 24)
EX	PREFIX INDICATING EXISTING CONDITION
BASE MATERIALS	
EX	PREFIX INDICATING EXISTING CONDITION
VB	4' VINYL WITH COVERED TOE BY FLOORING SUBCONTRACTOR
CTB	CERAMIC TILE BASE
WALL MATERIALS	
EX	PREFIX INDICATING EXISTING CONDITION
CMU	CONCRETE MASONRY UNIT
GWB	GYPSUM WALLBOARD
PT	PAINT
BRK	BRICK MASONRY UNIT
CEILING MATERIALS	
APC-1	ACOUSTICAL PANEL CEILING TYPE NO. 1 (SUSPENDED)
GWB	GYPSUM WALLBOARD

Preliminary
not for
Construction

Client Information
Palmer Public Schools
 202 Commercial St.
 Palmer, NE 68864

Project Information
Classroom Addition

Issue Date	01-13-2015
Job #	14-0256
Drawn by:	ktr
CADD file:	A-601

COPYRIGHT © DAVIS DESIGN ALL RIGHTS RESERVED

Drawing Title
 Room Finish Schedule

From Sheet:	A-601	for CA use:
Drawing #	A-601.1	

Lincoln
 1221 N Street, Suite 600
 Lincoln, NE 68508
 Phone 402-476-9700
 Fax 402-476-9722

Vermillion
 15 East Main, Suite 201
 Vermillion, SD 57069
 Phone 605-624-1081



DOOR AND FRAME SCHEDULE

O.A. = OVERALL DEPTH

OPN'G #	DOOR							FRAME					REMARKS	OPN'G #
	WIDTH	HT	THICKNESS	TYPE	FINISH	ELEV	LABEL	ELEV	MAT'L	FINISH	FRAME DEPTH-THROAT	HDWR #		
101	3'-0" (EXIST)	6'-10"	1 3/4"	AL	FACTORY	EXIST	----	EXIST	AL	----		EXIST	RELOCATED DOOR/FRAME	101
102	3'-0"	7'-0"	1 3/4"	AL	FACTORY	C	----	AL-1	AL	----				102
103	3'-0"	7'-0"	1 3/4"	WD	FACTORY	A	20 MIN	HM-1	HM	PAINT				103
103M	3'-0"	7'-0"	1 3/4"	WD	FACTORY	B	60 MIN	HM-1	HM	PAINT				103M
104	3'-0"	7'-0"	1 3/4"	WD	FACTORY	A	20 MIN	HM-1	HM	PAINT				104
104M	3'-0"	7'-0"	1 3/4"	WD	FACTORY	B	60 MIN	HM-1	HM	PAINT				104M
105	3'-0" (EXIST)	6'-10"	1 3/4"	AL	FACTORY	EXIST	----	EXIST	AL	----		EXIST	RELOCATED DOOR/FRAME	105
106	3'-0"	7'-0"	1 3/4"	AL	FACTORY	C	----	AL-1	AL	----				106
107	3'-0"	7'-0"	1 3/4"	WD	FACTORY	A	20 MIN	HM-1	HM	PAINT				107
107M	3'-0"	7'-0"	1 3/4"	WD	FACTORY	B	60 MIN	HM-1	HM	PAINT				107M
108	3'-0"	7'-0"	1 3/4"	WD	FACTORY	B	20 MIN	HM-1	HM	PAINT				108
109	3'-0"	7'-0"	1 3/4"	WD	FACTORY	A	20 MIN	HM-1	HM	PAINT				109
110	3'-0"	7'-0"	1 3/4"	WD	FACTORY	B	20 MIN	HM-1	HM	PAINT				110
110M	3'-0"	7'-0"	1 3/4"	WD	FACTORY	B	60 MIN	HM-1	HM	PAINT				110M
111	3'-0"	7'-0"	1 3/4"	WD	FACTORY	B	20 MIN	HM-1	HM	PAINT				111
112	3'-0"	7'-0"	1 3/4"	WD	FACTORY	B	----	HM-1	HM	PAINT				112
120	3'-0" (EXIST)	7'-0"	1 3/4"	HM	PAINT	EXIST	----	EXIST	HM	PAINT		EXIST	RELOCATED DOOR/FRAME	120
121	3'-0"	7'-0"	1 3/4"	WD	FACTORY	A	----	HM-1	HM	PAINT				121
122	3'-0"	7'-0"	1 3/4"	WD	FACTORY	A	----	HM-1	HM	PAINT				122
123	3'-0"	7'-0"	1 3/4"	WD	FACTORY	A	----	HM-1	HM	PAINT				123
124	3'-0"	7'-0"	1 3/4"	WD	FACTORY	A	----	HM-1	HM	PAINT				124
125	3'-0"	7'-0"	1 3/4"	WD	FACTORY	B	60 MIN	HM-1	HM	PAINT				125
126	PR 3'-0" (EXIST)	7'-0"	1 3/4"	HM	PAINT	EXIST	----	EXIST	HM	PAINT		EXIST	RELOCATED DOOR/FRAME	126
127A	16'-0"	10'-0"	1 3/4"		FACTORY									127A
127B	3'-0"	7'-0"	1 3/4"	WD	FACTORY	A	90 MIN	EXIST	HM	PAINT			HARDWARE TO REMAIN	127B
127C	3'-0"	7'-0"	1 3/4"	WD	PAINT	EXIST	----	EXIST	HM	PAINT			EXISTING DOOR/FRAME	127C

Lincoln
1221 N Street, Suite 600
Lincoln, NE 68508
Phone 402-476-9700
Fax 402-476-9722

Vermillion
15 East Main, Suite 201
Vermillion, SD 57069
Phone 605-624-1081



Preliminary
not for
Construction

Client Information
Palmer Public Schools
202 Commercial St.
Palmer, NE 68864

Project Information
Classroom Addition

Issue Date	01-13-2015
Job #	14-0256
Drawn by:	ktr
CADD file:	A-601

COPYRIGHT © DAVIS DESIGN ALL RIGHTS RESERVED

Drawing Title
Door and Frame Schedule

From Sheet:	A-601	for CA use:
Drawing #	A-601.2	