

**ADDENDUM
(AD)**

PROJECT: Nebraska Department of Correction Svcs
Community Correctional Center - Lincoln
Security Camera System Upgrade
2720 West Van Dorn Street
Lincoln, Nebraska

AD NO.: AD-1

DATE: November 18, 2024

DDI Project No.: 24-0086

NDCS Project No.: 2426

ISSUED BY: Jon Dalton, Coordinating Professional
Jon Dalton, Electrical Engineer
Igor Abadzic, Latta Tech

This addendum is issued by the Architect to all known bidders before receipt of proposals, for the purpose of explaining, interpreting, or modifying the original plans and specifications. When enumerated by the bidder upon the proposal sheet, the information or instructions given hereon will be equally binding upon all parties as if included in the original plans and specifications.

BIDDER MUST ENTER THE NUMBER OF THIS ADDENDUM ON HIS PROPOSAL SHEET

THE FOLLOWING ITEMS ARE GENERAL INFORMATION:

AD-1, ITEM #1:

In reference to pre-bid meeting, held November 14, 2024, attached are the pre-bid meeting notes and sign-in sheet.

THE FOLLOWING ITEMS ARE APPLICABLE TO THE SPECIFICATIONS:

AD-1, ITEM #2:

In reference to Section 28 2300 VIDEO MANAGEMENT AND RECORDING SYSTEM, see revised section attached.

THE FOLLOWING ITEMS ARE APPLICABLE TO THE DRAWINGS:

AD-1, ITEM #3:

In reference to Sheet ES1.09 EXISTING 160 BED BUILDING – EQUIPMENT PLATFORM LEVEL, see revised sheet attached. Changes are clouded.

AD-1, ITEM #4:

In reference to Sheet ES1.09 EXISTING 160 BED BUILDING – EQUIPMENT PLATFORM LEVEL, see revised sheet attached. Changes are clouded.

Nebraska Department of Correctional Services
Community Correctional Center - Lincoln
Security Camera System Upgrade
Lincoln, Nebraska
November 18, 2024
Addendum No. AD-1

AD-1, ITEM #5:

In reference to Sheet **ES1.09 EXISTING 160 BED BUILDING – EQUIPMENT PLATFORM LEVEL**, see revised sheet attached. Changes are clouded.

AD-1, ITEM #6:

In reference to Sheet **ES2.01 ENLARGED PLAN**, see revised sheet attached. Changes are clouded.

AD-1, ITEM #7:

In reference to Sheet **ES2.02 ENLARGED PLAN**, see revised sheet attached. Changes are clouded.

AD-1, ITEM #8:

In reference to Sheet **ES2.03 ENLARGED PLAN**, see revised sheet attached. Changes are clouded.

AD-1, ITEM #9:

In reference to Sheet **ES4.01 VIDEO MANAGEMENT SYTEM DIAGRAM**, see revised sheet attached. Changes are clouded.

AD-1, ITEM #10:

In reference to Sheet **ES4.02 CAMERA SCHEDULE**, see revised sheet attached. Changes are clouded.

END AD-1

MEETING NOTES

PROJECT: **Nebraska Dept of Corrections**
Community Correctional Center - Lincoln
Security Camera System Upgrade
Lincoln, NE

MEETING DATE: **11/14/2024**

MEETING TIME: **9:00 AM**

MEETING LOCATION: **CCCL Conference Room**

MEETING NAME: **Pre-Bid Meeting**

DAVIS DESIGN
PROJECT NO.: **24-0086**

I. Introductions

- A. Department of Corrections – Chad Ellison, Jerry Rotschafer
- B. Davis Design – Jon Dalton
- C. Latta Technical Services – Igor Abadzic

II. Bid Requirements:

- A. Bid Date: **November 21, 2024**. 2:00 PM @ Bldg. 1, Folsom and West Prospector Place, Lincoln, NE 68522
Optional: P.O. Box 94661 – Lincoln, NE 68509-4661

Hand Delivery is the ONLY way to guarantee it will be delivered correctly and on time!

Bids will be received and opened, but not read. Bid tab will be distributed to bidders at a later date.

- B. Bid Form (Proposal)
 - 1. Base Bid
 - 2. Alternate Providers
- C. Pre-Qualification Requirements (28 0510)
- D. Bid Security
- E. Addendums: One, to be issued no later than Monday, 11/18.

III. Security and Access Requirements

- A. Screening and Controls
 - 1. Worker Background Checks Mandatory. **All on-site personnel.**
 - 2. Site Access – Either parking lot for vehicles is fine.
 - 3. Tools: Expect all tools to be removed each day.
 - 4. Project should not require any large equipment for installation. Will need a lift in the high ceiling areas.
 - 5. No tobacco products on grounds or **Contraband Materials**
 - 6. No firearms or weapons on person or in vehicles.
 - 7. No cell phones. Main on-site superintendent may submit a request (Director's approval is required)

IV. Site Conditions

- A. Controlled Project Area
 - 1. Worker Parking – Either parking lot is fine.
 - 2. Material and tool storage: Bring as needed for daily installations.
 - 3. Material Disposal: Coordinate with staff.
 - 4. **Contractors will NOT be escorted. They will be able to move freely through the facility. They will need to contact staff for locked rooms.**

Nebraska Dept of Corrections
Community Correctional Center - Lincoln
Security Camera System Upgrade Pre-Bid Meeting
Lincoln, Nebraska
November 14, 2024
PAGE 2 of 2

V. Project Scope

- A. The scope of this project includes replacement of all existing analog and IP cameras (refer to ES series drawings), video viewing stations and video surveillance system head-end equipment (including but not limiting to servers, video storage, media converters, etc.). The new cameras shall be IP based, high definition and POE cameras. All new cameras shall be manufactured by Bosch (to match NDCS standard). Hanwha multisensory camera with integrated PTZ unit and Hanwha dual sensor camera shall be used at locations indicated on the drawings and camera schedule. The new video management software shall be the latest available version of Bosch VMS (BVMS 12.1). All cameras shall be recorded, and video storage shall be sized to retain video recording for 90 days. All cameras shall be continuously recording at native resolution at 15 images per second. Quiet time recording (no motion) shall be at native resolution and 2 images per second. The motion shall be estimated at 70%.
- B. The existing CAT6 cables shall remain for reuse. All CAT6 cables that are planned to be reused shall be tested to confirm uncompromised signal strength. All cables failing this test shall be replaced with the new fiber optic cable for exterior cameras and CAT6 for interior cameras.
- C. All new video system components shall be connected to network switches via CAT6 cable using patch panels. If any cable length between a component (camera, workstation, etc.) and a network switch, including slack, exceeds 300', provide new fiber optic cable, media converters and power supplies to support camera and media converter operation. Provide power for media converters from approved UPS circuits. All underground CAT6 runs shall be in conduit and shall utilize direct-burial rated cable.
- D. Work shall be phased out to install all new infrastructure and servers, etc. in place prior to removing existing surveillance equipment. Coordinate with the owner for the phasing of work by area. A phasing plan shall be submitted for owner approval prior to commencement of work. Downtime of existing systems shall be kept to a minimum during the course of the installation.
- E. Network switches shall be provided by the NDCS OCIO. Patch panels and associated head end patch cables shall be provided and installed by the contractor.
- F. All exiting video surveillance equipment (including but not limited to cameras, video monitors, servers and recorders, etc.) shall be removed and returned to the owner in accordance with ES series of drawings.
- G. New video management system equipment and all system components shall be powered from the back-up power systems with additional backup from uninterruptible power systems. New UPS backup shall be used for a minimum of 10 minutes at fully connected load. Refer to "E" series drawings for the power requirements.
- H. All security integrator provided hardware (including but not limited to CPUs, IP cameras, monitors, servers, etc.) and software shall be the latest available products on the market at the date of the project implementation and no more than 6 months prior to the system installation.
- I. All licenses for cameras and software shall be included and no recurring license fees shall apply for 5 years. The VMS software shall be purchased with all upgrades to allow the owner to replace cameras without additional license fees or software upgrade fees for the next 5 years
- J. Schedule
 1. Contractor shall have all materials/new equipment in their position, prior to starting on site work.
 2. The contractor will be expected to coordinate detailed schedules with the staff the CCCL.
 3. Both existing and new systems may need to be operational during the installation and implementation of the new equipment to ensure video surveillance is maintained. (OCIO assistance may be required).

VI. Questions: Submit to Jon Dalton no later than 5:00 pm, Friday, November 15. jon.dalton@davisdesign.com

DISTRIBUTION: Attendees

SIGN-IN FORM

PROJECT: **Nebraska Dept of Corrections**
Community Correctional Center - Lincoln
Security Camera System Upgrade
Lincoln, NE

MEETING DATE: **11/14/2024**

MEETING TIME: **9:00 AM**

MEETING LOCATION: **CCCL Conference Room**

MEETING NAME: **Pre-Bid Meeting**

DAVIS DESIGN
PROJECT NO.: **24-0086**

Present at Meeting	Via Phone	Individual Name	Company Name	Telephone	Email Address
x	<input type="checkbox"/>	Dalton, Jon	Davis Design	402-476-9700	jon.dalton@davisdesign.com
x	<input type="checkbox"/>	Abadzic, Igor	Latta Technical	972-633-5850	iabadzic@lattatech.com
x	<input type="checkbox"/>	Bornemeier, Nate	NDCS	402-479-5861	nathan.bornemeier@nebraska.gov
x	<input type="checkbox"/>	Drescher, Allison		402-471-6257	allisondrescher@nebraska.gov
x	<input type="checkbox"/>	Ellison, Chad	NDCS	402-479-5777	chad.ellison@nebraska.gov
x	<input type="checkbox"/>	Johnson, Jericho	NDCS	402-471-6686	jericho.johnson@nebraska.gov
x	<input type="checkbox"/>	McGuire, Dave	NDCS	402-560-2779	dave.mcguire@nebraska.gov
x	<input type="checkbox"/>	Rombough, Michael	NDCS	402-326-3365	michael.rumbough@nebraska.gov
	<input type="checkbox"/>	Rotschafer, Jerry	NDCS	402-479-5593	jerry.rotschafer@nebraska.gov
x	<input type="checkbox"/>	Trevino, Brady	NDCS	402-890-7849	brady.trevino@nebraska.gov
x	<input type="checkbox"/>	Scheer, Rick	Control Masters	402-306-5370	rickscheer@control-masters.com
x	<input type="checkbox"/>	Collen, Nick	IES	402-890-7874	nickc@ieselectricinc.com
x	<input type="checkbox"/>	Coolidge, Curt	MSI	913-848-4685	curt.coolidge@motorolasolutions.com
x	<input type="checkbox"/>	Butler, Joe	STS	531-229-3673	joe@stsmail.biz
x	<input type="checkbox"/>	Heath, Peter	STS	402-610-0474	pheath@stsmail.biz
x	<input type="checkbox"/>	Satterthwaite, Brandon	Willmar Electric	402-540-5338	bsatterthwaite@willmar-electric.com
x	<input type="checkbox"/>	Lovette, Dylan	Wired, Inc.	402-890-5599	dylan@wiredne.com
	<input type="checkbox"/>				
	<input type="checkbox"/>				

**NEBRASKA DEPARTMENT OF CORRECTIONAL SERVICES
COMMUNITY CORRECTION CENTER LINCOLN
SECURITY CAMERA SYSTEM UPGRADE
LINCOLN, NEBRASKA**

SECTION 28 2300

VIDEO MANAGEMENT AND RECORDING SYSTEM

PART 1 - GENERAL

1.1 DESCRIPTION

A. General:

1. Furnish all labor, materials, tools, equipment, and services for all video surveillance systems as indicated, in accordance with provisions of Contract Documents.
2. Completely coordinate with work of all other trades.
3. Although such work is not specifically indicated, furnish and install all supplementary or miscellaneous items, appurtenances and devices incidental to or necessary for a sound, secure and complete installation.
4. See Section 280510 for Electronic Systems General Requirements.
5. See Division 1 for General Requirements.

1.2 BASIS OF DESIGN

- A. The scope of this project includes replacement of all existing analog and IP cameras (refer to ES series drawings), video viewing stations and video surveillance system head-end equipment (including but not limiting to servers, video storage, media converters, etc.). The new cameras shall be IP based, high definition and POE cameras. All new cameras shall be manufactured by Bosch (to match NDCS standard). Hanwha multisensory camera with integrated PTZ unit and Hanwha dual sensor camera shall be used at locations indicated on the drawings and camera schedule. The new video management software shall be the latest available version of Bosch VMS (BVMS 12.1). All cameras shall be recorded, and video storage shall be sized to retain video recording for 90 days. All cameras shall be continuously recording at native resolution at 15 images per second. Quiet time recording (no motion) shall be at native resolution and 2 images per second. The motion shall be estimated at 70%.
- B. The upgraded video management system shall NOT be interfaced and integrated with the existing electronic security control system to allow display of all new camera icons on the existing touch screen maps for cameras call-up feature.
- C. The existing CAT6 cables shall remain for reuse. All CAT6 cables that are planned to be reused shall be tested to confirm uncompromised signal strength. All cables failing this test shall be replaced with the new fiber optic cable for exterior cameras and CAT6 for interior cameras.
- D. All new video system components shall be connected to network switches via CAT6 cable using patch panels. If any cable length between a component (camera, workstation, etc.) and a network switch, including slack, exceeds 300', provide new fiber optic cable, media converters and power supplies to support camera and media converter operation. Provide power for media converters from approved UPS circuits. All underground CAT6 runs shall be in conduit and shall utilize direct-burial rated cable.

**NEBRASKA DEPARTMENT OF CORRECTIONAL SERVICES
COMMUNITY CORRECTION CENTER LINCOLN
SECURITY CAMERA SYSTEM UPGRADE
LINCOLN, NEBRASKA**

- E. Work shall be phased out to install all new infrastructure and servers, etc. in place prior to removing existing surveillance equipment. Coordinate with the owner for the phasing of work by area. A phasing plan shall be submitted for owner approval prior to commencement of work. Downtime of existing systems shall be kept to a minimum during the course of the installation.
- F. Network switches shall be provided by the NDCS OCIO. Patch panels and associated head end patch cables shall be provided and installed by the contractor.
- G. All exiting video surveillance equipment (including but not limited to cameras, video monitors, servers and recorders, etc.) shall be removed and returned to the owner.
- H. New video management system equipment and all system components shall be powered from the back-up power systems with additional backup from uninterruptible power systems. New UPS backup shall be used for a minimum of 10 minutes at fully connected load. Refer to "E" series drawings for the power requirements.
- I. All security integrator provided hardware (including but not limited to CPUs, IP cameras, monitors, servers, etc.) and software shall be the latest available products on the market at the date of the project implementation and no more than 6 months prior to the system installation.
- J. The system shall provide full video control, with additional full selection capability at any point within the network from any workstation or a video console display. The security video system shall provide expansion capability for the addition or modification of the system.
- K. The system shall permit normal monitoring and analytics monitoring of all secured areas on monitors as shown in the specifications and drawings. Video monitoring consoles shall be installed as shown on the drawings and described in these specifications. In all cases, the equipment shall be state of the art, standardized commercial off-the-shelf, and modular. In all cases, the method of communication from remote locations within the network to the central components shall be transparent to the user. Equipment shall be selected and installed so repairs may be accomplished on site by module replacement, utilizing spare components whenever possible.
- L. The Contractor shall furnish and install all security video cameras, mounts, housings, power supplies, network cables, connectors, equipment racks, monitors and consoles, computer-controlled network switches, workstations, network storage, encoders, decoders, video console displays and all other hardware and software to provide a fully operational system.
- M. All licensing for cameras and software shall be included and no recurring license fees shall apply. The NDCS has standardized Bosch BVMS (latest version) software – it shall be purchased with all upgrades to allow the owner to replace cameras without additional license fees or software upgrade fees for the life of the system.
- N. The video management and recording system specified is an enterprise-class client/server-based IP video security solution that provides seamless management of digital video, audio and data across an IP network. The system is designed to work with CCTV and ONVIF compliant 3rd party products as part of a total video security management system to provide full virtual matrix switching and control capability. Cameras, recorders, and viewing stations may be placed anywhere in the IP network.
- O. The system shall provide multi-level diagnostics of each component in all critical areas. These diagnostics shall be reported to a diagnostic console for processing. In addition, the diagnostic data shall be capable of being scripted into actionable events within the system.

**NEBRASKA DEPARTMENT OF CORRECTIONAL SERVICES
COMMUNITY CORRECTION CENTER LINCOLN
SECURITY CAMERA SYSTEM UPGRADE
LINCOLN, NEBRASKA**

- P. The system shall be able to handle future expansion of an unlimited total capacity from what is shown in the drawings, including but not limited to cameras, monitors, workstations and keyboards.
- Q. The system shall be installed by a manufacturer certified dealer/integrator. Certification for installation shall be conducted by the manufacturer and shall provide all necessary knowledge to fulfill the systemization and deployment across diverse networks and infrastructures, as well as provide commissioning abilities at the integrator level.
- R. All the cameras shall be mounted within housings suitable for the environment in which they are placed. Exterior wall mount cameras shall be mounted so that the conduit penetration into the building will enter into the plenum space above the interior ceiling. Coordinate final heights with owner.
- S. Each typical camera mounting location shall be field verified prior to installation to confirm the best video coverage. Obstructions to the intended view shall be called out to the owner and Engineer prior to final mounting. Video coverage shall be approved either by the owner and submitted to the Engineer.
- T. Provide user-programmable title and camera number for each camera. Coordinate titles with owner. All camera titles for the new and the existing IP cameras (that will be reused) shall be coordinated with the owner.

1.3 QUALITY ASSURANCE (SEE SECTION 280510)

- A. Work shall be performed in accordance with the applicable national and local codes or standards current at the commencement of installation. The following list summarizes applicable standards:
 - 1. National Electrical Safety Code, current edition.
 - 2. National Fire Protection Association National Fire Codes, current edition.
 - 3. EIA/TIA – 568: Commercial Building Telecommunications Wiring Standard.
 - 4. EIA/TIA – 569: Commercial Building Standard for Telecommunications Pathways and Spaces.
 - 5. EIA/TIA – 606: Administrative Standards for the Telecommunications Infrastructure of Commercial Buildings.
 - 6. IEEE, RS 170 Variable Standard.
 - 7. IEEE 802.3 digital data network standard.
 - 8. Premises cabling standard EIT/TIA568A.
 - 9. Member, MPEG-4 Industry Forum
 - 10. Member, Universal Plug and Play (UPnP) Forum
 - 11. Member, Universal Serial Bus (USB) Implementers Forum
 - 12. Compliance, ISO/IEC 14496 standard (also known as MPEG-4)

**NEBRASKA DEPARTMENT OF CORRECTIONAL SERVICES
COMMUNITY CORRECTION CENTER LINCOLN
SECURITY CAMERA SYSTEM UPGRADE
LINCOLN, NEBRASKA**

- B. Where more than one code or regulation is applicable, the more stringent regulation shall apply.

1.4 SUBMITTALS (SEE SECTION 28 0510)

A. Video Surveillance System 28 2300

1. Project data: Description of system operation indicating purpose and capabilities of each component of the system with functional system diagram indicating all interfaces to other systems. Description shall include, and call attention to, all variances from the contract documents.
2. Shop drawings: Complete installation drawings including system diagrams and terminal point to terminal point wiring diagrams or schedules showing all device names, locations, IP addresses, hardware components and accessories, and switch port assignments.
3. Product data: Technical data sheets and specifications for each and every component.
4. Storage Calculations: To ensure that adequate storage is available to meet the specification requirements.
5. Bandwidth Calculations: To ensure that adequate bandwidth (backbone and per switch/stack) is available to support the full functionality of any camera, any recorder and any viewing station.

1.5 WARRANTY (SEE DIVISION 1)

1.6 OPERATING AND MAINTENANCE DATA (SEE SECTION 28 0510)

1.7 VIDEO MANAGEMENT SYSTEM CAPABILITIES

- A. The video management system (VMS) specified is an enterprise-class client/server-based IP video security solution that provides seamless management of digital video, audio and data across an IP network. The video management system is designed to work with CCTV and ONVIF compliant 3rd party products as part of a total video security management system to provide full virtual matrix switching and control capability. Cameras, recorders, and viewing stations may be placed anywhere in the IP network.
- B. The VMS shall be capable to be deployed in Local Area Networks (LAN) as well as in Wide Area Networks (WAN). For establishing remote connections across WAN, it shall be possible to setup a port mapping table within the configuration manager in order to map the public port to a private IP and port of the devices.
- C. The VMS shall provide a built-in command script editor that allows customized command scripts to be written to control virtually all the system functions.
- D. The VMS shall be built upon open, industry standards and facilitate integration with IT infrastructures and other digital and analog systems.
- E. The IP video management system shall have no restriction as to the resolution, frame rate, or number of standard resolution or mega pixel cameras that can be recorded, viewed, and managed on the system.

**NEBRASKA DEPARTMENT OF CORRECTIONAL SERVICES
COMMUNITY CORRECTION CENTER LINCOLN
SECURITY CAMERA SYSTEM UPGRADE
LINCOLN, NEBRASKA**

- F. All displays shall retain the camera's aspect ratio and accommodate 4:3, 16:9, or 16:10 monitor displays.
- G. Multiple users shall be able to simultaneously view the same camera view or sequence. The system shall support and implement multicast streaming video to allow multiple users to view the same video stream, though not necessarily synchronized with each other, without affecting the bandwidth of the network. A purely unicast system is not acceptable.
- H. The VMS shall allow for programming of alarms and associated incoming alarms with related parts of the system. Alarms and other triggers can be grouped into system events.
- I. The VMS shall log all alarms and events in the database.
- J. The VMS shall provide for virtual matrix functionality, leveraging the IP network to switch any camera to any monitor either through a PC Keyboard/Mouse or a joystick controller as well as transmit alarms and other system messages to any console on the network.
- K. The VMS shall be designed in such a way that configuration changes to any part of the system shall not interrupt operational tasks, until the operator decides to update re-fresh the workstation configuration.
- L. The VMS shall be able to handle future expansion of an unlimited total capacity from what is shown in the drawings, including but not limited to cameras, monitors, workstations and keyboards.
- M. The IP video management system network shall be arranged so each area will operate independently and shall communicate via a 10Giga-bit network at a minimum to the server. The system shall utilize virtual matrix switcher capabilities through the use of a server. The server shall provide a user interface and database management of the VMS. The server shall allow for users to be restricted via software to logical configurable groups of cameras, monitors and system operations

PART 2 - PRODUCTS

2.1 OPERATING AND MAINTENANCE DATA (SEE SECTION 280510)

2.2 GENERAL

- A. Manufacturers:
 - 1. Video management and recording software:
 - a. Bosch BVMS (TO MATCH THE EXISTING)
 - 2. Video surveillance equipment:
 - a. Bosch
 - b. Hanwha (MODELS COMPATIBLE WITH BOSCH VMS for operation of PTZ)
 - 3. CAT6 cable and Fiber Optic cable
 - a. Base: Belden, West Penn, CommScope, Inc.

**NEBRASKA DEPARTMENT OF CORRECTIONAL SERVICES
COMMUNITY CORRECTION CENTER LINCOLN
SECURITY CAMERA SYSTEM UPGRADE
LINCOLN, NEBRASKA**

4. Video Management and Recording Servers:
 - a. Dell
 - b. HP - Hewlett-Packard
 5. Video Management Workstations:
 - a. Dell
 - b. HP - Hewlett-Packard
 6. Network Switch (BY THE OWNER):
 7. The product numbers contained herein are for reference only and may not be the most current available nor a complete listing of all features or options required. Where a manufacturer is listed without a product number, an equivalent item of the specified manufacturer is acceptable. Determination of equivalent is at the sole discretion of the Engineer. Where a conflict or ambiguity exists between the written description and the product number, the written description shall govern.
 8. Other manufacturers desiring approval comply with Division 1.
- B. System Operation:
1. Provide complete system for viewing of remote scene including control of equipment accessories.
 2. Provide all programming of system as indicated herein.
 3. Video Surveillance Automated Call-Up:
 - a. The video surveillance system shall be configured for automatic camera viewing on selected intercom calls and alarms upon acknowledgment by the control operator.
 - 1) When an intercom call or alarm is acknowledged, the camera viewing the device shall be displayed.
 - 2) Intercom calls shall call up the camera viewing the intercom station. If the intercom is at a door with a camera on each side, then cameras on each side of the door shall be called up in quad view.
 - 3) Door alarms shall call up the cameras viewing each side of the door in quad view.
 - 4) Panic/Duress activation shall call up to four cameras in quad mode viewing the complete area of the alarm. If a camera is not available for such, call up cameras on entry to area.
 - 5) All call-ups shall be reviewed and revised as needed during the submittals.
 - b. Camera display shall reset to single camera view upon selection of another camera icon or single camera alarm.

2.3 VIDEO ANALYTICS

- A. Provide state-of-the-art intelligent video analysis that reliably detects, tracks, and analyzes moving objects while suppressing unwanted alarms from spurious sources in the image.

**NEBRASKA DEPARTMENT OF CORRECTIONAL SERVICES
COMMUNITY CORRECTION CENTER LINCOLN
SECURITY CAMERA SYSTEM UPGRADE
LINCOLN, NEBRASKA**

- B. Cameras shall be capable of processing and analyzing video within the camera itself, with no extra hardware required.
- C. VMS shall record metadata so analytics can be used on recorded video without having been setup for live video.
- D. Analytics shall intelligently adapt to difficult conditions like changes in lighting or environment such as rain, snow, clouds, and leaves blowing in the wind. The built-in tamper detection generates alarms on camera hooding/masking, blinding, defocusing, and repositioning.
- E. Analytics shall include
 - 1. Detect objects within, entering, or leaving an area
 - 2. Detect multiple line crossing from single line up to three lines combines in a logical row
 - 3. Detect objects traversing a route
 - 4. Detect loitering in an area related to radius and time
 - 5. Detect objects which are idle for a predefined time span
 - 6. Detect removed objects
 - 7. Detect objects who's properties such as size, speed, direction, and aspect ratio change within a configured time span according to specification (for example something falling down)
 - 8. Count objects crossing virtual line or entering a certain area
 - 9. Overhead people counting (Bird's eye view)
 - 10. Detect a certain crowd level in a predefined field
 - 11. Detect specified motion direction and speed even in crowds (for example a person moving the wrong way in a one-way gate)
 - 12. Detect objects that move contrary to the motion of all other objects in the scene, even in crowds
 - 13. Take snapshots of frontal faces
 - 14. Combine tasks using scripts
- F. To enhance robustness, analytics shall be capable of being configured to ignore specified image areas and small objects. Calibrated cameras shall automatically distinguish between upright persons, bikes, cars, and trucks. Furthermore, object size, speed, two-way direction, aspect ratio, and color filters shall be available for use in any combination to create specific detection rules for exactly the objects you are looking for. Statistics on object properties shall be stored and capable of being displayed for fine tuning the object filters. Object properties shall also be able to be defined by selecting an appropriately similar object in the video.
- G. Cameras specified and listed in the camera schedule with analytic requirements shall include all of these capabilities without any licenses for individual features and functions. All cameras analytics shall be calibrated and tested by the contractor.

**NEBRASKA DEPARTMENT OF CORRECTIONAL SERVICES
COMMUNITY CORRECTION CENTER LINCOLN
SECURITY CAMERA SYSTEM UPGRADE
LINCOLN, NEBRASKA**

2.4 2MP MINIDOME CAMERAS

- A. The Vandal resistant 2MP camera shall have a microSD card slot that uses standard; off-the-shelf microSD (SDHC and SDXC) cards for local storage (up to 2 TB) and be enclosed in a cast-aluminum housing with an aluminum trim ring and a clear polycarbonate dome bubble (with UV blocking anti-scratch coating) and be capable of operating in an indoor or an outdoor environment.
- B. Image Sensor: 1/2.8-inch CMOS, 2MP image sensor.
- C. Lens: 3.2-10.5mm motorized automatic zoom and focus (remote varifocal) lens with an advanced iris design. Horizontal field of view shall be 31 to 105 degrees and vertical field of view shall be 18 to 57 degrees minimum.
- D. Camera processing latency: <55 ms
- E. Dynamic Range: 120 dB HDR
- F. Compression: H.265 MP, H.264 MP, M-JPEG
- G. Audio
 - 1. Standard:
 - a. AAC
 - b. G.711, 8 kHz sampling rate
 - c. L16, 16 kHz sampling rate
 - 2. Signal-to-Noise Ratio: >50 dB
 - 3. Audio Streaming: Full duplex / Half duplex
- H. Light sensitivity (measured according to IEC 62676 Part 5 (1/25, F1.6):
 - 1. Color: 0.021 lx
 - 2. Monochrome: 0.004lx
- I. Content-based Imaging Technology (C-BIT), Intelligent streaming and Intelligent Dynamic Noise Reduction (iDNR) technology to reduce the bitrate and storage requirements by removing noise artifacts.
- J. Resolution: 1920X1080 pixels (1080P HD) at 60 fps with a 16:9 image format.
- K. Network:
 - 1. Protocols: IPv4, IPv6, UDP, TCP, HTTP, HTTPS, RTP/RTCP, IGMP V2/V3, ICMP, ICMPv6, RTSP, FTP, Telnet, ARP, DHCP, SNMP, SNMP (V1, MIB-II), 802.1x, DNS, DNSv6, DDNS, SMTP, iSCSI, UPnP (SSDP), DiffServ (QoS), LLDP, SOAP, Dropbox, CHAP, Digest Authentication.
 - 2. Encryption: AES with 256-bit keys, RSA, HTTPS
 - 3. Ethernet: STP, 10/100 Base-T, auto-sensing, half/full duplex, RJ45
 - 4. PoE Supply: IEEE 802.3af compliant
- L. Connectivity:
 - 1. ONVIF Profile S, G, T and M
 - 2. Auto-MDIX
- M. Intelligent Video Analytics Pro (IVA Pro)
 - 1. Configurations:
 - a. Silent VCA / Profile1/2 / Scheduled / Event Triggered
 - 2. Alarm rules (combinable):
 - a. Any object / Object in Field / Line Crossing / Enter/Leave field / Loitering / Follow route / idle/remove object / Counting / Occupancy / Crowd density estimation / Condition change / similarity search
- N. Operating Temperature: -40°C to +55°C (-40°F to 131°F)
- O. Operating Humidity: 0% to 90% relative humidity
- P. Water Protection: IP66
- Q. Impact Protection: IK10
- R. Model:
 - 1. Bosch NDE-5702-A series with mounting accessories as required

**NEBRASKA DEPARTMENT OF CORRECTIONAL SERVICES
COMMUNITY CORRECTION CENTER LINCOLN
SECURITY CAMERA SYSTEM UPGRADE
LINCOLN, NEBRASKA**

2.5 MAXIMUM SECURITY CELL CORNER CAMERA (6MP)

- A. The ruggedized, vandal resistant MP POE camera shall be a corner mount, no-grip design with a microSD card slot that uses standard; off-the-shelf microSD (SDHC and SDXC) cards for local storage (up to 2 TB) and be enclosed in a cast-aluminum housing. It shall be able to view the entire floor and all four walls of a 15 foot square room, including the two walls to which it is attached and have a night-time IR monochrome mode and built in microphone and IR illuminators.
- B. Image Sensor: 1/1.8-inch CMOS MP image sensor with mechanical filter technology for vivid daytime color and effective night-time performance under infrared illumination.
- C. Lens: 2.5 mm allowing a full 131° H-FoV and 96° V-FoV of the entire room.
- D. Camera processing latency: <55 ms
- E. Dynamic Range: 120 dB
- F. Audio
 - 1. Standard:
 - a. AAC
 - b. G.711, 8 kHz sampling rate
 - c. L16, 16 kHz sampling rate
 - 2. Signal-to-Noise Ratio: >50 dB
 - 3. Audio input: Built in Microphone and Line Level In
 - 4. Audio output: Line out
 - 5. Audio Streaming: Full duplex / Half duplex
- G. Light sensitivity (based on 3200K, Scene Reflectivity 89%, 30 IRE)
 - 1. Color: 0.090 lx
 - 2. Monochrome: 0.0 lx (IR on)
- H. Content-based Imaging Technology (C-BIT) and Intelligent Dynamic Noise Reduction (iDNR) technology to reduce the bitrate and storage requirements by removing noise artifacts.
- I. Resolution: 2816X2112 (6 MP) sensor at 30 FPS.
- J. IR Illumination: 940nm IR LED's with Smart IR for sensitivity adjustment
- K. Network:
 - 1. Protocols: IPv4, IPv6, UDP, TCP, HTTP, HTTPS, RTP, IGMP V2/V3, ICMP, RTSP, FTP, Telnet, ARP, DHCP, SNTP, SNMP (V1, MIB-II), 802.1x, SMTP, iSCSI, UPnP (SSDP)
 - 2. Encryption: The camera shall offer three levels of password protection, support 802.1x authentication using a RADIUS (Remote Authentication Dial In User Service) server, store a SSL certificate for use with HTTPS, and be capable of being independently AES encrypted with 128-bit keys.
 - 3. Ethernet: STP, 10/100 Base-T, auto-sensing, half/full duplex, RJ45
 - 4. PoE Supply: IEEE 802.3af Type-1 compliant
- L. Connectivity:
 - 1. ONVIF Profile S, G, M, T
 - 2. Auto-MDIX
- M. Intelligent Video Analytics Pro (IVA Pro)
 - 1. Configurations:
 - a. Silent VCA / Profile1/2 / Scheduled / Event Triggered
 - 2. Alarm rules (combinable):
 - a. Any object / Object in Field / Line Crossing / Enter/Leave field / Loitering / Follow route / idle/remove object / Counting / Occupancy / Crowd density estimation / Condition change / similarity search
- N. Operating Temperature: -10°C to +50°C (14°F to 122°F)
- O. Operating Humidity: 5% to 93% relative humidity
- P. Water/Dust Protection: IP66
- Q. Impact Protection: IK10+
- R. Model:

**NEBRASKA DEPARTMENT OF CORRECTIONAL SERVICES
COMMUNITY CORRECTION CENTER LINCOLN
SECURITY CAMERA SYSTEM UPGRADE
LINCOLN, NEBRASKA**

1. Bosch NCE-7703-FK (6MP) series with mounting accessories as required

2.6 5MP MINIDOME CAMERAS

- A. The Vandal resistant 5MP camera shall have a microSD card slot that uses standard; off-the-shelf microSD (SDHC and SDXC) cards for local storage (up to 2 TB) and be enclosed in a cast-aluminum housing with an aluminum trim ring and a clear polycarbonate dome bubble (with UV blocking anti-scratch coating) and be capable of operating in an indoor or an outdoor environment.
- B. Image Sensor: 1/2.7-inch CMOS image sensor.
- C. Lens: 3.2-10.5mm motorized automatic zoom and focus (remote varifocal) lens with an advanced iris design. Horizontal field of view shall be 29 to 96 degrees and vertical field of view shall be 22 to 71 degrees minimum.
- D. Camera processing latency: <55 ms
- E. Dynamic Range: 120 dB HDR
- F. Compression: H.265 MP, H.264 MP, M-JPEG
- G. Audio
 1. Standard:
 - a. AAC
 - b. G.711, 8 kHz sampling rate
 - c. L16, 16 kHz sampling rate
 2. Signal-to-Noise Ratio: >50 dB
 3. Audio Streaming: Full duplex / Half duplex
- H. Light sensitivity (measured according to IEC 62676 Part 5 (1/25, F1.6):
 1. Color: 0.060 lx
 2. Monochrome: 0.012lx
- I. Content-based Imaging Technology (C-BIT), Intelligent streaming and Intelligent Dynamic Noise Reduction (iDNR) technology to reduce the bitrate and storage requirements by removing noise artifacts.
- J. Resolution: 2688X1944 pixels (MP 5MP) at 30 fps with a 4:3 image format, 2592X1456 pixels (MP 3.8MP) at 30 fps with a 16:9 image format, and 1920 x 1080 (HD 1080P) at 30 fps with a 16:9 image format.
- K. Network:
 1. Protocols: IPv4, IPv6, UDP, TCP, HTTP, HTTPS, RTP/RTCP, IGMP V2/V3, ICMP, ICMPv6, RTSP, FTP, Telnet, ARP, DHCP, SNMP, SNMP (V1, MIB-II), 802.1x, DNS, DNSv6, DDNS, SMTP, iSCSI, UPnP (SSDP), DiffServ (QoS), LLDP, SOAP, Dropbox, CHAP, Digest Authentication.
 2. Encryption: AES with 256-bit keys, RSA, HTTPS
 3. Ethernet: STP, 10/100 Base-T, auto-sensing, half/full duplex, RJ45
 4. PoE Supply: IEEE 802.3af compliant
- L. Connectivity:
 1. ONVIF Profile S, G, T and M
 2. Auto-MDIX
- M. Intelligent Video Analytics Pro (IVA Pro)
 1. Configurations:
 - a. Silent VCA / Profile1/2 / Scheduled / Event Triggered
 2. Alarm rules (combinable):
 - a. Any object / Object in Field / Line Crossing / Enter/Leave field / Loitering / Follow route / idle/remove object / Counting / Occupancy / Crowd density estimation / Condition change / similarity search
- N. Operating Temperature: -40°C to +55°C (-40°F to 131°F)
- O. Operating Humidity: 0% to 90% relative humidity
- P. Water Protection: IP66
- Q. Impact Protection: IK10

**NEBRASKA DEPARTMENT OF CORRECTIONAL SERVICES
COMMUNITY CORRECTION CENTER LINCOLN
SECURITY CAMERA SYSTEM UPGRADE
LINCOLN, NEBRASKA**

R. Model:

1. Bosch NDE-5703-A series with mounting accessories as required

2.7 12MP 180/360 DEGREE PANORAMIC CAMERA

1. The panoramic camera shall be available in a 360 degree model, offer Content-based Imaging Technology (CBIT), utilize Intelligent Dynamic Noise Reduction (iDNR) technology to reduce the bitrate and storage requirements by removing noise artifacts, accept power via Power over Ethernet (IEEE 802.3af compliant), and offer optional Intelligent Video Analysis (IVA).
2. The camera shall offer a 1/2.3-inch CMOS image sensor, 12MP sensor pixels (9MP used pixels).
3. The camera shall provide direct network connection, allow full camera control and configuration capabilities over the network, be capable of capturing and storing images using the following compression standards:
 - a. H.264
 - b. H.265
 - c. M-JPEG
4. Video performance – Sensitivity (Measured according to IEC 62676 Part 5): color 0.150lx, monochrome 0.048lx, with IR, 0 lx
5. Wide Dynamic Range: 120dB
6. Built-in IR: 360 degree LED high efficiency array, 850nm, 20M (66 foot) range, 5 controllable zones
7. The camera shall deliver video over a 10/100 Base-T, auto-sensing, half/full duplex, RJ45 Ethernet connection, comply with the IEEE 802.3af
8. The camera shall be capable of processing and analyzing video within the camera itself, with no extra hardware required, be capable of detecting and sending alarms for abnormal events, and allow users to set up separate profiles, and switch profiles based on day/night or holiday schedules.
9. The camera shall offer three levels of password protection, support 802.1x authentication using a RADIUS (Remote Authentication Dial In User Service) server, store a SSL certificate for use with HTTPS, and be capable of being independently AES encrypted with 128-bit keys.
10. The camera shall support iSCSI devices to allow video stream to be recorded directly to an iSCSI RAID array, support iSCSI storage targets to enable the camera to function as a conventional DVR, have a microSD card slot that uses standard; off-the-shelf microSD (SDHC and SDXC) cards for local storage (up to 2 TB), and the local storage feature shall be capable of storage for Automatic Network Replenishment (ANR).
11. The camera shall have an integrated array with 3 digital MEMS audio sensors offer two-way, full duplex audio communication, and offer G.711, AAC and L16 audio compression (live and recording).

**NEBRASKA DEPARTMENT OF CORRECTIONAL SERVICES
COMMUNITY CORRECTION CENTER LINCOLN
SECURITY CAMERA SYSTEM UPGRADE
LINCOLN, NEBRASKA**

12. The camera shall provide a full circle image (3008 X 3008) as well as two distortion-free channels with their own streams. One of these channels is an E-PTZ channel which is always available. Viewing options for the second channel shall include full panoramic, double panoramic, Quad Corridor, E-PTZ.
13. The camera shall be ONVIF Profile S, ONVIF Profile D, ONVIF Profile M and ONVIF Profile T compliant.
14. Operating Temperature: -40°C to +50°C (-40°F to 122°F)
15. Model:
 - a. Bosch NDS-5704-F360LE

2.8 20MP MULTI-SENSOR ADJUSTABLE CAMERA

- A. The multi-sensor adjustable dome network camera shall be outdoor (IP66) and vandal rated (IK10) and capable of operating in an indoor and an outdoor environment, capture very high quality images with a total resolution of 20MP via four independent 5MP CMOS sensors, require a single IP address, accept power via Power over Ethernet (POE+), contain a built-in microphone, and incorporate built-in intelligent Video Analytics capability.
- B. The camera shall offer 4X CMOS image sensor, 5MP sensor pixels.
- C. The camera shall provide direct network connection, allow full camera control and configuration capabilities over the network, be capable of capturing and storing images using the following compression standards:
 1. H.264 (Baseline)
 2. H.265 (Baseline)
 3. MJPEG
- D. The camera shall deliver video over a 10/100 Base-T, auto-sensing, half/full duplex, RJ45 Ethernet connection
- E. The camera shall be capable of processing and analyzing video within the camera itself, with no extra hardware required, be capable of detecting and sending alarms for abnormal events, and allow users to set up separate profiles, and switch profiles based on day/night or holiday schedules.
- F. The camera shall offer password protection, support IEEE 802.1x authentication, and store a SSL certificate for use with HTTPS.
- G. The camera shall have an integrated microphone and offer two-way bi-directional audio communication.
- H. The camera shall provide four images that enable 360 degree coverage capturing images from every angle for comprehensive video coverage with 4 separate views from a single IP address.
- I. Maximum frame rate: 30 FPS
- J. Lens: 3.7 to 7.7mm, F1.9 with viewing angle of 88.8 to 40.2 H and 59.8 to 28.6 V

**NEBRASKA DEPARTMENT OF CORRECTIONAL SERVICES
COMMUNITY CORRECTION CENTER LINCOLN
SECURITY CAMERA SYSTEM UPGRADE
LINCOLN, NEBRASKA**

- K. Light sensitivity: 0.095 lx in color mode and 0.005 lx in monochrome mode
- L. Dynamic range: 120dB
- M. Edge Storage: via SD/SDHC memory card (sold separately)
- N. The camera shall be ONVIF Profile S and G compliant.
- O. IP66 weatherproof rating and IK10 vandal resistance rating.
- P. Operating Temperature: -40°C to +50°C (-40°F to 122°F)
- Q. Model:
 - 1. Bosch NDM-7703-A with accessories and mounts as required

2.9 34MP 360 DEGREE MULTI-DIRECTIONAL MULTI-SENSOR CAMERA WITH PTZ

- A. Manufacturer: Hanwha Vision
 - 1. Model: PNM-C34404RQPZ
 - 2. Or equal and fully compatible with the BVMS

2.10 10MP DUAL SENSOR CAMERA

- A. Manufacturer: Hanwha Vision
 - 1. Model : PNM-9000VD
 - 2. Or equal and fully compatible with the BVMS

2.11 43-INCH-HIGH PERFORMANCE HD LCD MONITOR

- A. Video
 - 1. The HD monitor shall support Full HD 1080p resolution (1920 x 1080), menu controls to adjust video features, and automatic detection of a PAL or an NTSC signal, and display images using an aspect ratio of 16:9 and be capable of displaying 16.7 million colors.
- B. Electrical:
 - 1. Rated Voltage: 120/230 VAC, 50/60 Hz
 - 2. Voltage Range: 100–240 VAC, 50/50 Hz
 - 3. Frequency:
 - a. Horizontal: 60–73 KHz
 - b. Vertical: 47–63 Hz
 - 4. Power at Rated Voltage:
 - a. On: <75 W

**NEBRASKA DEPARTMENT OF CORRECTIONAL SERVICES
COMMUNITY CORRECTION CENTER LINCOLN
SECURITY CAMERA SYSTEM UPGRADE
LINCOLN, NEBRASKA**

b. Standby: 0.5 W

C. Video:

1. Sync Format: PAL/NTSC
2. LCD Panel: LED
3. Viewable Picture Area: 42.5 in, measured diagonally
4. Active Display Area (H x V): 940.90 x 529.25 mm (37.04 x 20.84 in.)
5. Resolution: 1920 x 1080 pixels
6. Aspect Ratio: 16:9
7. Display Colors: 16.7 million colors
8. Response Time: 8 milliseconds (typical)
9. Backlight: 50,000 hours

D. Optical Characteristics

1. Luminance: 400 cd/m² (typical)
2. Contrast Ratio: 3000:1 (typical)
3. Viewing Angle:
 - a. Horizontal: 178°
 - b. Vertical: 178°

E. Connectors

1. DisplayPort: One DisplayPort
2. Digital: One DVI-D in
3. HDMI: One HDMI in
4. VGA:
 - a. One RGB 15-pin D-sub in
 - b. One RGB 15-pin S-sub out
5. Audio: One RCA in (right/left)
 - a. Two Audio in: RCA (left/right)
 - b. One Audio in: phono jack
 - c. One Audio out: RCA (left/right)

**NEBRASKA DEPARTMENT OF CORRECTIONAL SERVICES
COMMUNITY CORRECTION CENTER LINCOLN
SECURITY CAMERA SYSTEM UPGRADE
LINCOLN, NEBRASKA**

- d. One speaker out
- 6. Trigger Input: One 1/8 in. mini phono plug
- 7. Power Input: 100-240 VAC.
- F. Mechanical:
 - 1. Cabinet Material: SECC
 - 2. Finish: Black
 - 3. Mount: Wall mounting compatible with standard bracket
 - 4. VESA Mounting Compliance: 200 x 200 mm and 400 x 200mm
 - 5. Dimensions:
 - a. Monitor: 978.3 x 568.8 x 74.7 mm (38.52 x 22.39 x 2.94 in.)
 - 6. Weight:
 - a. Monitor Weight: 18.6 kg (41 lb)
 - b. Shipping Weight: 24.4 kg (53.8 lb)
- G. Environmental:
 - 1. Operating Temperature: 0° to +50°C (32° to 122°F)
 - 2. Storage Temperature: 0° to +50°C (32° to 122°F)
 - 3. Humidity: Maximum 0% to 90% relative
- H. Model:
 - 1. Bosch UML-434-90 with appropriate mount

2.12 27-INCH-HIGH PERFORMANCE HD LED MONITOR (ADD#1)

A. Video

- 1. **The industrial grade 4K monitor shall support Full 4K resolution (3840 x 2160), feature a 3-D comb filter, and display images using an aspect ratio of 16:9 and be capable of displaying 1.07 billion colors.**

B. Electrical/Mechanical

- 1. **Main Supply Input Voltage: 100–230 VAC, 50/60 Hz**
- 2. **Monitor Input Voltage/Power Requirements: 90–264 VAC, 50/60 Hz**
- 3. **Power at Rated Voltage:**
 - a. **Operation: 29.2 W**

**NEBRASKA DEPARTMENT OF CORRECTIONAL SERVICES
COMMUNITY CORRECTION CENTER LINCOLN
SECURITY CAMERA SYSTEM UPGRADE
LINCOLN, NEBRASKA**

b. Standby: .5 W

4. The 4K monitor shall conform to the 75 x 75 mm VESA Mounting standard.

C. Video:

1. LCD Panel: LED

2. Viewable Picture Area: 27 in, measured diagonally

3. Resolution: 3840 x 2160 pixels

4. Aspect Ratio: 16:9

5. Display Colors: 1.07 billion colors

6. Response Time: 12 milliseconds

7. Backlight rated life 30,000 hours

D. Optical Characteristics

1. Luminance: 200 cd/m²,

2. Contrast Ratio: 1000:1

3. Viewing Angle:

a. Horizontal: 178°

b. Vertical: 178°

E. Connectors

1. HDMI

2. Display Port

3. USB

4. Audio:

a. One (1) PC stereo input

5. Power Cord: Two 3-wire with a grounded plug, 1.8 m (6 ft) long.

F. Mechanical:

1. Dimensions:

a. Monitor Only: 615.11 x 428.40 x 219.70 mm (24.22 x 16.87 x 8.65 in.)

2. Weight:

a. Monitor Weight: 6.1 kg (13.45 lbs)

**NEBRASKA DEPARTMENT OF CORRECTIONAL SERVICES
COMMUNITY CORRECTION CENTER LINCOLN
SECURITY CAMERA SYSTEM UPGRADE
LINCOLN, NEBRASKA**

G. Environmental:

- 1. Operating Temperature: 0° to 40°C (32° to 104°F)**
- 2. Storage Temperature: 0° to +50°C (32° to 122°F)**
- 3. Humidity: Maximum 90%, non-condensing**

H. Model:

- 1. Bosch UML-275-90 with appropriate mount**
- 2. Or EQUAL**

2.13 HD VIDEO DECODER (ADD#1)

A. The HD video decoder specified shall be capable of functioning on data networks, such as Ethernet LANs and over the Internet and shall be capable of decoding high definition and standard definition streams using H.265, H.264 or MPEG-4 compression technology at up to 60 ips.

B. The HD video decoder shall be capable of decoding four (4) 4KP30 streams at 32Mbps or eight(8) 1080P30 streams at 8 Mbps or twenty two (22) H.264 SD streams with up to 2Mbps each.

C. The HD decoder specified shall be provided by the manufacturer complete with configuration cables, Installation and Operations Manuals, and safety instructions.

D. System Specifications

- 1. The HD decoder shall be based on the Intel seventh generation Core i3 CPU**
- 2. The HD decoder shall offer a Gigabyte Ethernet port.**
- 3. The HD decoder shall run a tailored Microsoft Windows 10 Embedded operating system.**
- 4. The HD decoder shall include Bosch Monitor Wall software based on the Bosch VideoSDK 6**

E. Monitor Support

- 1. The HD video decoder shall be capable of driving two (2) 4K UHD display devices via one HDMI and one mini DisplayPort**
- 2. The HD decoder shall be capable of displaying four (4) high definition streams in a quad-view display.**
- 3. The HD decoder shall be capable of switching screen layouts independently based on the controlling video management system.**

F. Video:

- 1. Video Outputs: 2 simultaneous**

**NEBRASKA DEPARTMENT OF CORRECTIONAL SERVICES
COMMUNITY CORRECTION CENTER LINCOLN
SECURITY CAMERA SYSTEM UPGRADE
LINCOLN, NEBRASKA**

2. Connectors: HDMI and Mini DisplayPort 1.2

3. Video Compression Standards:

- a. H.265
- b. H.264
- c. MPEG-4

4. Data Rates:

- a. MP: Up to 32 Mbps
- b. 4K UHD: Up to 32 Mbps
- c. HD: Up to 20 Mbps
- d. SD: Up to 6 Mbps per stream

5. GOP structure: I, IP, IBBP

6. Monitor Resolutions:

- a. DP: 3840 x 2160 maximum (UHD) at 60 Hz

G. Network

- 1. Ethernet: 10/100/1000 Base-T, auto-sensing, half/full duplex, RJ45
- 2. Protocols: RTP, Telnet, UPD, TCP, IP, HTTP, HTTPS, DHCP, IGMP V2/V3, ICMP, ARP, SNTP, SNMP (V1, MIB-II)
- 3. Encryption: TLS 1.0, SSL, AES (optional)

H. Models:

- 1. Bosch VJD-7513

2.14 QUAD MONITOR WORKSTATION

- A. Provide HP Z4 G5 management workstation with Intel's Xeon W3-2423 (2.6 GHz, 2666 MHz memory speed, 6C CPU), 16 GB ECC Registered Memory and NVIDIA Quadro T1000 (8 GB) graphics card ensures highest performance and resolution for fast presentation of displayed video data in a convertible mini-tower chassis with 750w, 90% efficient, custom PSU.
- B. Microsoft Windows 11 Professional Edition, 64-bit OS
- C. 512GB, PCIe solid state hard drive
- D. 4 Mini Display Ports
- E. Provide with HP 5-year Next Business Day on-site hardware warranty.
- F. Model:

**NEBRASKA DEPARTMENT OF CORRECTIONAL SERVICES
COMMUNITY CORRECTION CENTER LINCOLN
SECURITY CAMERA SYSTEM UPGRADE
LINCOLN, NEBRASKA**

1. Bosch MHW-WZ4G5-HEN3
2. Dell
3. HP

2.15 SERVER

- A. Provide as required for BVMS and VRM.
- B. HP ProLiant DL380 Generation 10 (G10) Server with hot plug fans and power supplies, and RAID controller with RAID-1 operating system protection. One (1) state-of-the-art eight-core Intel Xeon Silver 4208 Processor (2.1 GHz, 8 core, 85 W, and 16 (1 X 16 GB PC3L-10600R (DDR4-2666) Registered DIMMs. 1 x Four Port Gigabit Server Adapter.
- C. Microsoft Windows Server 2019 Standard Edition, 64-bit OS
- D. Provide a 3–year standard warranty.
- E. The server shall come in a 2U, 19-inch rack mount version with a quick deploy rail system, including sliding universal rails. The rack mount version allows access to all system components for easy in-rack serviceability.
- F. Model:
 1. Bosch MHW-S380RA-SC
 2. Dell
 3. HP

2.16 ISCSI STORAGE DEVICES

- A. General Characteristics:
 1. The IP Video Storage System shall be an embedded, all-in-one IP Video Storage subsystem that provides “plug-and-play” iSCSI-based recording and management, pre-configured and pre-installed iSCSI disk array, 2U or 3U rack-mount chassis with eight (8), twelve (12) or sixteen (16) hot swappable, SATA-3 hard disk drives with RAID-5/RAID-6 protection,
 2. The IP Video Storage System shall be a pre-configured and pre-installed video management solution with 32TB (8X4) 64TB (8X8), 144TB (8X18), 216TB (12X18) or 288TB (16X18) of gross storage capacity, and a bandwidth of 550 Mbit/s.
 3. The IP Video Storage System shall offer a dual port Gigabit Ethernet network interface, 16 GB system memory and an Intel Xeon Quad Core Processor, remote monitoring via a desktop application or a Web browser.
- B. Processor
 1. The IP Video Storage Appliance shall contain an Intel Core I7-12700E Processor 25MB Intel Smart Cache; 2.10GHz processor.

**NEBRASKA DEPARTMENT OF CORRECTIONAL SERVICES
COMMUNITY CORRECTION CENTER LINCOLN
SECURITY CAMERA SYSTEM UPGRADE
LINCOLN, NEBRASKA**

2. The IP Video Storage Appliance processor shall include ECC Unbuffered memory protection.

C. Memory

1. The IP Video Storage Array shall have 16 GB, DDR5-4800 ECC UDIMM of memory installed.

D. Storage

1. The IP Video Storage Appliance shall contain eight (8), twelve (12) or sixteen (16) 3.5 in. SATA storage trays.
2. The IP Video Storage Appliance shall have 8, 12 or 16, 4, 8 or 18 TB SATA-3 (7,200 RPM, 64 MB 3.5 in.) hard drives installed.
3. The IP Video Storage Appliance shall offer a 12 Gb/s Sixteen-Port RAID card.
4. The IP Video Storage Appliance shall include 2 X 480 GB SSD RAID-1 OS hard drives

E. Functions

1. The IP Video Storage Appliance shall feature a single-socket system, server-class motherboard.
2. The IP Video Storage Appliance shall offer an energy-efficient hot-swap redundant power supply.
3. The IP Video Storage Appliance shall offer hot-swap SATA-3 hard drives providing up to 288 TB of gross storage capacity.
4. The IP Video Storage Appliance shall come pre-installed and pre-configured with all necessary software.
5. The IP Video Storage Appliance shall utilize Microsoft Windows Server IoT 2022 for Storage Standard.

F. Management

1. The IP Video Storage Appliance shall come with Bosch VMS management application pre-configured and pre-licensed
2. The IP Video Storage Appliance shall allow operators to use one central tool for configuration and operations management.

G. Monitoring

1. The IP Video Storage Appliance shall provide SNMP, Remote Desktop and HTTP monitoring support.
2. The IP Video Storage Appliance shall offer high-availability hardware, embedded design, and system wide monitoring.

H. Electrical:

1. Input Voltage: 120/240 VAC

**NEBRASKA DEPARTMENT OF CORRECTIONAL SERVICES
COMMUNITY CORRECTION CENTER LINCOLN
SECURITY CAMERA SYSTEM UPGRADE
LINCOLN, NEBRASKA**

- a. Actual Output Wattage from Power Supply: 292 W
 - b. Efficiency of Power Supply: 93%
 - c. Total System Power Consumption: 314 W
 - d. Total BTU/h: 1071
 - e. Power Factor: .98
 - f. System AC Input VA Requirement: 320 VA
- I. Mechanical
1. Form Factor: 2U or 3U Rack Mount
 2. Power Supply: 800 W Platinum Level redundant
 3. USB Ports: 4; 2 in rear, 2 in front, USB 3.2 Gen 1 ports
 4. Network: Dual Intel® i210AT Gigabit LAN (teamed), 1 IPMI BMC port
 5. Dimensions (H x W x D): 660 x 448 x 88 mm (25.5 x 17.6 x 3.4 in (2RU) or 5.2 in(3RU).)
- J. Environmental:
1. Operating Temperature: +0°C to +40°C (+32°F to +104°F)
 2. Operating Relative Humidity: 8 to 90%, non-condensing
- K. Model:
1. Bosch Divar IP 7400 series with accessories and licenses as required

2.17 VIDEO MANAGEMENT SYSTEM

- A. The video management system (VMS) specified is an enterprise-class client/server based IP video security solution that provides seamless management of digital video, audio and data across an IP network. The video management system is designed to work with ONVIF compliant 3rd party products as part of a total video security management system to provide full virtual matrix switching and control capability. The video management system consists of the following software modules: management server, recording services, configuration client and operator clients. Video from other sites may be viewed from single or numerous workstations simultaneously at any time. Cameras, recorders, and viewing stations may be placed anywhere in the IP network.
- B. The VMS shall support the following recording services:
1. Video Recording Manager (VMS VRM)
 2. Local Storage and Direct-to-iSCSI recording
- C. The management server and the Video Recording Manager shall run as services on Windows Server 2019.

**NEBRASKA DEPARTMENT OF CORRECTIONAL SERVICES
COMMUNITY CORRECTION CENTER LINCOLN
SECURITY CAMERA SYSTEM UPGRADE
LINCOLN, NEBRASKA**

- D. The configuration client software shall run as an application on Windows Server 2019.
- E. The operator client software shall run as an application on Windows 10.
- F. The VMS shall support ONVIF compliant cameras. It shall be possible to access live streams and to control PTZ functionality.
- G. It shall be possible to record Onvif compliant cameras. For recording only, 3rd party cameras that support JPEG or RTSP shall be supported.
- H. The VMS shall provide a transcoding service for supporting iPad and iPhone devices as well as html5 based web clients as mobile video clients.
- I. Mobile video clients shall be able to access live and recording data of all cameras in the video management system. It shall be possible to view up to 4 video streams at once on a web client or iPad and mix live and playback streams. The mobile video clients shall further more provide an option for the user to zoom in as well as to opt between high resolution and smooth motion (higher rate of frames per second). It shall be possible to access the video management system from mobile video clients with the user accounts in the video management system.
- J. The VMS shall be scalable to an Enterprise Management System that allows a user of an operator client to simultaneously access the devices of multiple subsystems. Each subsystems shall contain 1 management server. The Enterprise Management Server shall manage up to 10 subsystems. If each subsystem is restricted to 100 cameras, the number of subsystems may be extended to 30 Subsystems. Access permissions of Enterprise Operator Clients to subsystems and their devices shall be managed within the subsystems by means of a user ID and PW. Enterprise Operator Clients can than only access subsystems, when respective user ID and PW and set correctly in their Enterprise User group. An Enterprise Management Server shall be able to provide 20 Enterprise Management User groups. A change in a subsystem's configuration shall be automatically reflected for the Enterprise Operator Client. Extensions in the subsystems shall not require any additional licensing within the dedicated Enterprise Management Server.
- K. The VMS shall provide a documented Software Development Kit (SDK) to allow integration to and integration from third-party software.
- L. The VMS specified shall be a centrally managed, scalable client/server based architecture that allows full virtual matrix switching and control systems.
- M. The VMS shall be capable to be deployed in Local Area Networks (LAN) as well as in Wide Area Networks (WAN). For establishing remote connections across WAN, it shall be possible to setup a port mapping table within the configuration manager in order to map the public port to a private IP and port of the devices. The VMS shall provide a RRAS configuration tool to transfer the port mapping table to a RRAS Service.
- N. The VMS shall allow a operator client to control and view live and playback streams of cameras allocated to the VRM, VSG and DVRs from a remote site (across WAN). This includes ONVIF cameras connected to the VSG.
- O. The VMS shall provide the possibility to the operator to view transcoded video streams (live and playback) in order view high quality images, when the remote operator client accesses the camera via a low bandwidth connection. On selection, there shall be an indication in the image pane of the operator client to indicate, that the stream is being transcoded.

**NEBRASKA DEPARTMENT OF CORRECTIONAL SERVICES
COMMUNITY CORRECTION CENTER LINCOLN
SECURITY CAMERA SYSTEM UPGRADE
LINCOLN, NEBRASKA**

- P. The VMS shall provide a built-in command script editor that allows customized command scripts to be written to control virtually all the system functions. Command scripts may be activated by system operators or automatically in response to alarms or system events. The built-in command script editor shall support C# and VB.NET.
- Q. The VMS shall emulate the Matrix Command Console Language (CCL). The VMS shall receive the CCL commands on a freely definable serial port on the management server. It shall be possible to select the Allegiant model that shall be emulated. CCL commands shall control:
 - 1. Camera to decoder connections
 - 2. Sequences on decoders
 - 3. Virtual Inputs
 - 4. PTZ commands
- R. The VMS shall support all Security Systems MPEG-4 and H.264 encoders, decoders, IP cameras, and IP AutoDomes.
- S. The VMS shall provide up to 10 different and independent programmable recording schedules. The schedules may be programmed to provide different record frames rates for day, night, and weekend periods as well as special days. Advanced task schedules may also be programmed that could specify allowed logon times for user groups, when events may trigger alarms, and when data backups should occur.
- T. The VMS shall allow the establishment of user groups and Enterprise user groups that have access rights to specific cameras, priority for pan/tilt/zoom control, rights for exporting video, and access rights to system event log files. Access to live, playback, audio, PTZ control, preset control, and auxiliary commands shall be programmable on an individual camera basis.
- U. The VMS shall interface with the Intelligent Video Analysis (IVA) techniques of the Bosch IP encoders and IP cameras to provide advanced motion detection that analyzes object size, direction, and speed as well as detecting objects entering or leaving designated areas.
- V. The VMS shall support Lightweight Directory Access Protocol (LDAP) that allows integration with enterprise user management systems such as Microsoft Active Directory.
- W. The VMS shall export video and audio data optionally in ASF format to a CD/DVD drive, a network drive, or a USB drive. The exported data in ASF format may be played back using standard software such as Windows Media Player. It shall also export video and audio data optionally in its native recording format to a CD/DVD drive, a network drive, or a direct attached drive. The exported data in native recording format shall include all associated metadata. Viewer software shall be included with the export. Once installed, the viewer software allows playback of the streams on any compatible Windows PC.
- X. The VMS shall auto-discover encoder, decoder, VRM devices and DVRs. Device detection shall support devices in different subnets.
- Y. The VMS shall support continuous operation during management server down-times as live viewing, playback of recording and export of video data. The operator client shall indicate its connection status to the management server.

**NEBRASKA DEPARTMENT OF CORRECTIONAL SERVICES
COMMUNITY CORRECTION CENTER LINCOLN
SECURITY CAMERA SYSTEM UPGRADE
LINCOLN, NEBRASKA**

- Z. The VMS software shall be maintenance free and provide free software upgrades, patches and firmware. Software with annual maintenance agreements shall not be allowed

AA. Model:

- 1. Bosch Video Management Software MBV-BPRO-12.1 or equal software with expansion licenses as required by project.

2.18 VIDEO RECORDING MANAGER

- A. The VMR shall be an optional package of the installation program of the VMS.
- B. The video management system shall be capable of managing multiple VRMs.
- C. The VRM shall be configured from the VMS configuration client. It shall be possible to assign encoders and IP cameras to it.
- D. The recording parameters shall be configured in the recording tables of the VMS configuration program. These settings will be replicated into the devices from the management server.
- E. The VRM shall manage any encoders, IP-Cameras, Streaming Gateways, and the iSCSI storage systems. It shall offer system wide recording monitoring and management of iSCSI storage, video servers and cameras.
- F. The VRM shall support the encoders and cameras to directly stream the data to the iSCSI storage. The VRM shall not be involved in the processing of the data.
- G. The VRM shall manage all disk arrays in the system as a single virtual common pool of storage. It shall dynamically assign portions of that pool to the encoders and IP-Cameras.
- H. The transfer rate of the data from the encoder or IP-Camera is limited by network speed and the iSCSI data throughput rate.
- I. The VRM shall provide redundancy for storage provisioning and failover design for central recording management service.
- J. The VRM shall be able to restore a lost recording database from data on the iSCSI storages.
- K. The VRM shall provide flexible retrieval of recordings. It shall be able to determine on which iSCSI disk array data from each camera or encoder has been stored.
- L. It shall be possible to secure the access to the VRM software with a password. This shall be done in the configuration client.
- M. The VRM software shall provide status monitoring information as a web interface. The following information shall be provided:
 - 1. Uptime of the VRM software
 - 2. Bit rate information for the recorded data
 - 3. Retention times per camera
 - 4. Status on recording and storage

**NEBRASKA DEPARTMENT OF CORRECTIONAL SERVICES
COMMUNITY CORRECTION CENTER LINCOLN
SECURITY CAMERA SYSTEM UPGRADE
LINCOLN, NEBRASKA**

- N. The video management system shall allow configuring if playback of recordings is streamed through the VRM or is streamed directly from the iSCSI storage.
- O. The video management system shall support to retrieve the playback information, i.e. from which iSCSI storages to retrieve the video, audio and meta-data, either from the Video Recording Manager or directly from the IP encoder or camera. Playback information directly from the IP encoder or camera is limited in time and should be used while the VRM is not available to increase the reliability of the video management system.
- P. Model:
 - 1. Bosch Video Recording Manager (VRM) 4.03.0025 or the latest available

2.19 EDGE ETHERNET SWITCH (PROVIDED BY THE OWNER)

- A. The switch shall support transmission utilizing Category 6 cable or better, multimode fiber, or single-mode fiber. The switch shall support IEEE 802.3 protocol using Auto-negotiating and Auto-MDI/MDI-X features. The switch shall be capable of supporting IEEE 802.3at 30 Watt PoE at each of the 24 (twenty-four) RJ-45 ports, considering the 400 W PoE budget for the switch as a whole. The switch shall have a fully internal power supply. The switch shall feature 22 (twenty-two) dedicated 10/100/1000T(X) RJ-45 ports capable of 802.3at PoE, 2 (two) dedicated 100/1000FX SFP ports, and 2 (two) combo ports, each combo port containing 1 (one) 10/100/1000T(X) RJ-45 port capable of 802.3at PoE and 1 (one) 100/1000FX SFP port
- B. To ease installation, the switch shall require no in-field electrical or optical adjustments or in-line attenuators. The switch shall provide power, link speed, and fiber port status indicating LED's for monitoring proper system operation. The switch shall provide a serial connection for local management of the device. The switch shall have a lifetime warranty to reduce system life cycle cost in an event of a failure.
- C. The following IEEE Networking Standards shall be supported:
 - 1. IEEE 802.3 10Base-T Ethernet
 - 2. IEEE 802.3u 100Base-TX Fast Ethernet
 - 3. IEEE 802.3ab 1000Base-TX Gigabit Ethernet
 - 4. IEEE 802.3at Power over Ethernet
 - 5. IEEE 802.3z Gigabit Ethernet Fiber
 - 6. IEEE 802.3x Flow Control and Back-pressure
 - 7. IEEE 802.1p class of service
 - 8. IEEE 802.1Q VLAN and GVRP
 - 9. IEEE 802.1D-2004 Rapid Spanning Tree Protocol (RSTP)
 - 10. IEEE 802.1s Multiple Spanning Tree Protocol
 - 11. IEEE802.3ad LACP

**NEBRASKA DEPARTMENT OF CORRECTIONAL SERVICES
COMMUNITY CORRECTION CENTER LINCOLN
SECURITY CAMERA SYSTEM UPGRADE
LINCOLN, NEBRASKA**

12. IEEE802.1X Port-based Network Access Control

13. IEEE 802.1AB LLDP

D. Switching Performance

1. Switch Technology: Store and Forward Technology with 52 Gbps Switch Fabric.

2. Transfer Packet Size: 64 bytes to 9600 bytes (with VLAN Tag)

3. MAC Address: 8K MAC

4. Packet Buffer: 1Mbits

5. Relay Alarm: Dry Relay output with 1A@24V ability

E. Management

1. Configuration: Web, HTTPS, SSH, TFTP/Web Update for firmware and configuration backup/restore, DHCP Client, Warm reboot, Reset to default, Admin password, Port Speed/Duplex control, status, statistic, MAC address table display, Static MAC, Aging time, SNMP v1, v2c, v3, Traps and RMON1.

2. SNMP MIB: MIB-II, Bridge MIB, VLAN MIB, SNMP MIB, RMON and Private MIB

3. Port Trunk: Up to 5 Static Trunk and 802.3ad LACP

4. VLAN: IEEE802.1Q VLAN, GVRP. Up to 64 VLAN groups

5. Quality of Service: Four priority queues per port,

6. IEEE802.1p COS and Layer 3 TOS/DiffServ

7. IGMP Snooping: IGMP Snooping V2/V3 for multicast filtering and IGMP Query

8. Rate Control: Ingress filtering for Broadcast, Multicast, Unknown DA or all packets, and Egress filtering for all packets

9. NTP: Network Time Protocol to synchronize time from Internet

10. PTP: Precision Time Protocol for clock synchronization.

11. Port Mirroring: Online traffic monitoring on multiple selected ports

12. Port Security: Assign authorized MAC to specific port

13. IP Security: IP security to prevent unauthorized access

14. 802.1x: Port-based Network Access Control

15. DHCP Server: Can assign 255 IP address, support IP and MAC binding

16. System Log: Supports both Local mode and Server mode

F. Network Redundancy

**NEBRASKA DEPARTMENT OF CORRECTIONAL SERVICES
COMMUNITY CORRECTION CENTER LINCOLN
SECURITY CAMERA SYSTEM UPGRADE
LINCOLN, NEBRASKA**

1. Rapid Spanning Tree Protocol: IEEE802.1D-2004 Rapid Spanning Tree Protocol.
2. Compatible with Legacy STP and IEEE802.1w.
3. Multiple Spanning Tree Protocol: IEEE 802.1s

G. Data Specifications

1. Data Interface: Ethernet IEEE 802.3
2. Data Rate: up to 1000 Mbps
3. Data Inputs/Outputs: up to 26
4. Operation Mode: Half or Full Duplex

H. Specification

1. Number of Optical ports: up to 4 SFP-based
2. Number of Fibers Required: 1 or 2, SFP-dependent
3. Optical Wavelength: 1310 or 1550 nm, SFP-dependent
4. Optical Power Budget: SFP-dependent
5. Maximum Distance: up to 120 km (70 mi) singlemode, SFP-dependent

I. Status Indicators

1. Power: Proper Power = Green
2. RJ-45 Link/Data: Green, No Link/No Data: Off
3. SFP Link/Data: Green, No Link/No Data: Off

J. Connectors

1. Optical: LC or SC, SFP-dependent
2. Power: IEC60320 connector for standard AC line cord.
3. Data: RJ-45
4. Console: DB9 serial communication.

K. Electrical Specifications

1. Power: Internal power supply, 100 to 240 VAC, 50-60 Hz input.
2. PoE Support: 400 watts available for 24 ports with PoE+ (30W available at all 24 ports, not to exceed 400 W total PoE consumption), at a maximum ambient operating temperature of +60° C.

**NEBRASKA DEPARTMENT OF CORRECTIONAL SERVICES
COMMUNITY CORRECTION CENTER LINCOLN
SECURITY CAMERA SYSTEM UPGRADE
LINCOLN, NEBRASKA**

3. Current Protection: Automatic re-settable solid-state current limiters
4. Voltage Regulation: Solid-state, Independent on each board
5. Circuit Board: UL 94 flame rated and meets all IPC standards.

L. Mechanical Specifications

1. 16.97 in (W) x 13.46 in (D) x 1.73 in (H) 431 mm (W) x 342 mm (D) x 44 mm (H)
2. Finish: Module shall be constructed of a metal enclosure with a powder coat.
3. Weight: <13lb/6kg

M. Environmental Specifications

1. MTBF: >100,000 Hours
2. Operating Temp: -10° C to +60° C.
3. Storage Temp: -40° C to +85° C.
4. Relative Humidity: 5% to 95% (non-condensing).

N. REGULATORY AGENCIES/APPROVALS AND LISTINGS

1. Underwriters Laboratory (UL) Listing Number: I.T.E. 6D16
2. Underwriters Laboratory Canada (ULC) Listing Number: I.T.E. 6D16
3. UL 94-flame rated PCB board: 94VO

O. Models:

1. Cisco Catalyst 9200 Series (PoE + Network Essentials)
2. Or Equal

2.20 CORE ETHERNET SWITCH (PROVIDED BY THE OWNER)

A. The core Ethernet switch shall be enterprise-class stackable Ethernet and Multigigabit Ethernet access and aggregation layer switches that provide full convergence between wired and wireless on a single platform. The core Ethernet switch shall support full IEEE 802.3at Power over Ethernet Plus (PoE+), modular and field-replaceable network modules, RJ45 and fiber-based downlink interfaces, and redundant fans and power supplies. With speeds that reach 10Gbps, the core Ethernet switch shall support current and next-generation wireless speeds and standards (including 802.11ac Wave 2) on existing cabling infrastructure. The switch shall support transmission utilizing Category 5 cable or better, multimode fiber, or single-mode fiber.

B. The core Ethernet switch shall be provided with following capabilities:

1. Integrated wireless controller capability with:

**NEBRASKA DEPARTMENT OF CORRECTIONAL SERVICES
COMMUNITY CORRECTION CENTER LINCOLN
SECURITY CAMERA SYSTEM UPGRADE
LINCOLN, NEBRASKA**

- a. Up to 40G of wireless capacity per switch (48-port models)
 - b. Support for up to 50 access points and 2000 wireless clients on each switching entity (switch or stack)
2. 24 and 48 10/100/1000 data PoE+ models with energy-efficient Ethernet (EEE)
 3. 24 and 48 100Mbps/1/2.5/5/10 Gbps UPOE models with energy-efficient Ethernet (EEE)¹
 4. 12- and 24-port SFP-based models
 5. Five optional uplink modules with 4 x Gigabit Ethernet, 2 x 10 Gigabit Ethernet, 4 x 10 Gigabit Ethernet, 8 x 10 Gigabit Ethernet₂ or 2 x 40 Gigabit QSFP₂ ports
 6. Dual redundant, modular power supplies and three modular fans providing redundancy
 7. Full IEEE 802.3at (PoE+) with 30W power on all copper ports in 1 rack unit (RU) form factor
 8. Software support for IPv4 and IPv6 routing, multicast routing, modular quality of service (QoS), Flexible NetFlow (FNF), and enhanced security features
 9. The core Ethernet switch shall be provided with advanced wired plus wireless QoS capabilities. The switch shall manage wireless bandwidth using unprecedented hierarchical bandwidth management starting at the per-access-point level and drilling further down to per-radio, per-service set identification (SSID), and per-user levels. The switch shall be capable of automatically allocating equal bandwidth among the connected users within a given SSID. This makes sure that all users within a given SSID get a fair share of the available bandwidth while being connected to the network. The UADP ASIC enables the hierarchical bandwidth management and fair sharing of bandwidth, thereby providing hardware-based QoS for optimized performance at line-rate traffic.
 10. The core Ethernet switch shall be provided with security features such as IEEE 802.1x, port security, Dynamic Host Configuration Protocol (DHCP) Snooping and Guard, Dynamic ARP Inspection, RA Guard, IP Source Guard, control plane protection (CoPP), wireless intrusion prevention systems (WIPSs), and so on enable protection against unauthorized users and attackers. With a variety of wired plus wireless users connecting to the network, the switch shall supports session-aware networking, in which each device connected to the network is identified as one session, and unique access control lists (ACLs) and/or QoS policies can be defined and applied using the ISE for each of these sessions, providing better control on the devices connecting to the network.
- C. The core Ethernet switches performance capabilities:
1. Switch capacity:
 - a. 176Gps on 48 port model
 - b. 92 Gbps on 24-port models
 - c. 68 Gbps on 12-port model
 2. Stacking bandwidth: 480Gps

**NEBRASKA DEPARTMENT OF CORRECTIONAL SERVICES
COMMUNITY CORRECTION CENTER LINCOLN
SECURITY CAMERA SYSTEM UPGRADE
LINCOLN, NEBRASKA**

3. Total number of MAC addresses: 32,000
 4. Total number of IPv4 routes: 24,000
 5. FNF entries:
 - a. 48,000 flow on 48-port models
 - b. 24,000 flows on 12-port and 24-port models
 6. DRAM: 4 Gb
 7. Flash: 2 Gb
 8. Vlan ID(s): 4,000
 9. Jumbo Frame: 9198 bytes
 10. Total Routed ports per 3850 Stack: 2018
- D. The core Ethernet switches physical characteristics:
1. Dimensions: 1.75" X 17.5" X 17.7"
 2. Weight: 15.5 lb
 3. Environmental: -5C to 45C
 4. Relative Humidity: 10% to 95%, noncondensing
 5. Connectors and Cabling:
 - a. 1000BASE-T ports: RJ-45 connectors, 4-pair Cat5E UTP cabling
 - b. 1000BASE-T SFP based ports: RJ-45 connectors, 4-pair Cat5E UTP cabling
 - c. 100BASE-FX, 1000BASE-SX, -LX/LH, -ZX, -BX10, DWDM and CWDM SFP transceivers: LC fiber connectors (single mode and multimode fiber)
 - d. 10GBASE-SR, LR, LRM, ER, ZR, DWDM SFP+transceivers: LC fiber connectors (single mode and multimode fiber)
 - e. CX1 cable assemblies: SFP+Connectors
 - f. Ethernet Management Port: RJ-45 connectors, 4-pair Cat5E UTP cabling
 - g. Management Console Port: RJ-45 to DB9 cable for PC connection
- E. The core Ethernet switches Power characteristics:
- a. Power Supply Rated Maximum: 1100W/715W/350W/440W
 - b. Total BTU Output: 3793 BTU/hr; 2465 BTU/hr; 1207 BTU/hr; 1517 BTU/hr

**NEBRASKA DEPARTMENT OF CORRECTIONAL SERVICES
COMMUNITY CORRECTION CENTER LINCOLN
SECURITY CAMERA SYSTEM UPGRADE
LINCOLN, NEBRASKA**

c. Input Voltage Range: 115-240VAC

d. Input Current Range: 12-6A

F. Model:

1. Cisco Catalyst 9300 Series (PoE + Network Advantage)

2. Or Equal

2.21 VIDEO WIRING SYSTEMS

A. The singlemode fiber cable shall be made for long-reach applications in campus and outside plant backbones. The singlemode fiber cable shall be Single-Jacket, All Dielectric Loose Tube Cables. The singlemode fiber cable shall be low-water peak fiber that is ideal for Wavelength Division Multiplexing (WDM) technology where multiple wavelengths operating at 10 or 25Gb are transmitted over a single fiber to deliver extremely high bandwidth to distances of 10 km or more.

1. The singlemode fiber shall support all broadband applications and complies with the most stringent industry standards, such as:

a. ITU-T G.652 (Tables A, B, C and D)

b. IEC 60793-2-50 Type B1.3

c. ISO 11801 052

d. TIA/EIA 492-CAAB

e. Telecordia GR-20-CORE

2. Model:

a. Indoor/Outdoor Ribbon cable: Single-Jacket, All Dielectric Loose Tube Cables

1) Belden

2) General Cable

3) West Penn

B. Provide multimode fiber optic cabling and patching for non-backbone fiber optic media conversion.

1. OM3/4 Indoor/Outdoor Fiber, 900 micron tight buffer:

a. OCC

b. Commscope

c. Mohawk CDT

d. Belden

C. Provide fiber optic patch panels and splice shelves with all required materials at each electronic security equipment room. Enclosures and panels shall be of sufficient size and capacity to terminate all of the combined fiber count of risers and backbone outside fiber optic cables.

1. Models:

**NEBRASKA DEPARTMENT OF CORRECTIONAL SERVICES
COMMUNITY CORRECTION CENTER LINCOLN
SECURITY CAMERA SYSTEM UPGRADE
LINCOLN, NEBRASKA**

- a. Leviton Opt-X 1000 Rack Mount
 - b. Belden AX Series Fiber Express
 - c. West Penn Wire
- D. Data Cable: Unshielded 4-pair, shall exceed all requirements for ANSI/EIA/TIA-568-A-5 and support high speed communication network applications.
1. Category 6:
 - a. Belden: 7881A – Dry, Wet not available
 - b. West Penn: 4246 – Dry, M57562 – Wet
 - c. Comscope: 75N4 – Dry, 6NF4+ – Wet

2.22 MEDIA CONVERTERS – INDUSTRIAL GRADE

- A. Transmits and receives 1000 Mbps data over multimode, single mode, optical fiber, or 10/100/1000 Mbps data over CAT5e or Cat6 electrical cable. The media converter shall meet following requirements:
1. Data Interface: Ethernet
 2. Data Rate: 10/100/1000 Mbps, IEEE 802.3 Compliant
 3. Operating Mode: Full Duplex or Half Duplex
 4. MTBF: > 100,000 hours
 5. Operating Temp: -40° C to +74° C
 6. Storage Temp: -40° C to +85° C
 7. Relative Humidity: 0% to 95%
 8. Model:
 - a. Comnet
 - b. KBC Networks
 - c. Blackbox
 - d. Redlion

2.23 CAMERA POWER SUPPLIES

- A. Provide minimum 60W PoE+ injector where recommended by the camera manufacturer. Provide adequate mounting hardware in rack to accommodate the number of PoE injectors required.
1. Bosch NPD-6001B or equal

**NEBRASKA DEPARTMENT OF CORRECTIONAL SERVICES
COMMUNITY CORRECTION CENTER LINCOLN
SECURITY CAMERA SYSTEM UPGRADE
LINCOLN, NEBRASKA**

2. Axis

2.24 SPARE PARTS

- A. Provide spare parts as follows:
 - 1. Camera: Two (2) of each type required.
 - 2. LCD HD Monitors 27": One (1)
 - 3. VIDEO STORAGE: Provide Two (2) of each type of RAID hard drives.

PART 3 - EXECUTION

3.1 INSTALLATION (SEE SECTION 280510)

- A. Install all equipment in accordance with manufacturer's recommendations.
- B. Provide rack mount equipment as required for all equipment shown rack mounted on the drawings.
- C. Install all video surveillance system cabling in conduit.
- D. Provide conduit with pull strings, boxes, and video system capacity for future cameras indicated on plans.
- E. Make all connections to video equipment with approved connectors for cable used.
- F. After Substantial Completion and initial programming as specified, provide a minimum of eight (8) hours of time with Owner Representative for review of specified program and modification to User's requirements.

3.2 TESTING (SEE SECTION 280510)

- A. Testing Specifications for each fiber optic cable:
 - 1. All of the following test shall be performed on each fiber in each cable installed and each test results shall be provided in written form
 - 2. End to end attenuation test with power meter. Maximum attenuation on installed cables / fibers shall be within the manufacturer's specifications.
- B. The testing of both windows of each fiber optic cable.
 - 1. If splicing of a fiber optic cable is required due to site conditions, each fiber in the associated cable shall be tested using an Optical Time Division Reflectometer (OTDR). All testing information and locations of each splice shall be in written form and provided with the as-build documents. The following items must be tested on each fiber associated with a splice.
 - a. Test each strand on one wavelength in one direction on each segment, no jumper allowed, and document.

**NEBRASKA DEPARTMENT OF CORRECTIONAL SERVICES
COMMUNITY CORRECTION CENTER LINCOLN
SECURITY CAMERA SYSTEM UPGRADE
LINCOLN, NEBRASKA**

- b. Test for overall continuity and document.
- c. Verify the length of each segment and document.
- d. Locate and indicate all splices on drawings.

3.3 WIRING (SEE SECTION 280510)

3.4 OWNER PERSONNEL TRAINING (SEE SECTION 280510)

- A. Provide training of owner personnel in proper operation and maintenance of video surveillance system.
- B. Training Outline-Admin staff
 - 1. Functions performed
 - 2. Control Functions
 - 3. Recording/Playback/Archival
 - 4. User Rights
- C. Training Outline-Operational staff
 - 1. Functions performed
 - 2. Control Functions
 - 3. Recording/Playback
- D. Training Outline-Maintenance Staff
 - 1. Systems Operation
 - 2. Component Review
 - 3. Routine Maintenance/Adjustments
 - 4. Troubleshooting/Repair


END OF SECTION 28 2300

KEYED NOTES:


- ① NEW IP CAMERA LOCATION. PULL NEW CAT6 CABLING. PLENUM CABLE SHALL BE PULLED ON J-HOOKS WHERE CEILING IS ACCESSIBLE. PROVIDE CONDUIT FROM CAMERA TO NEAREST ACCESSIBLE CEILING SPACE. IF THERE IS NO ACCESSIBLE CEILING RUN CAT6 CABLE IN CONDUIT FROM CAMERA TO DESIGNATED EQUIPMENT ROOM.
- ② REPLACE EXISTING IP CAMERA WITH NEW IP CAMERA. REUSE EXISTING CAT6 CABLE AND CONDUIT. SEE CAMERA SCHEDULE FOR NEW CAMERA TYPE.
- ③ EXISTING IP CAMERA WILL REMAIN FOR REUSE. REUSE EXISTING CAT6 CABLE AND CONDUIT.
- ④ REMOVED THE EXISTING IP CAMERA AND RETURNED IT TO THE OWNER. COIL THE EXISTING CABLE INSIDE CAMERA BACK-BOX AND PROVIDE BACK-BOX COVER PLATE. PROVIDE WEATHERPROOF COVER PLATE FOR THE EXTERIOR CAMERAS.
- ⑤ EXISTING ANALOG CAMERA TO BE REMOVED AND RETURNED TO OWNER. REPLACE EXISTING CAMERA WITH NEW IP BASED CAMERA (SEE CAMERA SCHEDULE). THE EXISTING COAX CABLE WILL BE REMOVED AND REPLACED WITH EITHER NEW CAT6 CABLE OR NEW FIBER OPTIC CABLE (DEPENDING OF THE DISTANCE BETWEEN CAMERA AND NETWORK SWITCH).

GENERAL NOTES:

1. LOCATION AND NUMBER OF ALL EXISTING ELECTRONIC SECURITY FIELD DEVICES SHOWN ON THIS DRAWING ARE BASED ON AS-BUILT DRAWINGS. FIELD VERIFY AND CONFIRM LOCATION, NUMBER AND FUNCTIONALITY OF ALL EXISTING FIELD DEVICES.
2. ALL EXISTING FIELD DEVICES (INCLUDING BUT NOT LIMITING TO DOOR CONTROL AND MONITORING, INTERCOM STATIONS, PAGING SPEAKERS, CALL BUTTONS, DURESS PUSHBUTTONS, ETC) AND THEIR ASSOCIATED CABLES/WIRES CONNECTING THEM TO THE EXISTING HEAD-END EQUIPMENT SHALL REMAIN FOR REUSE UNLESS NOTED OTHERWISE.
3. THE SCOPE OF THIS PROJECT INCLUDES REPLACEMENT OF ALL EXISTING ANALOG CAMERAS AND IP CAMERAS (REFER TO DRAWINGS FOR EXACT NUMBER AND LOCATION). THE EXISTING VIDEO VIEWING STATIONS SHALL BE REPLACED. THE EXISTING VIDEO RECORDING SERVER SHALL BE REPLACED. THE EXISTING VIDEO STORAGE SHALL BE REPLACED. ALL NEW CAMERAS SHALL BE MANUFACTURED BY BOSCH (TO MATCH MAJORITY OF THE NDCS'S FACILITIES). HANWHA MULTISENSOR CAMERA WITH INTEGRATED PTZ AND HANWHA DUAL SENSOR CAMERAS SHALL BE USED AT LOCATIONS INDICATED ON THE DRAWINGS AND CAMERA SCHEDULE. NEW VIDEO MANAGEMENT SOFTWARE SHALL BE THE LATEST AVAILABLE VERSION OF BOSCH VMS (V12.1 OR LATER). ALL CAMERAS WILL BE RECORDED AND VIDEO STORAGE SHALL BE SIZED TO RETAIN RECORDING FOR 90 DAYS. ALL CAMERAS SHALL BE CONTINUOUSLY RECORDED AT NATIVE RESOLUTION, 15 IMAGES PER SECOND. QUIET TIME RECORDING (NO MOTION) SHALL BE AT NATIVE RESOLUTION @ 2 IMAGES PER SECOND FOR ALL CAMERAS. THE MOTION SHALL BE ESTIMATED AT 70%.
4. THE NEW VIDEO MANAGEMENT SYSTEM SHALL NOT BE INTERFACED WITH THE EXISTING TOUCH SCREEN CONTROL AND MANAGEMENT SYSTEM TO ALLOW DISPLAY OF ALL NEW CAMERA ICONS ON THE TOUCH SCREEN MAPS FOR CAMERA CALL UP.
5. WORK SHALL BE PHASED TO INSTALL ALL NEW INFRASTRUCTURE AND SERVERS, ETC IN PLACE PRIOR TO REMOVING EXISTING SURVEILLANCE EQUIPMENT. COORDINATE WITH THE OWNER FOR THE PHASING OF WORK BY AREA. A PHASING PLAN SHALL BE SUBMITTED FOR OWNER APPROVAL PRIOR TO COMMENCEMENT OF WORK. DOWNTIME OF EXISTING SYSTEMS SHALL BE KEPT TO A MINIMUM DURING THE COURSE OF THE INSTALLATION.
6. ALL EXISTING ANALOG CAMERAS SHALL BE REMOVED AND REPLACED WITH NEW IP BASED POE CAMERAS AS SHOWN ON THE PLANS. THE EXISTING COAX CABLE SHALL BE REMOVED AND REPLACED WITH NEW CAT6 CABLES. THE EXISTING CONDUITS WILL BE REUSED FOR THE INSTANCES WHERE NEW CAT6 CABLE LENGTH FROM CAMERA TO ASSOCIATED NETWORK SWITCH DOES NOT EXCEED 280'. FOR THE INSTANCES WHERE EXISTING CONDUIT EXCEEDS LENGTH OF 280' CONTRACTOR WILL PROVIDE NEW FIBER OPTIC CABLE AND REQUIRED MEDIA CONVERTERS AND POWER SUPPLIES TO SUPPORT CAMERA AND MEDIA CONVERTER OPERATION.
7. THE EXISTING CAT6 CABLES SHALL REMAIN FOR REUSE. ALL CAT6 CABLES THAT ARE PLANNED TO BE REUSED SHALL BE TESTED TO CONFIRM UNCOMPROMISED SIGNAL STRENGTH. ALL CABLES FAILING THIS TEST SHALL BE REPLACED WITH THE NEW FIBER OPTIC CABLE FOR EXTERIOR CAMERAS AND CAT6 FOR INTERIOR CAMERAS.
8. ALL NEW VIDEO SYSTEM COMPONENTS SHALL BE CONNECTED TO NETWORK SWITCHES VIA CAT6 CABLE USING PATCH PANELS. IF ANY CABLE LENGTH BETWEEN A COMPONENT (CAMERA, WORKSTATION, ETC) AND A NETWORK SWITCH, INCLUDING SLACK, EXCEEDS 300', PROVIDE NEW FIBER OPTIC CABLE, MEDIA CONVERTERS AND POWER SUPPLIES TO SUPPORT CAMERA AND MEDIA CONVERTER OPERATION. PROVIDE POWER FOR MEDIA CONVERTERS FROM APPROVED UPS CIRCUITS. ALL UNDERGROUND CAT6 RUNS SHALL BE IN CONDUIT AND SHALL UTILIZE DIRECT-BURIAL RATED CABLE.
9. CAT6 CABLES FOR NEW CAMERAS SHALL RUN IN CONDUITS BETWEEN CAMERA AND THE NEAREST ACCESSIBLE CEILING. USE J-HOOKS AND PLENUM RATED CABLE FOR THE CABLE RUNS ABOVE CEILINGS.
10. NETWORK SWITCHES SHALL BE PROVIDED BY THE NDCS_OCI0.
11. PATCH PANELS AND ASSOCIATED HEAD END PATCH CABLES SHALL BE PROVIDED AND INSTALLED BY THE CONTRACTOR.
12. THE EXISTING TOUCH SCREEN STATION HARDWARE SHALL REMAIN.
13. ALL EXISTING VIDEO SURVEILLANCE EQUIPMENT (INCLUDED BUT NOT LIMITED TO CAMERAS, VIDEO MONITORS, SERVERS AND RECORDERS, ETC.) SHALL BE REMOVED AND RETURNED TO THE OWNER.
14. EACH CAMERA MOUNTING LOCATION SHALL BE FIELD VERIFIED TO CONFIRM BEST VIDEO COVERAGE. VIDEO COVERAGE SHALL BE APPROVED AND SIGNED OFF BY THE OWNER OR ENGINEER. FOR NEW CAMERA LOCATIONS CONTRACTOR MUST NOTIFY ENGINEER OF ANY OBSTRUCTIONS TO INTENDED VIEW PRIOR TO CAMERA INSTALLATION.
15. ALL REMOVED EXISTING CABLING WILL BE LEGALLY DISPOSED OF BY THE CONTRACTOR AND NOT TURNED OVER TO THE OWNER UNLESS NOTED OTHERWISE.

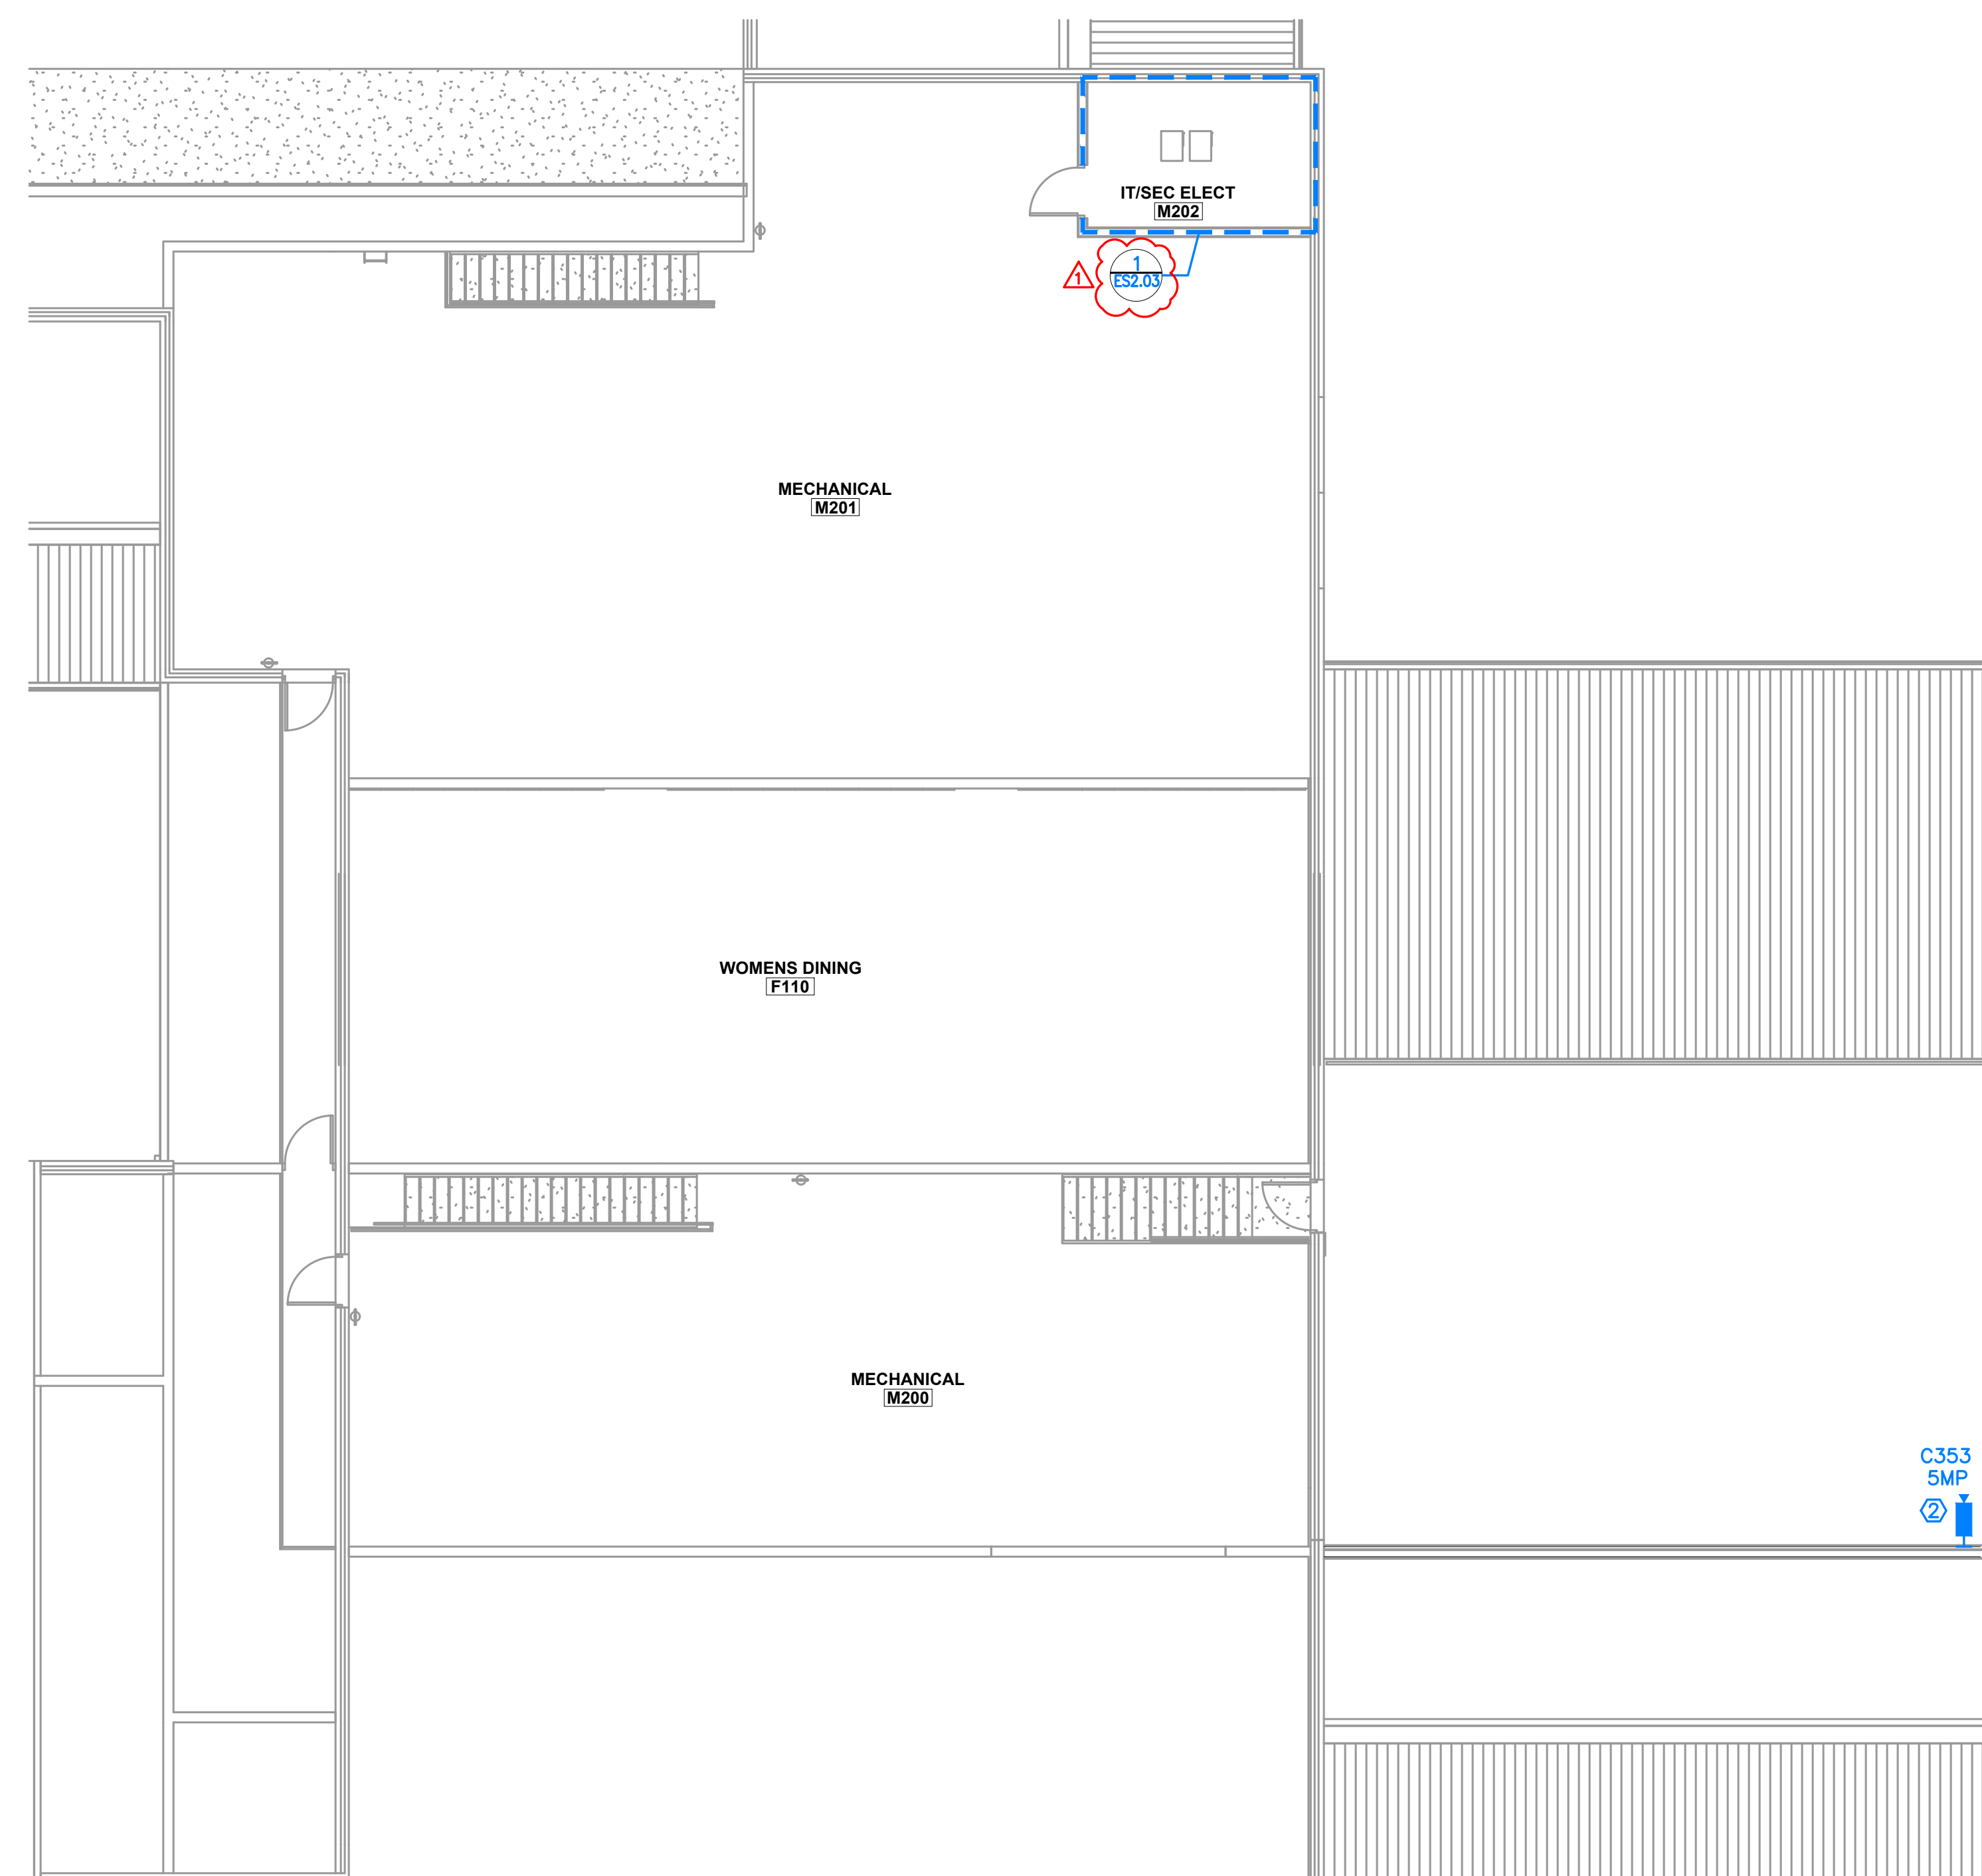

1 EQUIPMENT PLATFORM LEVEL
ES1.09 SCALE: 1/8" = 1'-0"

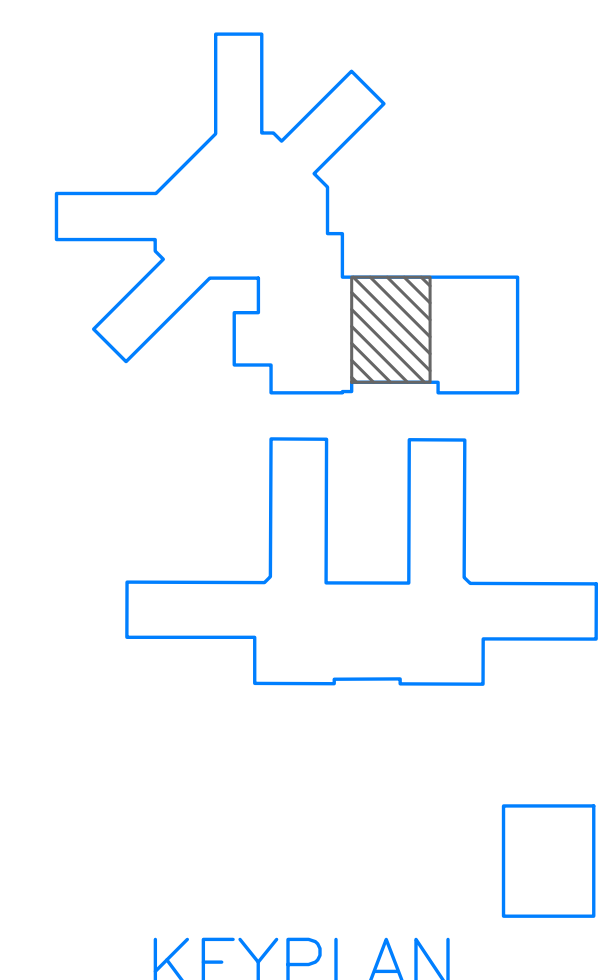

CLIENT INFORMATION
NE Dept of Correctional Services
2720 W. Van Dorn St
Lincoln, NE 68522

PROJECT INFORMATION
CCCL - SECURITY CAMERA SYSTEM UPGRADE


Job #	24-0086	
ISSUE DATE	10/25/2024	
Revisions:		
ID	Date	Description
1	11/18/2024	ADDENDUM #1

CHECKED: JA
DRAWN BY: JC


SHEET TITLE
EXISTING 160 BED BUILDING - EQUIPMENT PLATFORM LEVEL

SHEET NUMBER
ES1.09




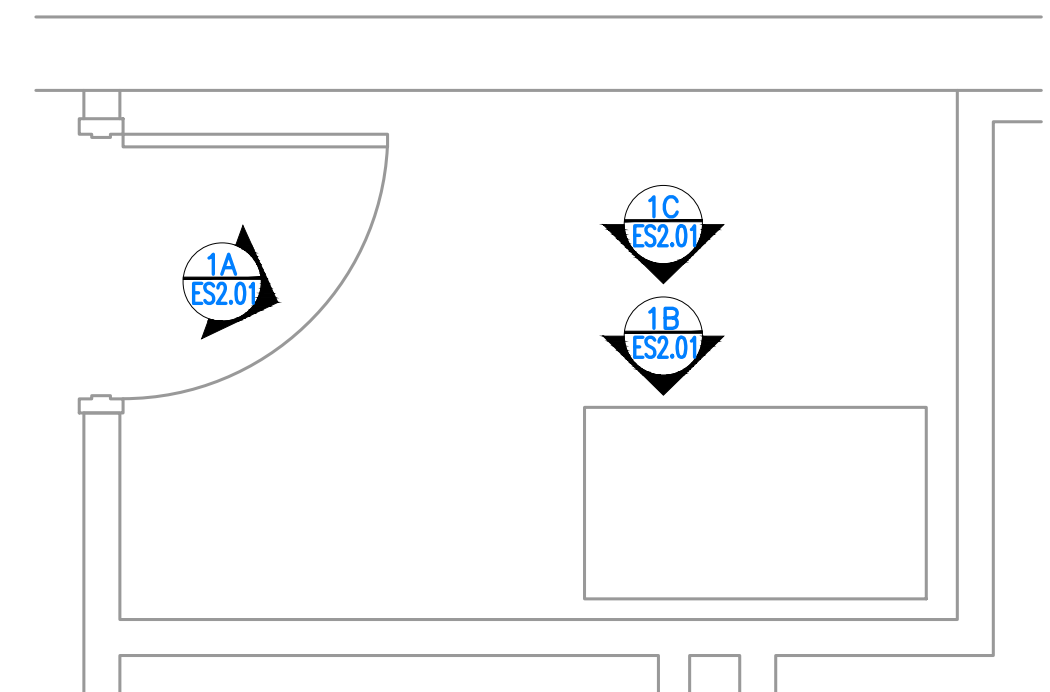

1 EXISTING ROOM IDORM
ES2.01 SCALE: 1/2" = 1'-0"

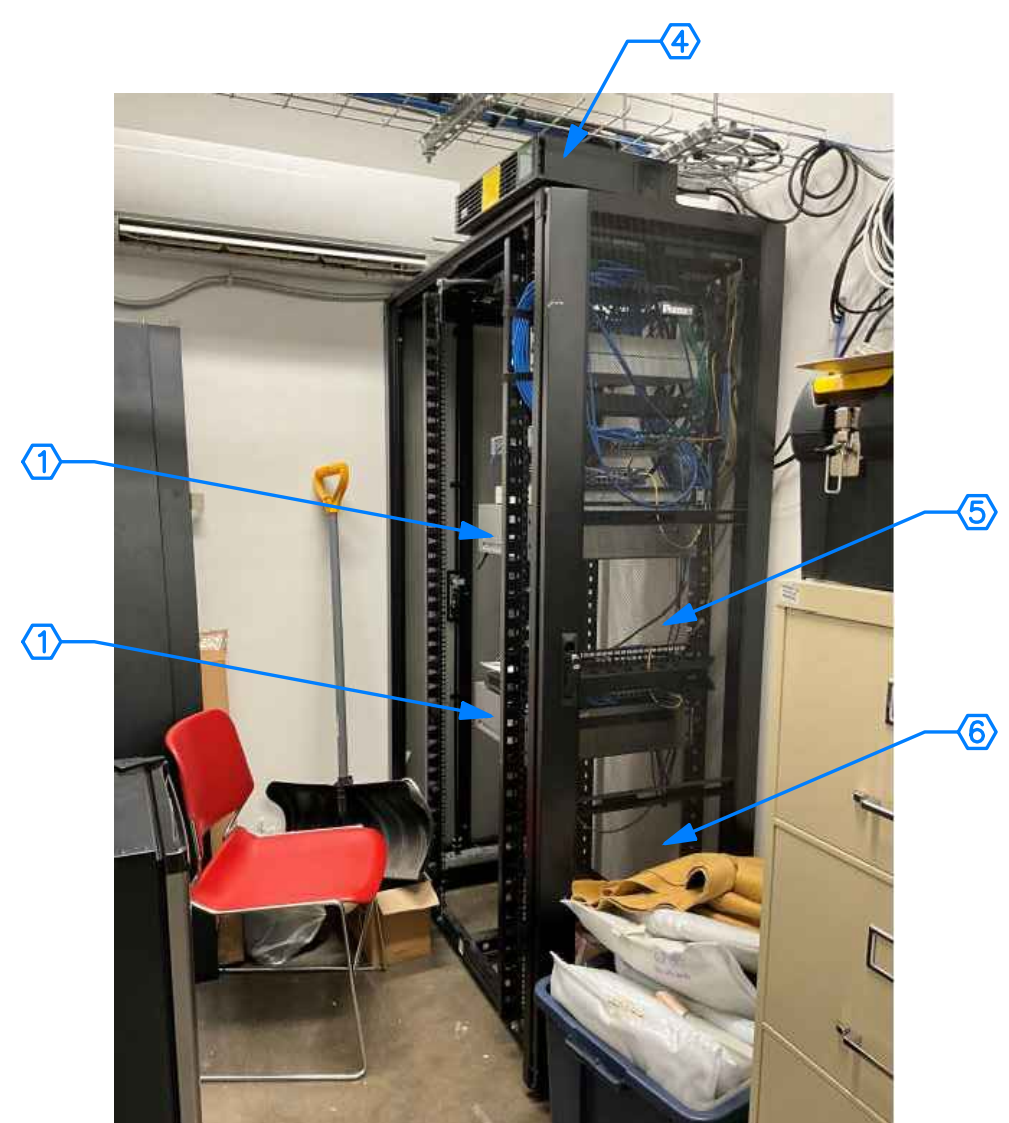


1A PHOTO EXISTING EQUIPMENT
ES2.01 SCALE: NOT TO SCALE

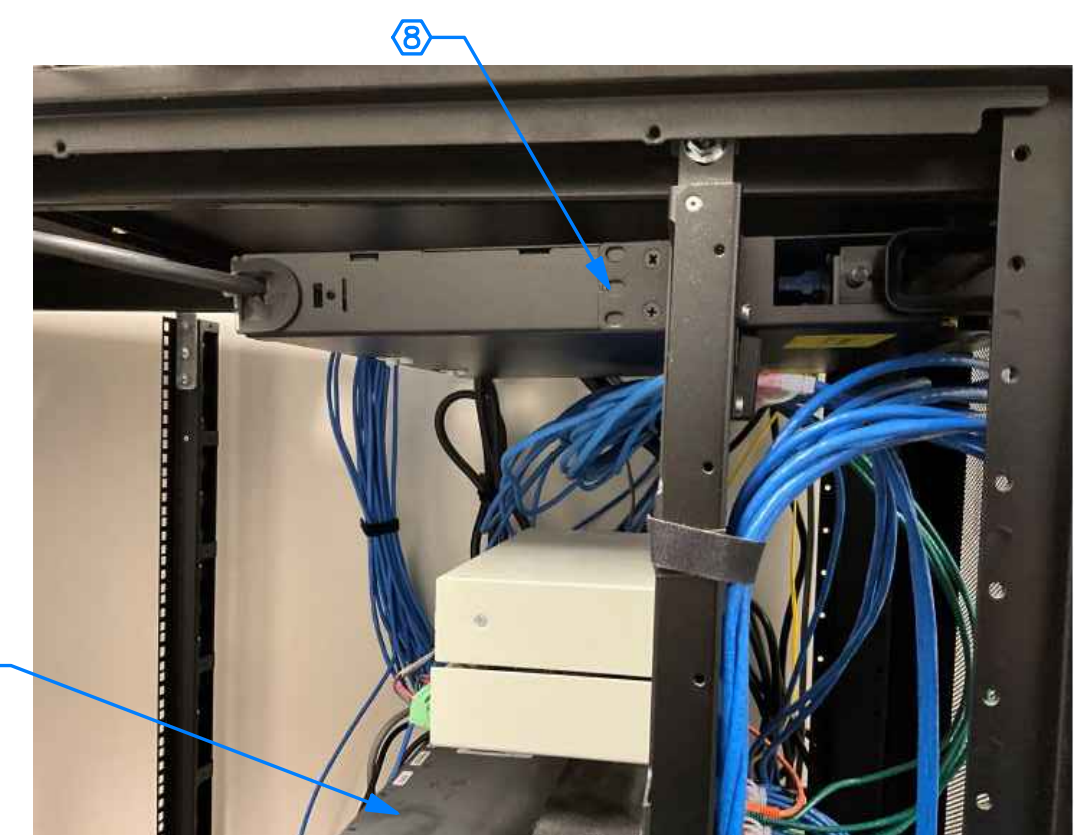


1B PHOTO EXISTING EQUIPMENT
ES2.01 SCALE: NOT TO SCALE




1C PHOTO EXISTING EQUIPMENT
ES2.01 SCALE: NOT TO SCALE

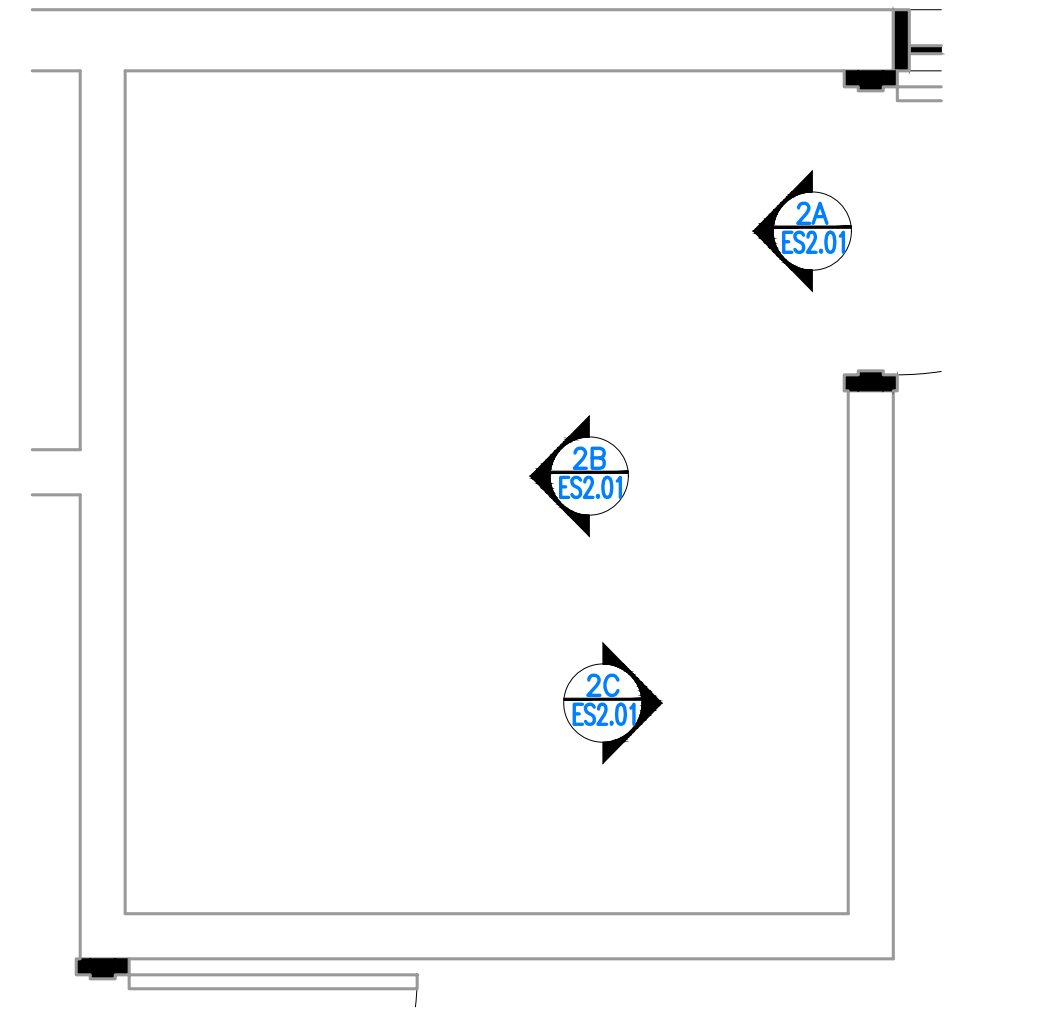


2 ROOM #A105
ES2.01 SCALE: 1/2" = 1'-0"

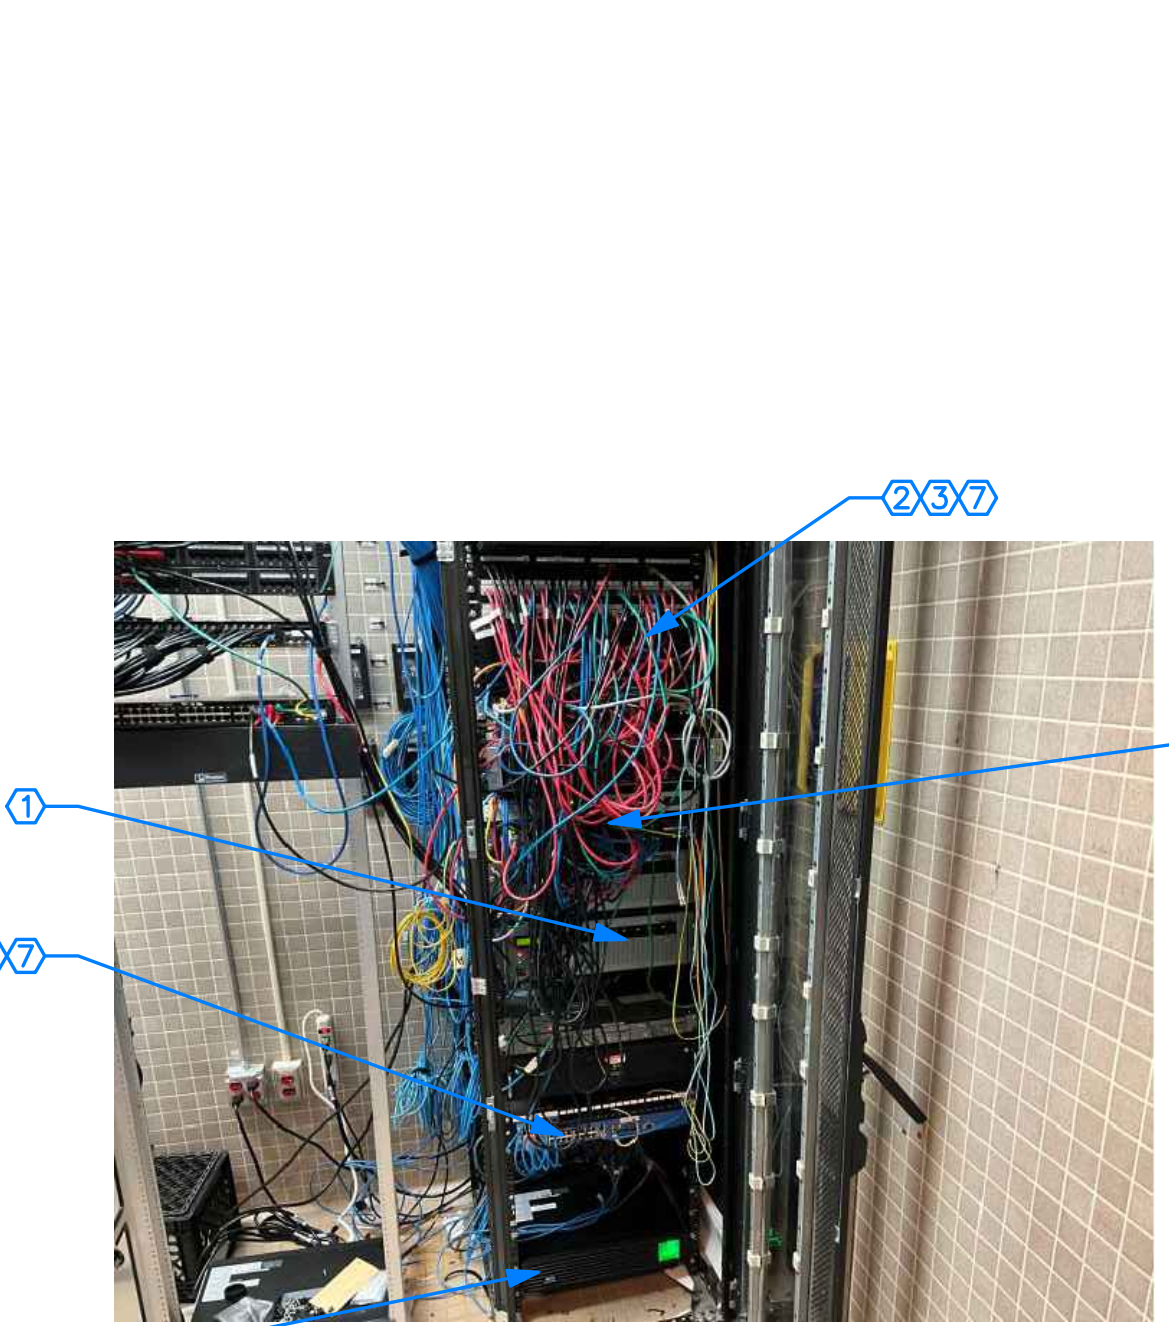


2A PHOTO EXISTING EQUIPMENT
ES2.01 SCALE: NOT TO SCALE

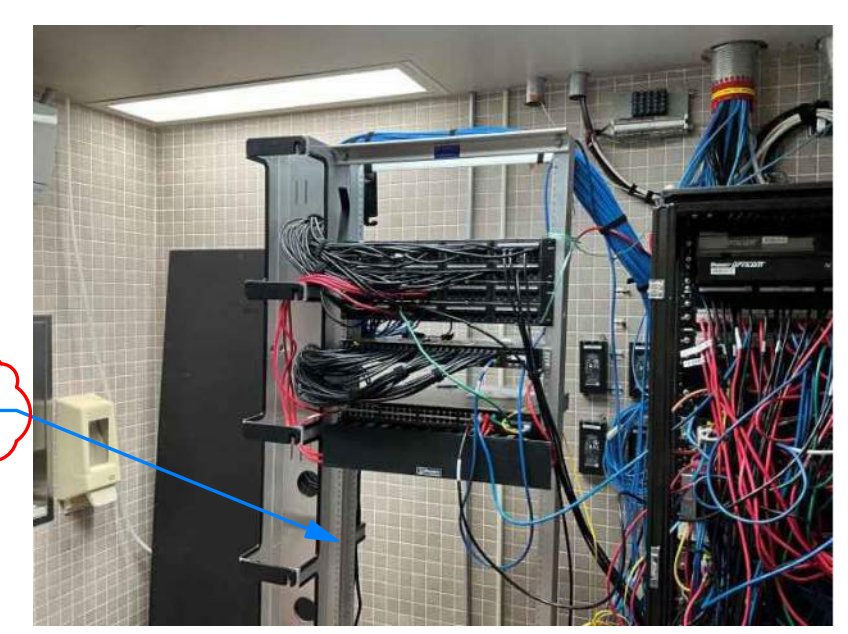

2B PHOTO EXISTING EQUIPMENT
ES2.01 SCALE: NOT TO SCALE

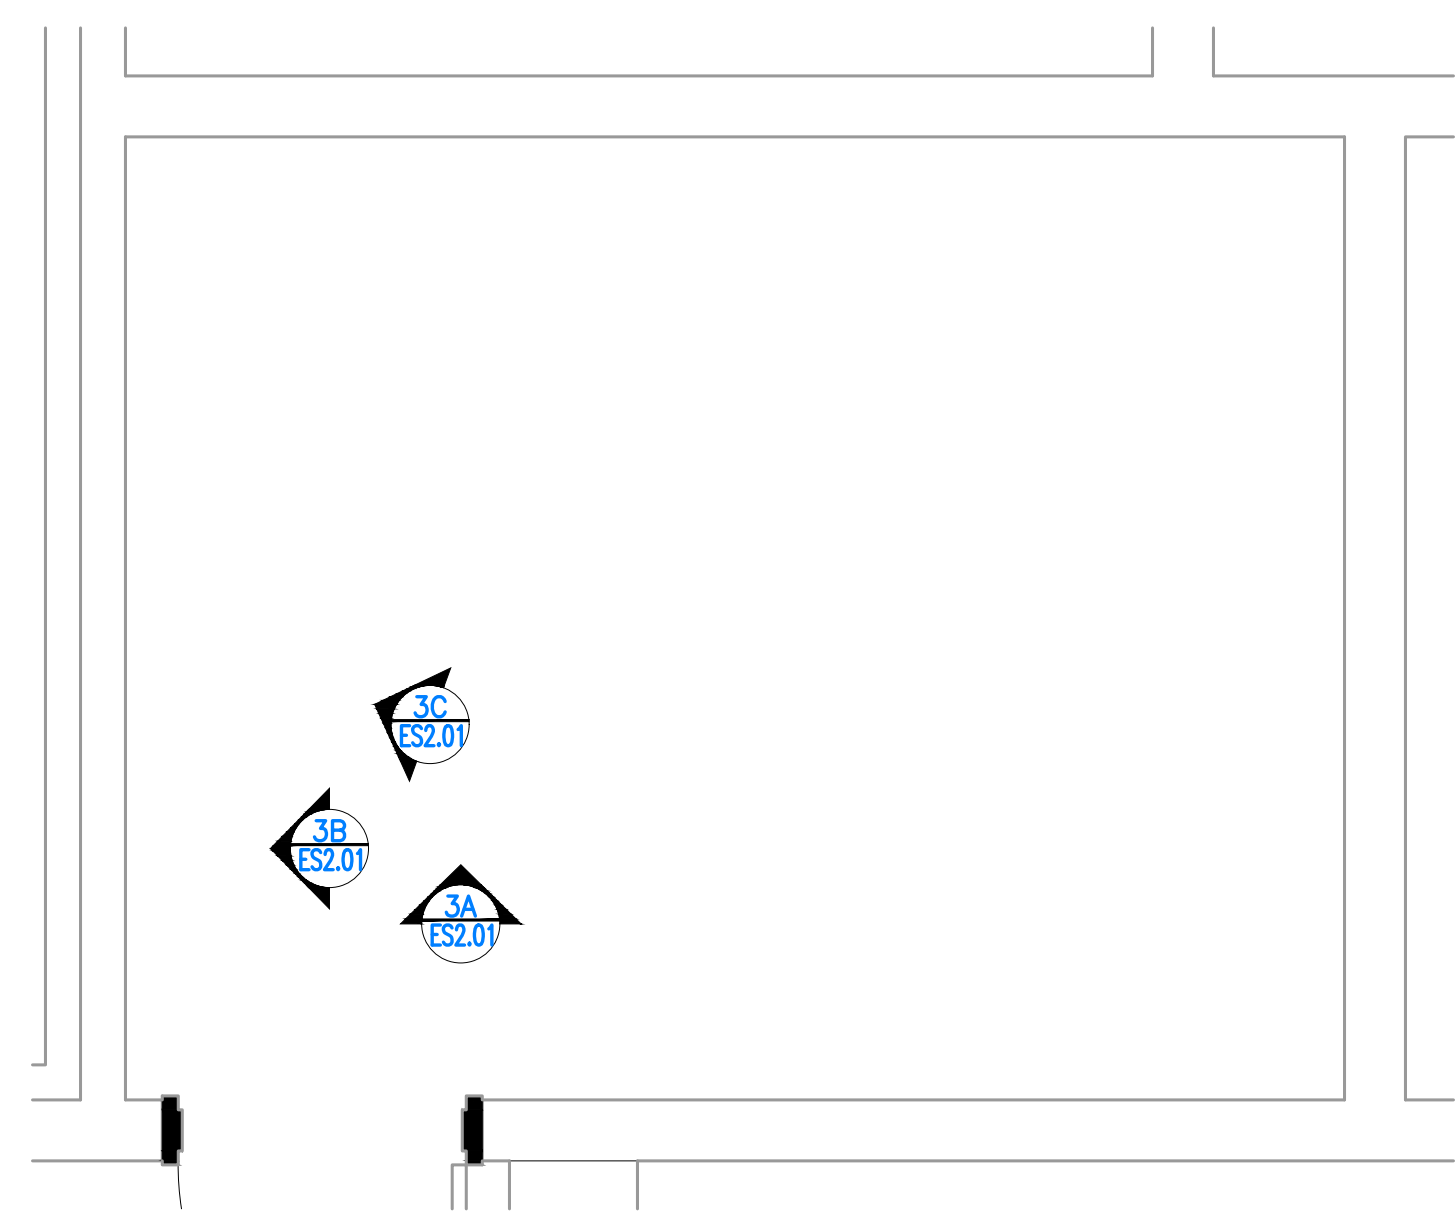

3 ELECTRICAL #B122
ES2.01 SCALE: 1/2" = 1'-0"

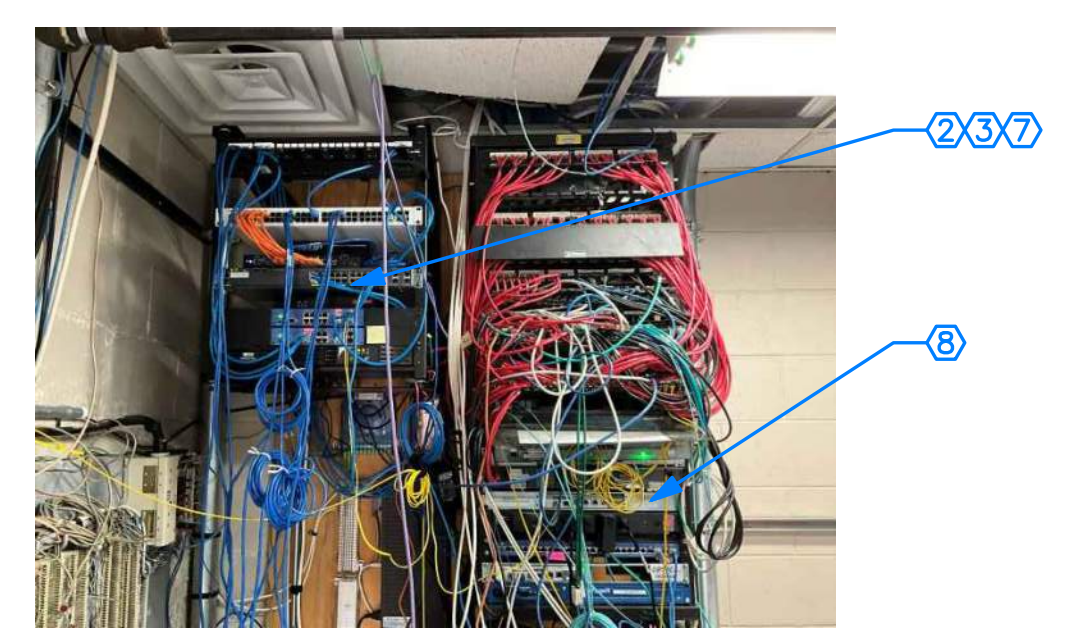

3A PHOTO EXISTING EQUIPMENT
ES2.01 SCALE: NOT TO SCALE

- GENERAL NOTES:**
- LOCATION AND NUMBER OF ALL EXISTING ELECTRONIC SECURITY FIELD DEVICES SHOWN ON THIS DRAWING ARE BASED ON AS-BUILT DRAWINGS. FIELD VERIFY AND CONFIRM LOCATION, NUMBER AND FUNCTIONALITY OF ALL EXISTING FIELD DEVICES.
 - ALL EXISTING FIELD DEVICES (INCLUDING BUT NOT LIMITING TO DOOR CONTROL AND MONITORING, INTERCOM STATIONS, PAGING SPEAKERS, CALL BUTTONS, DURESS PUSHBUTTONS, ETC) AND THEIR ASSOCIATED CABLES/WIRES CONNECTING THEM TO THE EXISTING HEAD-END EQUIPMENT SHALL REMAIN FOR REUSE UNLESS NOTED OTHERWISE.
 - THE SCOPE OF THIS PROJECT INCLUDES REPLACEMENT OF ALL EXISTING ANALOG CAMERAS AND IP CAMERAS (REFER TO DRAWINGS FOR EXACT NUMBER AND LOCATION). THE EXISTING VIDEO VIEWING STATIONS SHALL BE REPLACED. THE EXISTING VIDEO RECORDING SERVER SHALL BE REPLACED. THE EXISTING VIDEO STORAGE SHALL BE REPLACED. ALL NEW CAMERAS SHALL BE MANUFACTURED BY BOSCH (TO MATCH MAJORITY OF THE NDCCS'S FACILITIES). HANWHA MULTISENSOR CAMERA WITH INTEGRATED PTZ AND HANWHA DUAL SENSOR CAMERAS SHALL BE USED AT LOCATIONS INDICATED ON THE DRAWINGS AND CAMERA SCHEDULE. NEW VIDEO MANAGEMENT SOFTWARE SHALL BE THE LATEST AVAILABLE VERSION OF BOSCH VMS (V12.1 OR LATER). ALL CAMERAS WILL BE RECORDED AND VIDEO STORAGE SHALL BE SIZED TO RETAIN RECORDING FOR 90 DAYS. ALL CAMERAS SHALL BE CONTINUOUSLY RECORDED AT NATIVE RESOLUTION AND 15 IMAGES PER SECOND. QUIET TIME RECORDING (NO MOTION) SHALL BE AT NATIVE RESOLUTION @ 2 IMAGES PER SECOND FOR ALL CAMERAS. THE MOTION SHALL BE ESTIMATED AT 70%.
 - THE NEW VIDEO MANAGEMENT SYSTEM SHALL NOT BE INTERFACED WITH THE EXISTING TOUCH SCREEN CONTROL AND MANAGEMENT SYSTEM TO ALLOW DISPLAY OF ALL NEW CAMERA ICONS ON THE TOUCH SCREEN MAPS FOR CAMERA CALL UP.
 - WORK SHALL BE PHASED TO INSTALL ALL NEW INFRASTRUCTURE AND SERVERS, ETC IN PLACE PRIOR TO REMOVING EXISTING SURVEILLANCE EQUIPMENT. COORDINATE WITH THE OWNER FOR THE PHASING OF WORK BY AREA. A PHASING PLAN SHALL BE SUBMITTED FOR OWNER APPROVAL PRIOR TO COMMENCEMENT OF WORK. DOWNTIME OF EXISTING SYSTEMS SHALL BE KEPT TO A MINIMUM DURING THE COURSE OF THE INSTALLATION.
 - ALL EXISTING ANALOG CAMERAS SHALL BE REMOVED AND REPLACED WITH NEW IP BASED POE CAMERAS AS SHOWN ON THE PLANS. THE EXISTING COAX CABLE SHALL BE REMOVED AND REPLACED WITH NEW CAT6 CABLES. THE EXISTING CONDUITS WILL BE REUSED FOR THE INSTANCES WHERE NEW CAT6 CABLE LENGTH FROM CAMERA TO ASSOCIATED NETWORK SWITCH DOES NOT EXCEED 280'. FOR THE INSTANCES WHERE EXISTING CONDUIT EXCEEDS LENGTH OF 280' CONTRACTOR WILL PROVIDE NEW FIBER OPTIC CABLE AND REQUIRED MEDIA CONVERTERS AND POWER SUPPLIES TO SUPPORT CAMERA AND MEDIA CONVERTER OPERATION.
 - THE EXISTING CAT6 CABLES SHALL REMAIN FOR REUSE. ALL CAT6 CABLES THAT ARE PLANNED TO BE REUSED SHALL BE TESTED TO CONFIRM UNCOMPROMISED SIGNAL STRENGTH. ALL CABLES FAILING THIS TEST SHALL BE REPLACED WITH THE NEW FIBER OPTIC CABLE FOR EXTERIOR CAMERAS AND CAT6 FOR INTERIOR CAMERAS.
 - ALL NEW VIDEO SYSTEM COMPONENTS SHALL BE CONNECTED TO NETWORK SWITCHES VIA CAT6 CABLE USING PATCH PANELS. IF ANY CABLE LENGTH BETWEEN A COMPONENT (CAMERA, WORKSTATION, ETC) AND A NETWORK SWITCH, INCLUDING SLACK, EXCEEDS 300', PROVIDE NEW FIBER OPTIC CABLE, MEDIA CONVERTERS AND POWER SUPPLIES TO SUPPORT CAMERA AND MEDIA CONVERTER OPERATION. PROVIDE POWER FOR MEDIA CONVERTERS FROM APPROVED UPS CIRCUITS. ALL UNDERGROUND CAT6 RUNS SHALL BE IN CONDUIT AND SHALL UTILIZE DIRECT-BURIAL RATED CABLE.
 - CAT6 CABLES FOR NEW CAMERAS SHALL RUN IN CONDUITS BETWEEN CAMERA AND THE NEAREST ACCESSIBLE CEILING. USE J-HOOKS AND PLENUM RATED CABLE FOR THE CABLE RUNS ABOVE CEILINGS.
 - NETWORK SWITCHES SHALL BE PROVIDED BY THE NDCCS_OCIO.
 - PATCH PANELS AND ASSOCIATED HEAD END PATCH CABLES SHALL BE PROVIDED AND INSTALLED BY THE CONTRACTOR.
 - THE EXISTING TOUCH SCREEN STATION HARDWARE SHALL REMAIN.
 - ALL EXISTING VIDEO SURVEILLANCE EQUIPMENT (INCLUDED BUT NOT LIMITED TO CAMERAS, VIDEO MONITORS, SERVERS AND RECORDERS, ETC.) SHALL BE REMOVED AND RETURNED TO THE OWNER.
 - EACH CAMERA MOUNTING LOCATION SHALL BE FIELD VERIFIED TO CONFIRM BEST VIDEO COVERAGE. VIDEO COVERAGE SHALL BE APPROVED AND SIGNED OFF BY THE OWNER OR ENGINEER. FOR NEW CAMERA LOCATIONS CONTRACTOR MUST NOTIFY ENGINEER OF ANY OBSTRUCTIONS TO INTENDED VIEW PRIOR TO CAMERA INSTALLATION.
 - ALL REMOVED EXISTING CABLING WILL BE LEGALLY DISPOSED OF BY THE CONTRACTOR AND NOT TURNED OVER TO THE OWNER UNLESS NOTED OTHERWISE.

- NOTES:**
- EXISTING PANASONIC NETWORK RECORDERS AND SERVERS SHALL BE REMOVED AND RETURNED TO NDCCS.
 - EXISTING NETWORK SWITCHES AND PATCH PANELS WILL BE REUSED.
 - USE EXISTING NETWORK PORTS FOR NEW CAMERAS CONVERTED FROM ANALOG TO IP. IF NETWORK PORTS ARE NOT AVAILABLE COORDINATE WITH NDCCS OCIO TO PROVIDE NEW NETWORK SWITCHES.
 - EXISTING UPS SHALL BE REUSED.
 - PROVIDE NEW BOSCH VIDEO MANAGEMENT SERVER AND STORAGE. THE NEW BOSCH EQUIPMENT SHALL BE POWERED FROM THE EXISTING AND NEW UPS.
 - PROVIDE NEW 2KVA UPS TO POWER NEW BOSCH VIDEO SERVERS AND STORAGE.
 - LABEL ALL EXISTING AND NEW CAMERA'S CAT6 CABLES. LABELS SHALL BE PLACED ON EACH CABLE AND NETWORK PORT.
 - EXISTING FIBER OPTIC CABLES AND PATCH PANELS SHALL BE REUSED.
 - PROVIDE NEW BOSCH VIDEO MANAGEMENT SYSTEM STORAGE. THE NEW VIDEO MANAGEMENT EQUIPMENT SHALL BE POWERED FROM THE EXISTING UPS.




CLIENT INFORMATION
NE Dept of Correctional Services
2720 W. Van Dorn St
Lincoln, NE 68522

PROJECT INFORMATION
CCCL - SECURITY CAMERA SYSTEM UPGRADE

Job #	24-0086
ISSUE DATE	10/25/2024
Revisions:	
Rev. No.	Description
1	11/18/2024 ADDENDUM #1

CHECKED BY: JA
DRAWN BY: JC
SHEET TITLE: DAVIS DESIGN ALL RIGHTS RESERVED
ENLARGED PLAN


SHEET NUMBER
ES2.01

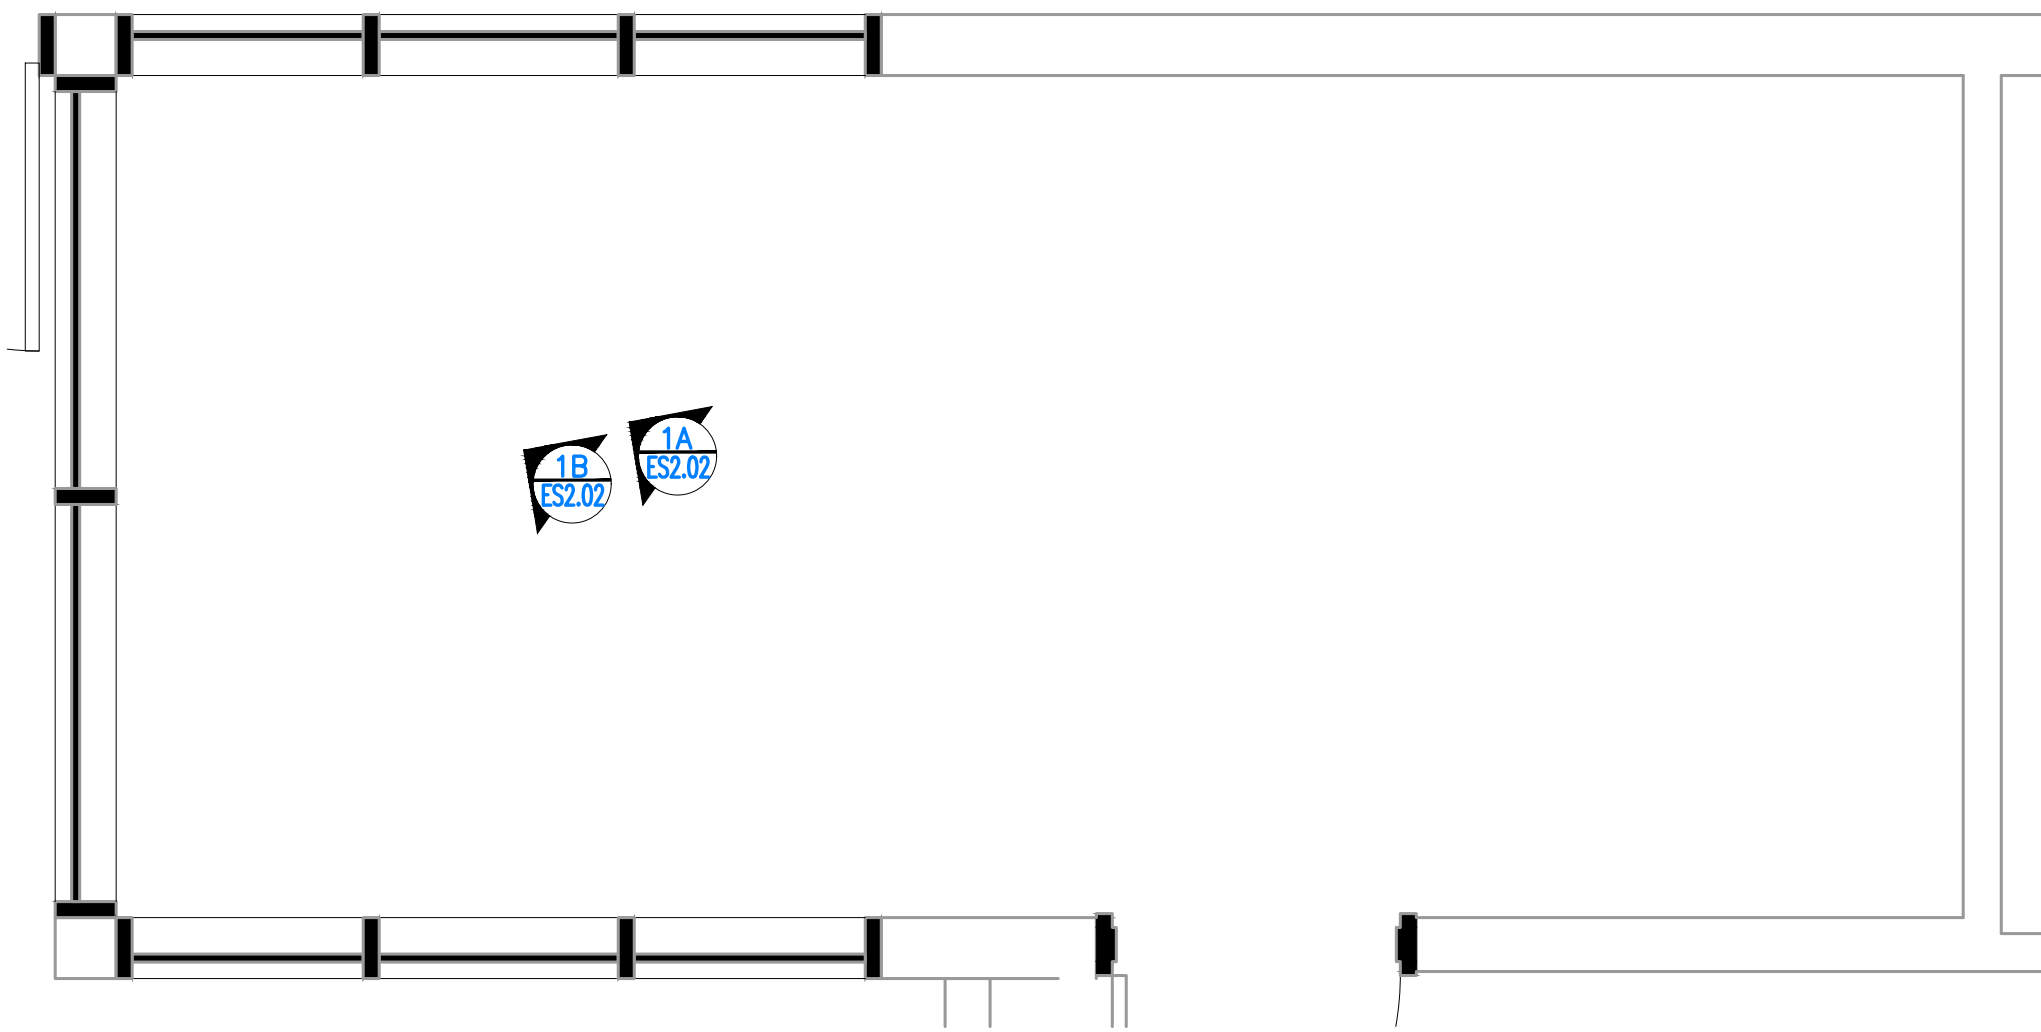


1 EXISTING CONTROL STATION #141
ES2.02 SCALE: 1/2" = 1'-0"




1A PHOTO EXISTING EQUIPMENT
ES2.02 SCALE: NOT TO SCALE

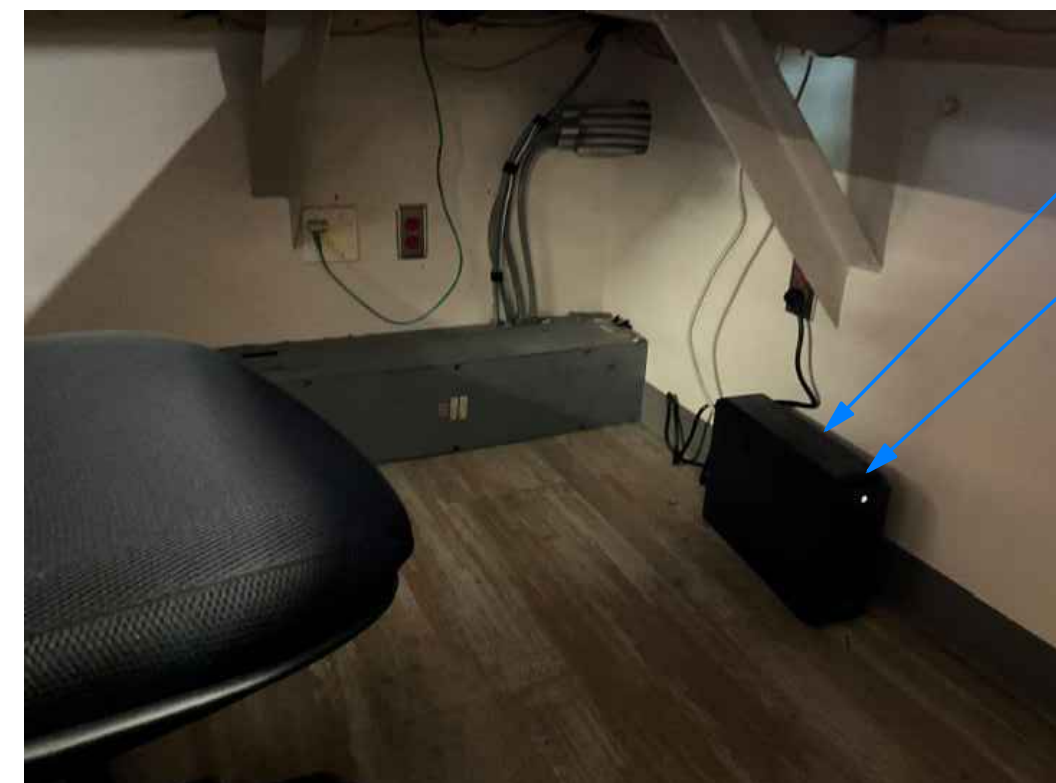


1B PHOTO EXISTING EQUIPMENT
ES2.02 SCALE: NOT TO SCALE

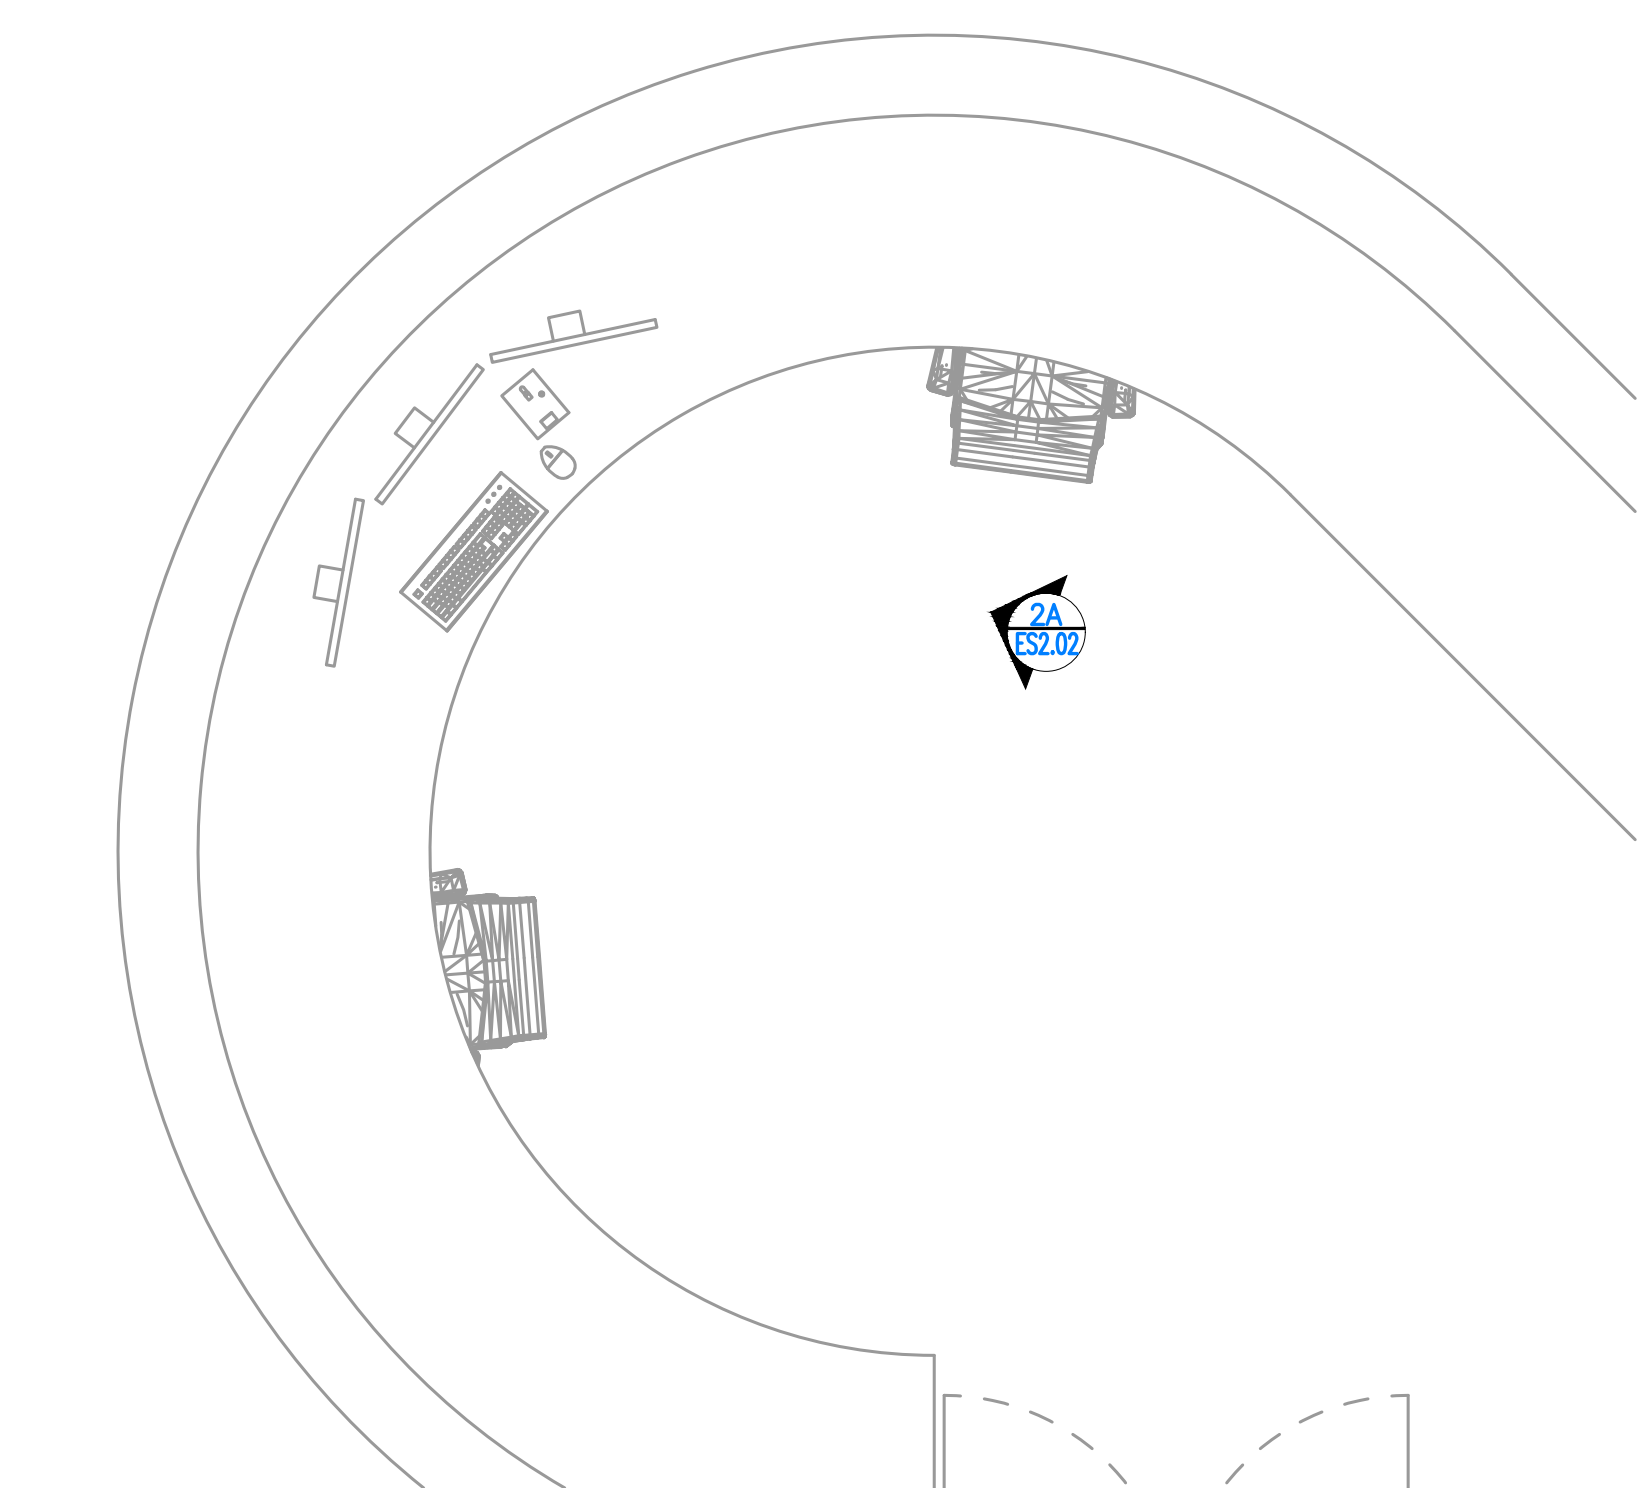


2 OFFICER STATION #E100
ES2.02 SCALE: 1/2" = 1'-0"

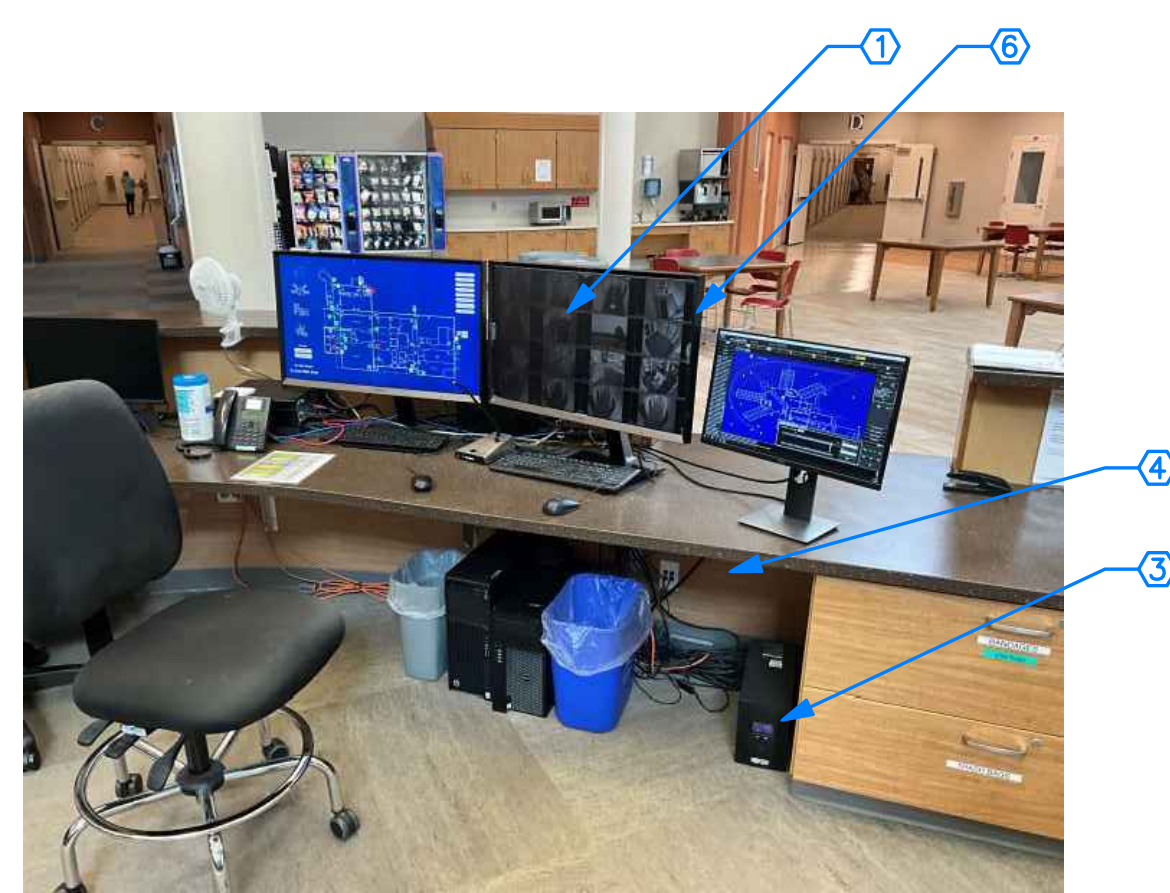

2A PHOTO EXISTING EQUIPMENT
ES2.02 SCALE: NOT TO SCALE

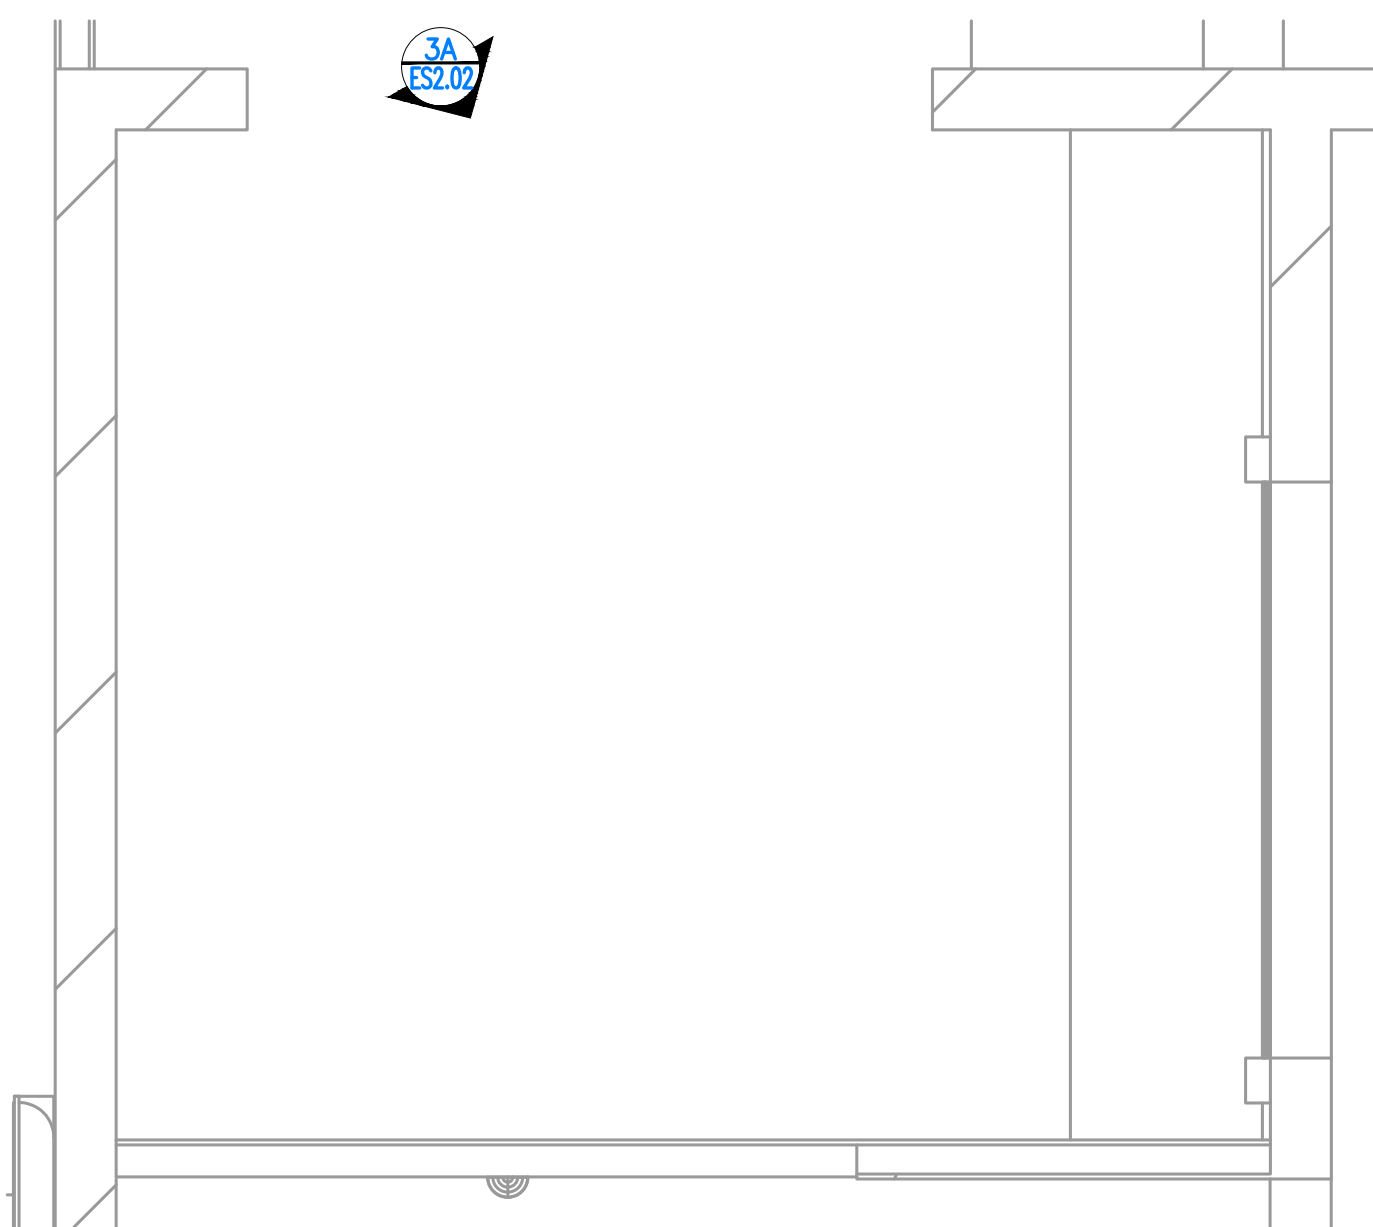

3 RECEPTION #E101
ES2.02 SCALE: 1/2" = 1'-0"

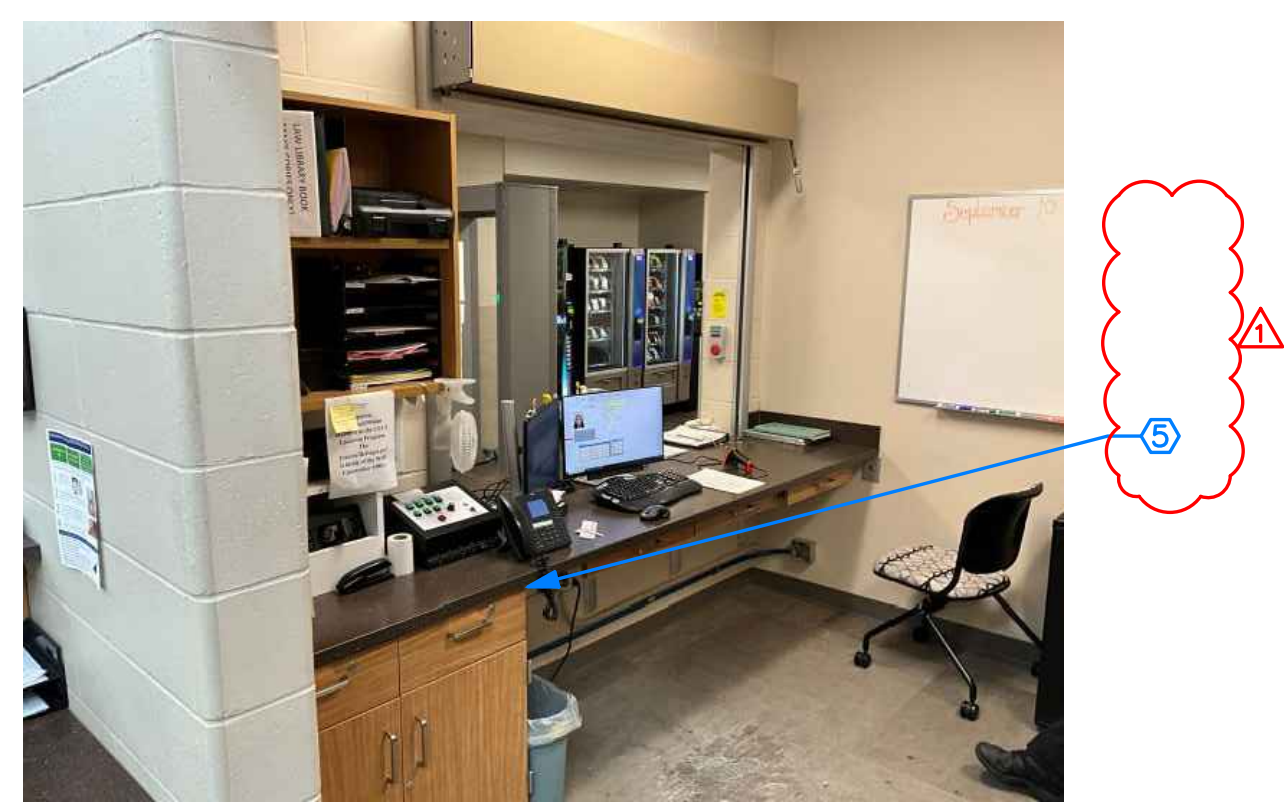

3A PHOTO EXISTING EQUIPMENT
ES2.02 SCALE: NOT TO SCALE

- GENERAL NOTES:**
- LOCATION AND NUMBER OF ALL EXISTING ELECTRONIC SECURITY FIELD DEVICES SHOWN ON THIS DRAWING ARE BASED ON AS-BUILT DRAWINGS. FIELD VERIFY AND CONFIRM LOCATION, NUMBER AND FUNCTIONALITY OF ALL EXISTING FIELD DEVICES.
 - ALL EXISTING FIELD DEVICES (INCLUDING BUT NOT LIMITING TO DOOR CONTROL AND MONITORING, INTERCOM STATIONS, PAGING SPEAKERS, CALL BUTTONS, DURESS PUSHBUTTONS, ETC) AND THEIR ASSOCIATED CABLES/WIRES CONNECTING THEM TO THE EXISTING HEAD-END EQUIPMENT SHALL REMAIN FOR REUSE UNLESS NOTED OTHERWISE.
 - THE SCOPE OF THIS PROJECT INCLUDES REPLACEMENT OF ALL EXISTING ANALOG CAMERAS AND IP CAMERAS (REFER TO DRAWINGS FOR EXACT NUMBER AND LOCATION). THE EXISTING VIDEO VIEWING STATIONS SHALL BE REPLACED. THE EXISTING VIDEO RECORDING SERVER SHALL BE REPLACED. THE EXISTING VIDEO STORAGE SHALL BE REPLACED. ALL NEW CAMERAS SHALL BE MANUFACTURED BY BOSCH (TO MATCH MAJORITY OF THE NDCCS FACILITIES). HANWHA MULTISENSOR CAMERA WITH INTEGRATED PTZ AND HANWHA DUAL SENSOR CAMERAS SHALL BE USED AT LOCATIONS INDICATED ON THE DRAWINGS AND CAMERA SCHEDULE. NEW VIDEO MANAGEMENT SOFTWARE SHALL BE THE LATEST AVAILABLE VERSION OF BOSCH VMS (V12.1 OR LATER). ALL CAMERAS WILL BE RECORDED AND VIDEO STORAGE SHALL BE SIZED TO RETAIN RECORDING FOR 90 DAYS. ALL CAMERAS SHALL BE CONTINUOUSLY RECORDED AT NATIVE RESOLUTION, 15 IMAGES PER SECOND, QUIET TIME RECORDING (NO MOTION) SHALL BE AT NATIVE RESOLUTION @ 2 IMAGES PER SECOND FOR ALL CAMERAS. THE MOTION SHALL BE ESTIMATED AT 70%.
 - THE NEW VIDEO MANAGEMENT SYSTEM SHALL NOT BE INTERFACED WITH THE EXISTING TOUCH SCREEN CONTROL AND MANAGEMENT SYSTEM TO ALLOW DISPLAY OF ALL NEW CAMERA ICONS ON THE TOUCH SCREEN MAPS FOR CAMERA CALL UP.
 - WORK SHALL BE PHASED TO INSTALL ALL NEW INFRASTRUCTURE AND SERVERS, ETC IN PLACE PRIOR TO REMOVING EXISTING SURVEILLANCE EQUIPMENT. COORDINATE WITH THE OWNER FOR THE PHASING OF WORK BY AREA. A PHASING PLAN SHALL BE SUBMITTED FOR OWNER APPROVAL PRIOR TO COMMENCEMENT OF WORK. DOWNTIME OF EXISTING SYSTEMS SHALL BE KEPT TO A MINIMUM DURING THE COURSE OF THE INSTALLATION.
 - ALL EXISTING ANALOG CAMERAS SHALL BE REMOVED AND REPLACED WITH NEW IP BASED POE CAMERAS AS SHOWN ON THE PLANS. THE EXISTING COAX CABLE SHALL BE REMOVED AND REPLACED WITH NEW CAT6 CABLES. THE EXISTING CONDUITS WILL BE REUSED FOR THE INSTANCES WHERE NEW CAT6 CABLE LENGTH FROM CAMERA TO ASSOCIATED NETWORK SWITCH DOES NOT EXCEED 280'. FOR THE INSTANCES WHERE EXISTING CONDUIT EXCEEDS LENGTH OF 280' CONTRACTOR WILL PROVIDE NEW FIBER OPTIC CABLE AND REQUIRED MEDIA CONVERTERS AND POWER SUPPLIES TO SUPPORT CAMERA AND MEDIA CONVERTER OPERATION.
 - THE EXISTING CAT6 CABLES SHALL REMAIN FOR REUSE. ALL CAT6 CABLES THAT ARE PLANNED TO BE REUSED SHALL BE TESTED TO CONFIRM UNCOMPROMISED SIGNAL STRENGTH. ALL CABLES FAILING THIS TEST SHALL BE REPLACED WITH THE NEW FIBER OPTIC CABLE FOR EXTERIOR CAMERAS AND CAT6 FOR INTERIOR CAMERAS.
 - ALL NEW VIDEO SYSTEM COMPONENTS SHALL BE CONNECTED TO NETWORK SWITCHES VIA CAT6 CABLE USING PATCH PANELS. IF ANY CABLE LENGTH BETWEEN A COMPONENT (CAMERA, WORKSTATION, ETC) AND A NETWORK SWITCH, INCLUDING SLACK, EXCEEDS 300', PROVIDE NEW FIBER OPTIC CABLE, MEDIA CONVERTERS AND POWER SUPPLIES TO SUPPORT CAMERA AND MEDIA CONVERTER OPERATION. PROVIDE POWER FOR MEDIA CONVERTERS FROM APPROVED UPS CIRCUITS. ALL UNDERGROUND CAT6 RUNS SHALL BE IN CONDUIT AND SHALL UTILIZE DIRECT-BURIAL RATED CABLE.
 - CAT6 CABLES FOR NEW CAMERAS SHALL RUN IN CONDUITS BETWEEN CAMERA AND THE NEAREST ACCESSIBLE CEILING. USE J-HOOKS AND PLENUM RATED CABLE FOR THE CABLE RUNS ABOVE CEILING.
 - NETWORK SWITCHES SHALL BE PROVIDED BY THE NDCCS_OCIO.
 - PATCH PANELS AND ASSOCIATED HEAD END PATCH CABLES SHALL BE PROVIDED AND INSTALLED BY THE CONTRACTOR.
 - THE EXISTING TOUCH SCREEN STATION HARDWARE SHALL REMAIN.
 - ALL EXISTING VIDEO SURVEILLANCE EQUIPMENT (INCLUDED BUT NOT LIMITED TO CAMERAS, VIDEO MONITORS, SERVERS AND RECORDERS, ETC.) SHALL BE REMOVED AND RETURNED TO THE OWNER.
 - EACH CAMERA MOUNTING LOCATION SHALL BE FIELD VERIFIED TO CONFIRM BEST VIDEO COVERAGE. VIDEO COVERAGE SHALL BE APPROVED AND SIGNED OFF BY THE OWNER OR ENGINEER. FOR NEW CAMERA LOCATIONS CONTRACTOR MUST NOTIFY ENGINEER OF ANY OBSTRUCTIONS TO INTENDED VIEW PRIOR TO CAMERA INSTALLATION.
 - ALL REMOVED EXISTING CABLING WILL BE LEGALLY DISPOSED OF BY THE CONTRACTOR AND NOT TURNED OVER TO THE OWNER UNLESS NOTED OTHERWISE.

- NOTES:**
- EXISTING VIDEO MANAGEMENT SYSTEM MONITOR SHALL BE REMOVED AND RETURNED TO THE OWNER.
 - PROVIDE NEW 43" 4K LED VIDEO MONITOR (DELL U4323QE OR EQUAL). PROVIDE NEW FULL MOTION VESA COMPLIANT WALL MOUNT (KANTO M300 OR EQUAL).
 - EXISTING UPS WILL BE REUSED.
 - PROVIDE NEW VIDEO WORKSTATION. THE NEW VIDEO WORKSTATION AND THE EXISTING UPS WILL BE MOUNTED IN NEW LOCKABLE AND VENTILATED CABINET. NEW CABINET WILL BE NavePoint Pro Series 12U OR EQUAL.
 - PROVIDE NEW VIDEO DECODER BOSCH VIDEO JET 7000 AND NEW 27" BOSCH LED MONITOR.
 - PROVIDE NEW DESK MOUNTED 43" 4K LED MONITOR (DELL U4323QE OR EQUAL).



CLIENT INFORMATION
NE Dept of Correctional Services
2720 W. Van Dorn St
Lincoln, NE 68522




PROJECT INFORMATION
CCCL - SECURITY CAMERA SYSTEM UPGRADE

Job # 24-0086
ISSUE DATE: 10/25/2024
Revisions:
ID Date Description
1/18/2024 ADDENDUM #1

CHECKED: JA
DRAWN BY: JC

SHEET TITLE: ENLARGED PLAN

SHEET NUMBER: ES2.02

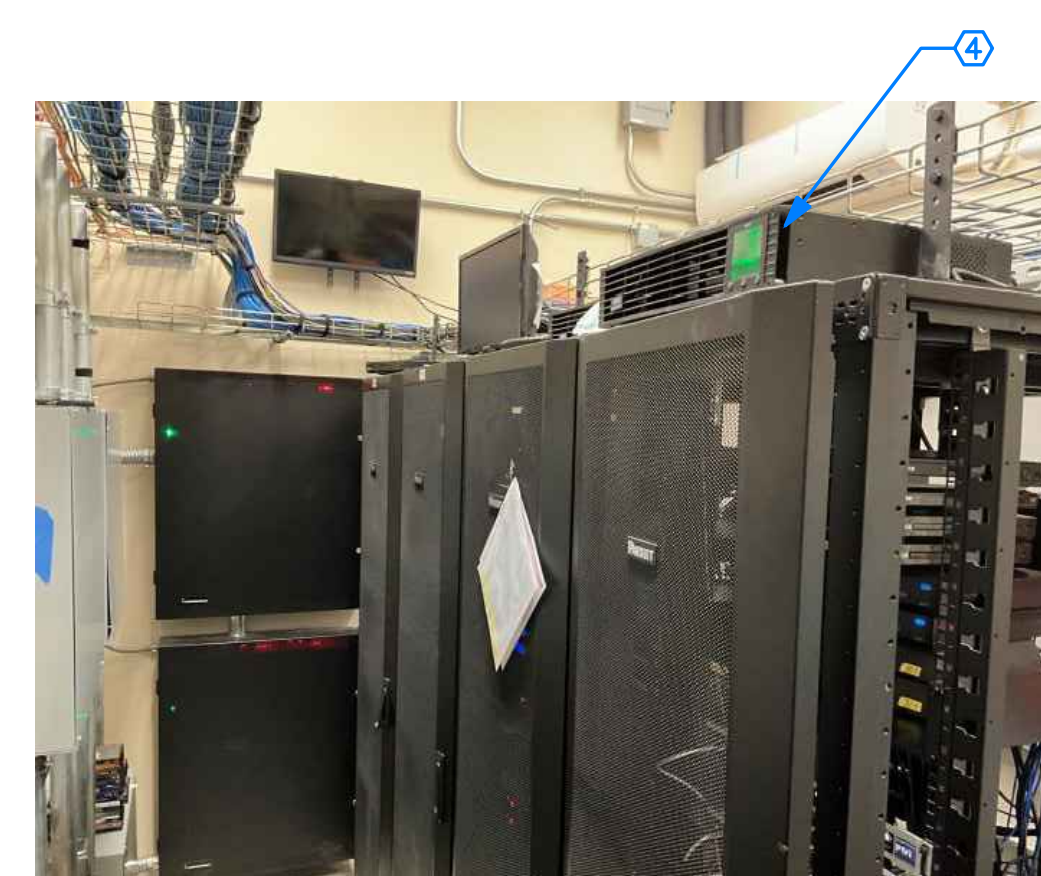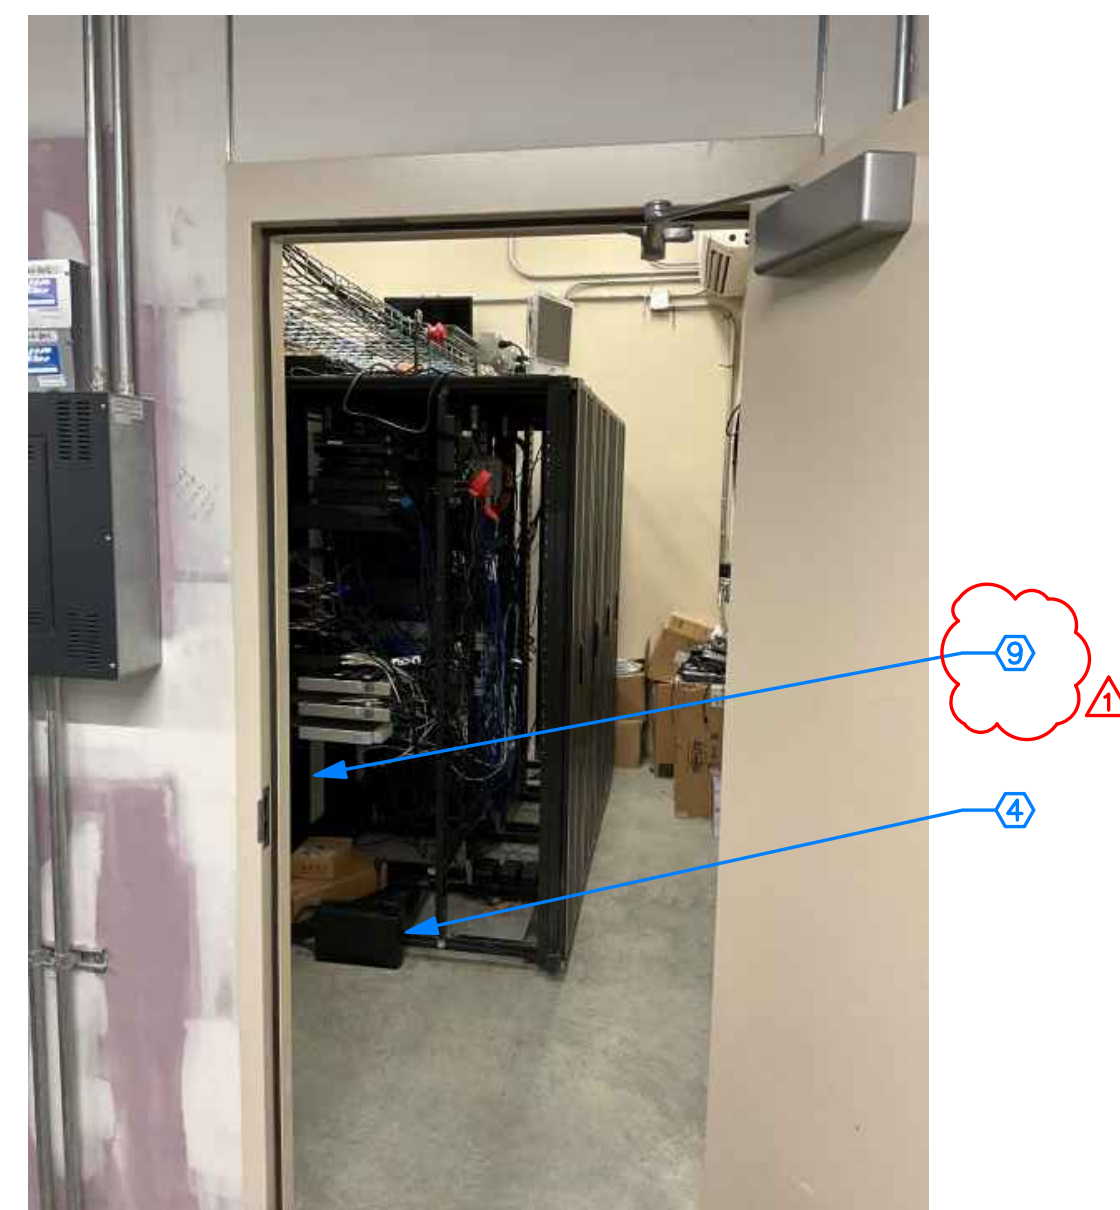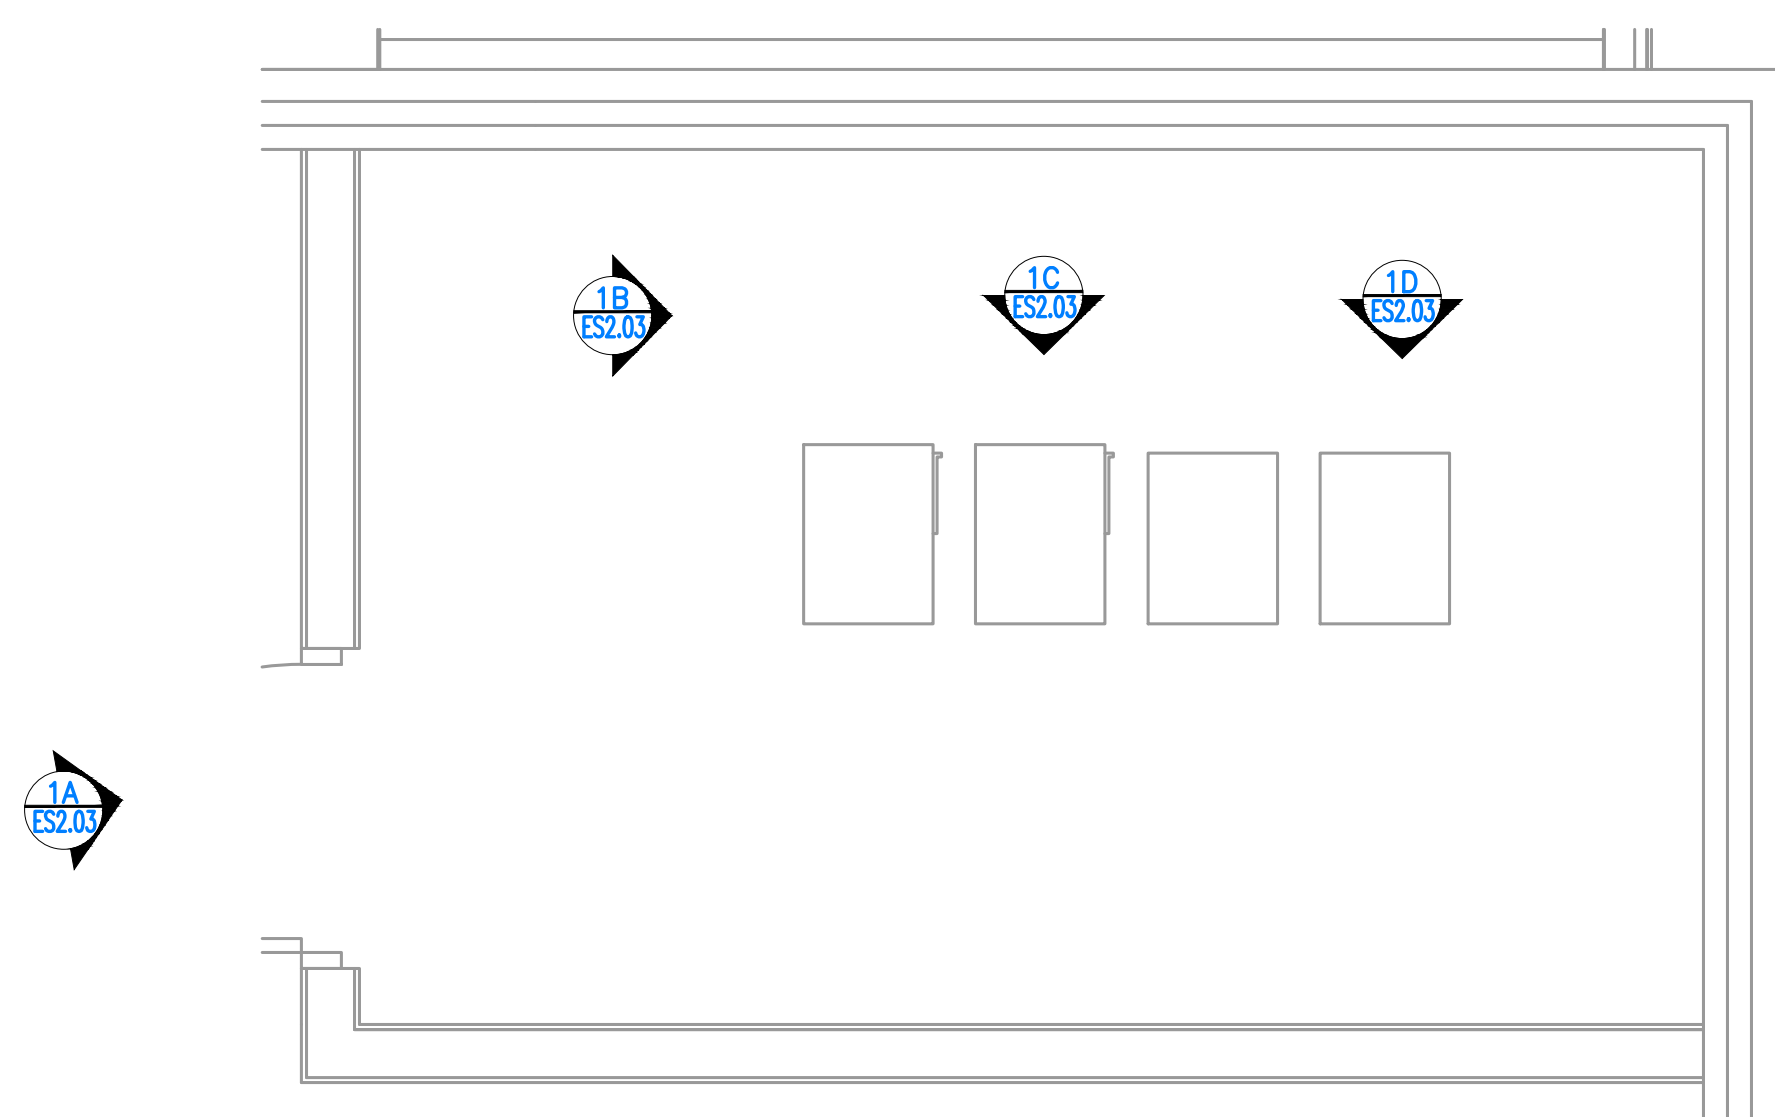

1 EXISTING IT/SEC ELECT #M202



ES2.03 SCALE: 1/2" = 1'-0"

1A PHOTO EXISTING EQUIPMENT

ES2.03 SCALE: NOT TO SCALE

1B PHOTO EXISTING EQUIPMENT

ES2.03 SCALE: NOT TO SCALE

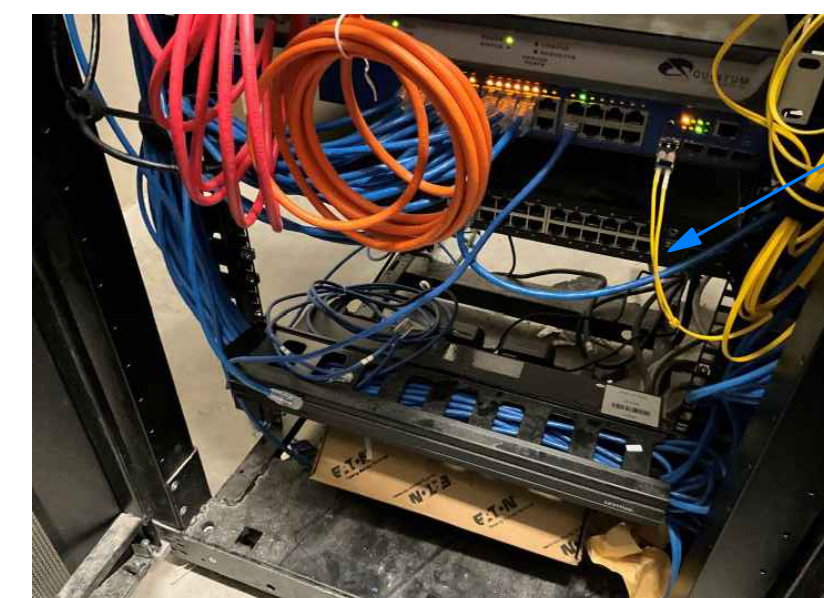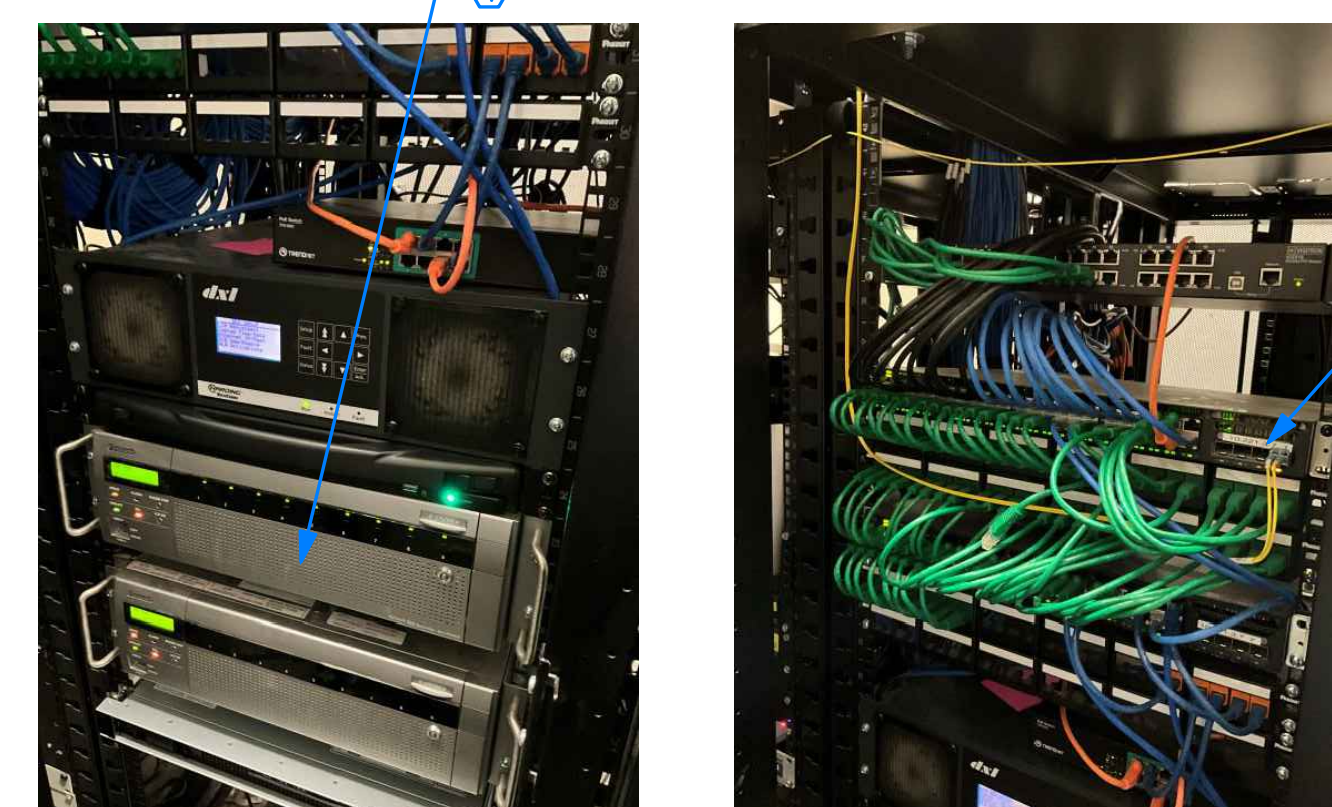

1C PHOTO EXISTING EQUIPMENT

ES2.03 SCALE: NOT TO SCALE

1D PHOTO EXISTING EQUIPMENT

ES2.03 SCALE: NOT TO SCALE

GENERAL NOTES:

- LOCATION AND NUMBER OF ALL EXISTING ELECTRONIC SECURITY FIELD DEVICES SHOWN ON THIS DRAWING ARE BASED ON AS-BUILT DRAWINGS. FIELD VERIFY AND CONFIRM LOCATION, NUMBER AND FUNCTIONALITY OF ALL EXISTING FIELD DEVICES.
- ALL EXISTING FIELD DEVICES (INCLUDING BUT NOT LIMITING TO DOOR CONTROL AND MONITORING, INTERCOM STATIONS, PAGING SPEAKERS, CALL BUTTONS, DURESS PUSHBUTTONS, ETC) AND THEIR ASSOCIATED CABLES/WIRES CONNECTING THEM TO THE EXISTING HEAD-END EQUIPMENT SHALL REMAIN FOR REUSE UNLESS NOTED OTHERWISE.
- THE SCOPE OF THIS PROJECT INCLUDES REPLACEMENT OF ALL EXISTING ANALOG CAMERAS AND IP CAMERAS (REFER TO DRAWINGS FOR EXACT NUMBER AND LOCATION). THE EXISTING VIDEO VIEWING STATIONS SHALL BE REPLACED. THE EXISTING VIDEO RECORDING SERVER SHALL BE REPLACED. THE EXISTING VIDEO STORAGE SHALL BE REPLACED. ALL NEW CAMERAS SHALL BE MANUFACTURED BY BOSCH (TO MATCH MAJORITY OF THE NDCCS FACILITIES). HANMHA MULTISENSOR CAMERA WITH INTEGRATED PTZ AND HANMHA DUAL SENSOR CAMERA WITH CAMERA SCHEDULE. NEW VIDEO MANAGEMENT SOFTWARE SHALL BE THE LATEST AVAILABLE VERSION OF BOSCH VMS (V12.1 OR LATER). ALL CAMERAS WILL BE RECORDED AND VIDEO STORAGE SHALL BE SIZED TO RETAIN RECORDING FOR 90 DAYS. ALL CAMERAS SHALL BE CONTINUOUSLY RECORDED AT NATIVE RESOLUTION @ 15 IMAGES PER SECOND. QUIET TIME RECORDING (NO MOTION) SHALL BE AT NATIVE RESOLUTION @ 2 IMAGES PER SECOND FOR ALL CAMERAS. THE MOTION SHALL BE ESTIMATED AT 70%.
- THE NEW VIDEO MANAGEMENT SYSTEM SHALL NOT BE INTERFACED WITH THE EXISTING TOUCH SCREEN CONTROL AND MANAGEMENT SYSTEM TO ALLOW DISPLAY OF ALL NEW CAMERA ICONS ON THE TOUCH SCREEN MAPS FOR CAMERA CALL UP.
- WORK SHALL BE PHASED TO INSTALL ALL NEW INFRASTRUCTURE AND SERVERS, ETC IN PLACE PRIOR TO REMOVING EXISTING SURVEILLANCE EQUIPMENT. COORDINATE WITH THE OWNER FOR THE PHASING OF WORK BY AREA. A PHASING PLAN SHALL BE SUBMITTED FOR OWNER APPROVAL PRIOR TO COMMENCEMENT OF WORK. DOWNTIME OF EXISTING SYSTEMS SHALL BE KEPT TO A MINIMUM DURING THE COURSE OF THE INSTALLATION.
- ALL EXISTING ANALOG CAMERAS SHALL BE REMOVED AND REPLACED WITH NEW IP BASED POE CAMERAS AS SHOWN ON THE PLANS. THE EXISTING COAX CABLE SHALL BE REMOVED AND REPLACED WITH NEW CAT6 CABLES. THE EXISTING CONDUITS WILL BE REUSED FOR THE INSTANCES WHERE NEW CAT6 CABLE LENGTH FROM CAMERA TO ASSOCIATED NETWORK SWITCH DOES NOT EXCEED 280'. FOR THE INSTANCES WHERE EXISTING CONDUIT EXCEEDS LENGTH OF 280' CONTRACTOR WILL PROVIDE NEW FIBER OPTIC CABLE AND REQUIRED MEDIA CONVERTERS AND POWER SUPPLIES TO SUPPORT CAMERA AND MEDIA CONVERTER OPERATION.
- THE EXISTING CAT6 CABLES SHALL REMAIN FOR REUSE. ALL CAT6 CABLES THAT ARE PLANNED TO BE REUSED SHALL BE TESTED TO CONFIRM UNCOMPROMISED SIGNAL STRENGTH. ALL CABLES FAILING THIS TEST SHALL BE REPLACED WITH THE NEW FIBER OPTIC CABLE FOR EXTERIOR CAMERAS AND CAT6 FOR INTERIOR CAMERAS.
- ALL NEW VIDEO SYSTEM COMPONENTS SHALL BE CONNECTED TO NETWORK SWITCHES VIA CAT6 CABLE USING PATCH PANELS. IF ANY CABLE LENGTH BETWEEN A COMPONENT (CAMERA, WORKSTATION, ETC) AND A NETWORK SWITCH, INCLUDING SLACK, EXCEEDS 300', PROVIDE NEW FIBER OPTIC CABLE, MEDIA CONVERTERS AND POWER SUPPLIES TO SUPPORT CAMERA AND MEDIA CONVERTER OPERATION. PROVIDE POWER FOR MEDIA CONVERTERS FROM APPROVED UPS CIRCUITS. ALL UNDERGROUND CAT6 RUNS SHALL BE IN CONDUIT AND SHALL UTILIZE DIRECT-BURIAL RATED CABLE.
- CAT6 CABLES FOR NEW CAMERAS SHALL RUN IN CONDUITS BETWEEN CAMERA AND THE NEAREST ACCESSIBLE CEILING. USE J-HOOKS AND PLENUM RATED CABLE FOR THE CABLE RUNS ABOVE CEILING.
- NETWORK SWITCHES SHALL BE PROVIDED BY THE NDCCS_OCIO.
- PATCH PANELS AND ASSOCIATED HEAD END PATCH CABLES SHALL BE PROVIDED AND INSTALLED BY THE CONTRACTOR.
- THE EXISTING TOUCH SCREEN STATION HARDWARE SHALL REMAIN.
- ALL EXISTING VIDEO SURVEILLANCE EQUIPMENT (INCLUDED BUT NOT LIMITED TO CAMERAS, VIDEO MONITORS, SERVERS AND RECORDERS, ETC.) SHALL BE REMOVED AND RETURNED TO THE OWNER.
- EACH CAMERA MOUNTING LOCATION SHALL BE FIELD VERIFIED TO CONFIRM BEST VIDEO COVERAGE. VIDEO COVERAGE SHALL BE APPROVED AND SIGNED OFF BY THE OWNER OR ENGINEER. FOR NEW CAMERA LOCATIONS CONTRACTOR MUST NOTIFY ENGINEER OF ANY OBSTRUCTIONS TO INTENDED VIEW PRIOR TO CAMERA INSTALLATION.
- ALL REMOVED EXISTING CABLING WILL BE LEGALLY DISPOSED OF BY THE CONTRACTOR AND NOT TURNED OVER TO THE OWNER UNLESS NOTED OTHERWISE.

NOTES:

- EXISTING PANASONIC NETWORK RECORDERS AND SERVERS SHALL BE REMOVED AND RETURNED TO NDCCS.
- EXISTING NETWORK SWITCHES AND PATCH PANELS WILL BE REUSED.
- USE EXISTING NETWORK PORTS FOR NEW CAMERAS. CONVERTED FROM ANALOG TO IP. IF NETWORK PORTS ARE NOT AVAILABLE COORDINATE WITH NDCCS OCIO TO PROVIDE NEW NETWORK SWITCHES.
- EXISTING UPS SHALL BE REUSED.
- NOT USED.
- PROVIDE NEW 2KVA UPS TO POWER NEW BOSCH VIDEO SERVERS AND STORAGE.
- LABEL ALL EXISTING AND NEW CAMERA'S CAT6 CABLES. LABELS SHALL BE PLACED ON EACH CABLE AND NETWORK PORT.
- EXISTING FIBER OPTIC CABLES AND PATCH PANELS SHALL BE REUSED.
- PROVIDE NEW BOSCH VIDEO MANAGEMENT SYSTEM STORAGE. THE NEW VIDEO MANAGEMENT EQUIPMENT SHALL BE POWERED FROM THE EXISTING UPS.



CLIENT INFORMATION
NE Dept of Correctional Services

2720 W. Van Dorn St
Lincoln, NE 68522


PROJECT INFORMATION
CCCL - SECURITY CAMERA SYSTEM UPGRADE

Job #	24-0086
ISSUE DATE	10/25/2024
Revisions:	
Rev. No.	Description
1	11/18/2024 ADDENDUM #1


CHECKED BY: JA
DRAWN BY: JC

SHEET TITLE
ENLARGED PLAN

SHEET NUMBER
ES2.03

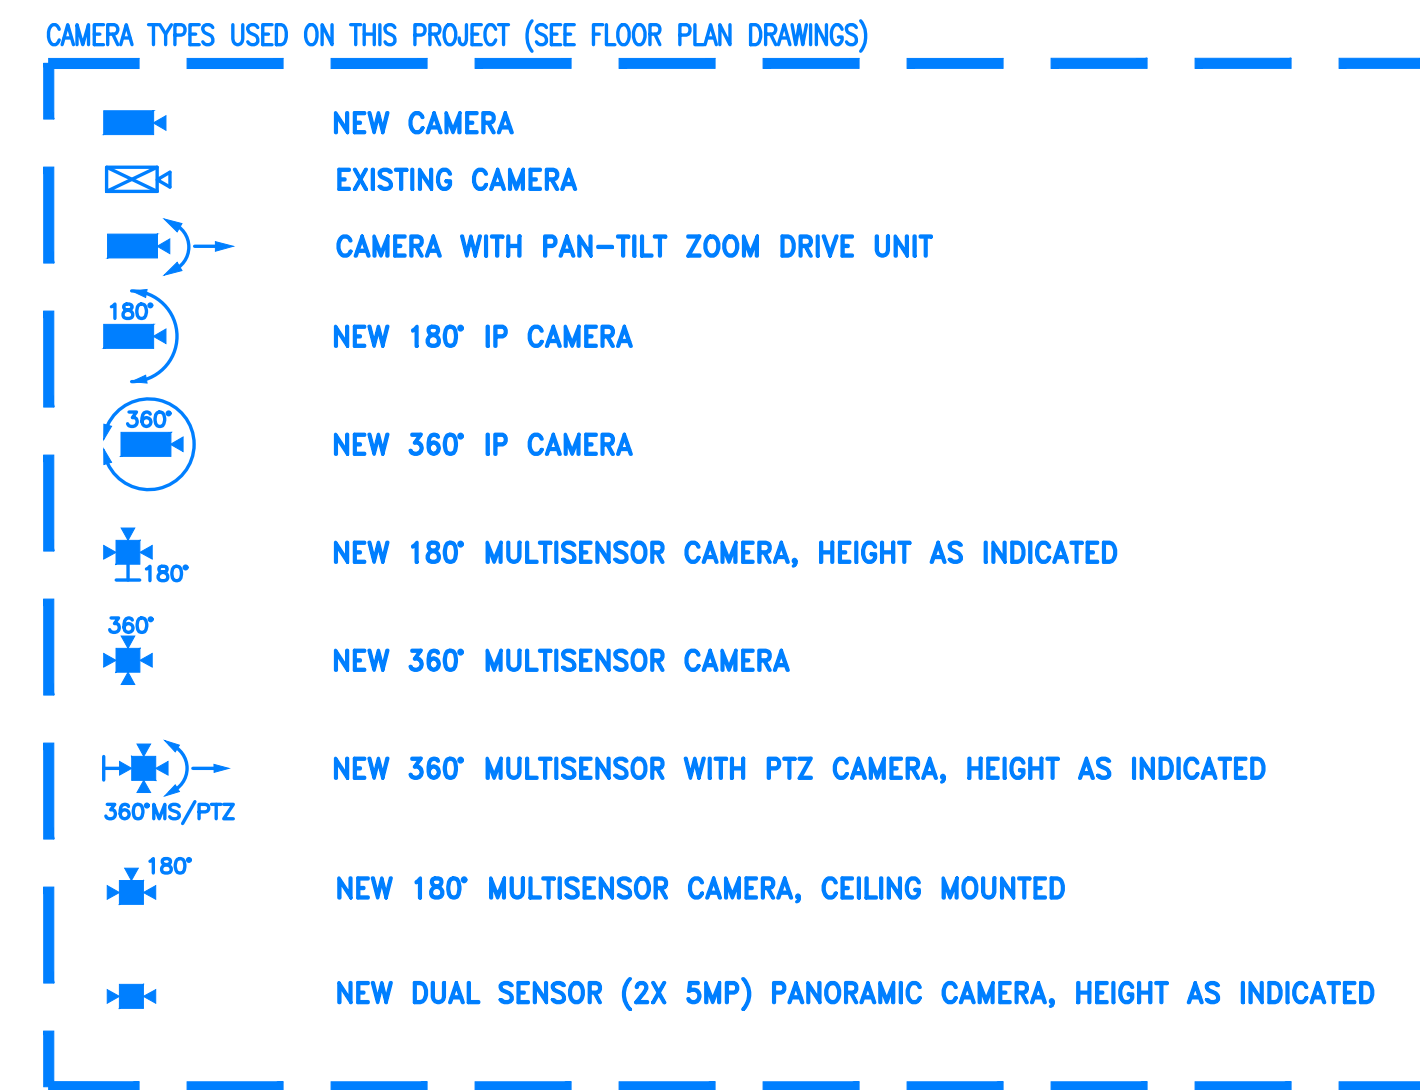

- GENERAL NOTES:
- LOCATION AND NUMBER OF ALL EXISTING ELECTRONIC SECURITY FIELD DEVICES SHOWN ON THIS DRAWING ARE BASED ON AS-BUILT DRAWINGS. FIELD VERIFY AND CONFIRM LOCATION, NUMBER AND FUNCTIONALITY OF ALL EXISTING FIELD DEVICES.
 - REFER TO CAMERA SCHEDULE FOR THE EXACT CAMERA MOUNTING LOCATIONS AND TYPES. THE FINAL CAMERAS MOUNTING LOCATIONS SHALL BE FIELD VERIFIED (TO PROVIDE OPTIMUM VIEW) AND CONFIRMED BY THE OWNER AND SECURITY CONSULTANT. (REFER TO ESS.01).
 - ALL EXISTING AND NEW WIRING SHALL BE MANAGED IN ACCORDANCE TO APPLICABLE CODES AND INDUSTRY STANDARDS. ALL EXISTING AND NEW WIRING SHALL BE LABELED PER CONSTRUCTION DOCUMENTS REQUIREMENTS.
 - FIBER OPTIC PATCH PANELS SHALL BE USED TO TERMINATE AND DISTRIBUTE ALL FIBER OPTIC CABLES IN EQUIPMENT CABINETS/ENCLOSURES.
 - PATCH PANELS SHALL BE USED TO TERMINATE AND DISTRIBUTE ALL DATA CABLES (CAT6) IN EQUIPMENT CABINETS/ENCLOSURES.
 - ALL NETWORK SWITCHES FOR THE ELECTRONIC SECURITY SYSTEM SHALL BE PROVIDED BY THE OWNER (NDCS-OCIO). ELECTRONIC SECURITY CONTRACTOR SHALL COORDINATE SWITCHES SETUP WITH THE OWNER. ALL IP ADDRESSES AND VLAN CONFIGURATION SHALL BE COORDINATED BETWEEN THE ELECTRONIC SECURITY CONTRACTOR AND THE OWNER DURING THE SUBMITTAL PROCESS.
 - ALL GENERAL NOTES SHOWN ON THE FLOOR PLAN DRAWINGS APPLY TO THIS DRAWING.

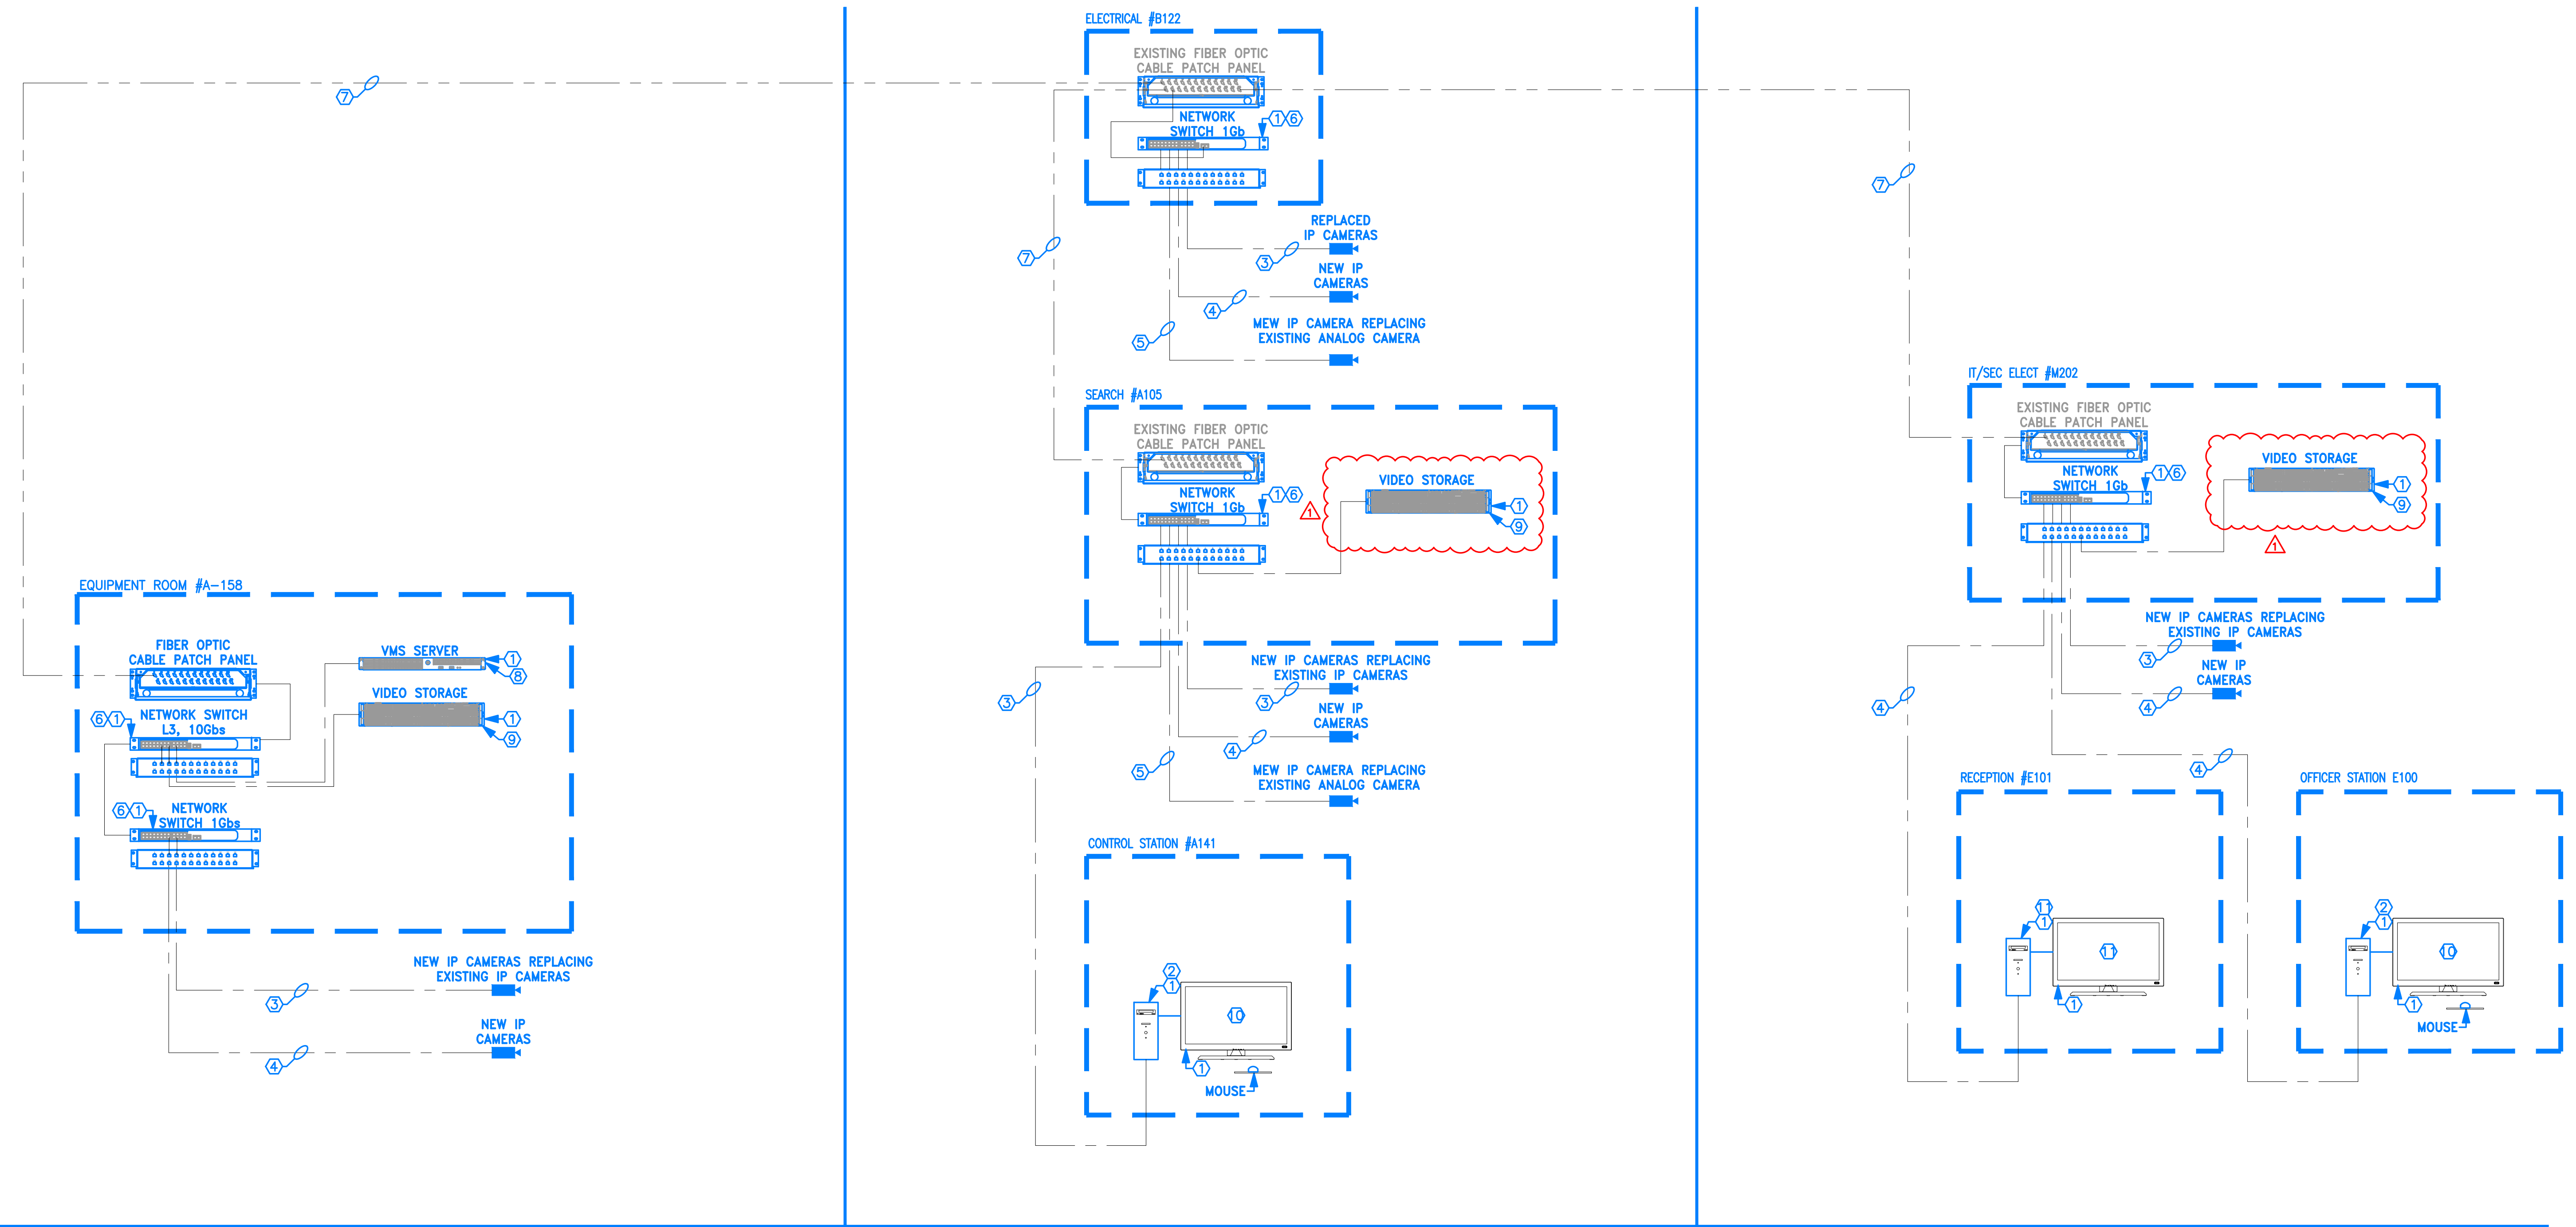

- NOTES
- 120 VAC, 20A POWER FROM THE EXISTING AND NEW UPS. REUSE EXISTING UPS POWER RECEPTACLE WHERE AVAILABLE.
 - NEW VIDEO VIEWING/MONITORING WORKSTATION (43" 4K MONITOR, CPU, MOUSE AND KEYBOARD). PROVIDE HDMI CABLE FOR CONNECTION BETWEEN VIDEO MONITORS AND DECODER.
 - REUSE CAT6 CABLE IN THE EXISTING CONDUIT.
 - NEW CAT6 CABLE IN NEW 3/4" CONDUIT.
 - REMOVE EXISTING COAX CABLE AND PROVIDE NEW CAT6 CABLE.
 - EXISTING/NEW LAYER 3, 10G 24 PORT NETWORK SWITCH. PROVIDE QUANTITY AS REQUIRED TO ACCOMMODATE ALL VMS FILED DEVICES AND AND EQUIPMENT. PROVIDED BY NDCS OCIO.
 - EXISTING FIBER OPTIC CABLE AND CONDUIT. SHOWN CONDUIT ROUTING IS JUST DIAGRAMMATIC REPRESENTATION OF THE EXISTING FIBER OPTIC BACKBONE.
 - NEW ARRAY OF HARD DRIVES IN RAID 6 CONFIGURATION FOR VIDEO RECORDING STORAGE. PROVIDE QUANTITY AS REQUIRED TO MEET CONSTRUCTION DOCUMENTS REQUIREMENTS.
 - NEW VIDEO RECORDING SYSTEM (VRS) SERVER. THE SERVER SHALL MANAGE VIDEO RECORDING AND DISTRIBUTION.
 - PROVIDE NEW 43" VIDEO MONITOR.
 - PROVIDE NEW VIDEO DECODER BOSCH VIDEO JET 7000 AND NEW 27" BOSCH LED MONITOR.



CLIENT INFORMATION
NE Dept of Correctional Services
2720 W. Van Dorn St
Lincoln, NE 68522

PROJECT INFORMATION
CCCL - SECURITY CAMERA SYSTEM UPGRADE

Job # 24-0086
ISSUE DATE: 10/25/2024
Revisions:
ED Date Description
11/18/2024 ADDENDUM #1

CHECKED: JA
DRAWN BY: JC
SHEET TITLE: VIDEO MANAGEMENT SYSTEM DIAGRAM

SHEET NUMBER
ES4.01

100 BED BUILDING

CCCL BUILDING

160 BED BUILDING

1 SYSTEM NETWORK DIAGRAM
ES4.01 SCALE: NOT TO SCALE

CAMERA SCHEDULE

Camera Number	Room Name	Sheet	Resolution	Lens	Mount	Video Analytics	Notes:
Site Plan							
1	C501	Exterior Site	ES0.10	4K/1080P	360°MS/PTZ	Pole	
2	C502	Exterior Site	ES0.10	4K/1080P	360°MS/PTZ	Pole	
3	C503	Exterior Site	ES0.10	20MP	360°MS	Pole	
4	C504	Exterior Site	ES0.10	4K/1080P	360°MS/PTZ	Pole	
5	C505	Exterior Site	ES0.10	20MP	360°MS	Pole	
6	C506	Exterior Site	ES0.10	4K/1080P	360°MS/PTZ	Pole	
7	C507	Exterior Site	ES0.10	20MP	360°MS	Pole	
8	C508	Exterior Site	ES0.10	4K/1080P	360°MS/PTZ	Pole	
9	C509	Exterior Site	ES0.10	12MP	360°		
100 BED BUILDING							
10	C101	Room	ES1.01	5MP	3-10mm	Wall	
11	C102	Room	ES1.01	5MP	3-10mm	Wall	
12	C103	Room	ES1.01	5MP	3-10mm	Wall	
13	C104	Room	ES1.01	5MP	3-10mm	Wall	
14	C105	Room	ES1.01	12MP	180°	Wall	
15	C106	Room	ES1.01	12MP	180°	Wall	
16	C107	Room	ES1.01	12MP	360°	Ceiling/Pendent	
17	C108	Room	ES1.01	12MP	180°	Wall	
18	C109	Exterior	ES1.01	20MP	360°MS	Wall Corner	
19	C110	Exterior	ES1.01	20MP	360°MS	Wall Corner	
CCCL Building							
20	C201	Corridor #B107	ES1.03	10MP	3-10mm	Ceiling	
21	C202	Day Room #B106	ES1.03	12MP	360°	Ceiling	
22	C203	Corridor #A126	ES1.03	20MP	360°MS	Ceiling	
23	C204	Exterior	ES1.03	5MP	3-10mm	Ceiling	
24	C205	Laundry #C101	ES1.03	5MP	3-10mm	Ceiling Corner	
25	C206	Dayroom #C106	ES1.03	12MP	360°	Ceiling	
26	C207	Corridor #C107	ES1.03	10MP	3-10mm	Ceiling	
27	C208	Exterior	ES1.03	5MP	3-10mm	Wall	
28	C209	Waiting	ES1.03	5MP	3-10mm	Wall	
29	C210	Classroom	ES1.03	5MP	3-10mm	Wall	
30	C211	Storage #C100	ES1.03	6MP	3-10mm	Ceiling Corner Vandal Mount	
31	C212	Corridor #A107	ES1.03	20MP	360°MS	Ceiling	
32	C213	Sally Port #A119	ES1.03	5MP	3-10mm	Ceiling Corner	
33	C214	Exterior	ES1.03	5MP	3-10mm	Wall	
34	C215	Exterior	ES1.03	5MP	3-10mm	Wall	
35	C216	Exterior	ES1.03	4K/1080P	360°MS/PTZ	Wall/Parapet	
36	C217	Room	ES1.03	20MP	360°MS	Ceiling	
37	C218	Holding	ES1.03	6MP	3-10mm	Ceiling Corner Vandal Mount	
38	C219	Holding	ES1.03	6MP	3-10mm	Ceiling Corner Vandal Mount	
39	C220	Commissary	ES1.03	12MP	360°	Ceiling	
40	C221	Multi-Purpose Room #A127	ES1.03	5MP	3-10mm	Wall	
41	C222	Lobby	ES1.03	5MP	3-10mm	Ceiling	
42	C223	Exterior	ES1.03	5MP	3-10mm	Ceiling	
43	C224	Corridor #A153	ES1.04	5MP	3-10mm	Ceiling	
44	C225	Sally Port #A149	ES1.04	5MP	3-10mm	Ceiling Corner	
45	C226	Exterior	ES1.04	5MP	3-10mm	Ceiling Corner	
46	C227	Exterior	ES1.04	4K/1080P	360°MS/PTZ	Wall/Parapet	
47	C228	Holding Cell #A131	ES1.04	5MP	3-10mm	Ceiling Corner	
48	C229	Corridor #A132	ES1.04	5MP	3-10mm	Ceiling	
49	C230	Corridor #A140	ES1.04	5MP	3-10mm	Ceiling	
50	C231	Canteen #A139	ES1.04	12MP	360°	Ceiling	
51	C232	Clothing #E101	ES1.04	5MP	3-10mm	Ceiling Corner	
52	C233	Dayroom #E106	ES1.04	12MP	360°	Ceiling	
53	C234	Laundry #E108	ES1.04	5MP	3-10mm	Ceiling Corner	
54	C235	Corridor #E107	ES1.04	10MP	3-10mm	Ceiling	
55	C236	Exterior	ES1.04	5MP	3-10mm	Ceiling	
56	C237	Corridor #A130	ES1.04	20MP	360°MS	Ceiling	
57	C238	Exterior	ES1.04	5MP	3-10mm	Ceiling	
58	C239	Laundry #D101	ES1.04	5MP	3-10mm	Ceiling Corner	
59	C240	Dayroom #D106	ES1.04	12MP	360°	Ceiling	
60	C241	Corridor #D107	ES1.04	10MP	3-10mm	Ceiling	
61	C242	Exterior	ES1.04	5MP	3-10mm	Ceiling	
62	C243	Recreation #A128	ES1.04	5MP	3-10mm	Wall	
63	C244	Corridor	ES1.04	10MP	3-10mm	Ceiling	
64	C245	Multi-Purpose Room #A127	ES1.04	10MP	3-10mm	Ceiling	
65	C246	NOT USED					
66	C247	Dayroom #C106	ES1.04	5MP	3-10mm	Ceiling	
67	C248	Dayroom #B106	ES1.04	5MP	3-10mm	Ceiling	
68	C249	Dayroom #E106	ES1.04	5MP	3-10mm	Ceiling	
69	C250	Dayroom #D106	ES1.04	5MP	3-10mm	Ceiling	

CAMERA SCHEDULE

Camera Number	Room Name	Sheet	Resolution	Lens	Mount	Video Analytics	Notes:
160 Bed Building							
70	C301	Treat #E113	ES1.06	5MP	3-10mm	Ceiling Corner	
71	C302	Exercise #E115	ES1.06	5MP	3-10mm	Ceiling Corner	
72	C303	MP #E116A	ES1.06	5MP	3-10mm	Ceiling Corner	
73	C304	Corridor #D100	ES1.06	10MP	3-10mm	Ceiling	
74	C305	Corridor #C100	ES1.06	10MP	3-10mm	Ceiling	
75	C306	Laundry	ES1.06	5MP	3-10mm	Ceiling Corner	
76	C307	Exterior	ES1.06	5MP	3-10mm	Wall	
77	C308	Dayroom C/D	ES1.06	20MP	360°MS	Wall Corner	
78	C309	Dayroom A/B	ES1.06	20MP	360°MS	Wall Corner	
79	C310	Laundry #E126	ES1.06	5MP	3-10mm	Ceiling Corner	
80	C311	Corridor #B100	ES1.06	10MP	3-10mm	Ceiling	
81	C312	Corridor #A100	ES1.07	10MP	3-10mm	Ceiling	
82	C313	Exterior	ES1.07	5MP	3-10mm	Wall	
83	C314	Dayroom A #E132	ES1.07	5MP	3-10mm	Ceiling Corner	
84	C315	Dayroom D #131	ES1.07	5MP	3-10mm	Wall	
85	C316	Entry #E135	ES1.07	5MP	3-10mm	Ceiling Corner	
86	C317	Exterior	ES1.07	5MP	3-10mm	Wall	
87	C318	Vestibule #E107	ES1.07	5MP	3-10mm	Ceiling Corner	
88	C319	Corridor/Waiting #E106	ES1.07	20MP	360°MS	Ceiling	
89	C320	Stair B #E108	ES1.07	5MP	3-10mm	Wall	
90	C321	Class/MP/VIS #E111	ES1.07	5MP	3-10mm	Ceiling	
91	C322	Class/MP/VIS #E112	ES1.07	5MP	3-10mm	Ceiling	
92	C323	Corridor #F108	ES1.07	5MP	3-10mm	Ceiling	
93	C324	Corridor #F109	ES1.07	5MP	3-10mm	Ceiling	
94	C325	Womens Dining #F110	ES1.07	20MP	360°MS	Wall	
95	C326	Womens Dining #F110	ES1.07	5MP	3-10mm	Wall	
96	C327	Stair A #F111	ES1.07	5MP	3-10mm	Wall	
97	C328	Corridor #F106	ES1.07	5MP	3-10mm	Ceiling	
98	C329	Room	ES1.07	5MP	3-10mm	Ceiling	
99	C330	Room	ES1.07	5MP	3-10mm	Ceiling Corner	
100	C331	Mens Dining #F119	ES1.07	5MP	3-10mm	Wall	
101	C332	Mens Dining #F119	ES1.07	20MP	360°MS	Wall	
102	C333	Exterior	ES1.07	20MP	360°MS	Wall	
103	C334	Serving #F131	ES1.07	20MP	360°MS	Ceiling	
104	C335	Cold Prep #F132	ES1.07	5MP	3-10mm	Ceiling Corner	
105	C336	Cold Prep #F132	ES1.07	5MP	3-10mm	Ceiling	
106	C337	Dishwash #F118	ES1.07	12MP	360°	Ceiling	
107	C338	Serving #F122	ES1.07	12MP	360°	Ceiling	
108	C339	Corridor #F121	ES1.07	5MP	3-10mm	Ceiling	
109	C340	Pantry #F124	ES1.07	5MP	3-10mm	Ceiling Corner	
110	C341	Corridor	ES1.07	5MP	3-10mm	Ceiling	
111	C342	Cartwash #F140	ES1.08	12MP	360°	Ceiling	
112	C343	Room	ES1.08	5MP	3-10mm	Ceiling	
113	C344	Dry Storage #F125	ES1.08	12MP	360°	Ceiling	
114	C345	Corridor #F151	ES1.08	20MP	360°MS	Ceiling	
115	C346	Vestibule #F142	ES1.08	5MP	3-10mm	Ceiling	
116	C347	Med Office #F105	ES1.07	6MP	3-10mm	Ceiling Corner Vandal Mount	
117	C348	Workshop #F154	ES1.08	12MP	360°	Ceiling	
118	C349	Dock Staging #F150	ES1.08	5MP	3-10mm	Wall	
119	C350	Storage #F144	ES1.08	12MP	360°	Steel Joist	
120	C351	Exterior	ES1.08	4K/1080P	360°MS/PTZ	Wall Corner	
121	C352	Exterior	ES1.08	5MP	3-10mm	Wall	
122	C353	Exterior	ES1.09	5MP	3-10mm	Wall	
123	C354	Room	ES1.07	12MP	360°	Ceiling	
124	C355	Exterior	ES1.06	5MP	3-10mm	Wall	



NE Dept of Correctional Services

2720 W. Van Dorn St
Lincoln, NE 68522

CCCL - SECURITY CAMERA SYSTEM UPGRADE

Job # 24-0086

ISSUE DATE: 10/25/2024

Revisions: ID, Date, Description

11/18/2024 ADDENDUM #1

CHECKED: JA

DRAWN BY: JC

SHEET TITLE: DAVIS DESIGN ALL RIGHTS RESERVED

CAMERA SCHEDULE

SHEET NUMBER

ES4.02